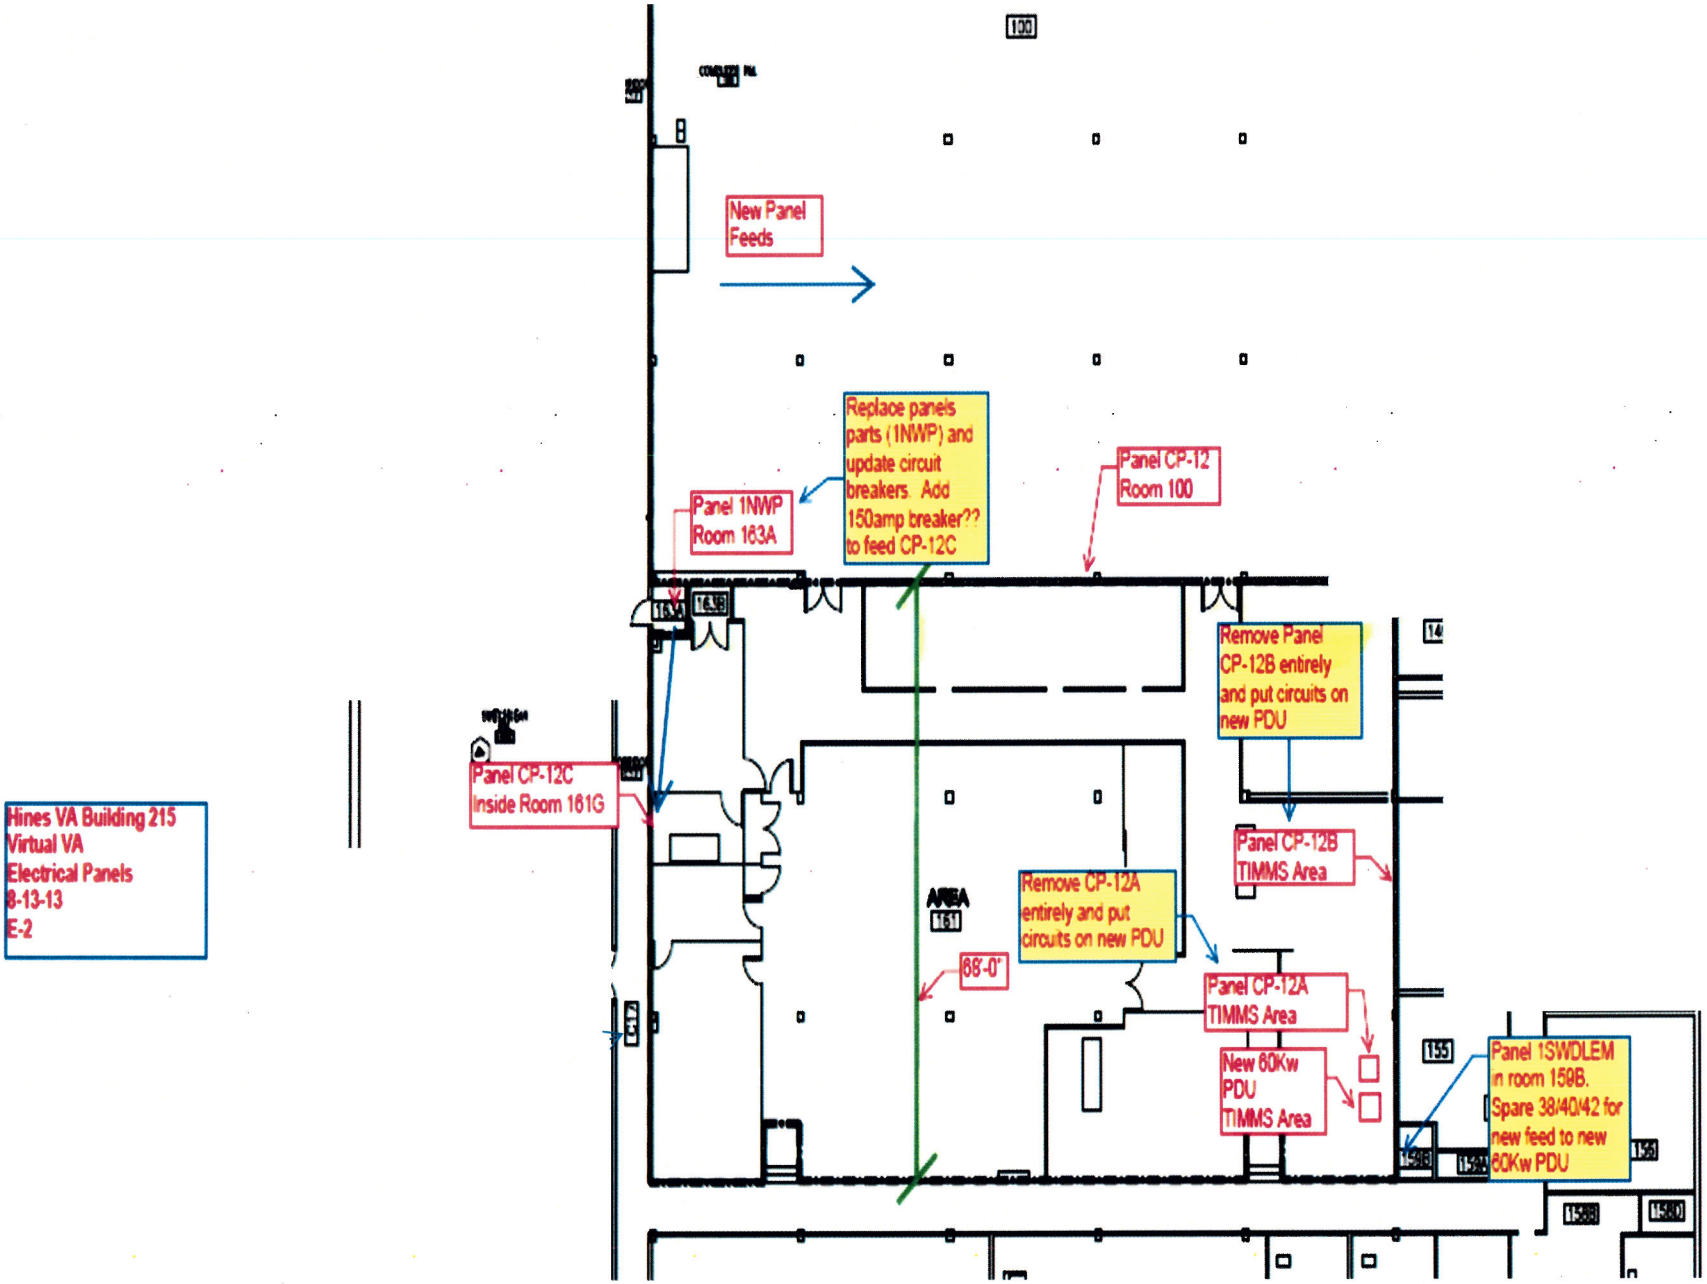Attachment E: Electrical Panels New Feeds