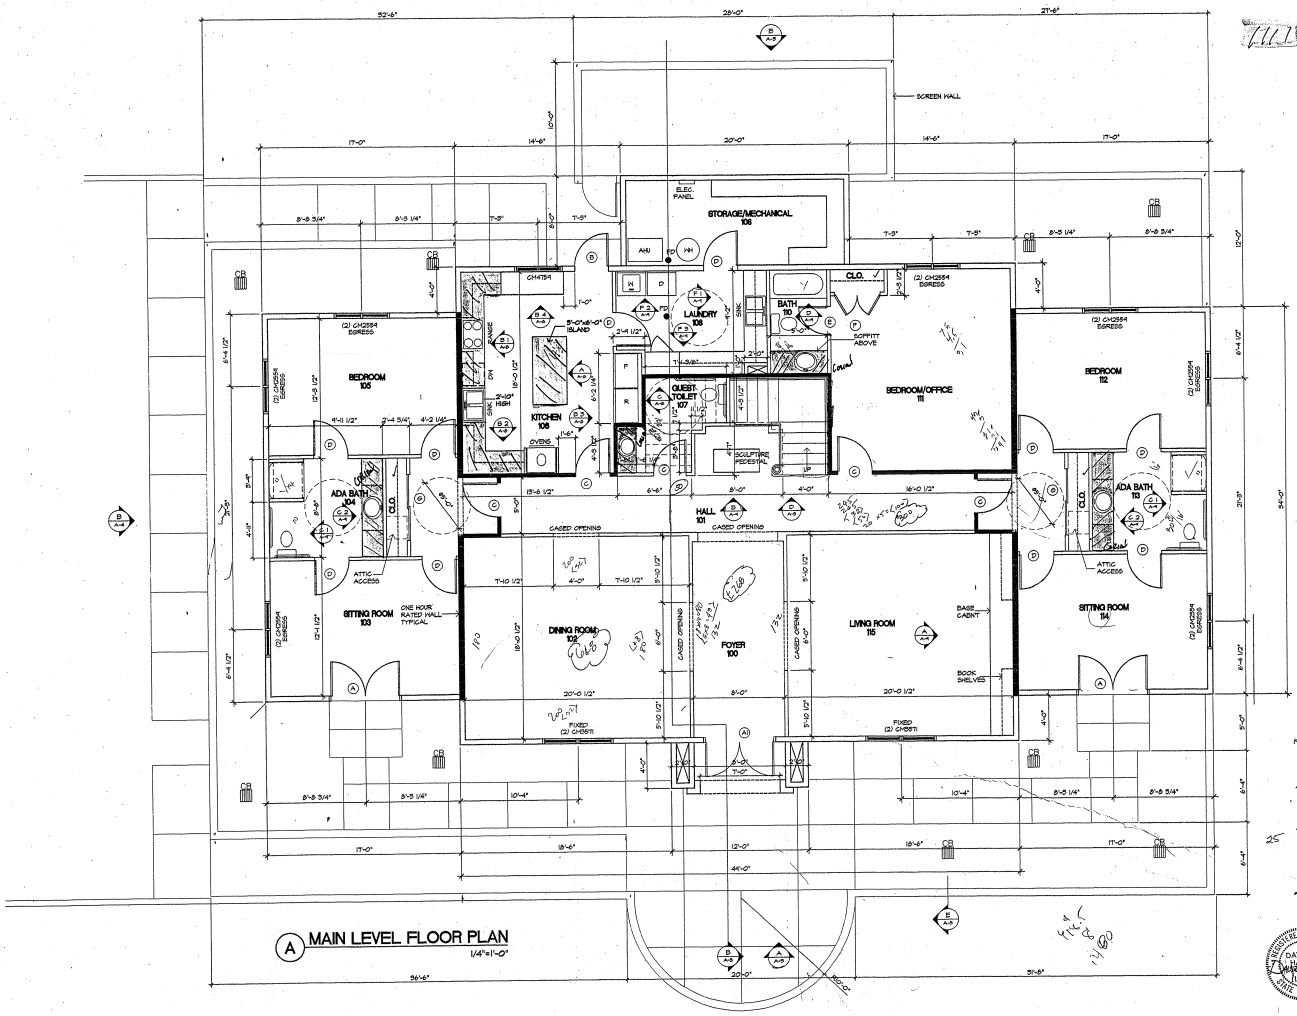

A MAIN LEVEL FLOOR PLAN
1/4"=1'-0"

16.4
30 BATH
30
25
50
13.5
KITCH
100 ft
LAUNDRY
100 ft
Foyer
145 ft
25
Hall
150 ft
Dining
360 ft

DAVID A. HINES ARCHITECT
302 north rock rd. suite 201, wichita, kansas 67206, 316 684 0880

NEW BUILDING
ZACHARY AND ELIZABETH FISHER HOUSE
BAY PINES VETERANS HOSPITAL

11-29-00

A-1