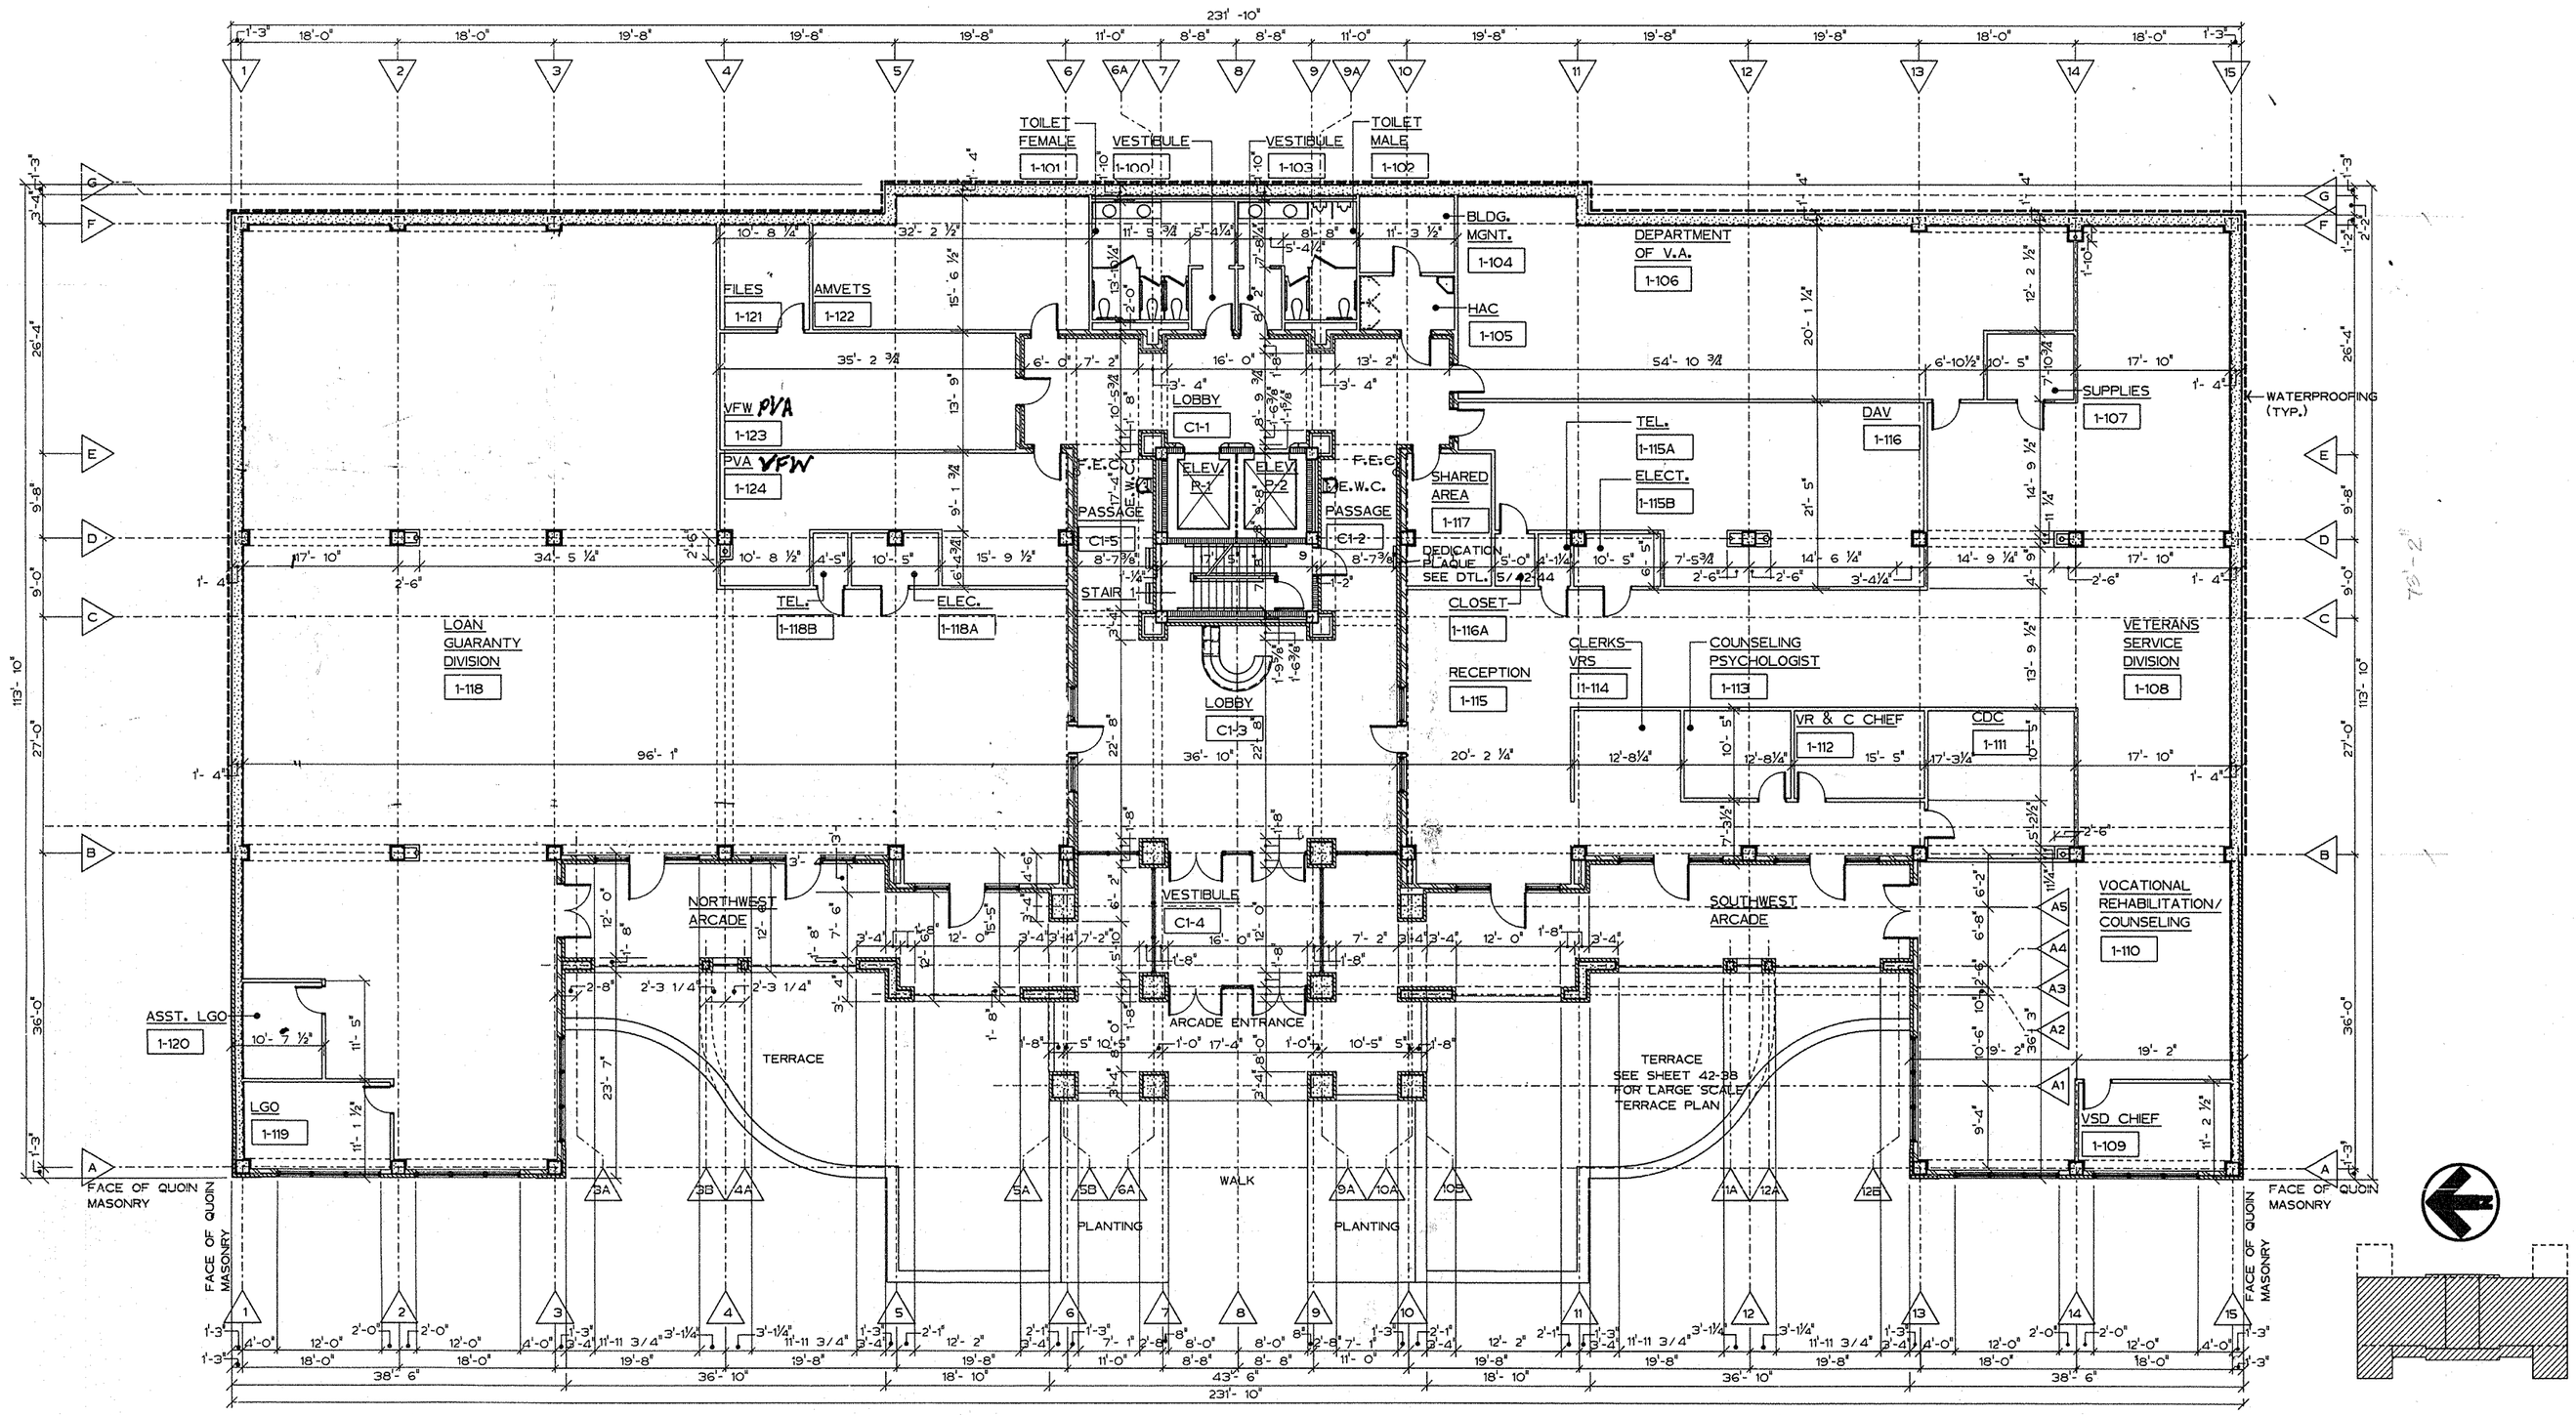

1 - FIRST FLOOR LEVEL DIMENSIONAL PLAN
ONE EIGHTH INCH EQUALS ONE FOOT

Fully Sprinklered

Revisions	Date

2WR
Watson Watson Rutland / Architects Inc.
166 Commerce Street
P.O. Box 4834
Montgomery, Alabama 36104
205)263-6401

STATE OF ALABAMA WATSON 5093 WATSON 1828 RUTLAND 2149 REGISTERED ARCHITECTS

Drawing Title	First Floor Level Dimensional Plan
Approved: Area Project Manger	
Project Title	Relocate Regional Office to Department Owned Grounds
Building Number	42
Checked	
Drawn	
Location	VMAC Montgomery, Al.
Date	27 JANUARY 92
Project No.	322-002
DRAWING NO.	42-2
Dwg. 26 of 134	

Office of Facilities
Department of Veterans Affairs

VA FORM 08-6231A, JAN 1990