






ADDENDUM #4 	09/24/2013
ADDENDUM #3 	09/12/2013
ADDENDUM #2 	09/09/2013
ADDENDUM #1 	08/28/2013
Revisions:	Date
ISSUED FOR CONSTRUCTION	08/15/2013

KEY PLAN:

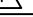

WEST








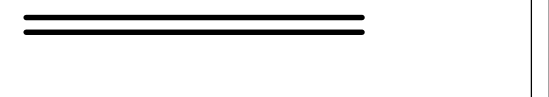



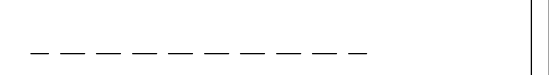
SOUTH

NORTH

Drawing Title	ENLARGED PLAN 9TH FLOOR - SOUTH
Approved Project Director	

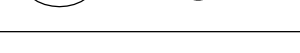Project Title VA NY HARBOR HEALTHCARE SYSTEM MANHATTAN VAMC - BUILDING 1 9TH FLOOR RENOVATIONS		
Location 423 EAST 23RD STREET NEW YORK, NY 10010		
Date AUGUST 15, 2013	Checked AH/DT	Drawn CO

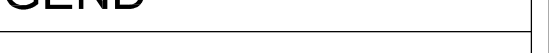
Project Number 630PR2600	Office of Construction & Facilities Management
Building Number 1	
Drawing Number 1-AE109-S	
<div>  <div>U.S. Department of Veterans Affairs</div> </div>	

<div data-bbox="2276 75 2309 121">  </div> <div data-bbox="2309 75 2582 121"> <h1>PARTITION FIRE RATING LEGEND</h1> </div>	<div data-bbox="2582 75 2614 121">  </div> <div data-bbox="2614 75 2914 121"> <h1>CONSTRUCTION PLAN LEGEND</h1> </div>
<div data-bbox="2276 121 2386 140">  </div> <div data-bbox="2386 121 2582 140"> <p>1 HOUR FIRE</p> </div> <div data-bbox="2276 140 2386 168">  </div> <div data-bbox="2386 140 2582 168"> <p>SMOKE BARRIER (1 HOUR FIRE)</p> </div> <div data-bbox="2276 168 2386 203">  </div> <div data-bbox="2386 168 2582 203"> <p>2 HOUR FIRE BARRIER</p> </div>	<div data-bbox="2582 121 2712 140"> <p>EXISTING CONSTRUCTION TO REMAIN</p> </div> <div data-bbox="2712 121 2914 140">  </div> <div data-bbox="2582 140 2712 168"> <p>NEW CONSTRUCTION</p> </div> <div data-bbox="2712 140 2914 168">  </div> <div data-bbox="2582 168 2712 203"> <p>EXISTING PERIMETER WINDOW TO REMAIN</p> </div> <div data-bbox="2712 168 2914 203">  </div>
	<div data-bbox="2582 203 2712 231"> <p>EXISTING DOOR ASSEMBLY TO REMAIN</p> </div> <div data-bbox="2712 203 2914 231">  </div> <div data-bbox="2582 231 2712 258"> <p>NEW DOOR ASSEMBLY</p> </div> <div data-bbox="2712 231 2914 258">  </div> <div data-bbox="2582 258 2712 285"> <p>CURTAIN TRACK (CEILING MOUNTED)</p> </div> <div data-bbox="2712 258 2914 285">  </div> <div data-bbox="2582 285 2712 312"> <p>MATCH LINE</p> </div> <div data-bbox="2712 285 2914 312">  </div> <div data-bbox="2582 312 2914 342"> <div data-bbox="2778 312 2914 342"> <p>F1/1-A-XXXX-X F1/1-A-XXXX-X</p> </div> </div>

- # GENERAL CONSTRUCTION NOTES
1. ALL DIMENSIONS ARE TO FINISHED FACE OF PARTITION UNLESS NOTED OTHERWISE.
 2. ALL DIMENSIONS SHOWN IN RENOVATED AREAS ARE TO BE VERIFIED IN THE FIELD BEFORE PROCEEDING WITH WORK.



- ## SPECIFIC CONSTRUCTION NOTES
- 1 AT THE INTERIOR FACE OF WALL ALONG THE PERIMETER PROVIDE FRAMING AS SCHEDULED WITH TYPE X GYPSUM BOARD AND INSULATION.
 - 2 PROVIDE NEW LOUVER. REFER TO F3/1-A506.
 - 3 PROVIDE NEW CONNECTOR ENCLOSURE AND WINDOW SILL. REFER TO DETAIL F8/1-A508.
 - 4 NEW CONCRETE CURB, ALIGN NEW CURB WITH EXISTING COLUMN ENCLOSURE IN PLACE, MATCH HEIGHT TO EXISTING ADJACENT CONCRETE CURB HEIGHT. REFER TO DETAIL F8/1-SJ001.
 - 5 NEW SLAB INFILL. REFER TO DETAIL E6/1-SJ001.
 - 6 REPAIR EXISTING CONCRETE SLAB. REFER TO DETAIL CB/1-SJ001.
 - 7 NEW MECHANICAL CHAFF INLET. REFER TO DETAIL CB/1-SJ001. COORDINATE WITH MECHANICAL DWGS.
 - 8 EXISTING CONCRETE CURBS TO REMAIN.
 - 9 PROVIDE AND INSTALL EXTENSION BACK BOXES FOR ALL ELEVATOR CALL BUTTON ASSEMBLIES AND CALL LIGHTS, AND EXTEND CONDUIT AND POWER TO BE FLUSH WITH NEW FACE OF ELEVATOR WALL.
 - 10 NEW SECURITY GRILLE. REFER TO B1/1-A502 AND C1/1-A503.
 - 11 NEW FIRE EXTINGUISHER CABINET. REFER TO SHEET F-A502 FOR DETAILS.
 - 12 NEW WALL ACCESS PANEL. REFER TO B8/1-A503.
 - 13 AT 9TH FLOOR, PAINT ALL EXPOSED PIPING WITH NEW COAT OF PAINT TO MATCH EXISTING. SPRINKLER PIPING TO BE PAINTED RED.
 - 14 EXISTING FIRE ALARM PANEL TO REMAIN.
 - 15 NEW 4" HOUSEKEEPING PADS. COORDINATE LOCATION W/ MECHANICAL DRAWINGS. REFER TO DETAIL F8/1-SJ001.
 - 16 NEW DRINKING FOUNTAIN (SEE PLUMBING DWGS).
 - 17 NEW RADIATOR ENCLOSURE. REFER TO DETAIL F1/1-A506.
 - 18 NEW FIN TUBE ENCLOSURE. REFER TO DETAIL B6/1-A506.
 - 19 NEW 2HR RATED SLAB INFILL WITH OPENING FOR DUCTWORK. SEE MECHANICAL DWGS 1-B-001 FOR ADDITIONAL INFORMATION INCLUDING FIRE DAMPER.
 - 20 PROVIDE ACCESS PANEL IN NEW PARTITION FOR EXISTING ELECTRICAL WIRE WAY. REFER TO ELECTRICAL DRAWINGS FOR ADDITIONAL INFORMATION. COORDINATE EXACT SIZE / LOCATION WITH EXISTING EQUIPMENT.
 - 21 PROVIDE 2 HOUR RATED ACCESS PANEL IN EXISTING PARTITION. CONTRACTOR TO VERIFY EXACT SIZE IN FIELD.
 - 22 FOR LOCATIONS WHERE EXISTING STRUCTURAL STEEL BEAM CORNER ENCROACHMENT IS MISSING DUE TO PLUMBING PIPING, REFER TO DETAIL C6/1-A506. CONTRACTOR TO FIELD VERIFY.
- END PLUMBING IS TO 1" SPACING EDGE
- Scale: 1/8" = 1'-0"

three inches = one foot
one and one half inches = one foot
one inch = one foot
three quarters inch = one foot
one half inch = one foot
three eighths inch = one foot
one quarter inch = one foot
one eighth inch = one foot
one sixteenth inch = one foot

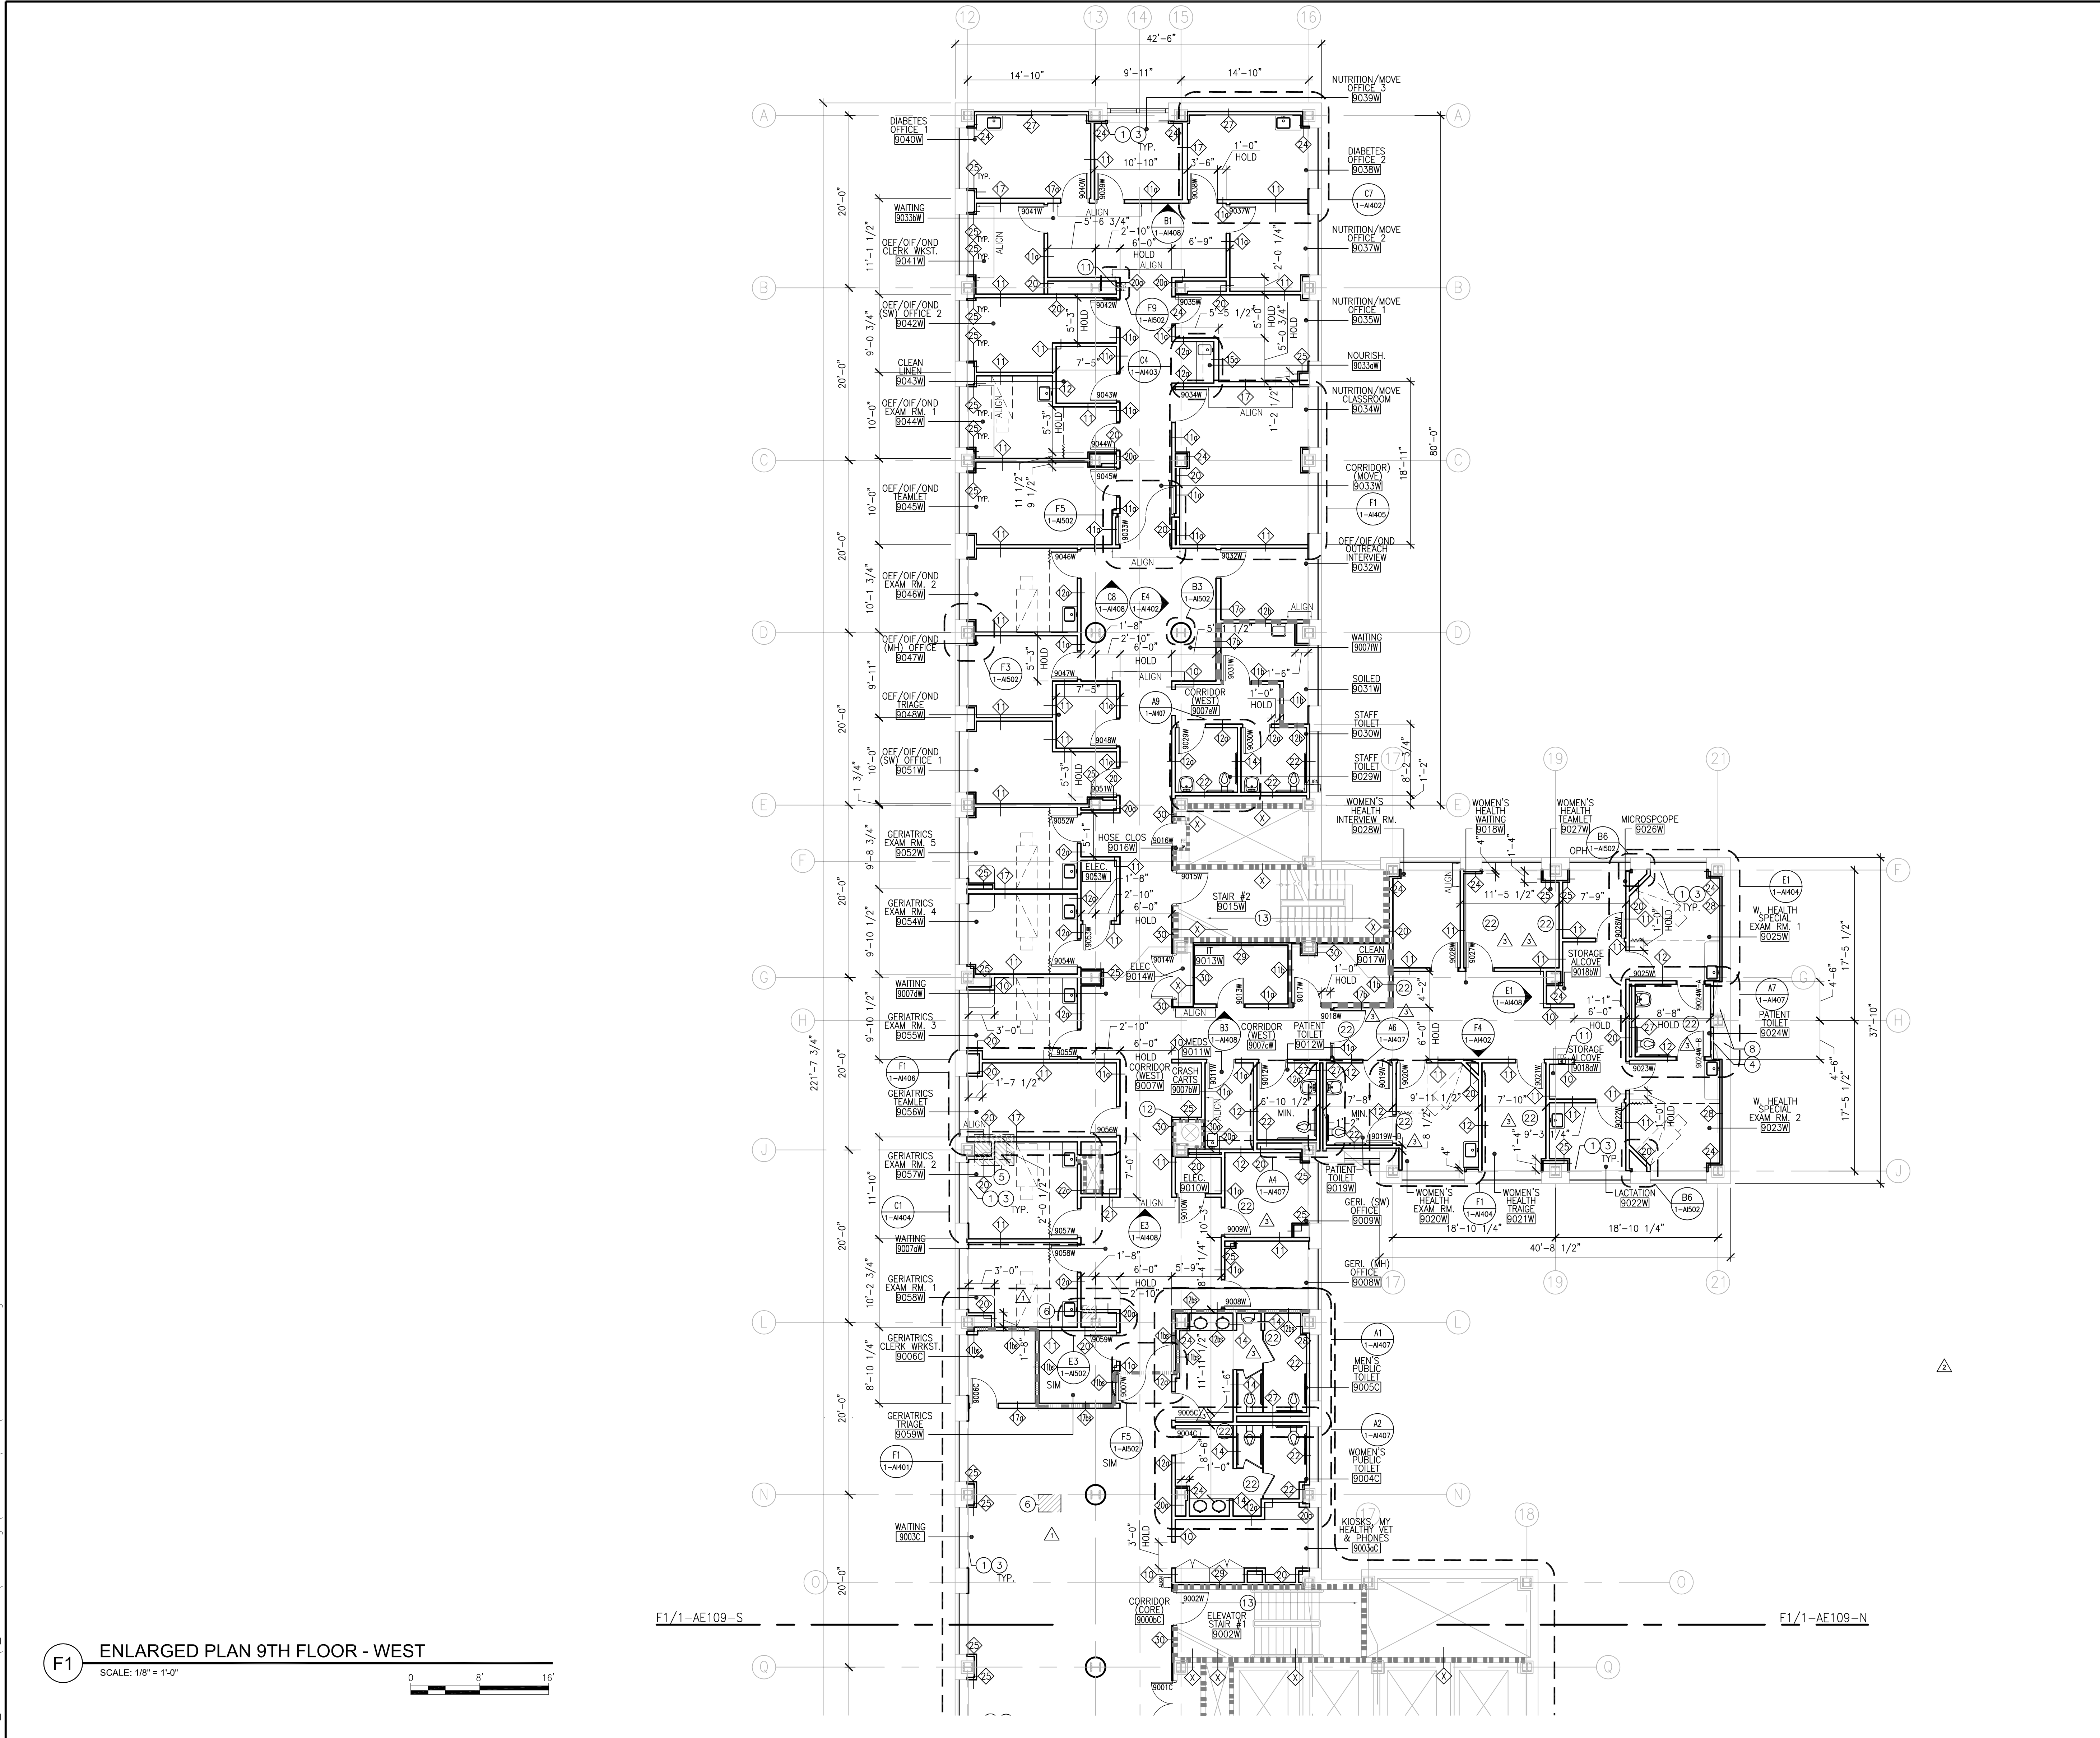

PARTITION FIRE RATING LEGEND

1 HOUR FIRE

SMOKE BARRIER (1 HOUR FIRE)

2 HOUR FIRE BARRIER

CONSTRUCTION PLAN LEGEND

EXISTING CONSTRUCTION TO REMAIN

NEW CONSTRUCTION

EXISTING PERIMETER WINDOW TO REMAIN

EXISTING DOOR ASSEMBLY TO REMAIN

NEW DOOR ASSEMBLY

CURTAIN TRACK (CEILING MOUNTED)

MATCH LINE

GENERAL CONSTRUCTION NOTES

1. ALL DIMENSIONS ARE TO FINISHED FACE OF PARTITION UNLESS NOTED OTHERWISE.

2. ALL DIMENSIONS SHOWN IN RENOVATED AREAS ARE TO BE VERIFIED IN THE FIELD BEFORE PROCEEDING WITH WORK.

3. WHERE A FIXED RATED PARTITION IS SHOWN ABUTTING EXTERIOR WALLS, THE FIRE RATED ASSEMBLY IS TO EXTEND TO THE EXTERIOR WALL CONSTRUCTION.

4. IN ALL ROOMS BELOW AREAS WHICH RECEIVE UNDER FLOOR SERVICES, REMOVE A PORTION OF EXISTING CEILING AS REQUIRED. PATCH FINISHES TO MATCH EXISTING OR AS INDICATED ON ROOM FINISH SCHEDULE.

5. REFER TO MEP DRAWINGS FOR EXISTING AND NEW FIXTURES AND SERVICES TO BE REMOVED AND/OR INSTALLED. EXISTING FINISHES DISTURBED BY THIS WORK SHALL BE PATCHED TO MATCH ADJACENT UNDISTURBED FINISHES.

6. WHENEVER EXISTING EQUIPMENT, PIPING, DUCTS, ETC ARE REQUIRED TO BE REMOVED, SUCH REMOVAL SHALL INCLUDE ALL ANCHORS, HANGERS, ETC. AFTER REMOVAL FLOORS, WALLS AND CEILINGS SHALL BE FINISHED TO MATCH ADJOINING SURFACES OR AS INDICATED ON ROOM FINISH SCHEDULE.

7. FIRESTOP W/ U.L. APPROVED SYSTEMS. ALL PENETRATIONS THROUGH NEW & EXISTING RATED CONSTRUCTION FIRESTOP AT ALL OPENINGS RESULTING FROM THE RENOVATIONS OF EXISTING MEP SYSTEMS. SEE MECHANICAL ELECTRICAL PLUMBING & FIRE PROTECTION DRAWINGS TO DETERMINE FULL SCOPE OF WORK. REFER TO CS/1-AE601 AND SCHEDULE OF THROUGH PENETRATION FIRESTOP SYSTEMS ON DRAWING 1-AE601 FOR PENETRATION FIRESTOPPING REQUIREMENTS. CONTRACTOR TO MAINTAIN THE INTEGRITY OF THE RATED ASSEMBLY AT ALL PENETRATIONS THROUGH THAT ASSEMBLY.

8. EXAM TABLES ARE DASHED AND SHOWN FOR REFERENCE AND COORDINATION ONLY.

9. REFER TO A0 DRAWING SERIES FOR FURNITURE AND EQUIPMENT PLANS FOR REFERENCE AND COORDINATION. PROVIDE BLOCKING AT ALL EQUIPMENT AND ACCESSORIES, REFER TO DETAIL E6/1-A504.

10. UNDERCUT ALL DOORS TO CLEAR NEW FLOOR FINISHES. FOR ADDITIONAL INFORMATION REFER TO DOOR SCHEDULE ON SHEETS 1-AE603 AND 1-AE604.

11. CHOP AROUND ABANDONED EXISTING CONDUIT AND PIPES TO THE TOP OF THE STRUCTURAL SLAB CUT CONDUITS AND PIPES AT THE TOP OF STRUCTURAL SLAB AND SEAL WITH FIRESEALING BACKFILL VOID WITH LIGHT WEIGHT CONCRETE.

12. BACKFILL WITH LIGHT WEIGHT CONCRETE ALL VOIDS TOPPING SLAB RESULTING FROM REMOVAL OF PARTITIONS, SHOWER PANS AND OTHER REMOVALS.

13. FLOAT ENTIRE SLAB WITH HYDRAULIC CEMENT UNDERLAYMENT. PROVIDE BONDING AGENT.

14. ALL WINDOWS AND ASSOCIATED HARDWARE, INTERNAL WINDOW SHADE ASSEMBLIES AND OPERATORS TO BE REMOVED AND REPLACED AT ALL OPENINGS RESULTING FROM THE RENOVATIONS OF EXISTING MEP SYSTEMS. REFER TO DRAWING 1-AE109.1 FOR WINDOW TYPE AND LOCATIONS. WINDOWS AT ELEVATOR LOBBY DOORS TO REMAIN. CONTRACTOR TO FIELD VERIFY EXISTING WINDOW SIZE AND QUANTITY. PROTECT AND REPAIR ALL EXTERIOR WALL OPENINGS INCLUDING FLASHING. SEALANT AND INSULATION FOR WINDOW REMOVAL AND REPLACEMENT. COORDINATE INSULATION SEALANT AND ATTACHMENT WITH NEW WINDOW MANUFACTURER. REFER TO SPECIFICATION SECTION 085113 ALUMINUM WINDOWS.

15. REFER TO SPECIFICATION SECTION 1-05 AT AND SEISMIC DESIGN PARAMETERS LISTED ON SHEET 1-SJ001 FOR ALL SEISMIC BRACING REQUIREMENTS.

16. ALL INTERIOR PARTITIONS THAT STOP ABOVE THE CEILING TO BE BRACED TO THE SLAB ABOVE.

17. ALL LOOSE CONCRETE MATERIAL, ABOVE BEAMS AND/OR COLUMNS TO BE REMOVED. ALL BARE STRUCTURAL STEEL TO BE REPROOFED. ALL CRACKS TO BE FILLED WITH NON-SHRINK GROUT.

18. ALIGN THE FACE OF AN INTERIOR PARTITION WITH THE EDGE OF THE WINDOW JAMB AT LOCATIONS WHERE THE INTERIOR PARTITION MEETS THE EXTERIOR WALL ASSEMBLY, UNLESS OTHERWISE NOTED.

SPECIFIC CONSTRUCTION NOTES

1. AT THE INTERIOR FACE OF WALL ALONG THE PERIMETER PROVIDE FRAMING AS SCHEDULED WITH TYPE X GYPSUM BOARD AND INSULATION.

2. PROVIDE NEW LOUVER. REFER TO F3/1-A506.

3. PROVIDE NEW CONVECTOR ENCLOSURE AND WINDOW SILL. REFER TO DETAIL F8/1-A506.

4. NEW CONCRETE CURB. ALIGN NEW CURB WITH EXISTING COLUMN ENCLOSURE IN PLAN. MATCH HEIGHT TO EXISTING ADJACENT CONCRETE CURB HEIGHT. REFER TO DETAIL F8/1-SJ001.

5. NEW SLAB INFILL. REFER TO DETAIL E6/1-SJ001.

6. REPAIR EXISTING CONCRETE SLAB. REFER TO DETAIL C8/1-SJ001. COORDINATE WITH MECHANICAL DWGS.

7. NEW MECHANICAL SHAFT INFILL. REFER TO DETAIL E8/1-SJ001. COORDINATE WITH MECHANICAL DWGS.

8. EXISTING CONCRETE CURB TO REMAIN.

9. PROVIDE AND INSTALL EXTENSION BACK BOXES FOR ALL ELEVATOR CALL BUTTON ASSEMBLIES AND CALL LIGHTS, AND EXTEND CONDUIT AND POWER TO BE FLUSH WITH NEW FACE OF ELEVATOR WALL.

10. NEW SECURITY GRILLE. REFER TO B1/1-A502 AND C1/1-A503.

11. NEW FIRE EXTINGUISHER CABINET. REFER TO SHEET 1-A502 FOR DETAILS.

12. NEW WALL ACCESS PANEL. REFER TO B8/1-A503.

13. AT 9TH FLOOR, PAINT ALL EXPOSED PIPING WITH NEW COAT OF PAINT TO MATCH EXISTING. SPRINKLER PIPING TO BE PAINTED RED.

14. EXISTING FIRE ALARM PANEL TO REMAIN.

15. NEW 4" HOUSEKEEPING PADS. COORDINATE LOCATION W/ MECHANICAL DRAWINGS. REFER TO DETAIL F8/1-SJ001.

16. NEW DRINKING FOUNTAIN (SEE PLUMBING DWGS).

17. NEW RADIATOR ENCLOSURE. REFER TO DETAIL F1/1-A506.

18. NEW FIN TUBE ENCLOSURE. REFER TO DETAIL B8/1-A506.

19. NEW 2HR RATED SLAB INFILL WITH OPENING FOR DUCTWORK. SEE MECHANICAL DWG 1-AE401 FOR ADDITIONAL INFORMATION INCLUDING FIRE DAMPER.

20. PROVIDE ACCESS PANEL IN NEW PARTITION FOR EXISTING ELECTRICAL WIRE WAY. REFER TO ELECTRICAL DRAWINGS FOR ADDITIONAL INFORMATION. COORDINATE EXACT SIZE /LOCATION WITH EXISTING EQUIPMENT.

21. PROVIDE 2 HOUR RATED ACCESS PANEL IN EXISTING PARTITION. CONTRACTOR TO VERIFY EXACT SIZE IN FIELD.


22. FOR LOCATIONS WHERE EXISTING STRUCTURAL STEEL BEAM CONCRETE ENCASMENT IS MISSING DUE TO PLUMBING PIPING, REFER TO DETAIL C6/1-A502. CONTRACTOR TO FIELD VERIFY.


BUILDING IS FULLY SPRINKLERED


Scale: 1/8"=1'-0"

















<div><div><div></div><div>F1</div></div><div>ENLARGED PLAN 9TH FLOOR - WEST</div><div>SCALE: 1/8" = 1'-0"</div></div>		<div>CONSULTANTS:</div> <div>ASBESTOS ABATEMENT CONSULTANT:</div> <div>Egan Environmental Consulting, Inc.</div> <div>14 HIGH STREET</div> <div>MAHWAH, NEW JERSEY 07430</div> <div>Tel: (201) 848-7790 Fax: (201) 848-7791</div>		<div>KEY PLAN:</div> <div></div>		<div>ARCHITECT/ENGINEERS:</div> <div>CANNONDESIGN</div> <div>360 Madison Avenue, New York, New York 10017 212.972.9800</div> <div>Baltimore • Boston • Buffalo • Calgary • Chicago</div> <div>Houston • Los Angeles • Mumbai • New York • Phoenix</div> <div>St. Louis • San Francisco • Shanghai • Toronto</div> <div>Vancouver • Victoria • Washington DC</div>		<div>Drawing Title</div> <div>ENLARGED PLAN 9TH FLOOR - WEST</div> <div>Approved Project Director</div>		<div>Project Title</div> <div>VA NY HARBOR HEALTHCARE SYSTEM</div> <div>MANHATTAN VAMC - BUILDING 1</div> <div>9TH FLOOR RENOVATIONS</div> <div>Location</div> <div>423 EAST 23RD STREET</div> <div>NEW YORK, NY 10010</div> <div>Date</div> <div>AUGUST 15, 2013</div> <div>Checked</div> <div>AH/DT</div> <div>Drawn</div> <div>CO</div>		<div>Project Number</div> <div>630PR2600</div> <div>Building Number</div> <div>1</div> <div>Drawing Number</div> <div>1-AE109-W</div> <div>Office of Construction & Facilities Management</div> <div>VA U.S. Department of Veterans Affairs</div>	
---	--	--	--	----------------------------------	--	--	--	---	--	--	--	--	--

VA FORM 08-6231 1 2 3 4 5 6 7 8 9

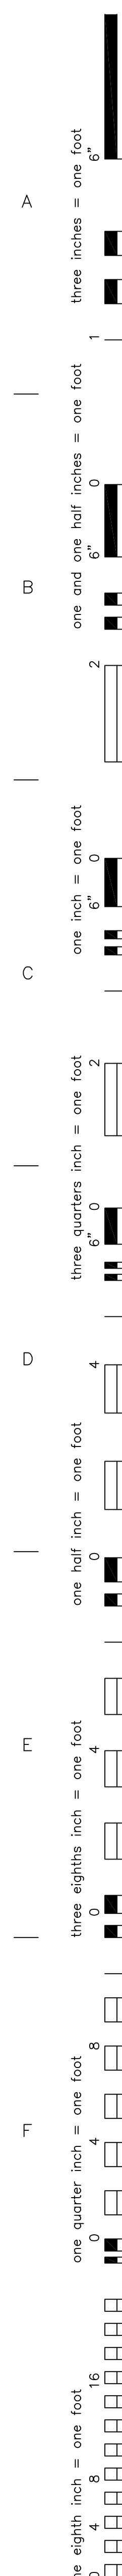

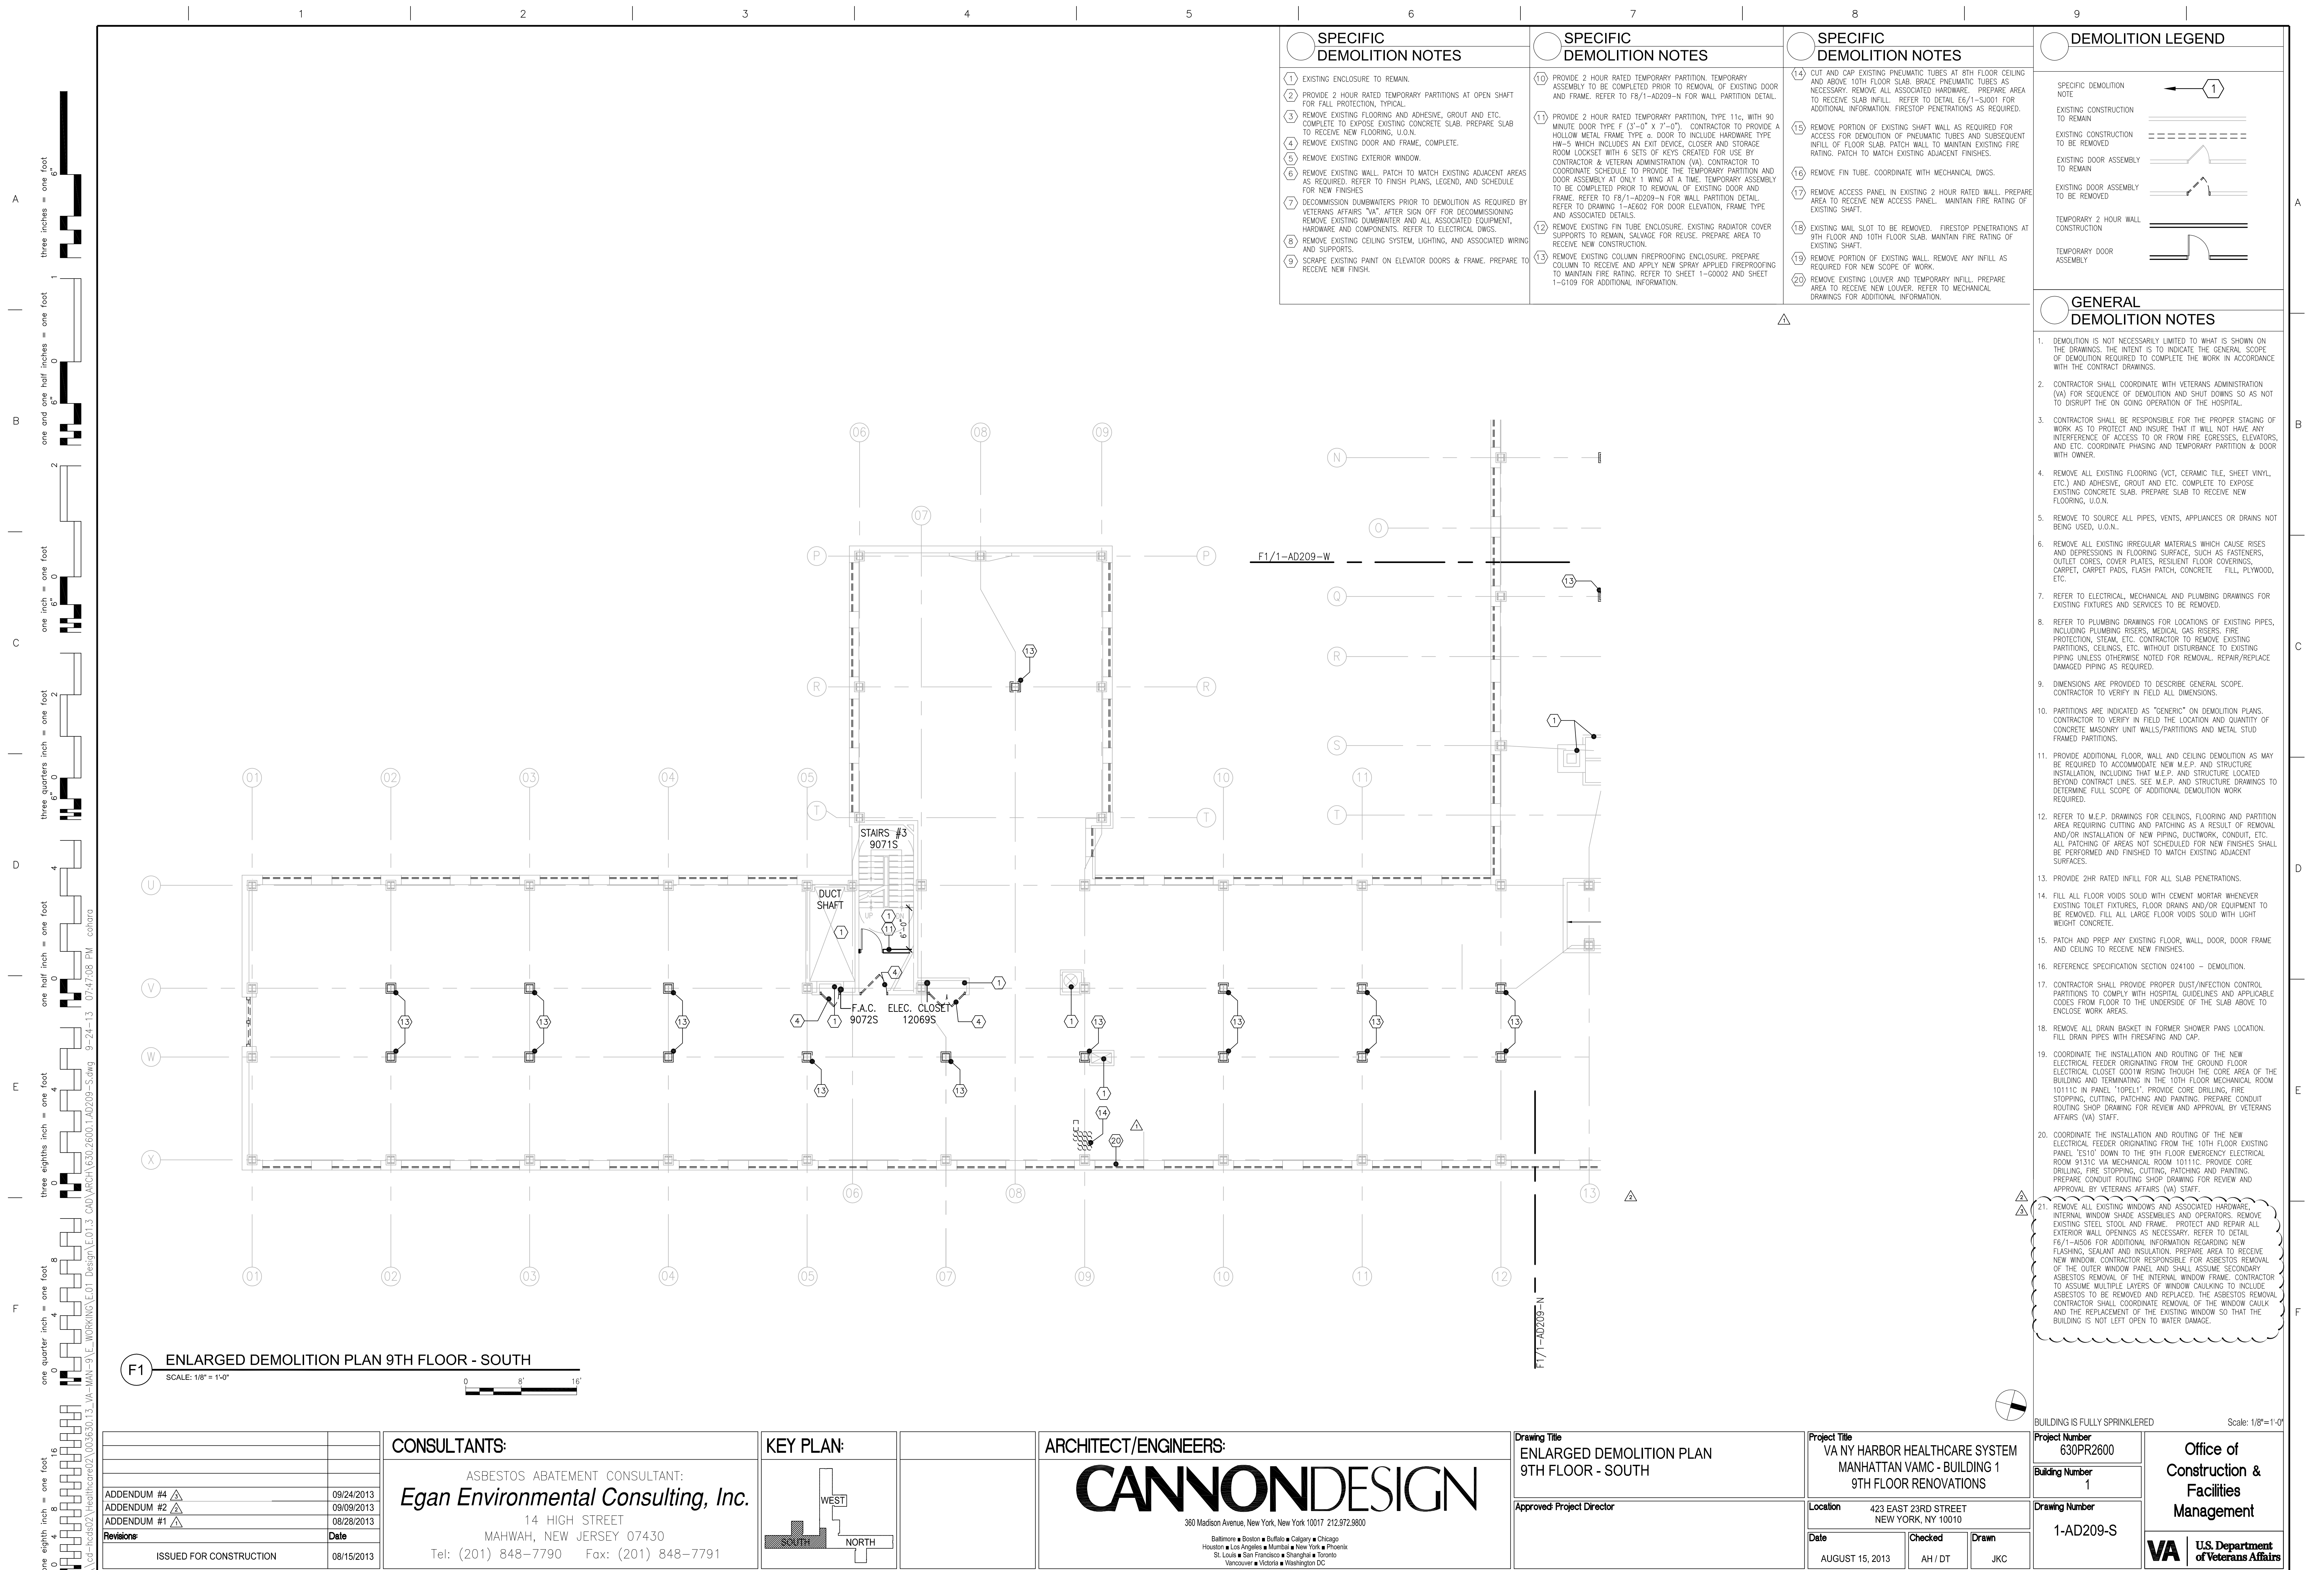

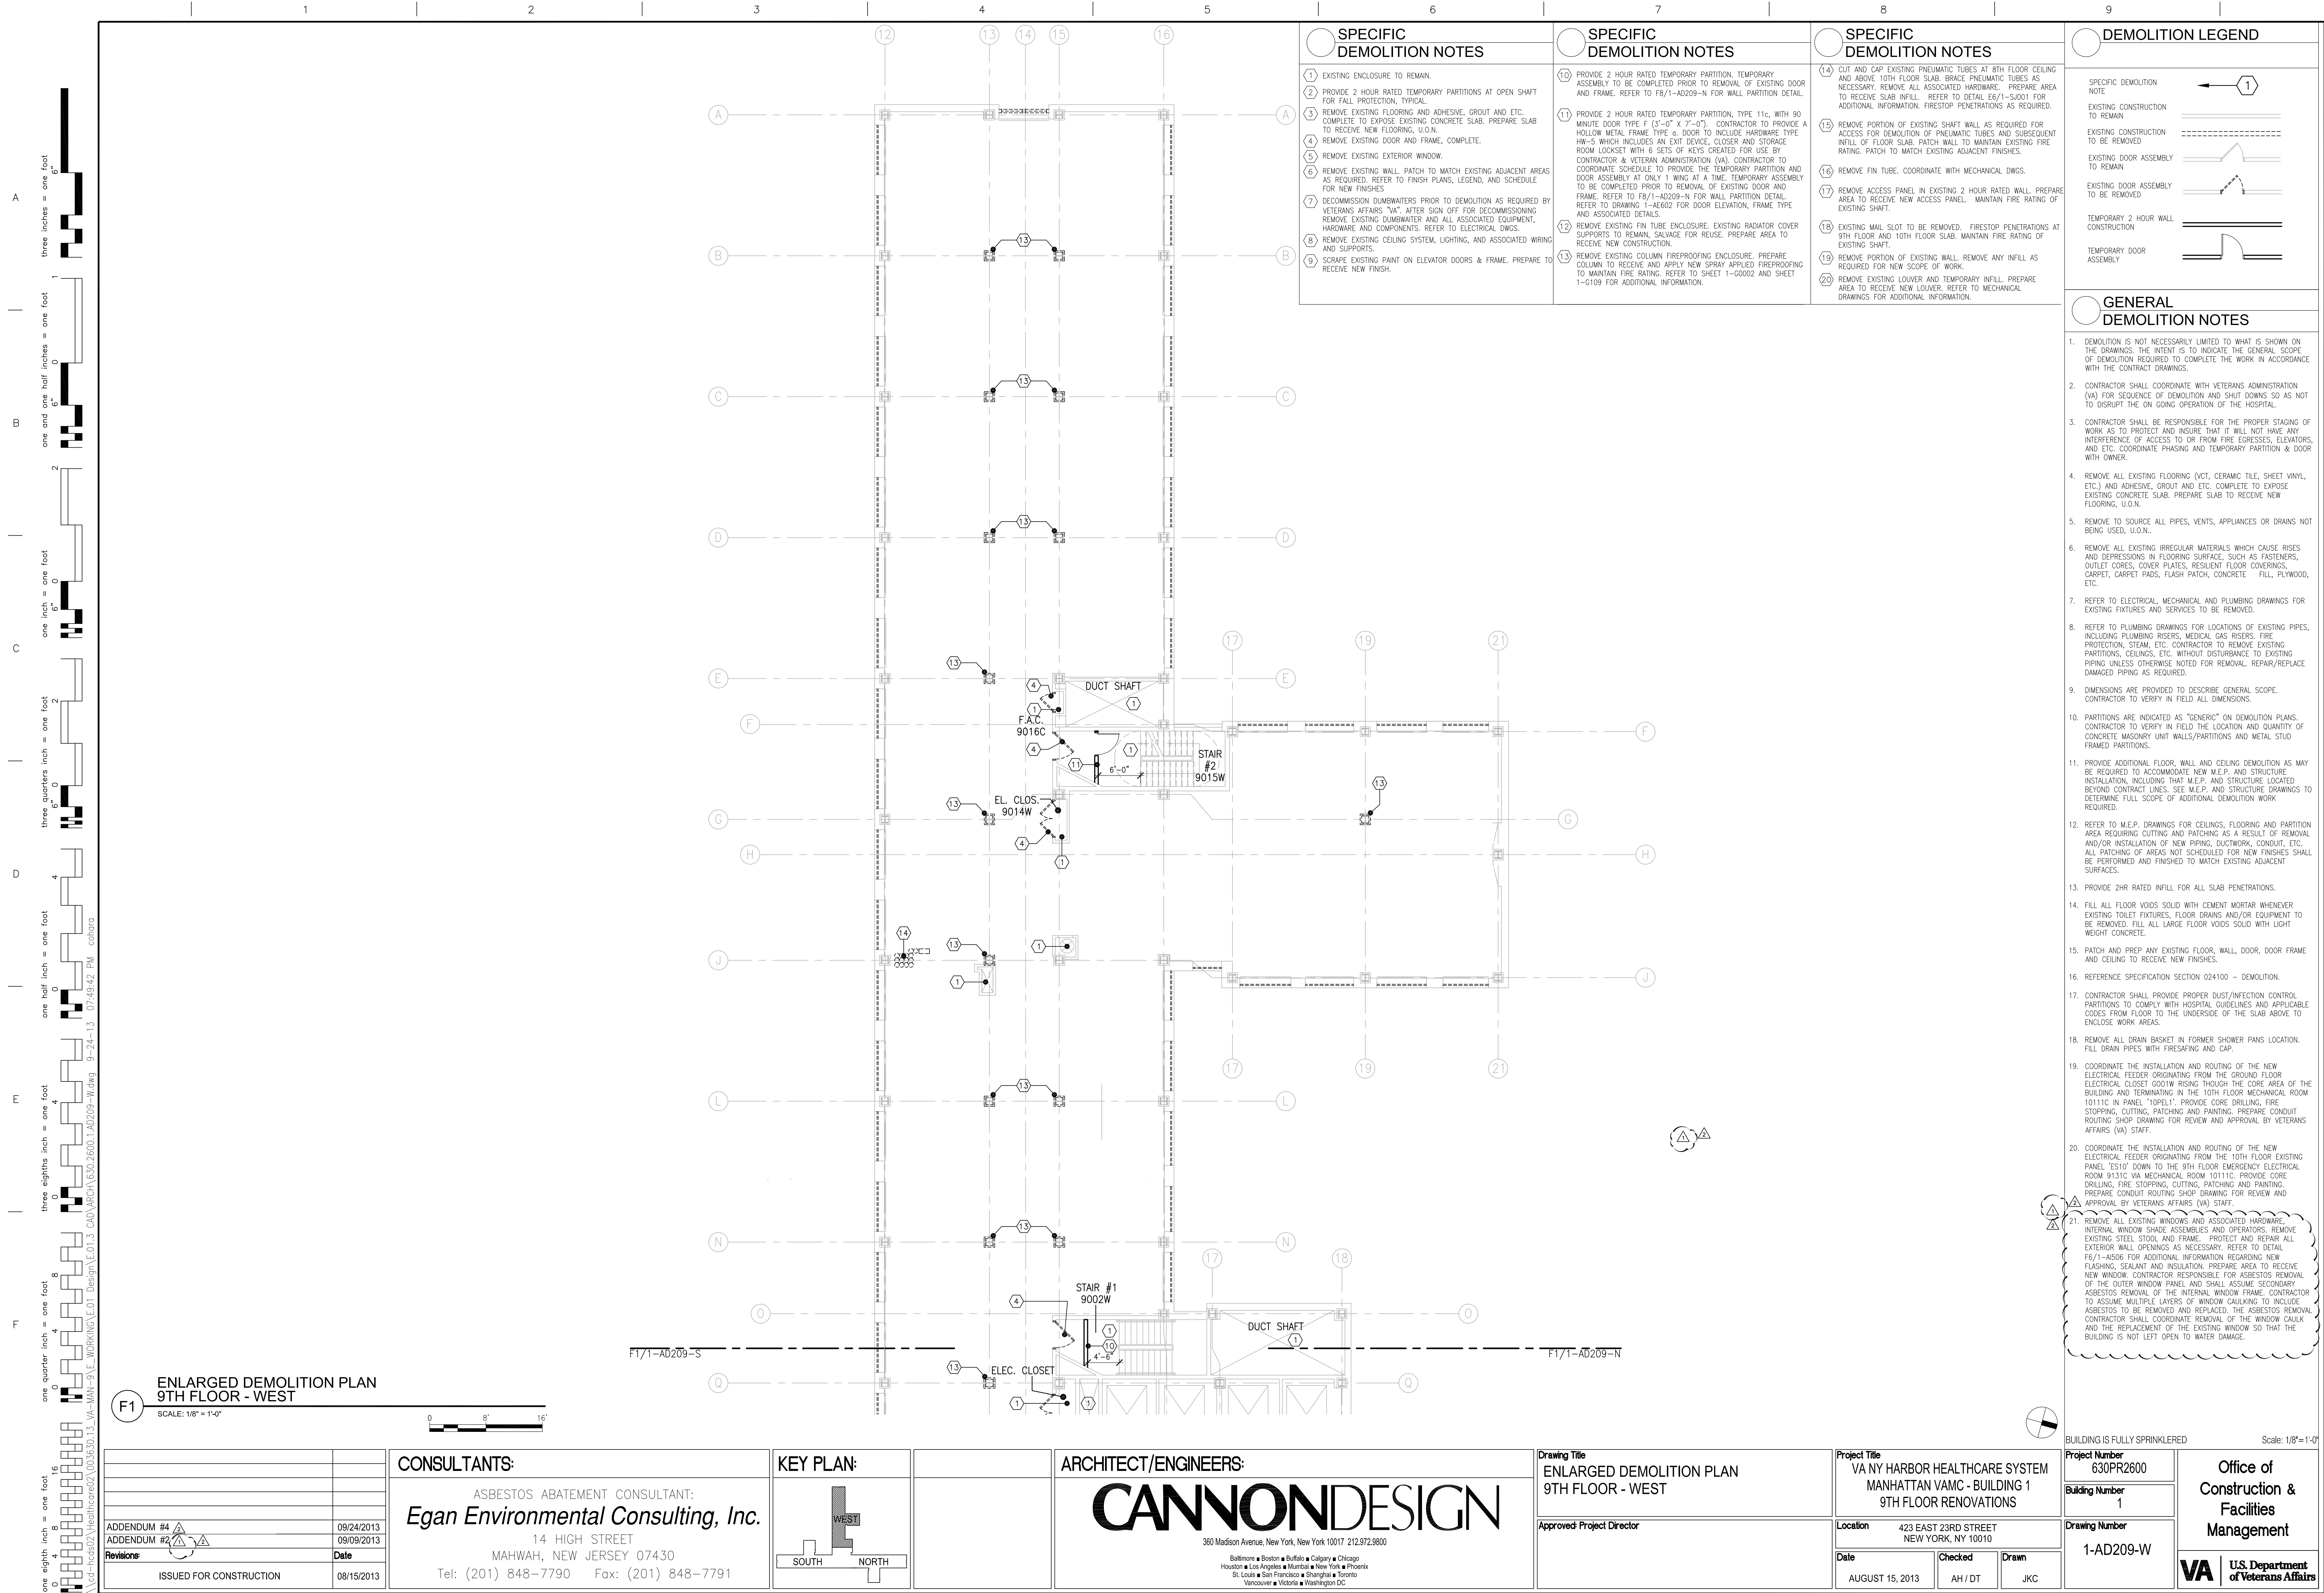

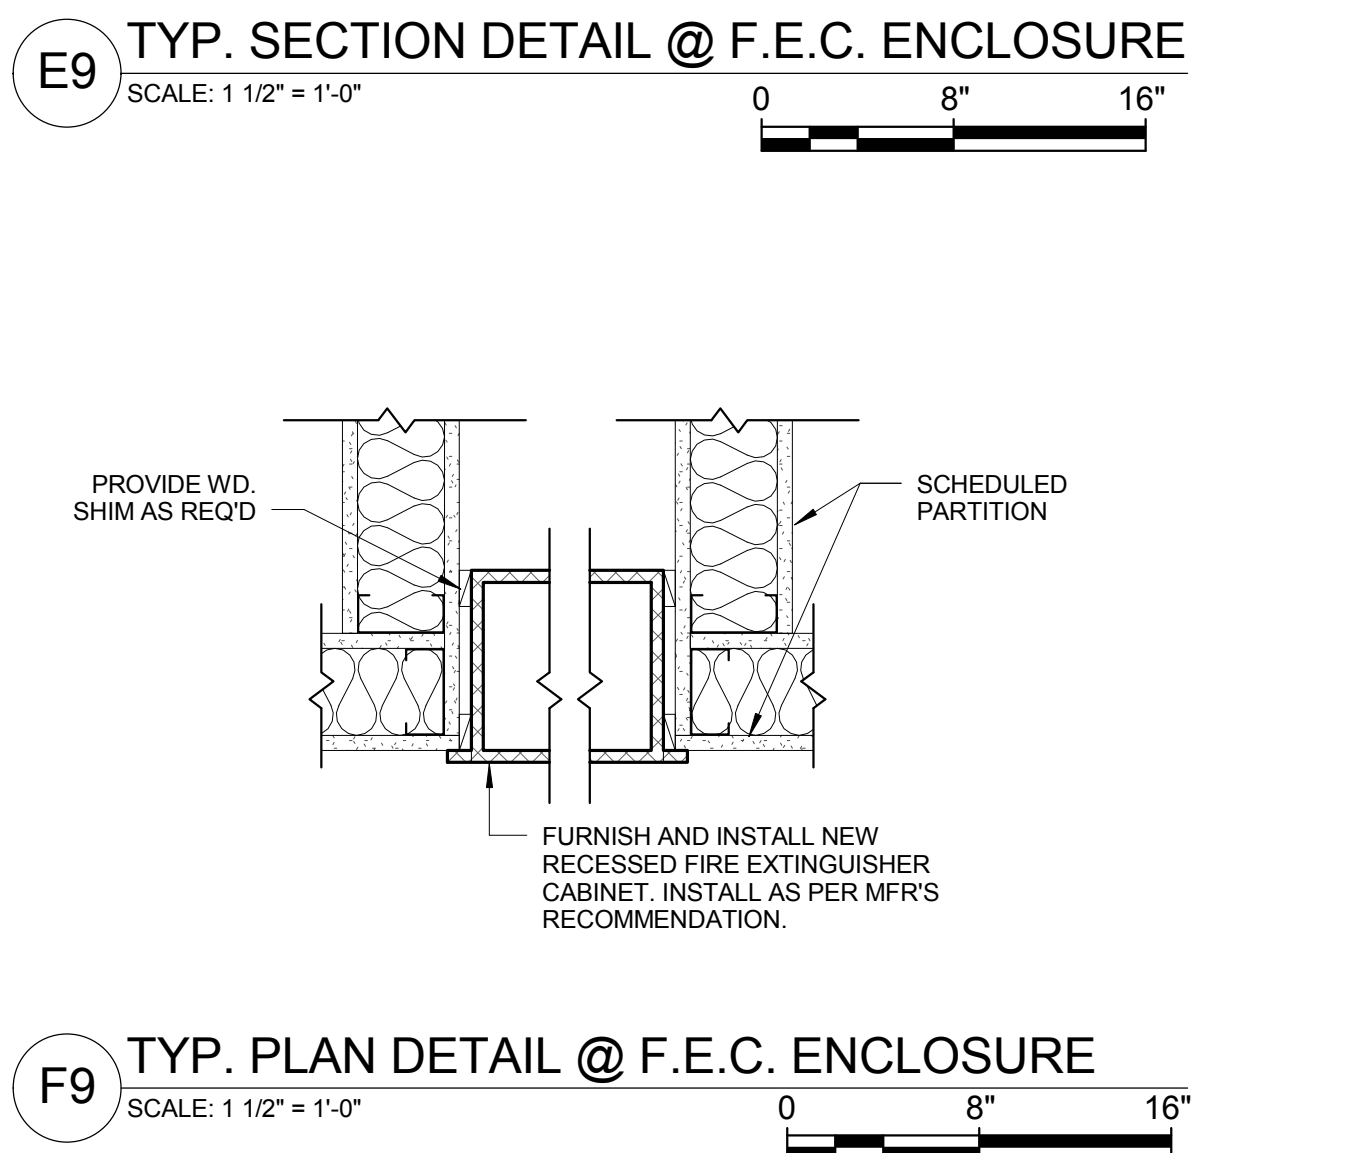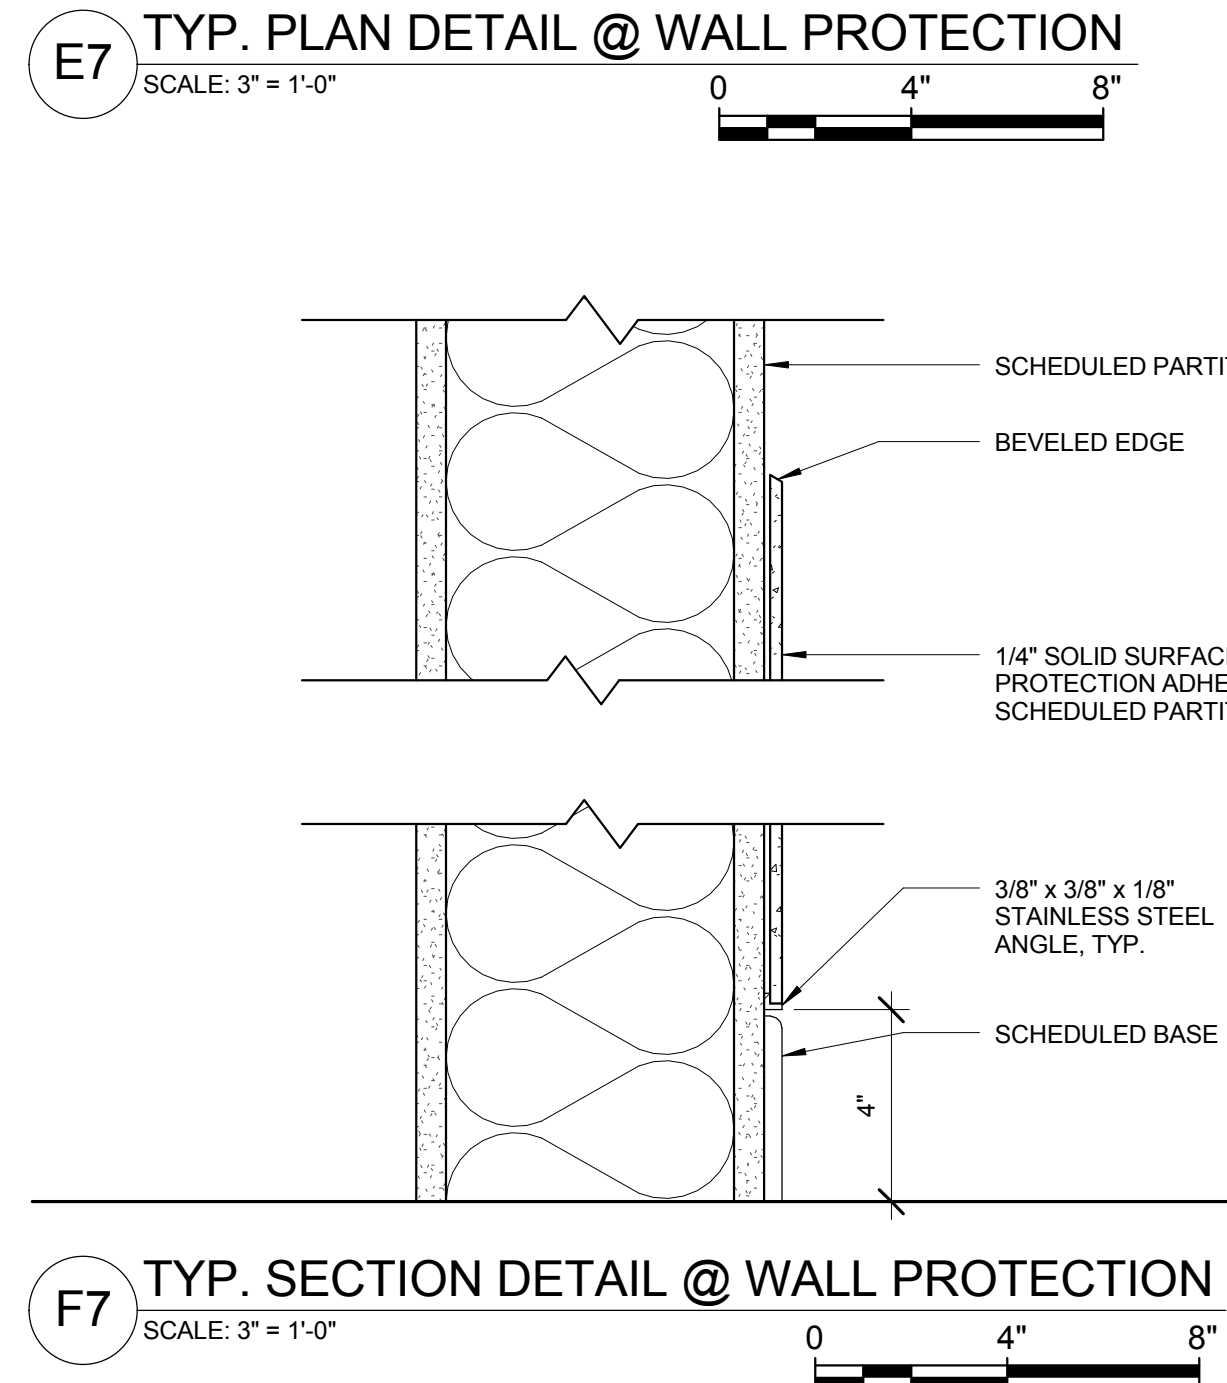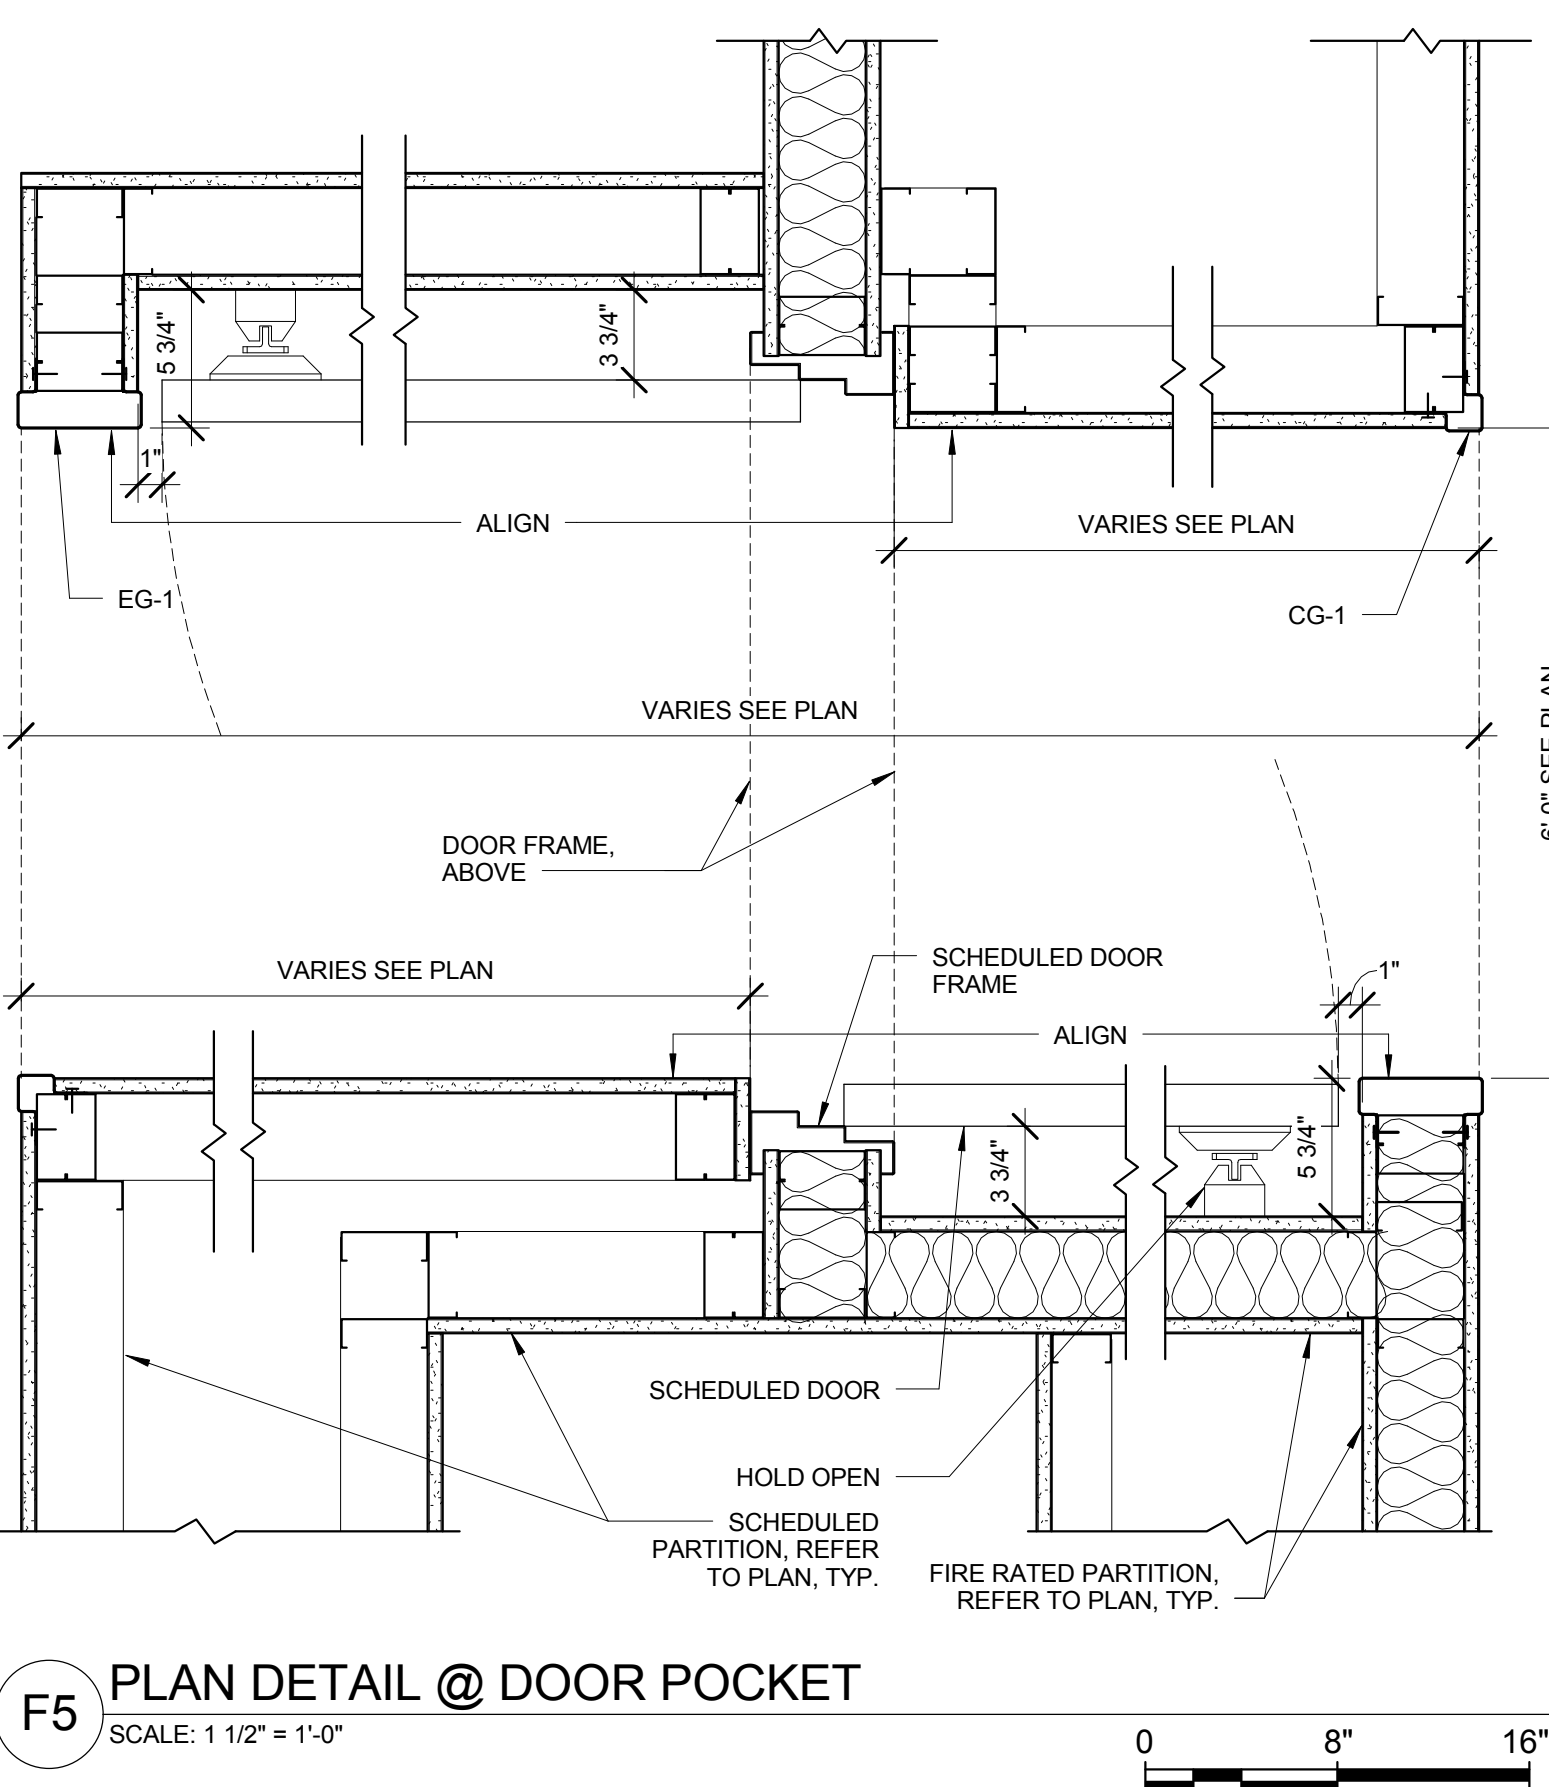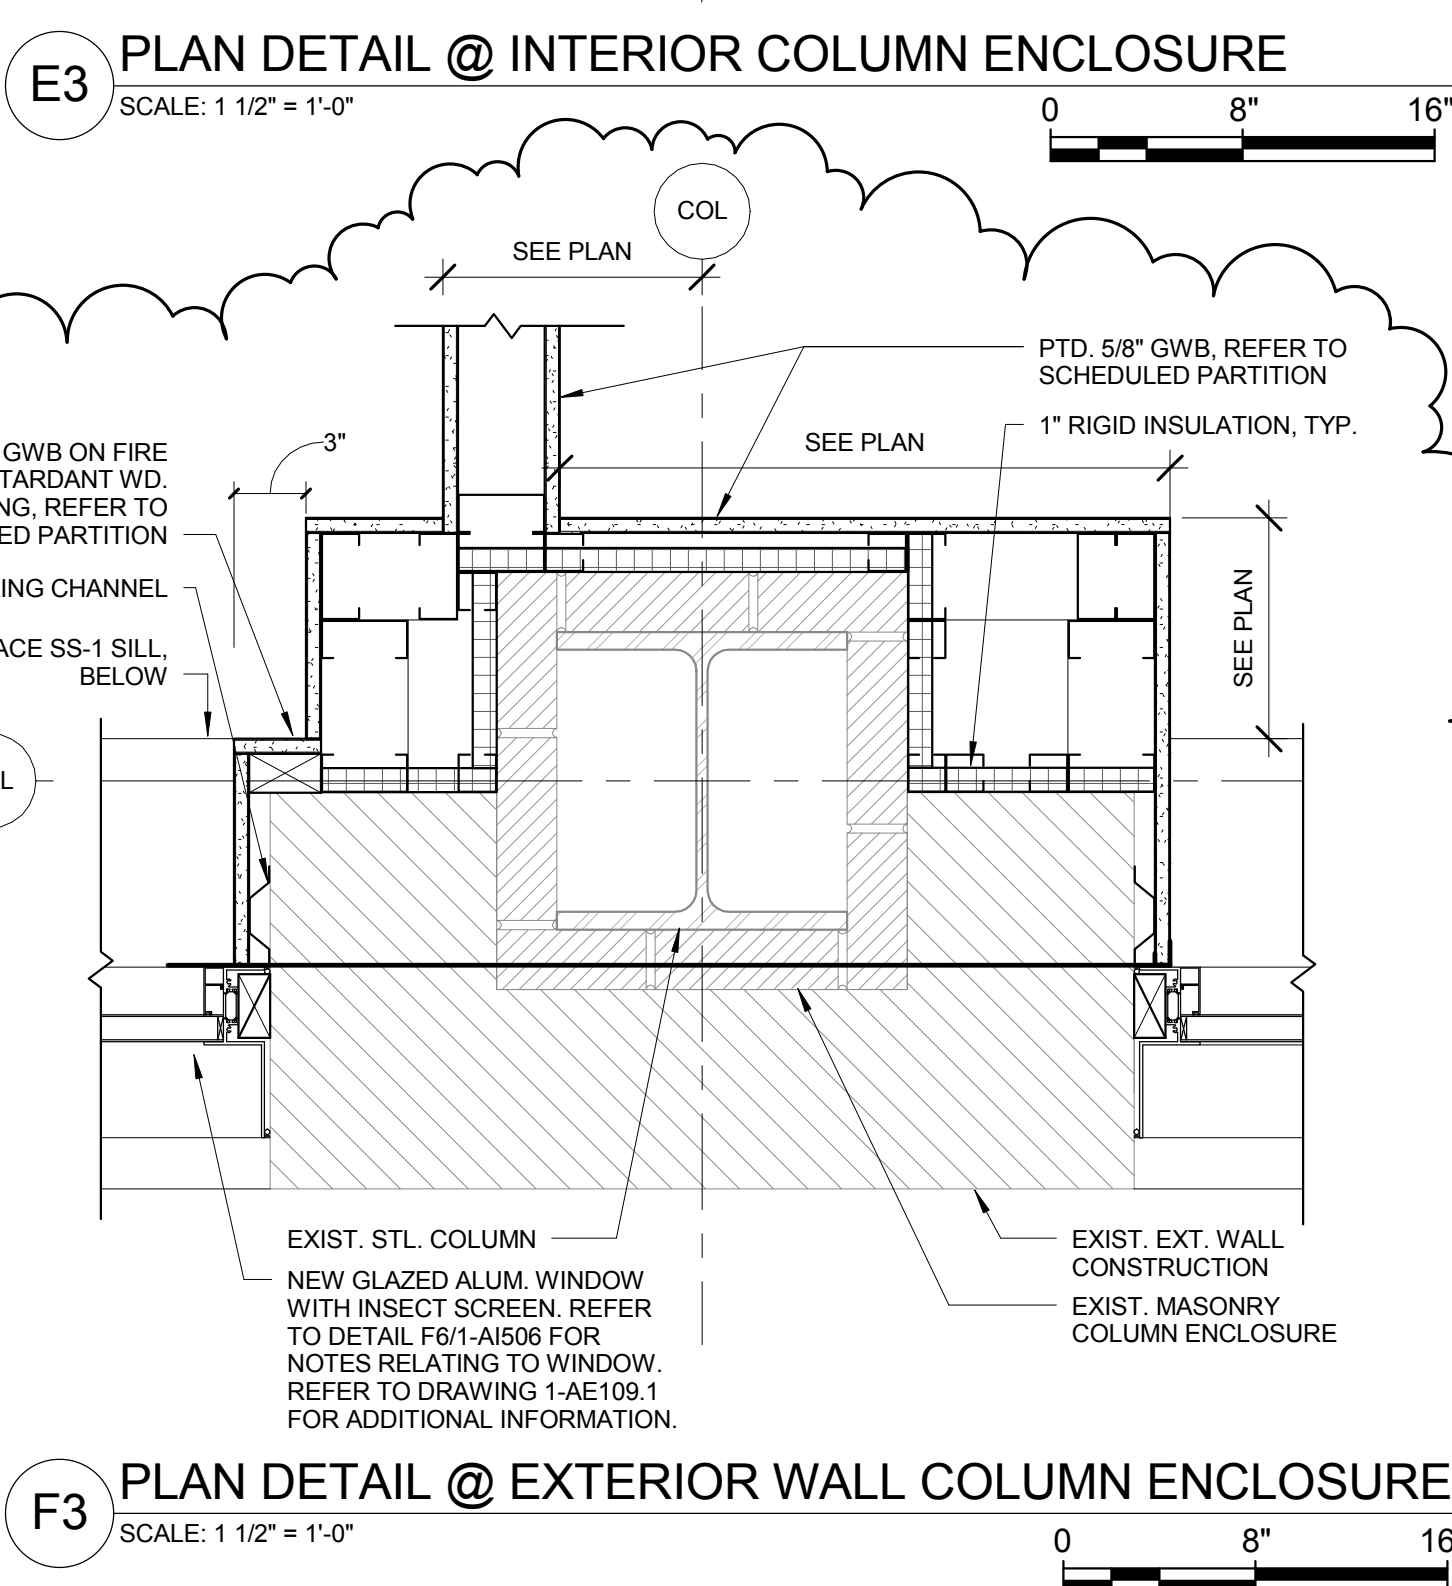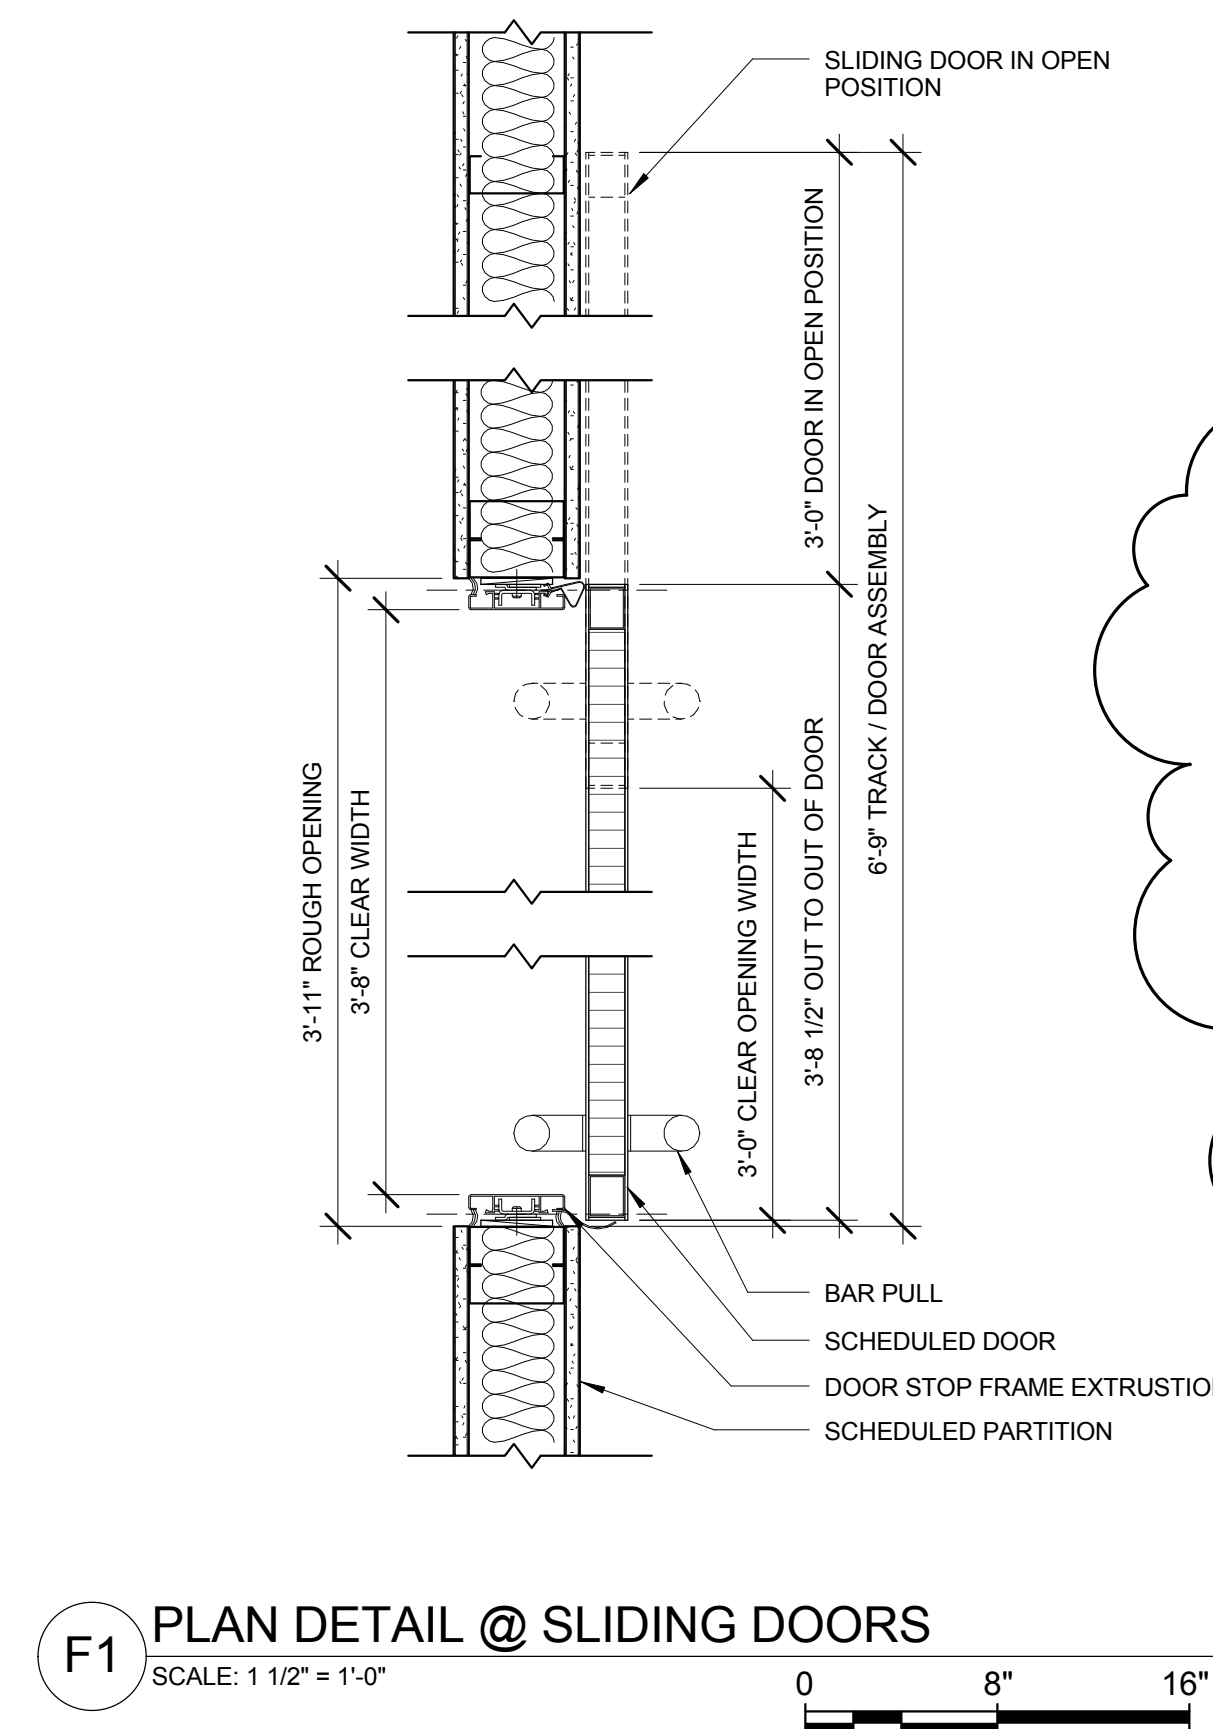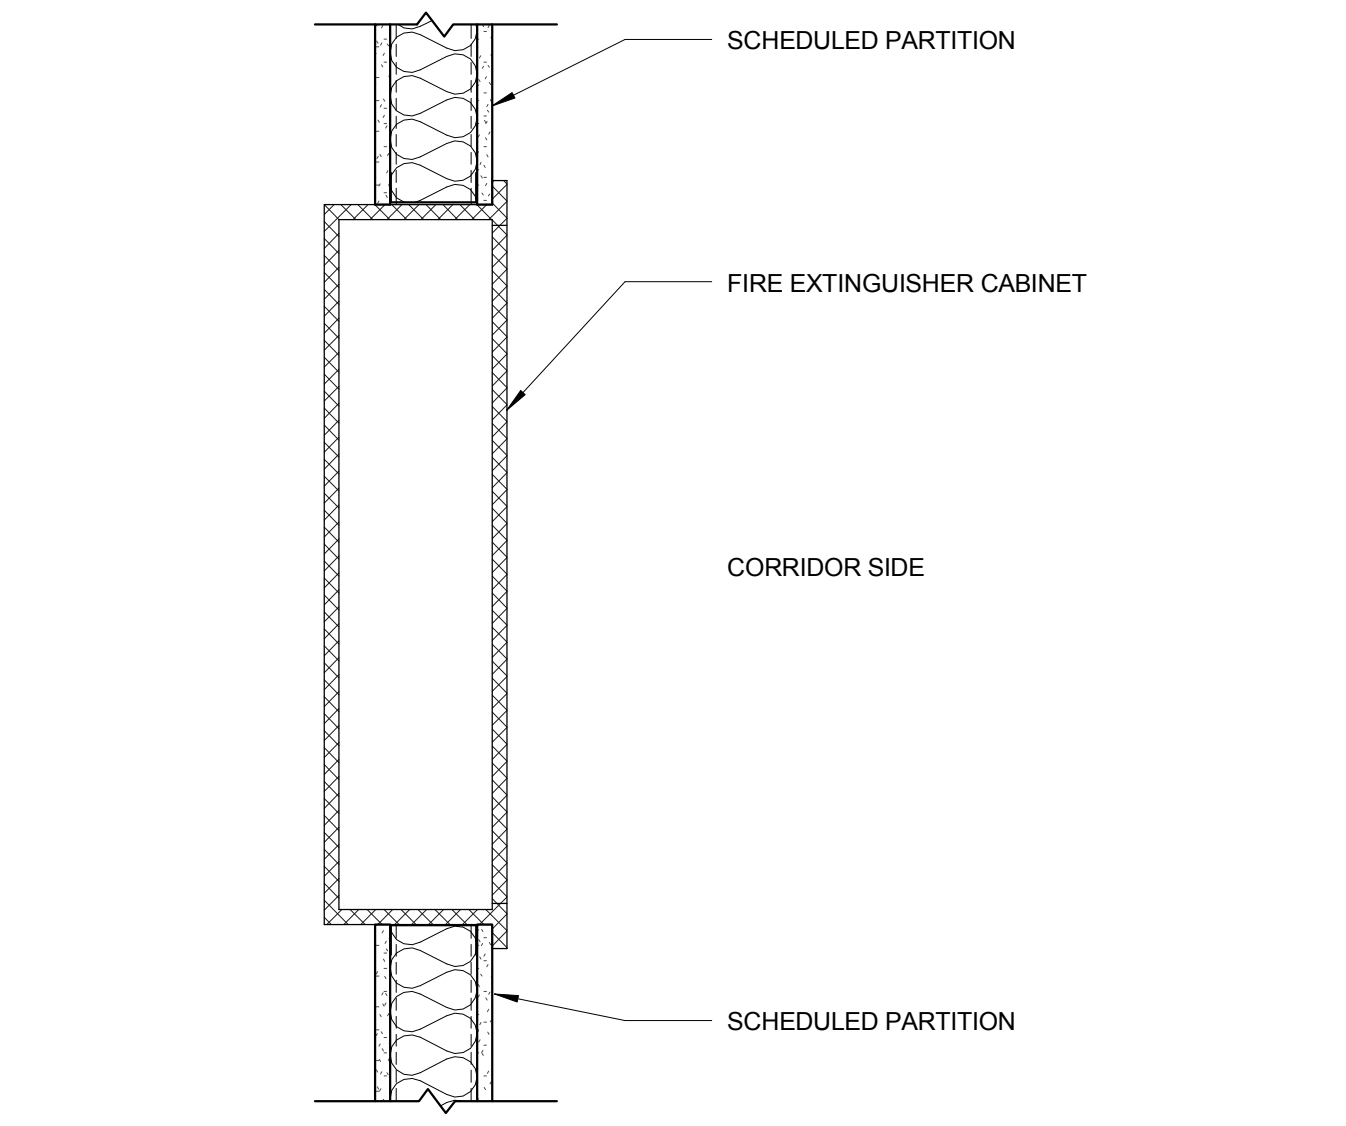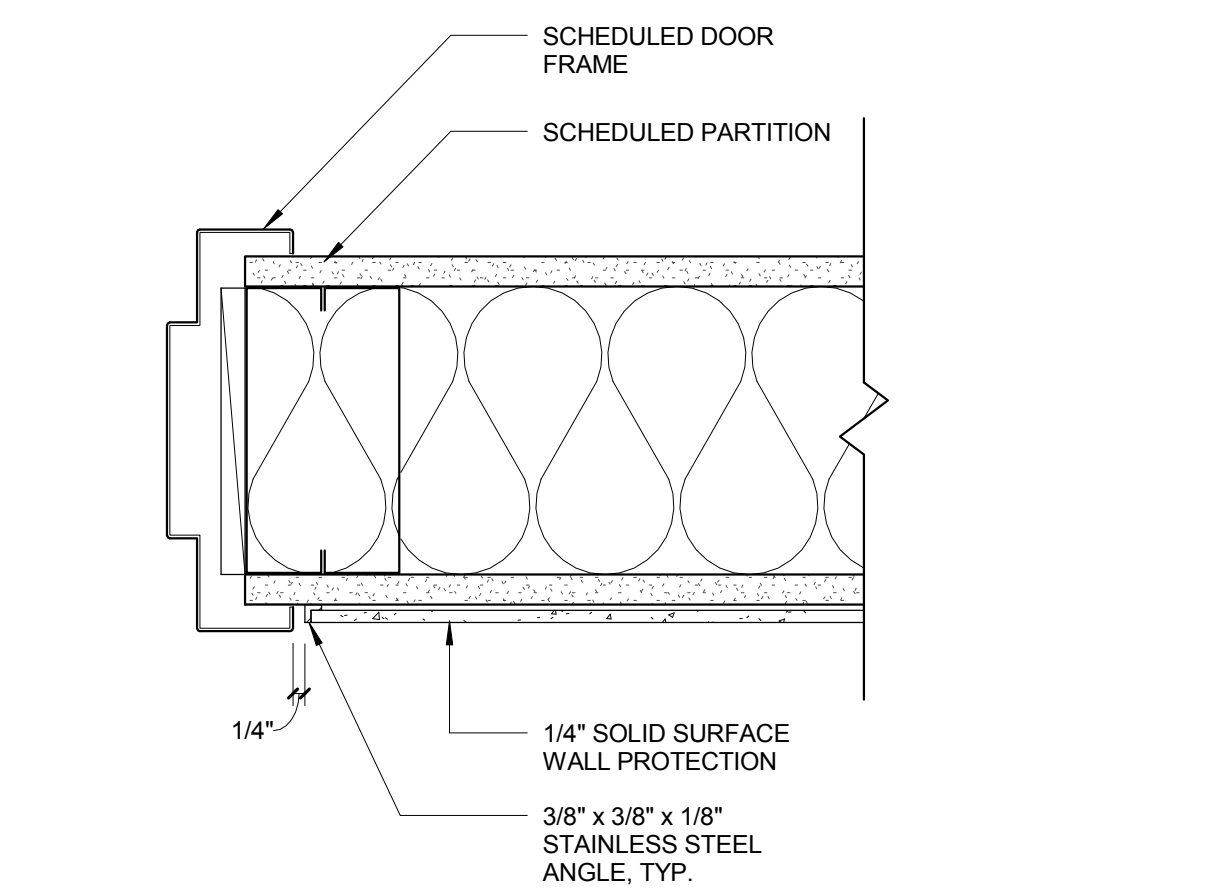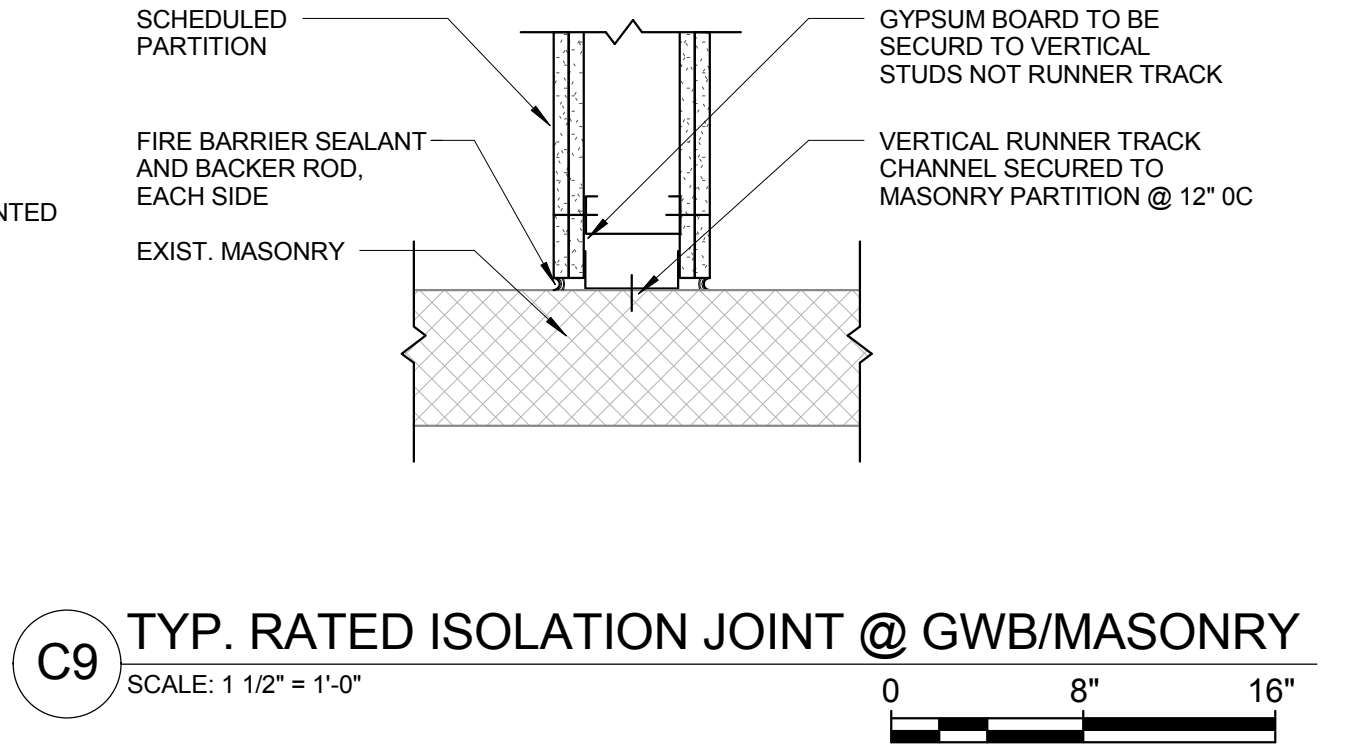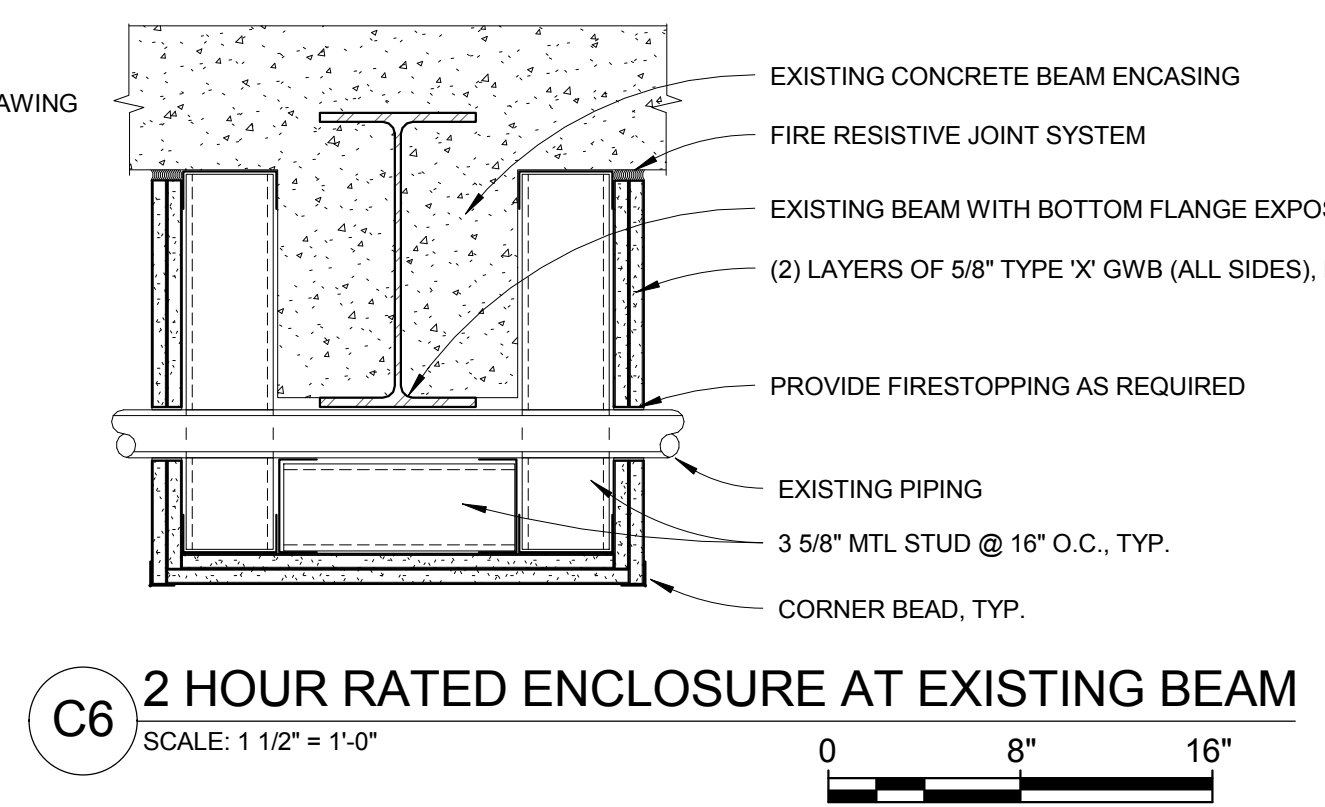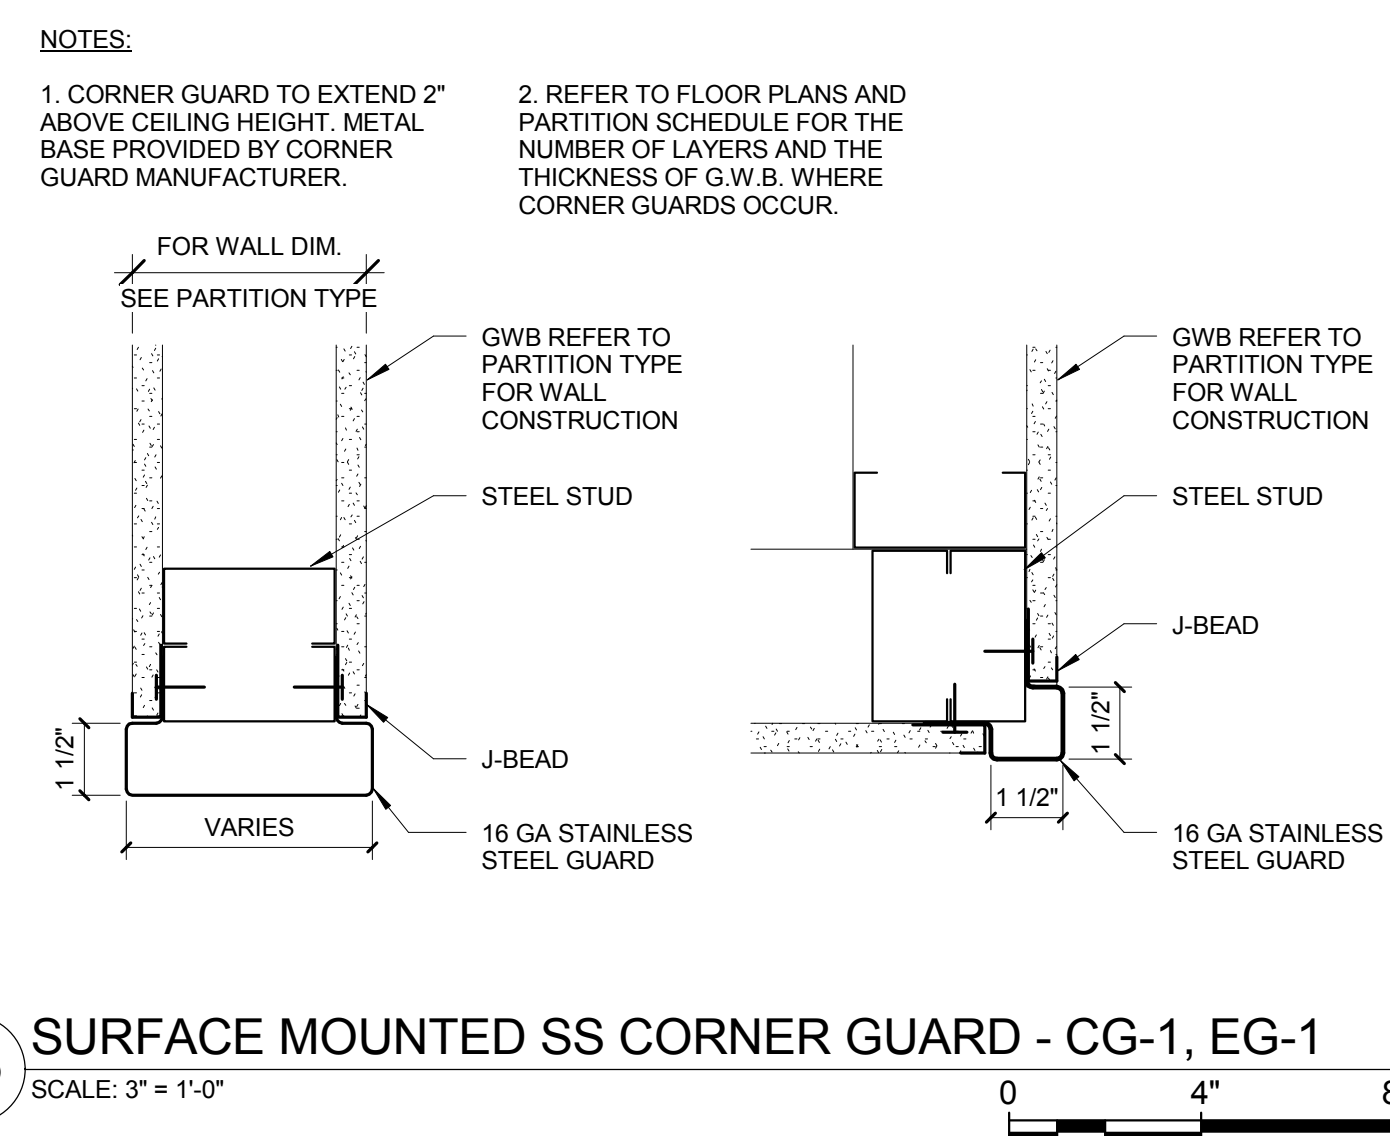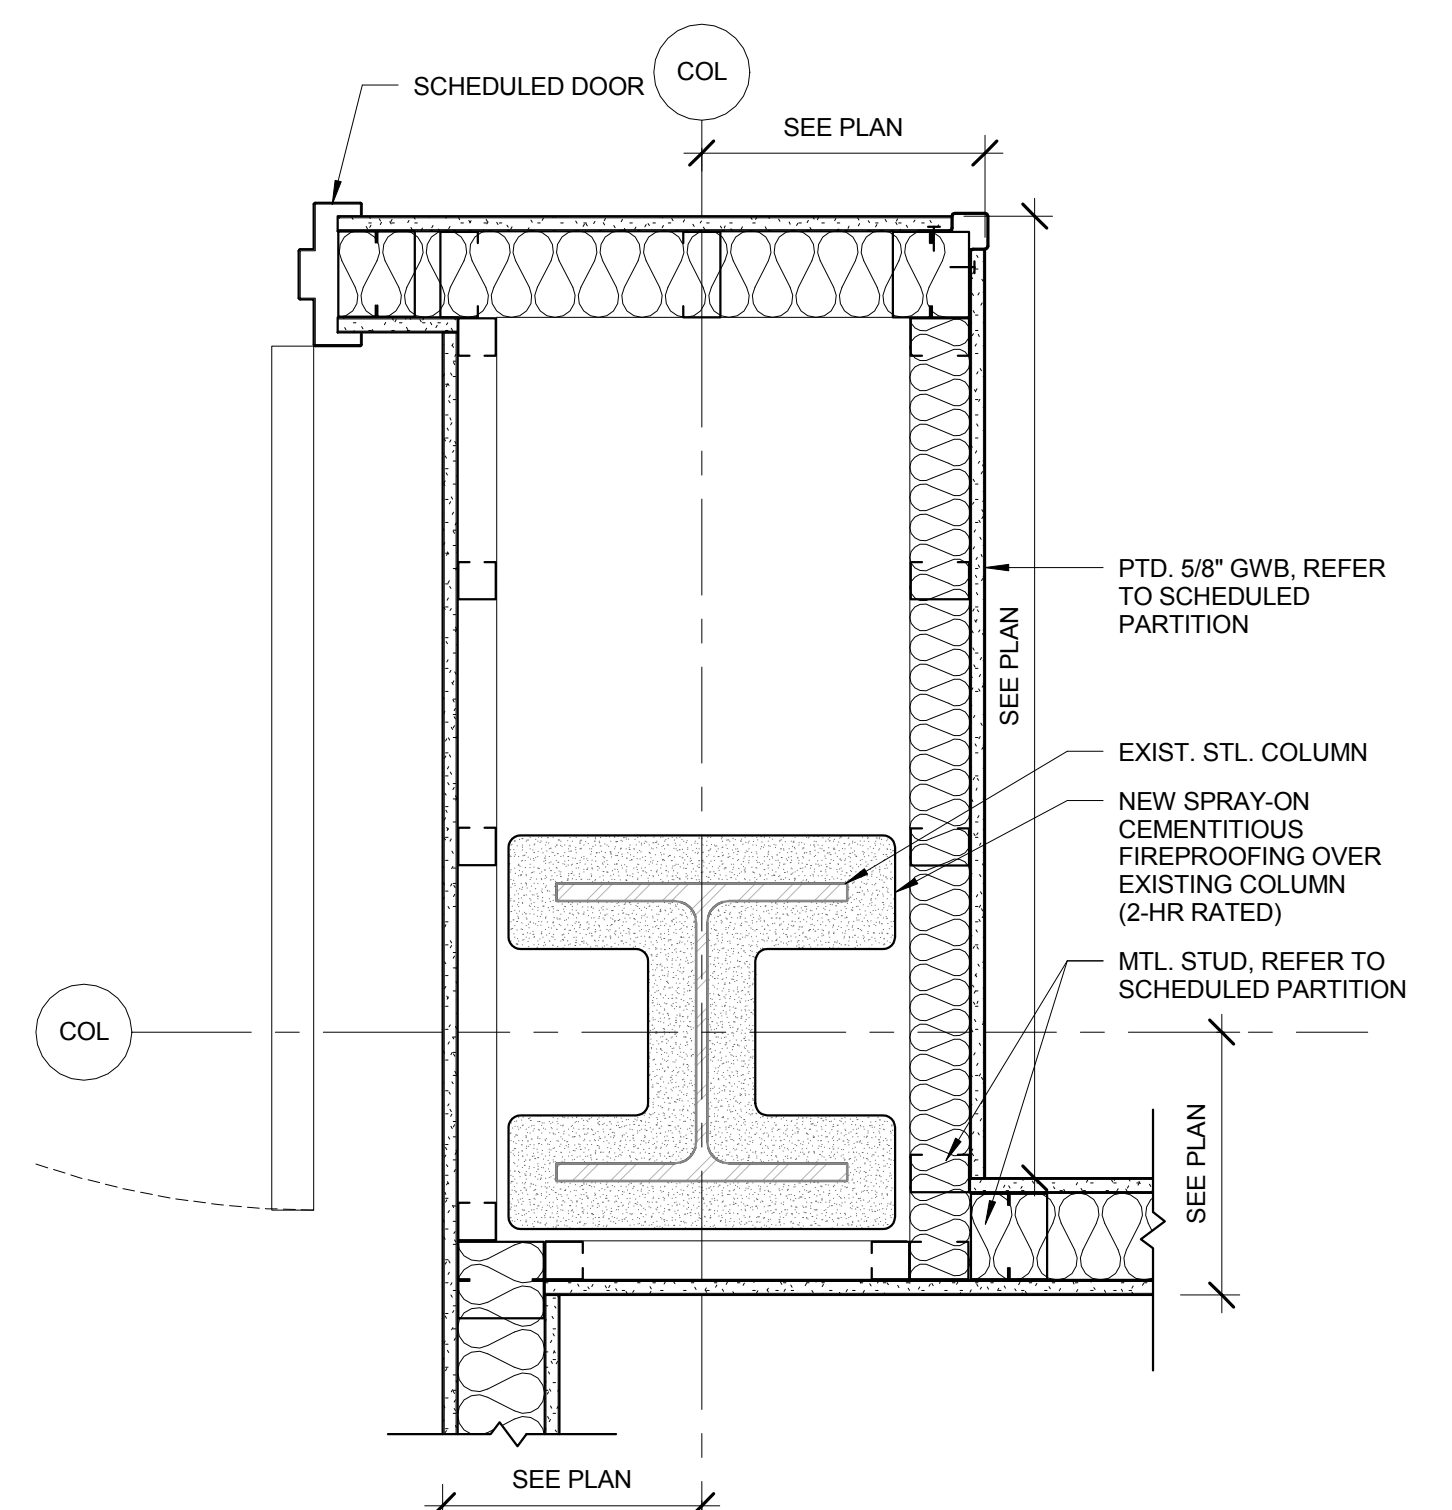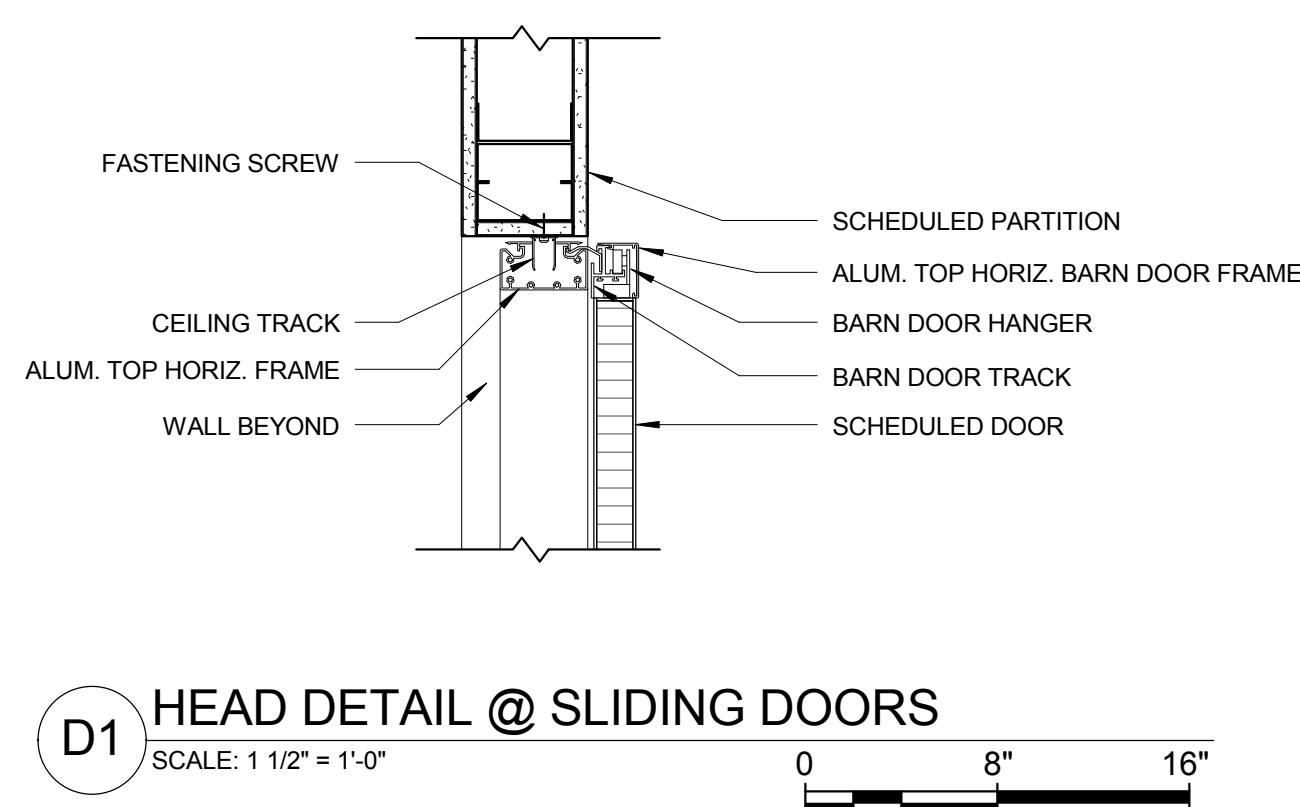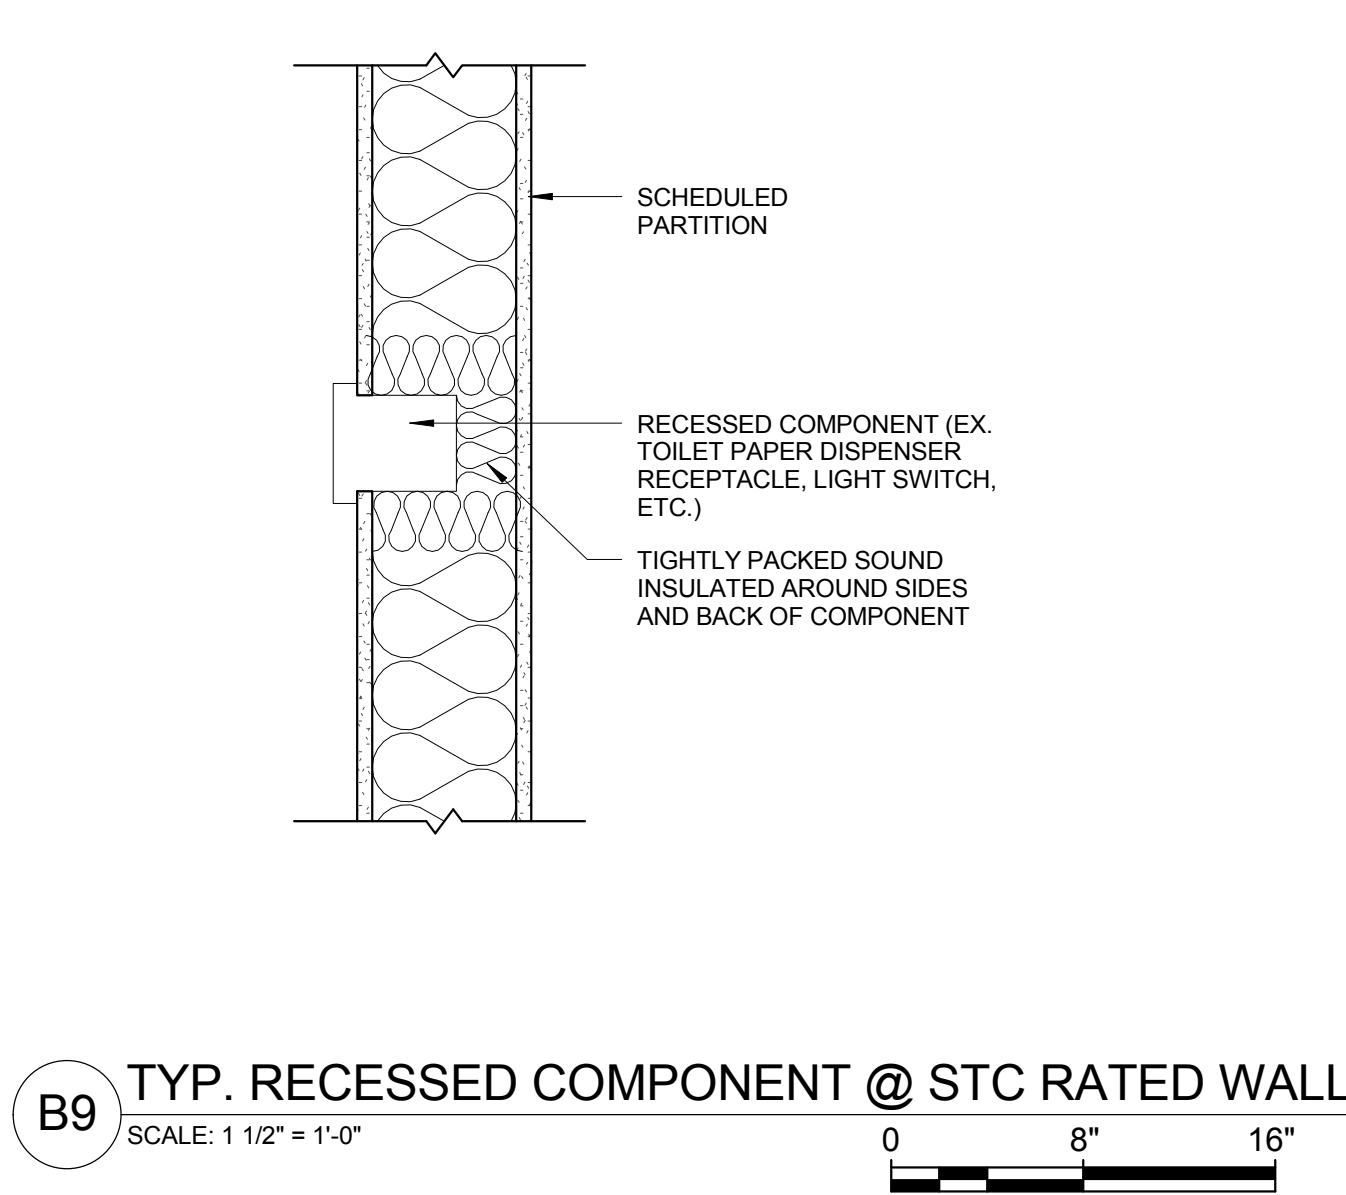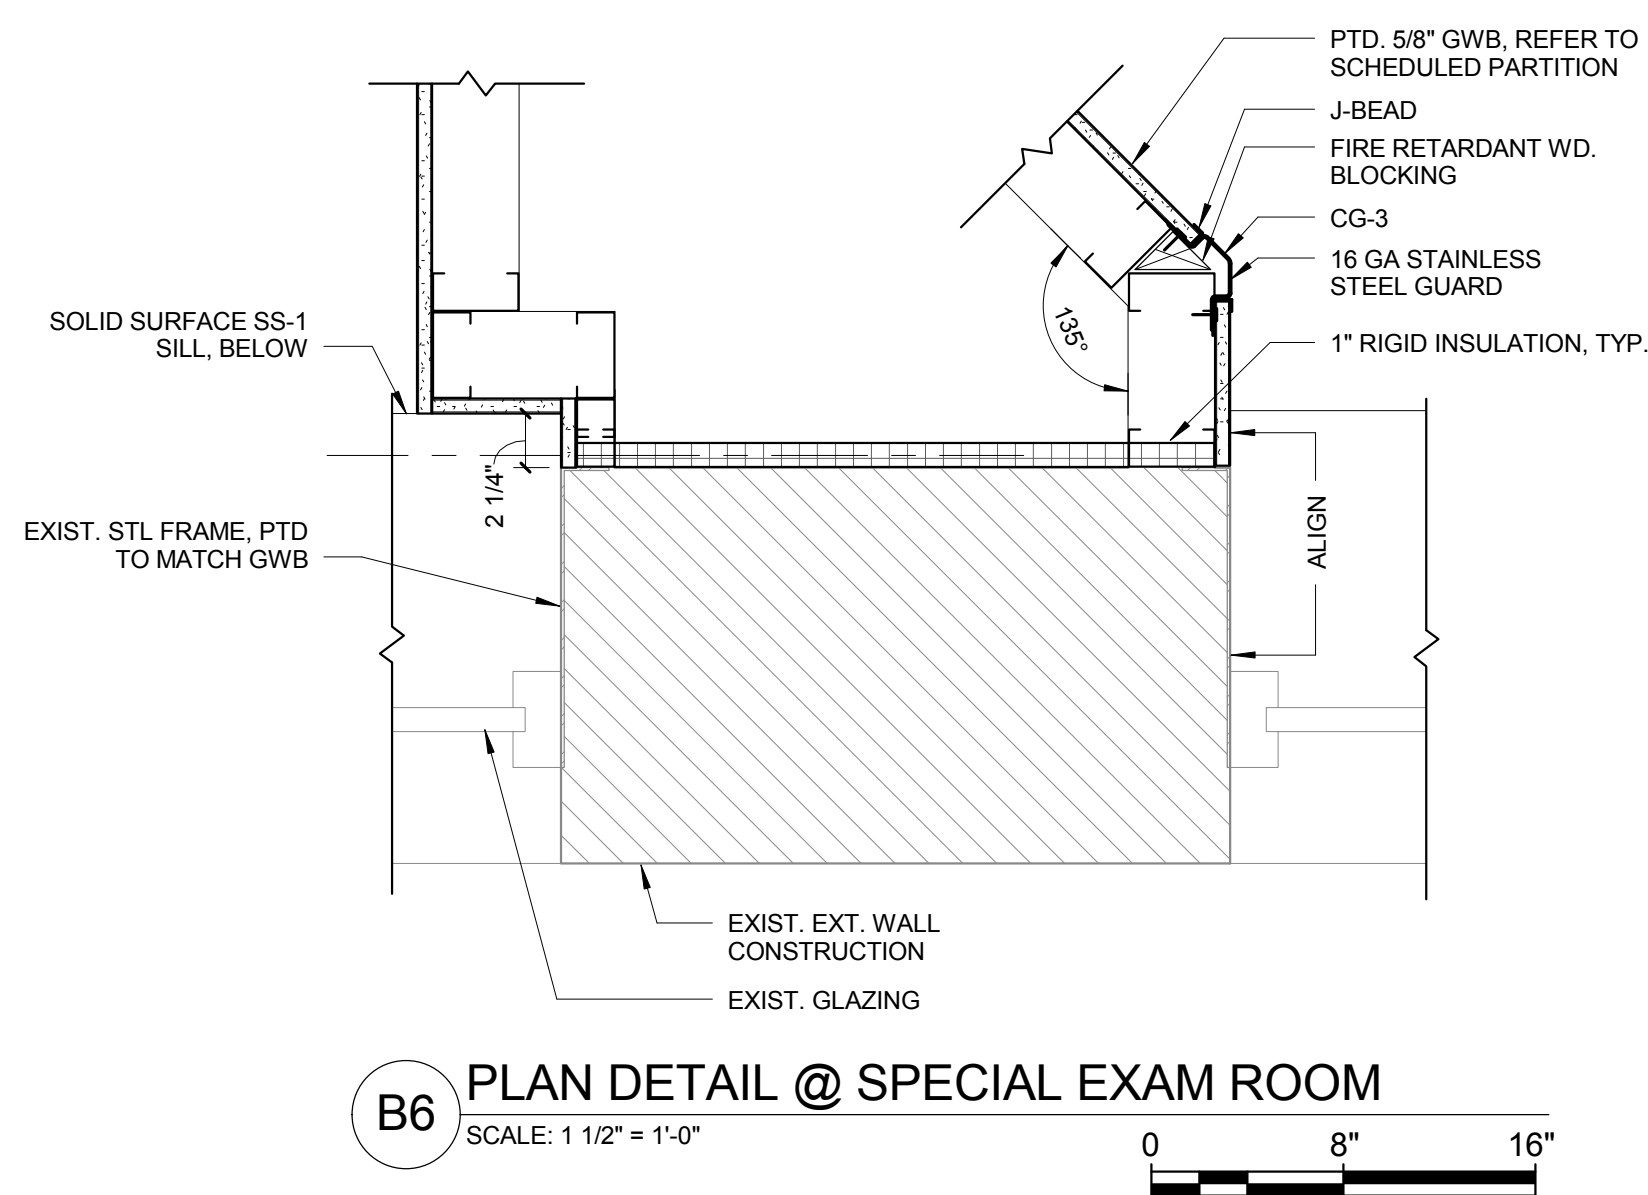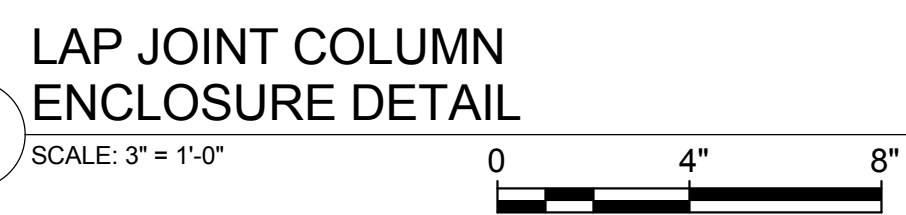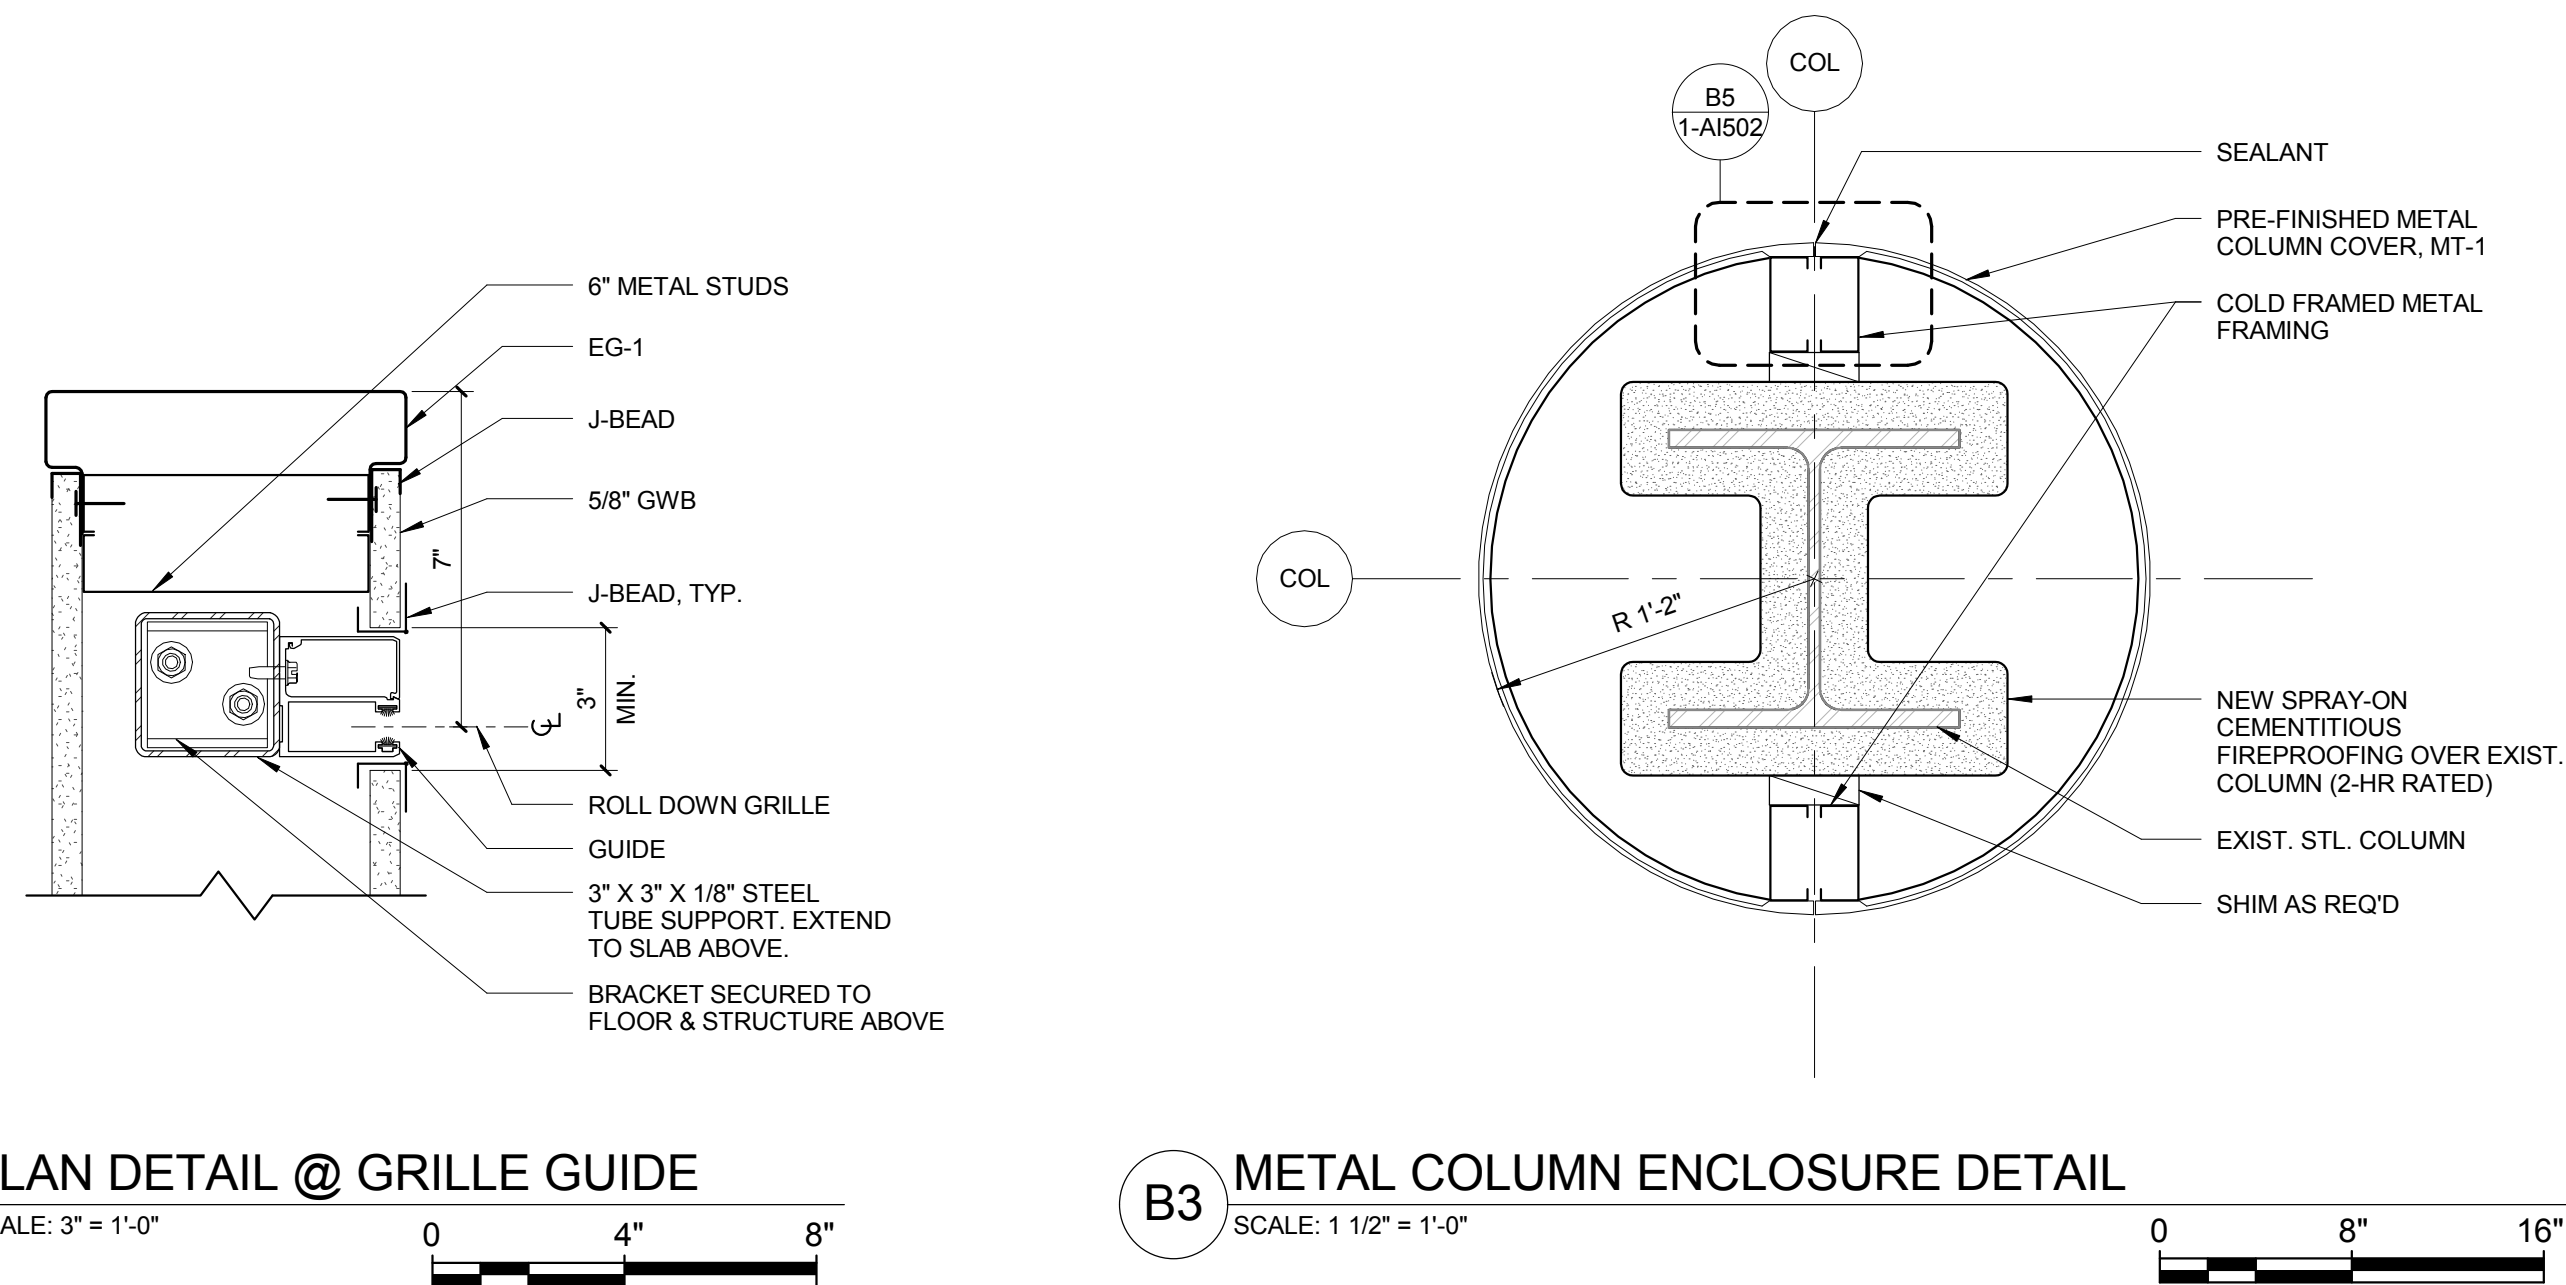

ADDENDUM #4	09/24/2013
ADDENDUM #3	09/12/2013
Revisions:	Date
ISSUED FOR CONSTRUCTION	

KEY PLAN:

ARCHITECT/ENGINEERS:

CANNONDESIGN

360 Madison Avenue, New York, New York 10017 212.972.9800

Baltimore ■ Boston ■ Buffalo ■ Calgary ■ Chicago
Houston ■ Los Angeles ■ Mumbai ■ New York ■ Phoenix
St. Louis ■ San Francisco ■ Shanghai ■ Toronto
Vancouver ■ Victoria ■ Washington DC


Drawing Title
INTERIOR DETAILS
Approved: Project Director

Project Title		
VA NY HARBOR HEALTHCARE SYSTEM MANHATTAN VAMC - BUILDING 1 9THFLOOR RENOVATIONS		
Location		
423 EAST 23RD STREET NEW YORK, NY 10010		
Date	Checked	Drawn
AUGUST 8, 2013	AH/DT	MK

Project Number 630PR2600	<div>Office of Construction & Facilities Management</div> <div>  <div>U.S. Department of Veterans Affairs</div> </div>
Building Number 1	
Drawing Number 1-AI502	

A
B
C
D
E
F


three inches = one foot
one and one half inches = one foot
one inch = one foot
three quarters inch = one foot
one half inch = one foot
three eighths inch = one foot
one quarter inch = one foot
one eighth inch = one foot

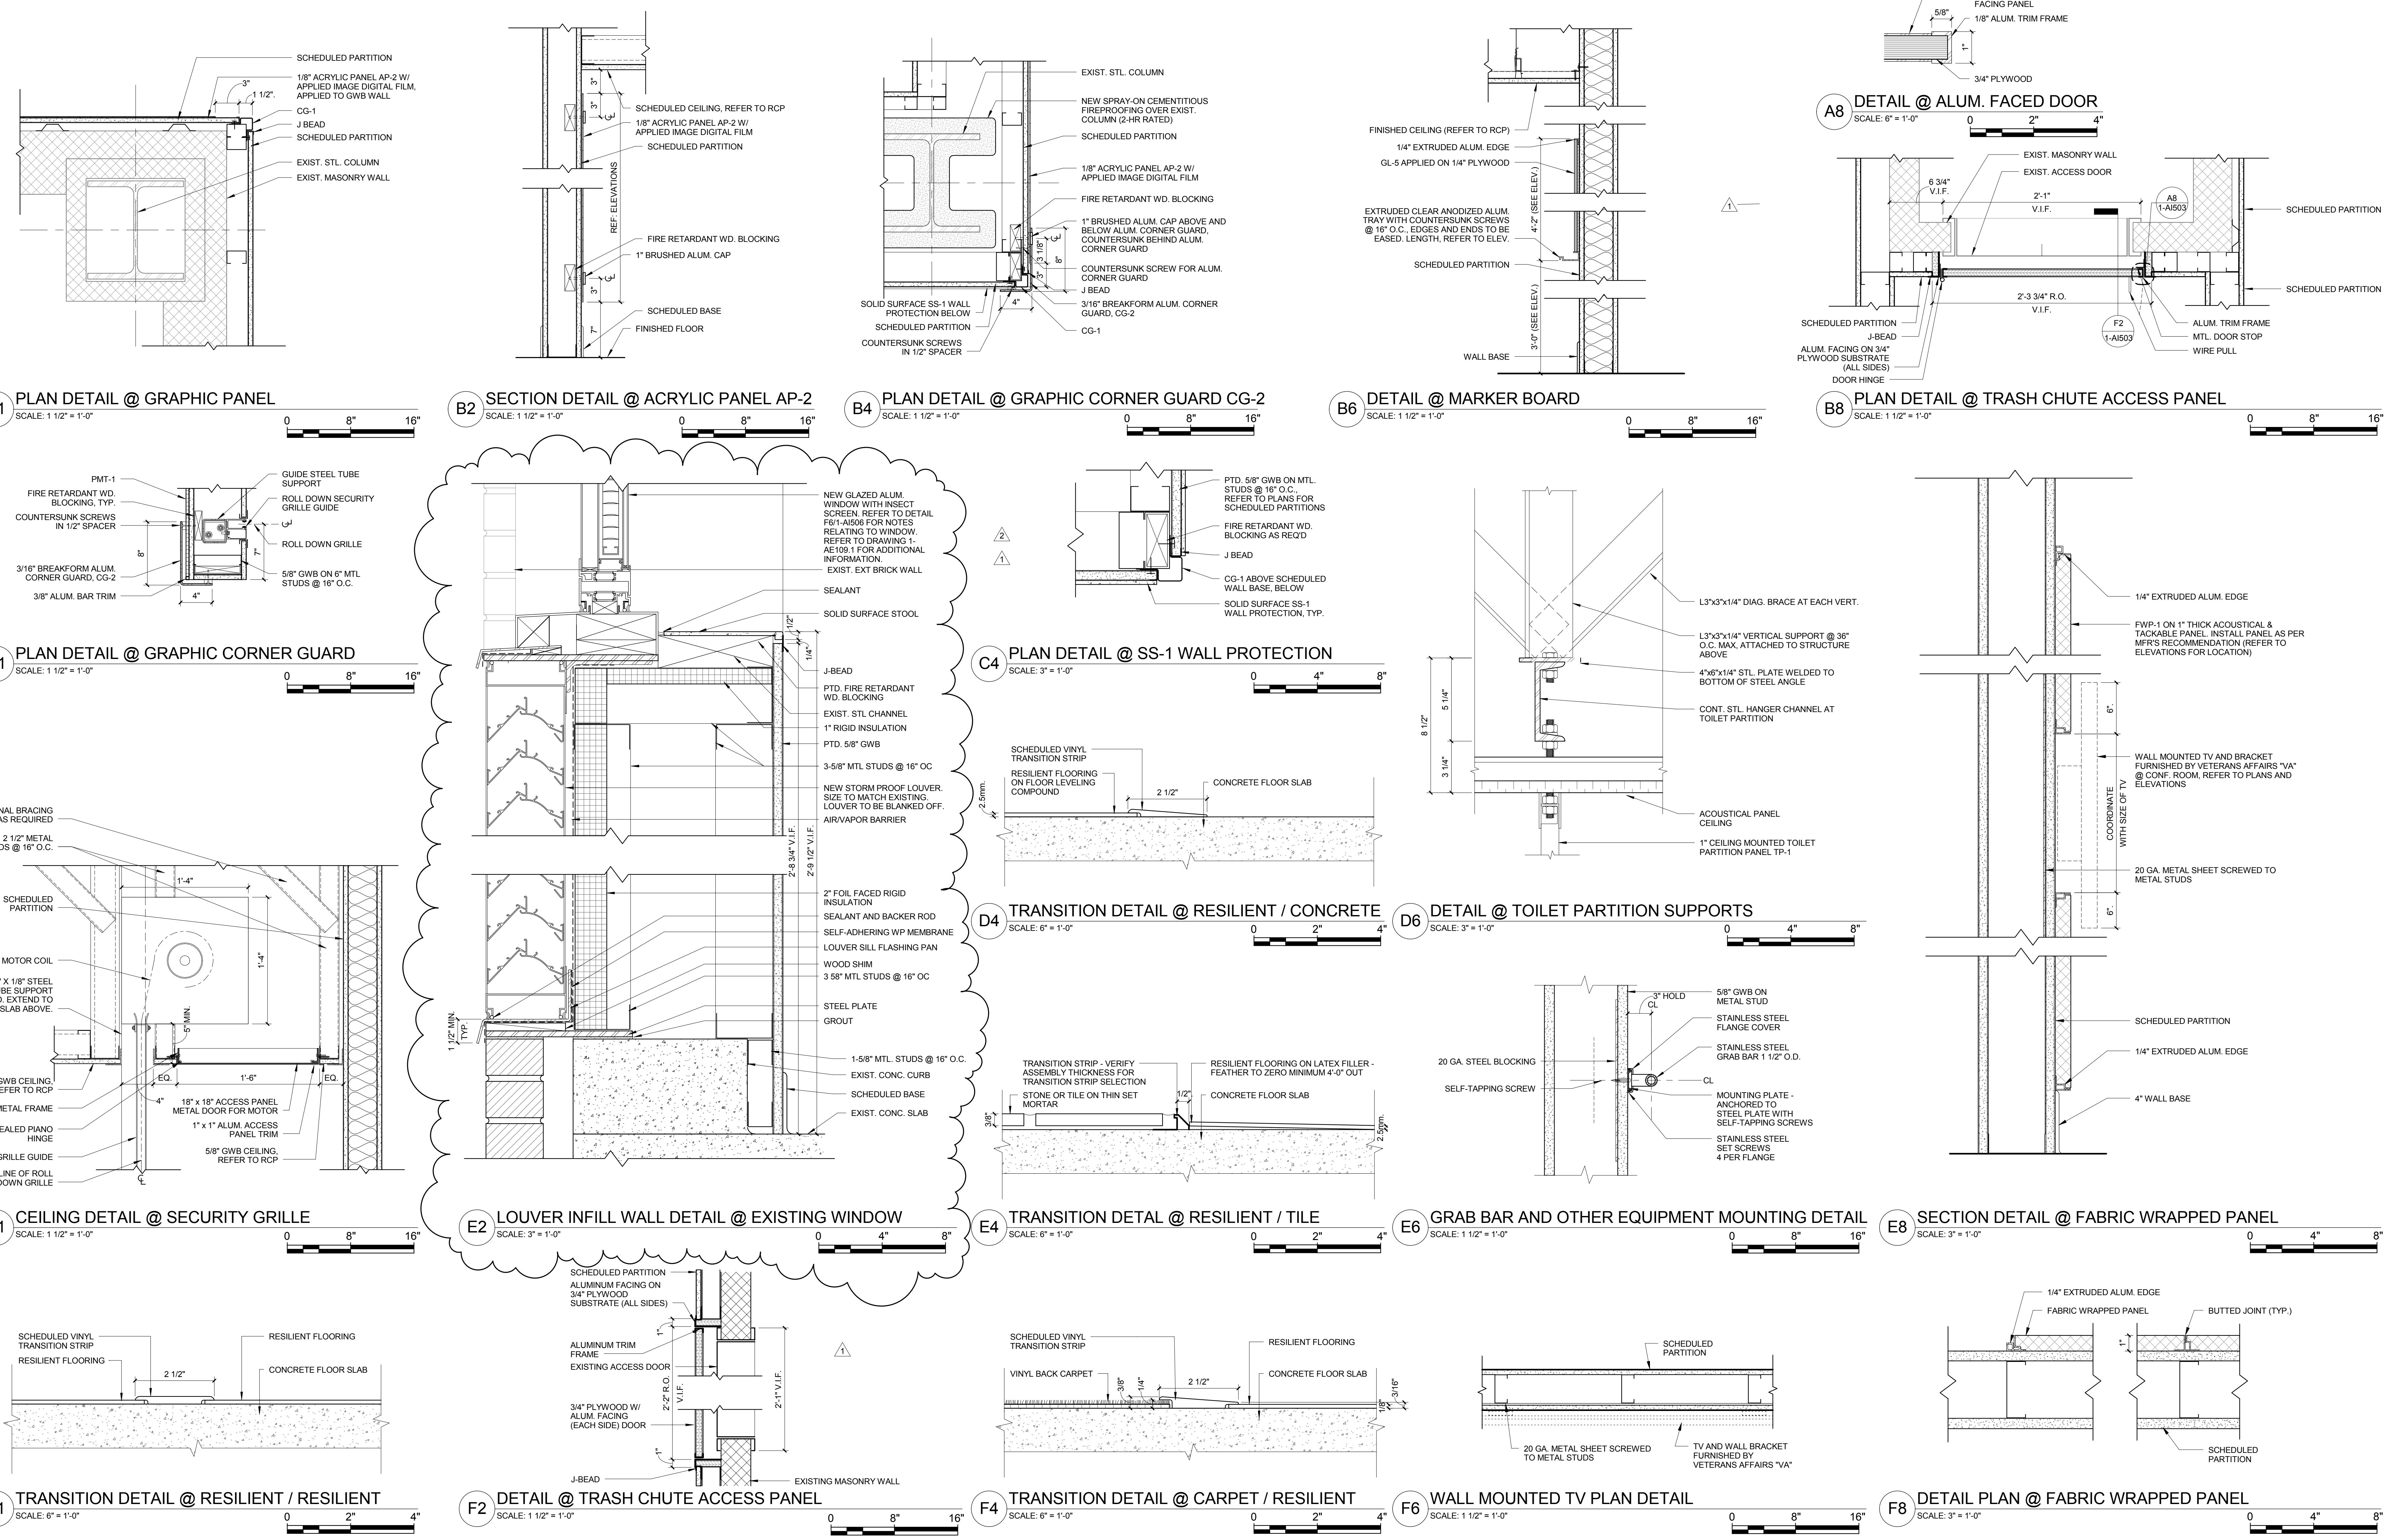



CONSULTANTS:		KEY PLAN:		ARCHITECT/ENGINEERS:		Drawing Title		Project Title		BUILDING IS FULLY SPRINKLERED		Scale: AS NOTED	
ASBESTOS ABATEMENT CONSULTANT:				CANNONDESIGN		INTERIOR DETAILS		VA NY HARBOR HEALTHCARE SYSTEM		Project Number		Office of Construction & Facilities Management	
Egan Environmental Consulting, Inc.				360 Madison Avenue, New York, New York 10017 212.972.9800		Approved: Project Director		MANHATTAN VAMC - BUILDING 1		630PR2600		U.S. Department of Veterans Affairs	
14 HIGH STREET				Baltimore • Boston • Buffalo • Calgary • Chicago				9TH FLOOR RENOVATIONS		Building Number			
MAHAH, NEW JERSEY 07430				Houston • Los Angeles • Mumbai • New York • Phoenix				423 EAST 23RD STREET		1			
Tel: (201) 848-7790 Fax: (201) 848-7791				St. Louis • San Francisco • Shanghai • Toronto				NEW YORK, NY 10010		Drawing Number			
				Vancouver • Victoria • Washington DC				Date		1-AI503			
ADDENDUM #4 2								Checked					
ADDENDUM #1 1								Drawn					
Revisions:								Date					
ISSUED FOR CONSTRUCTION								AUGUST 8, 2013					
								AH/DT					
								MK					

A
B
C
D
E
F



three inches = one foot
one and one half inches = one foot
one inch = one foot
three quarters inch = one foot
one half inch = one foot
three eighths inch = one foot
one quarter inch = one foot
one eighth inch = one foot

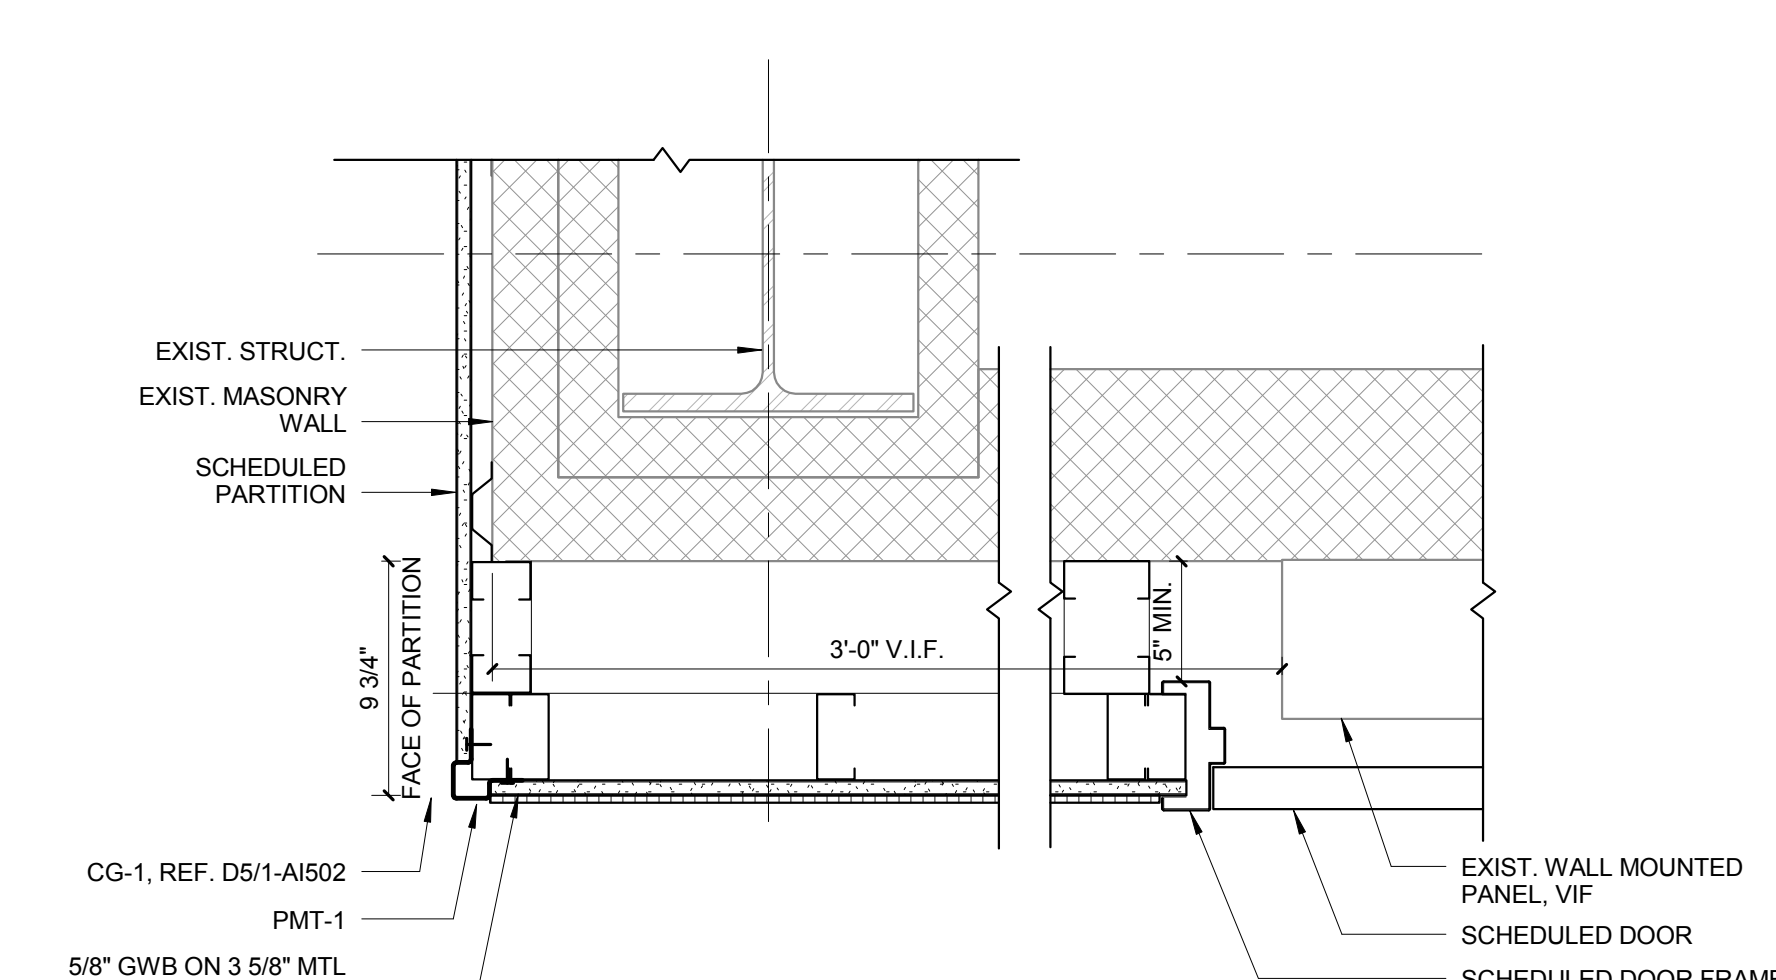



B1 PORCELAIN TILE WALL @ CORNER JAMB
SCALE: 1 1/2" = 1'-0"

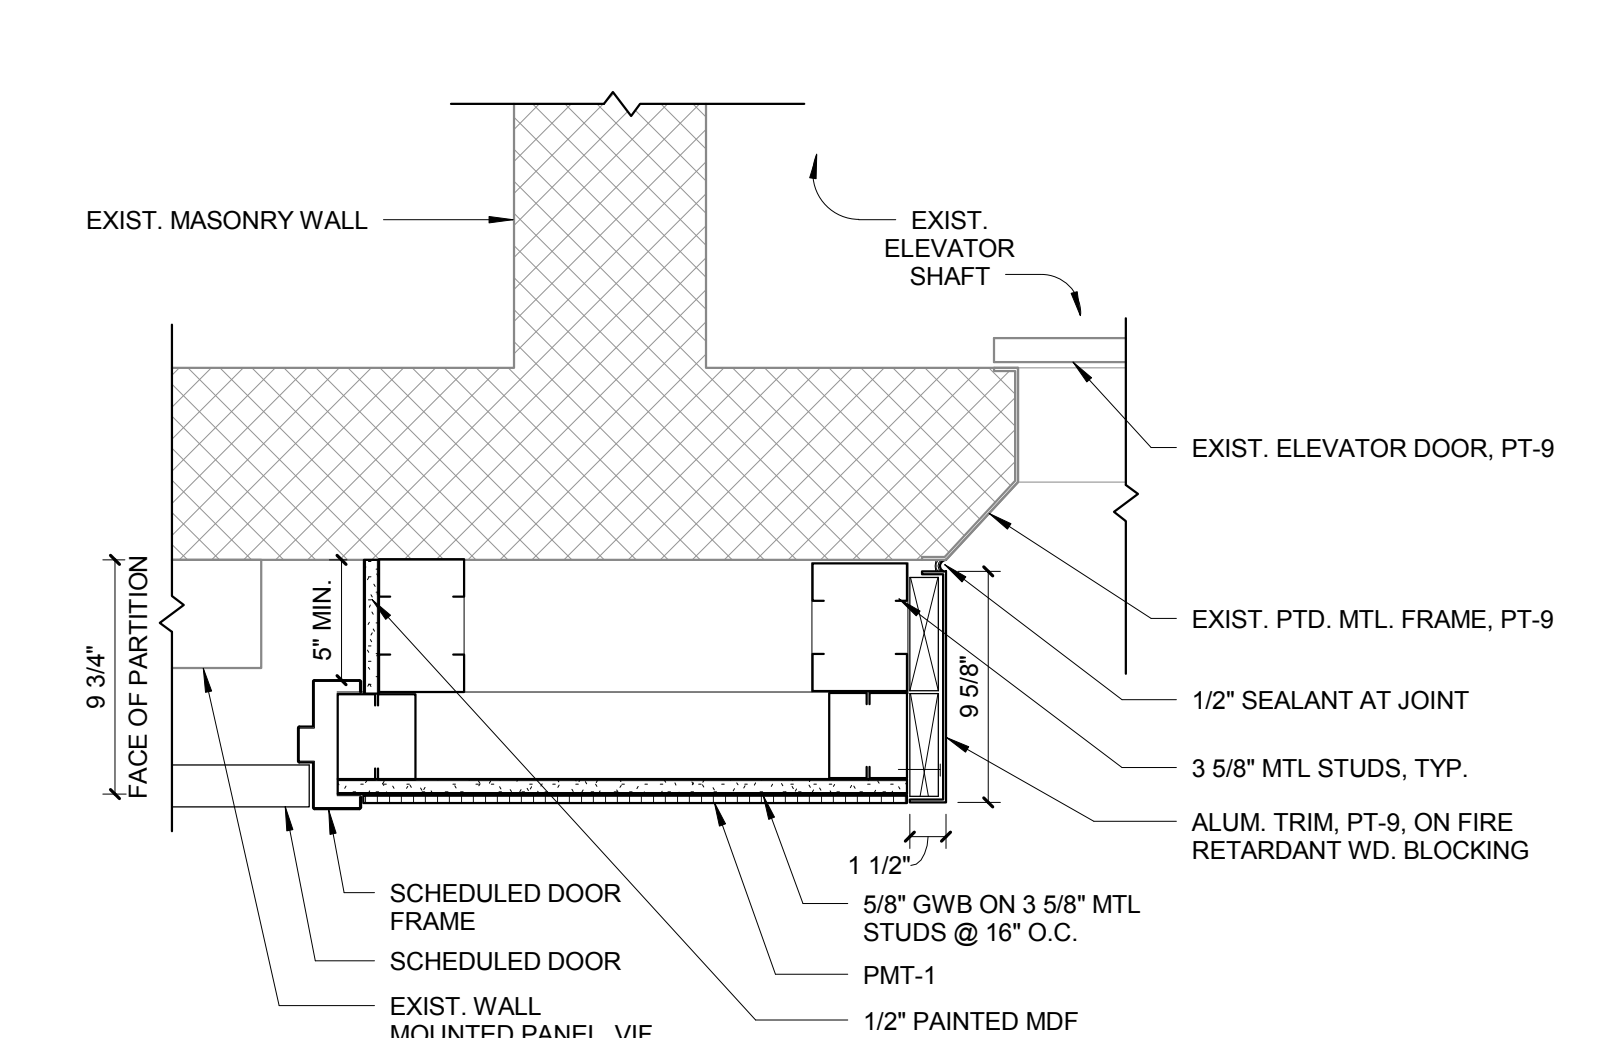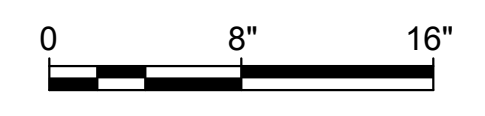



B3 PORCELAIN TILE WALL @ ELEVATOR JAMB
SCALE: 1 1/2" = 1'-0"

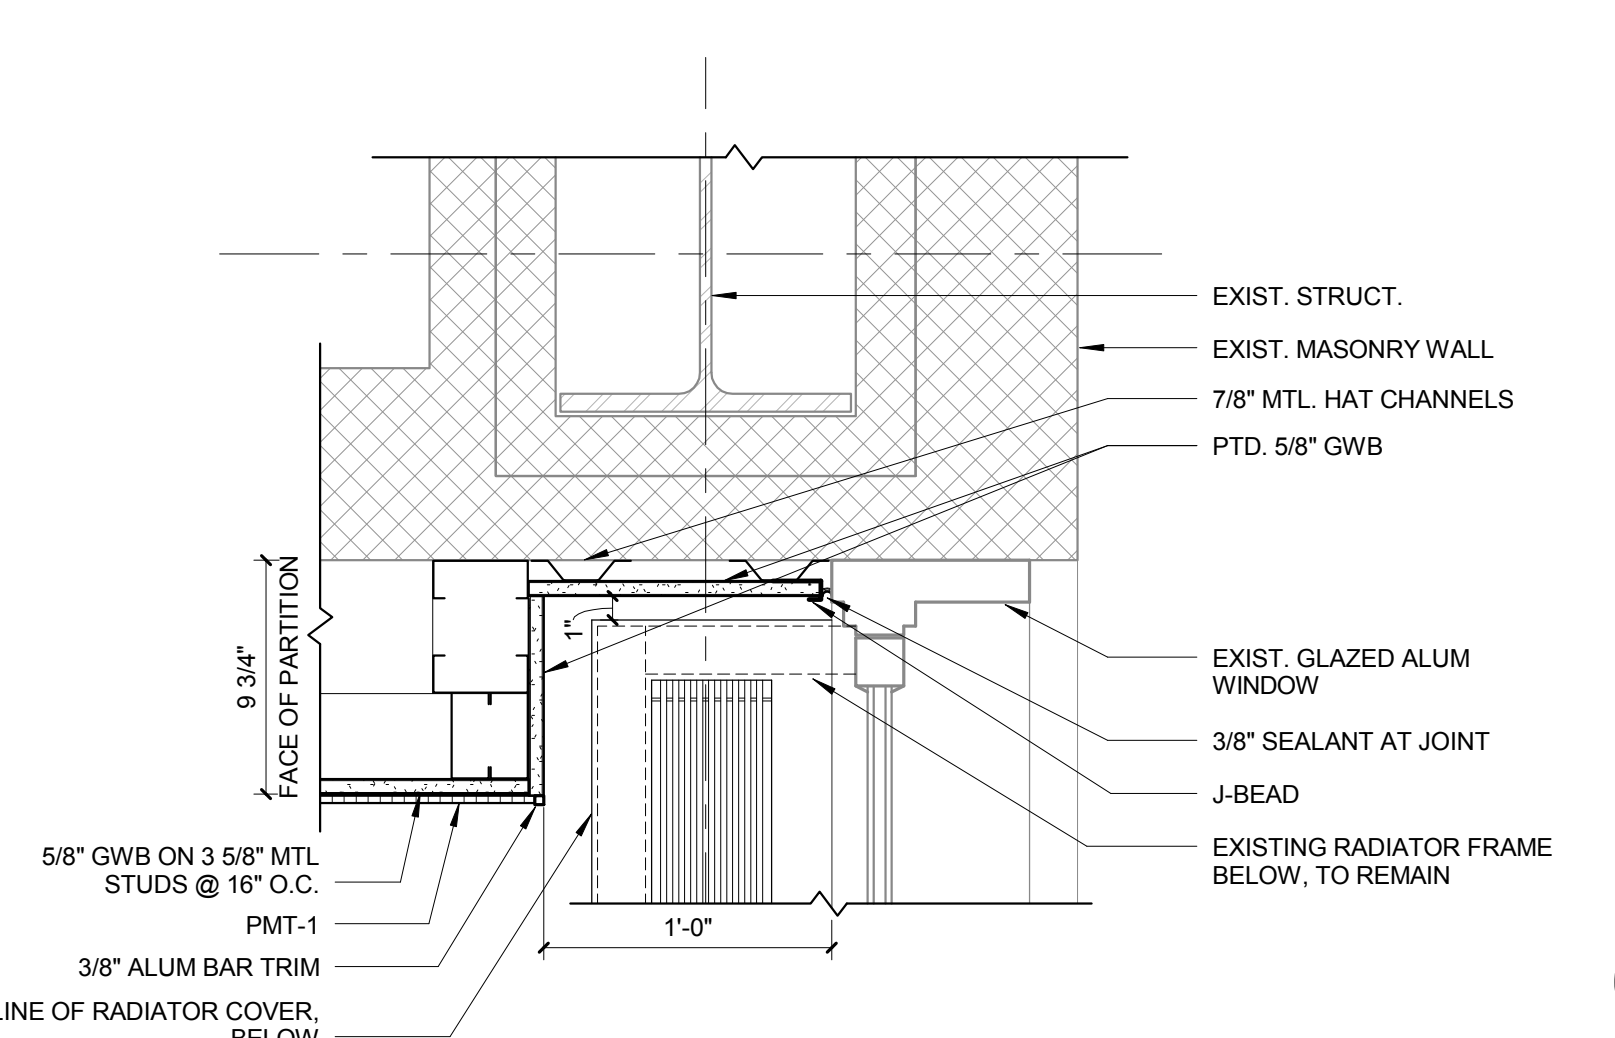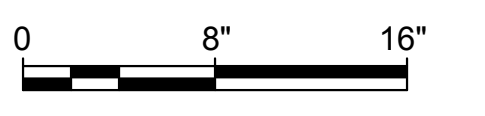



B6 PORCELAIN TILE WALL @ WINDOW JAMB
SCALE: 1 1/2" = 1'-0"

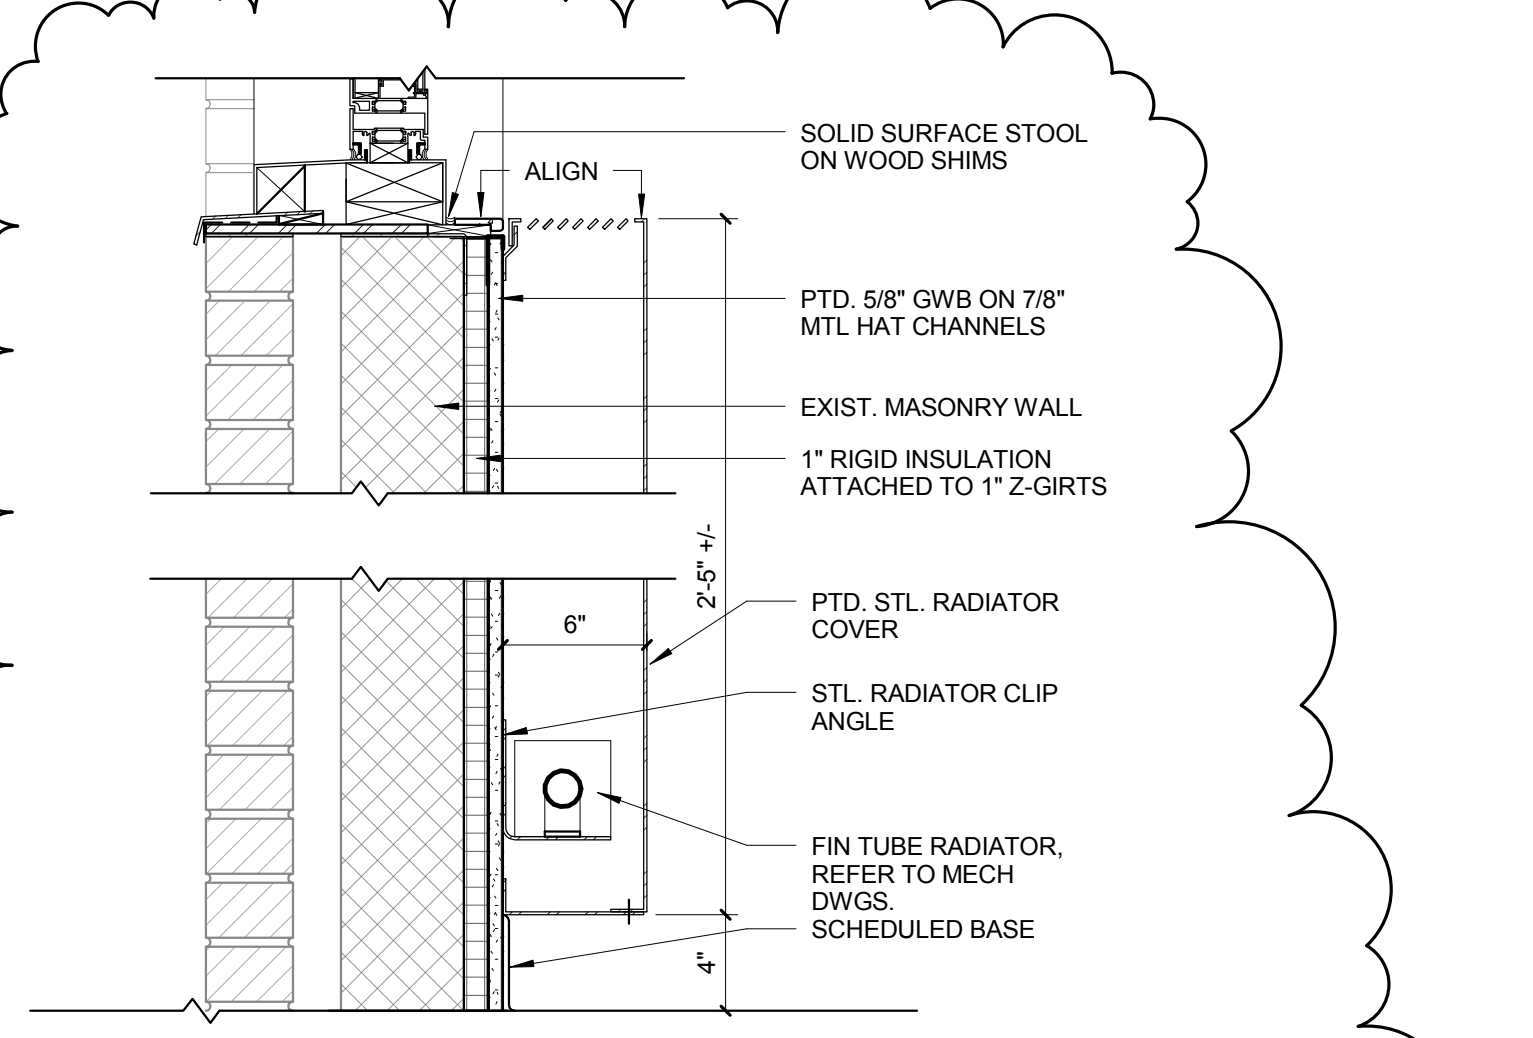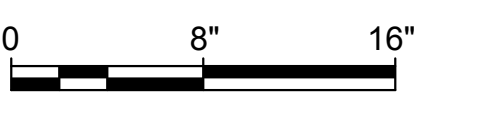



B8 BASE DETAIL @ FIN TUBE RADIATOR
SCALE: 1 1/2" = 1'-0"

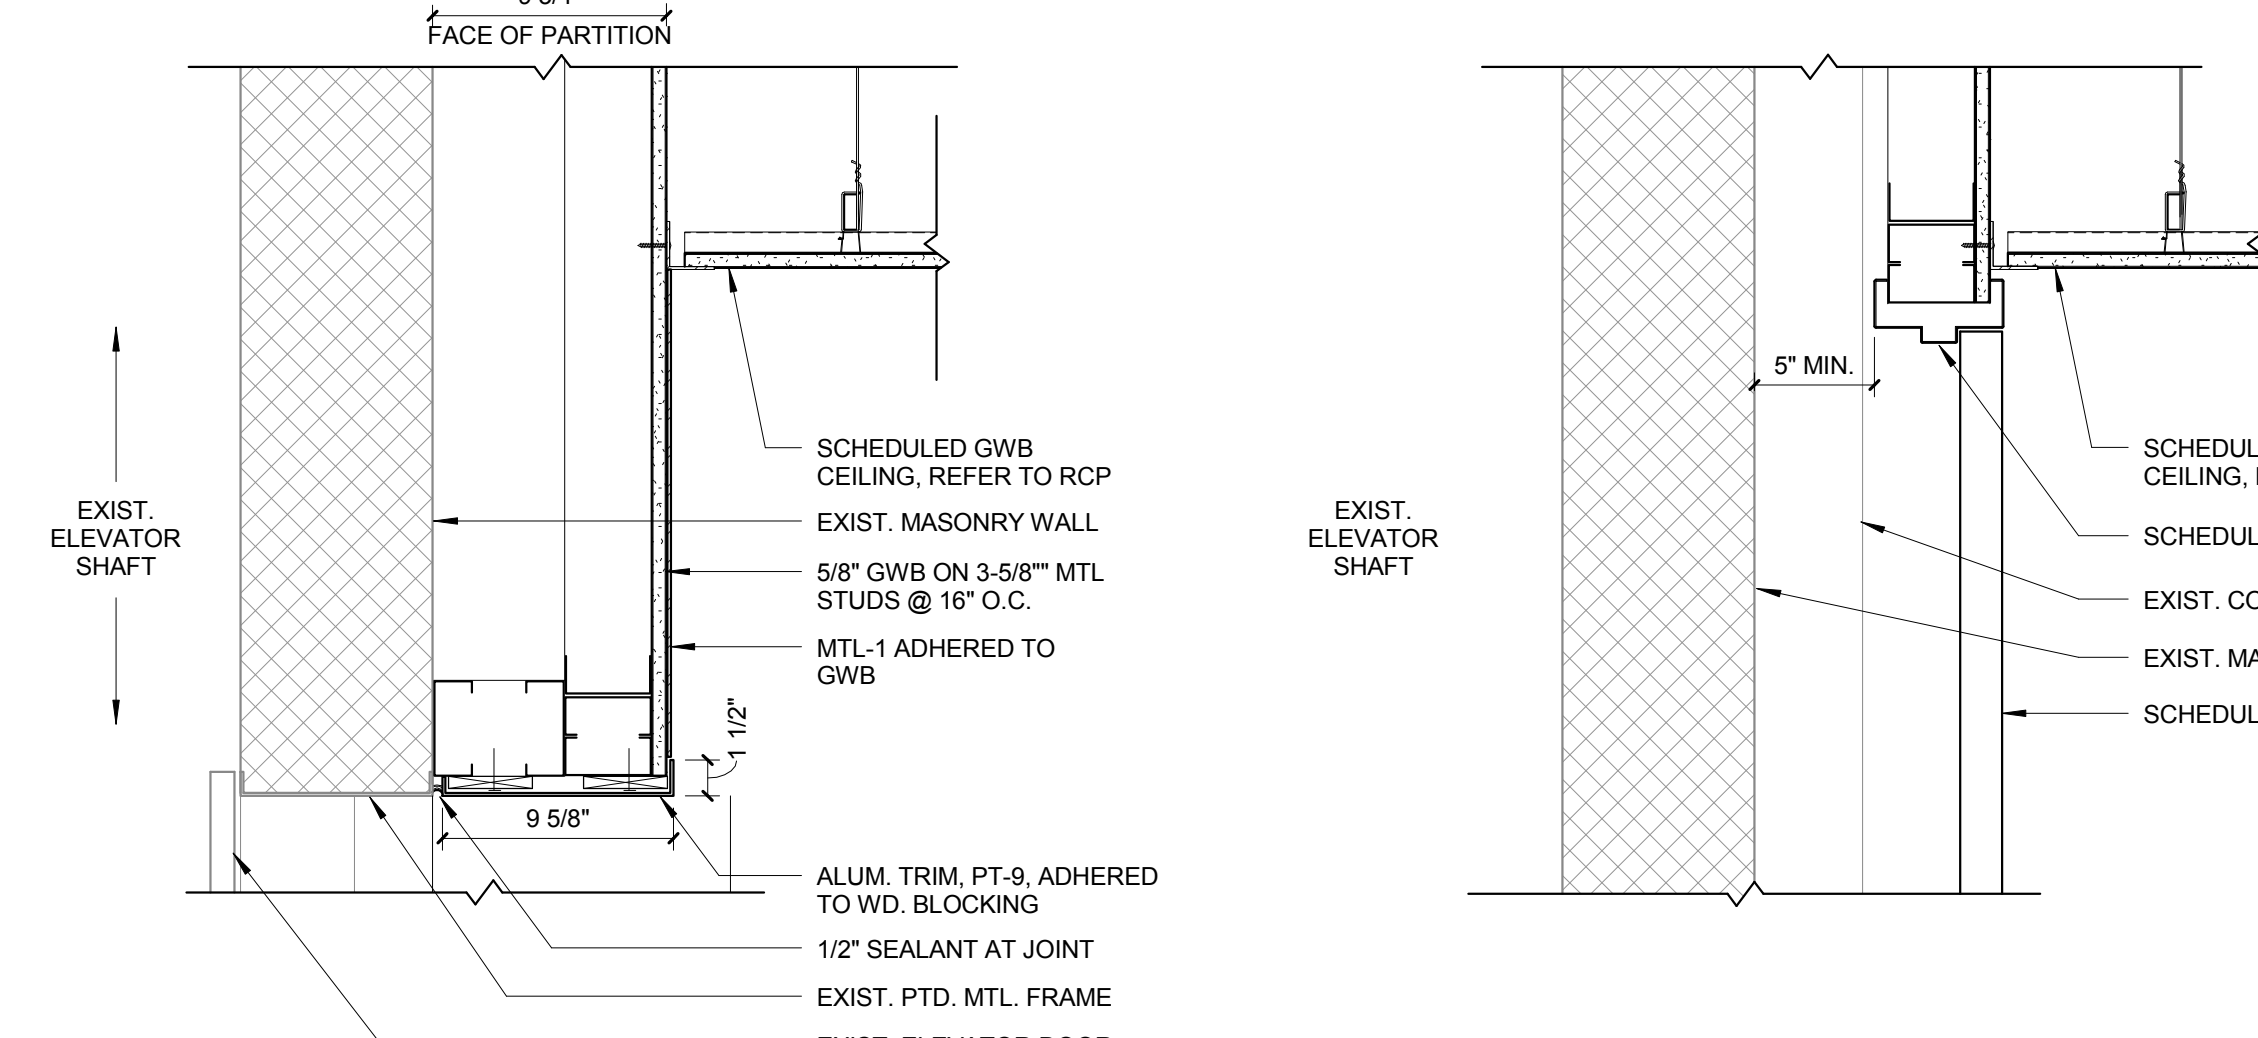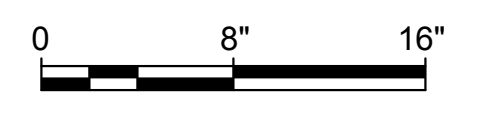



D1 METAL PANEL @ ELEVATOR HEAD
SCALE: 1 1/2" = 1'-0"

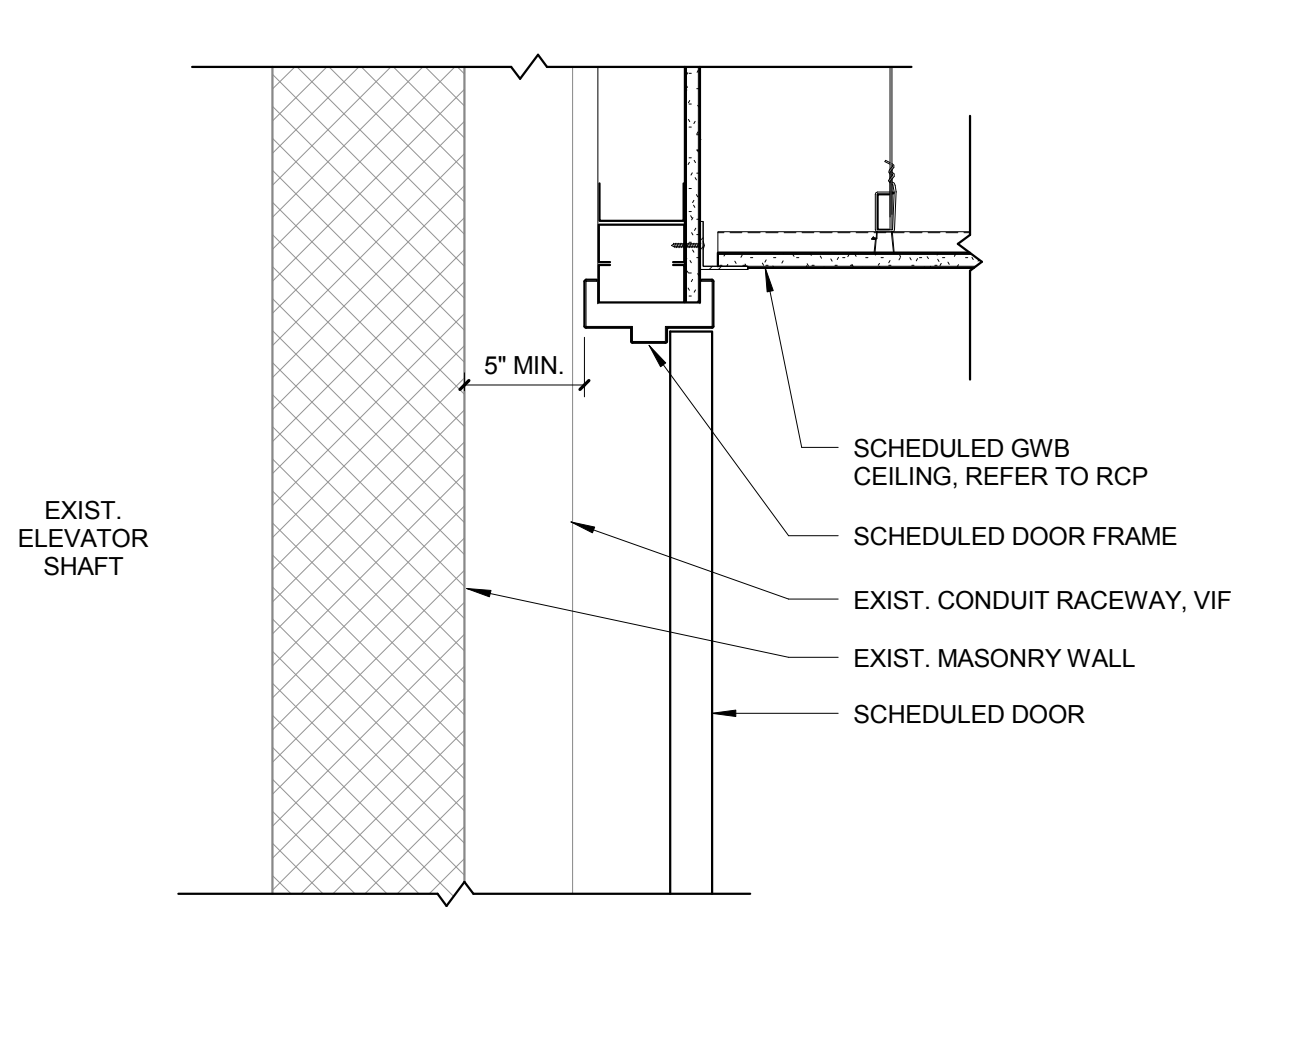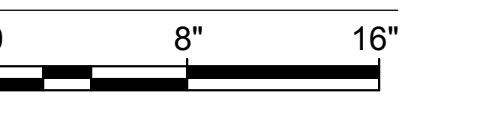



D2 DETAIL @ ELEVATOR LOBBY DOOR HEAD
SCALE: 1 1/2" = 1'-0"

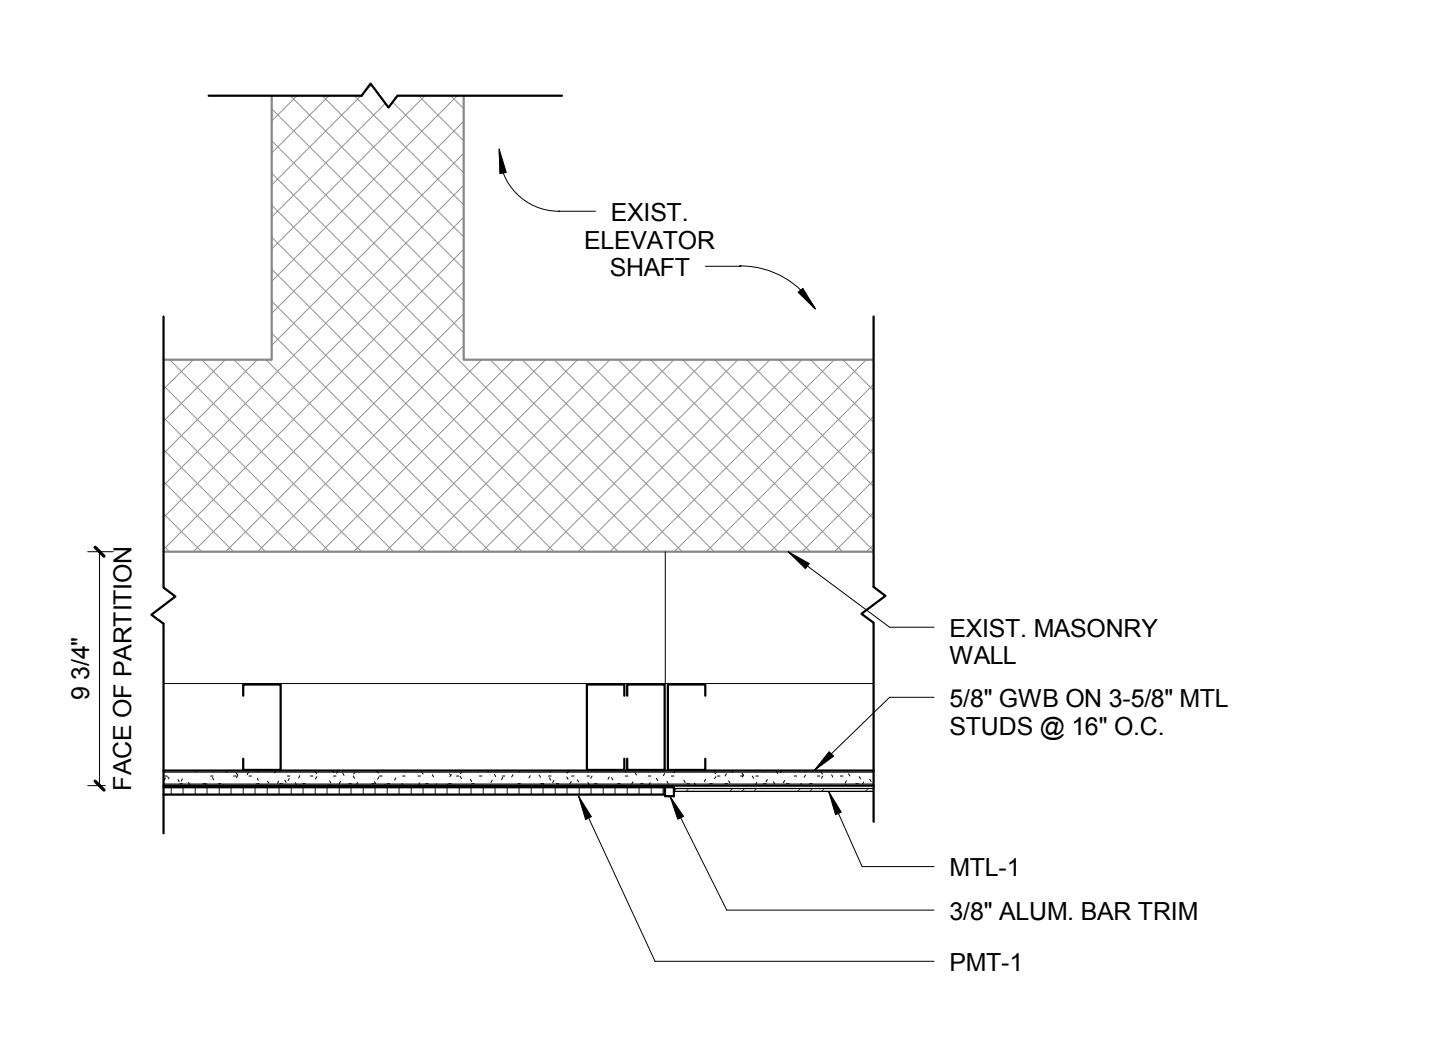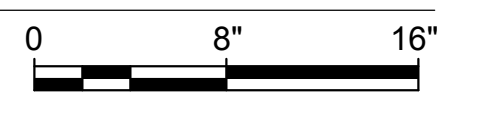



D4 PORCELAIN TILE WALL/METAL PANEL @ ELEVATOR LOBBY
SCALE: 1 1/2" = 1'-0"

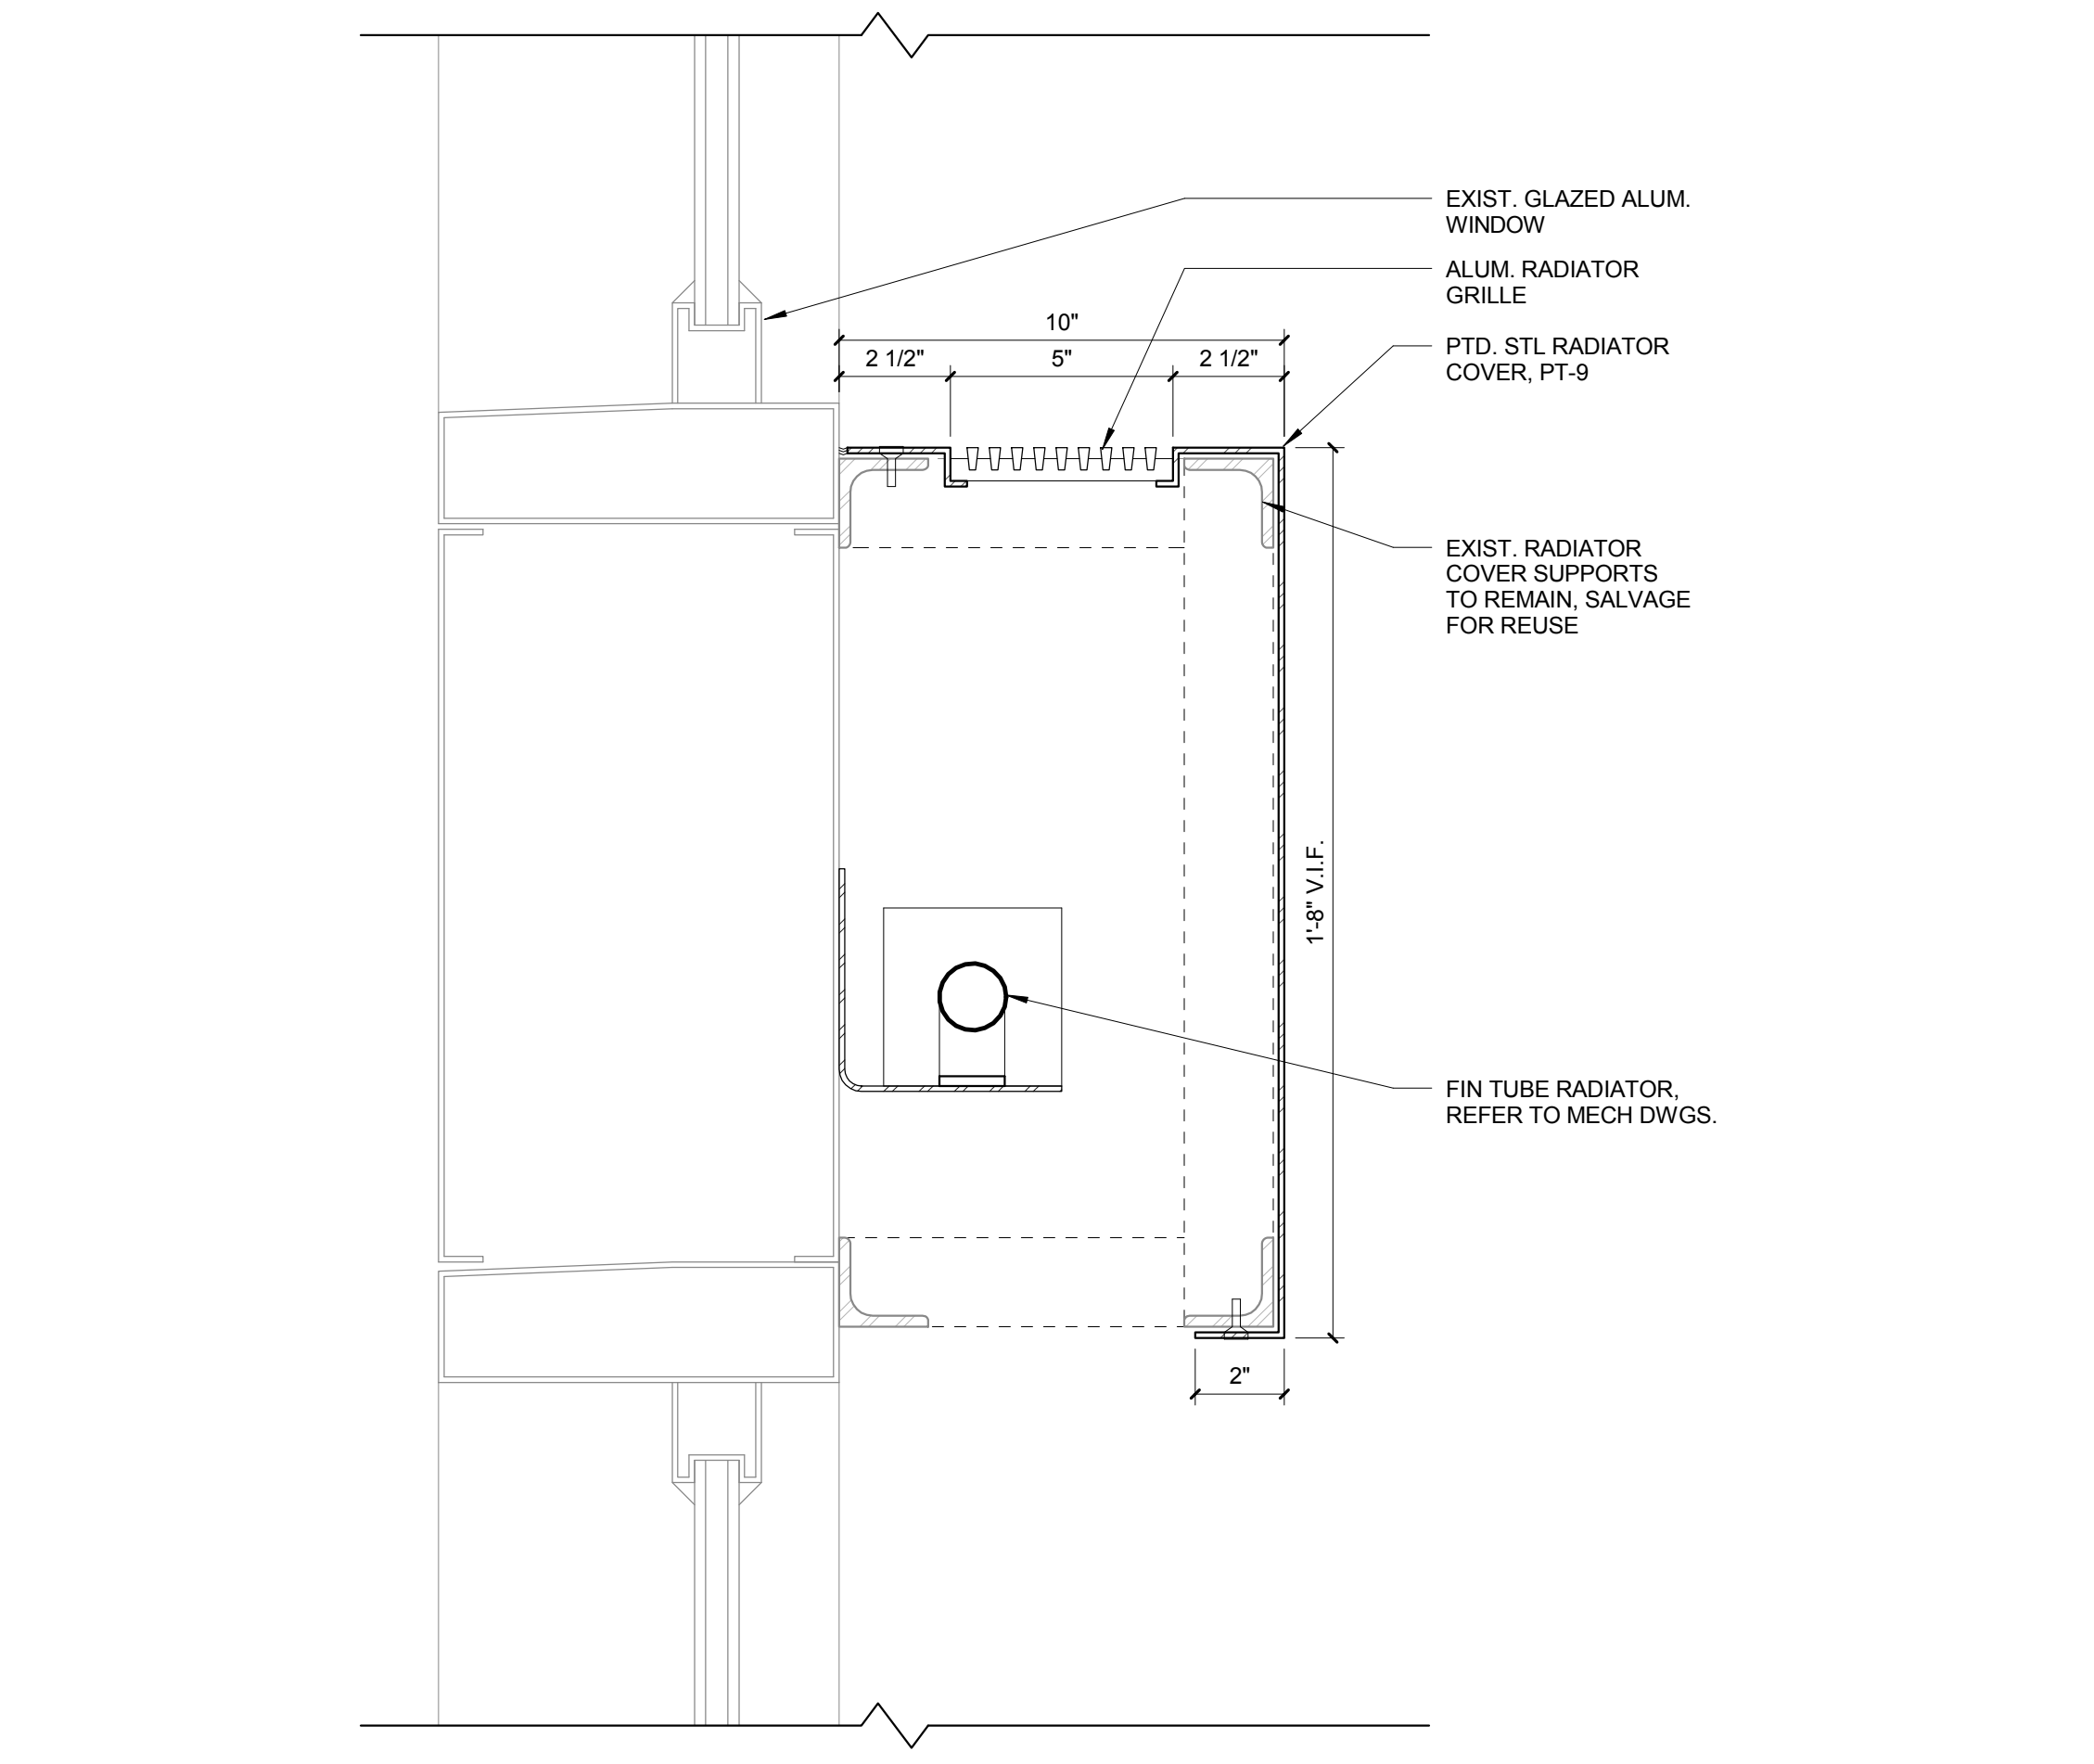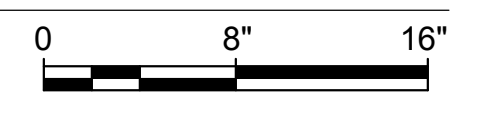



F1 RADIATOR PANEL DETAIL @ ELEVATOR LOBBY
SCALE: 3" = 1'-0"

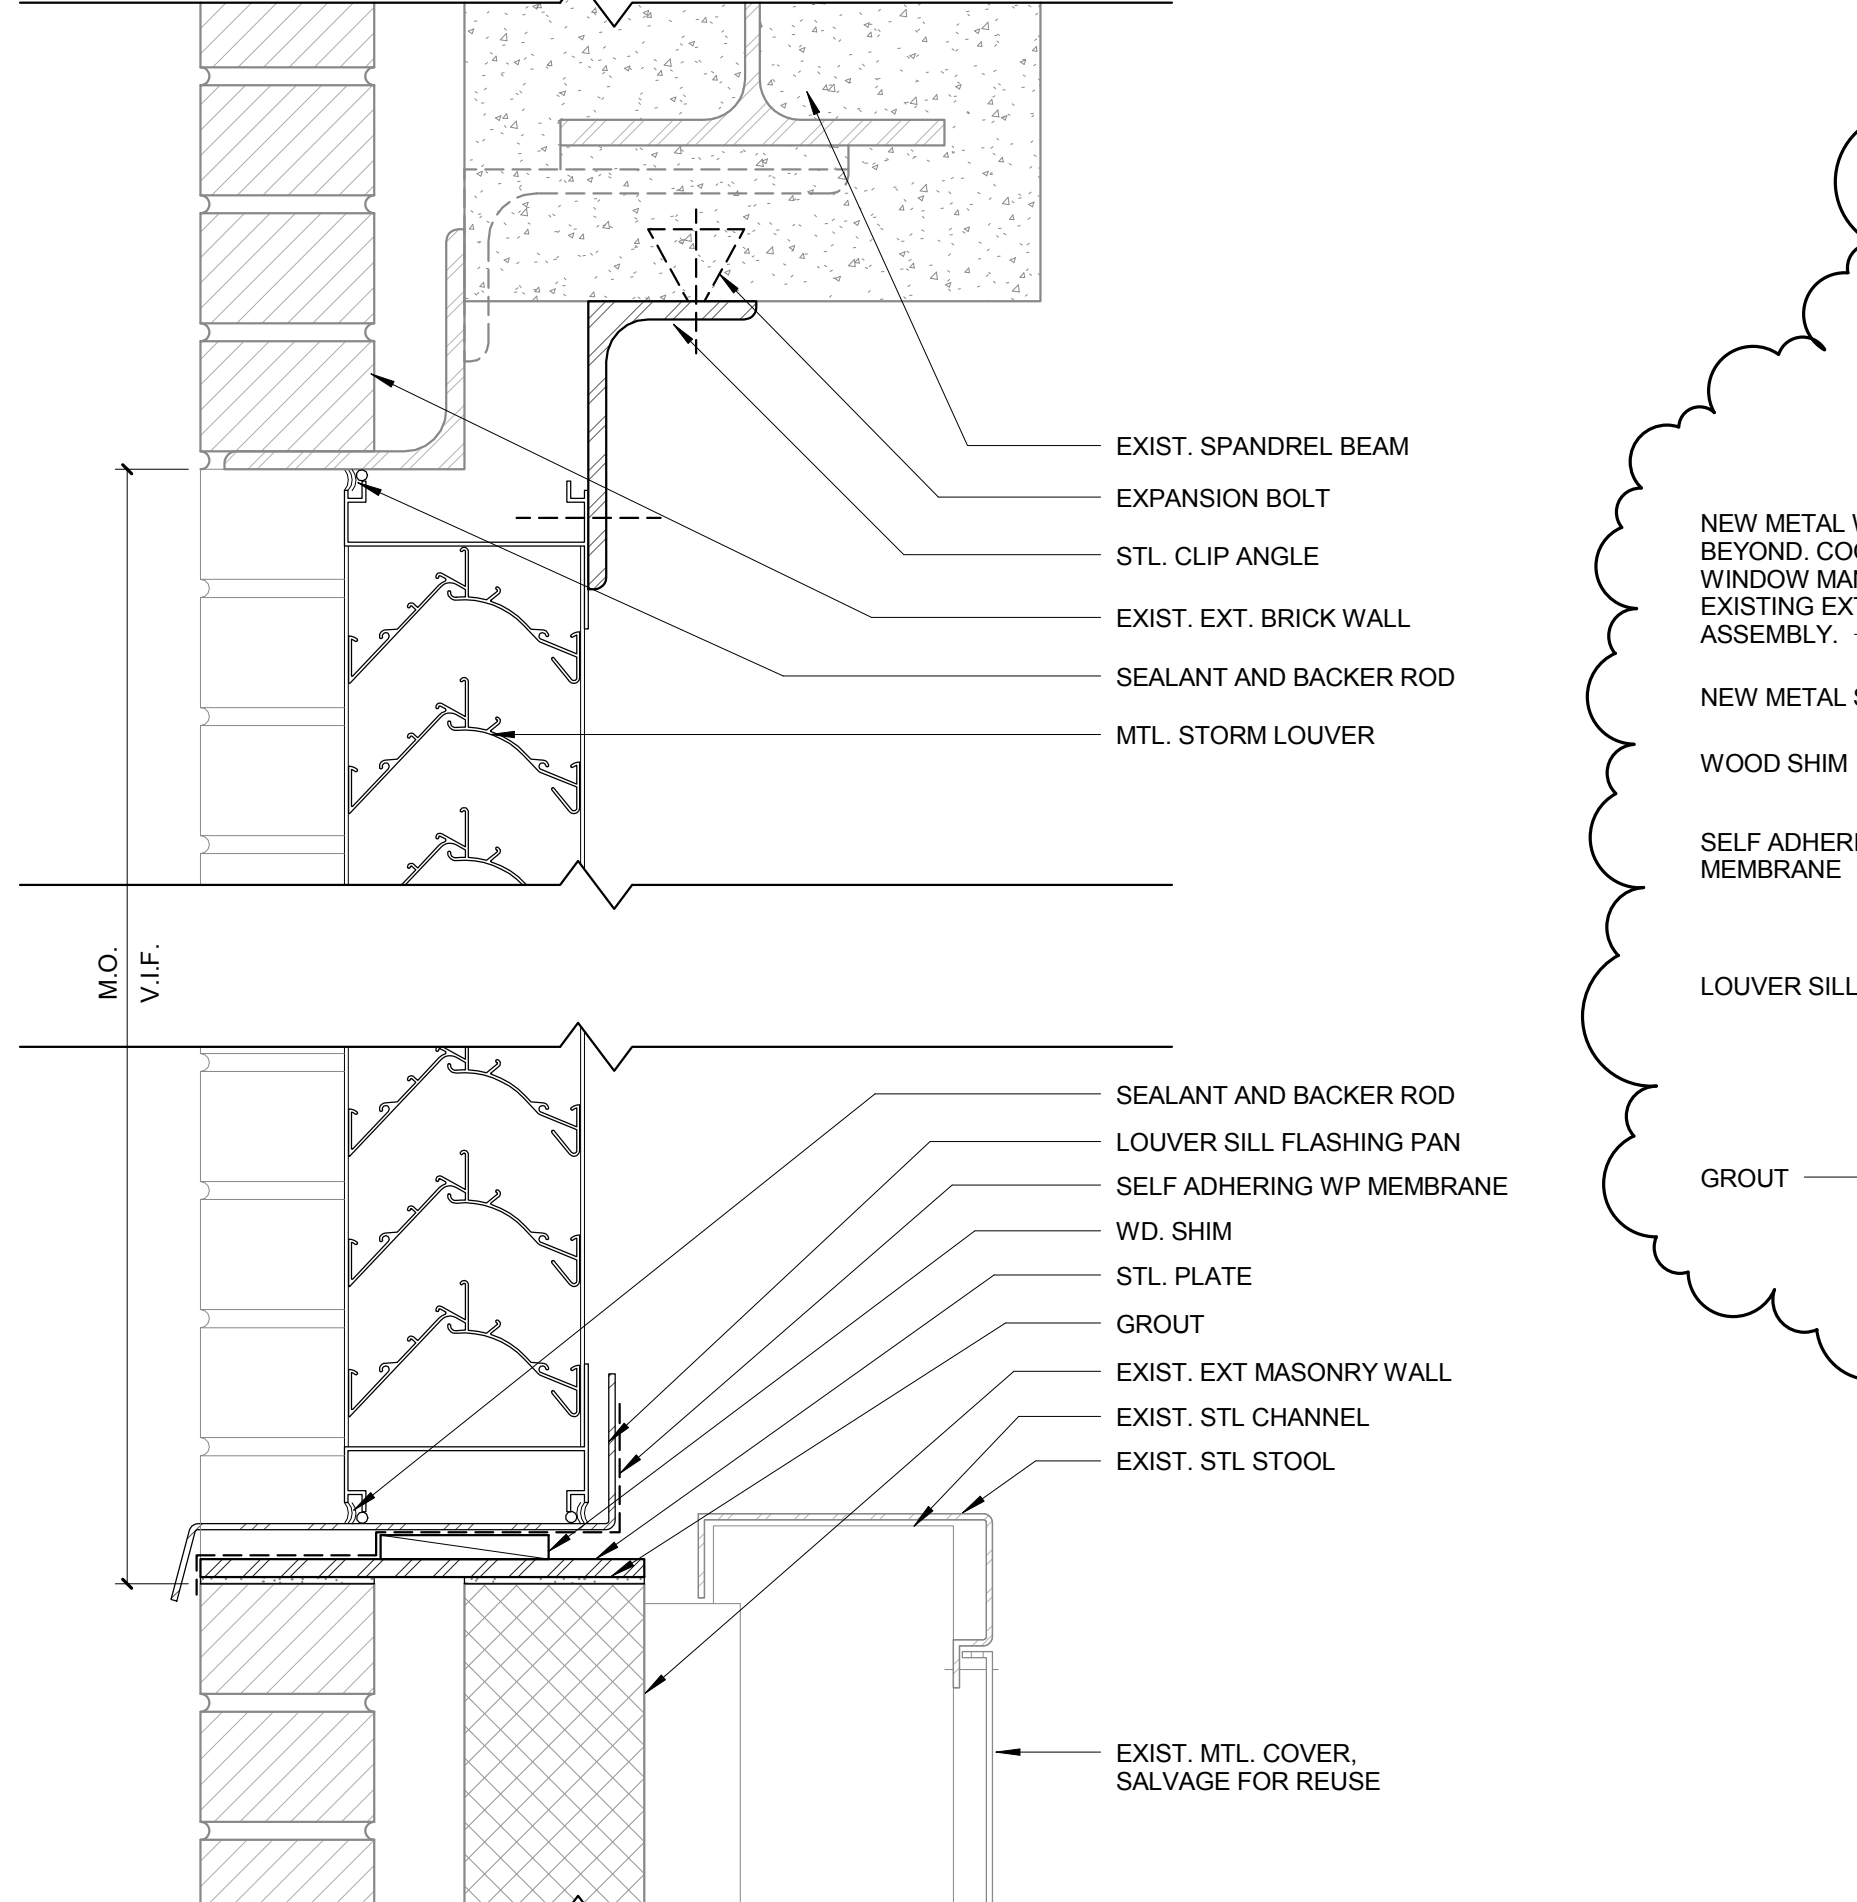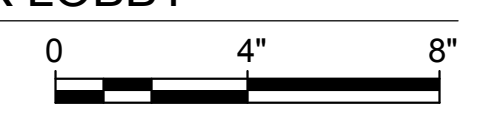

F3 LOUVER DETAIL @ EXISTING WINDOW
SCALE: 3" = 1'-0"

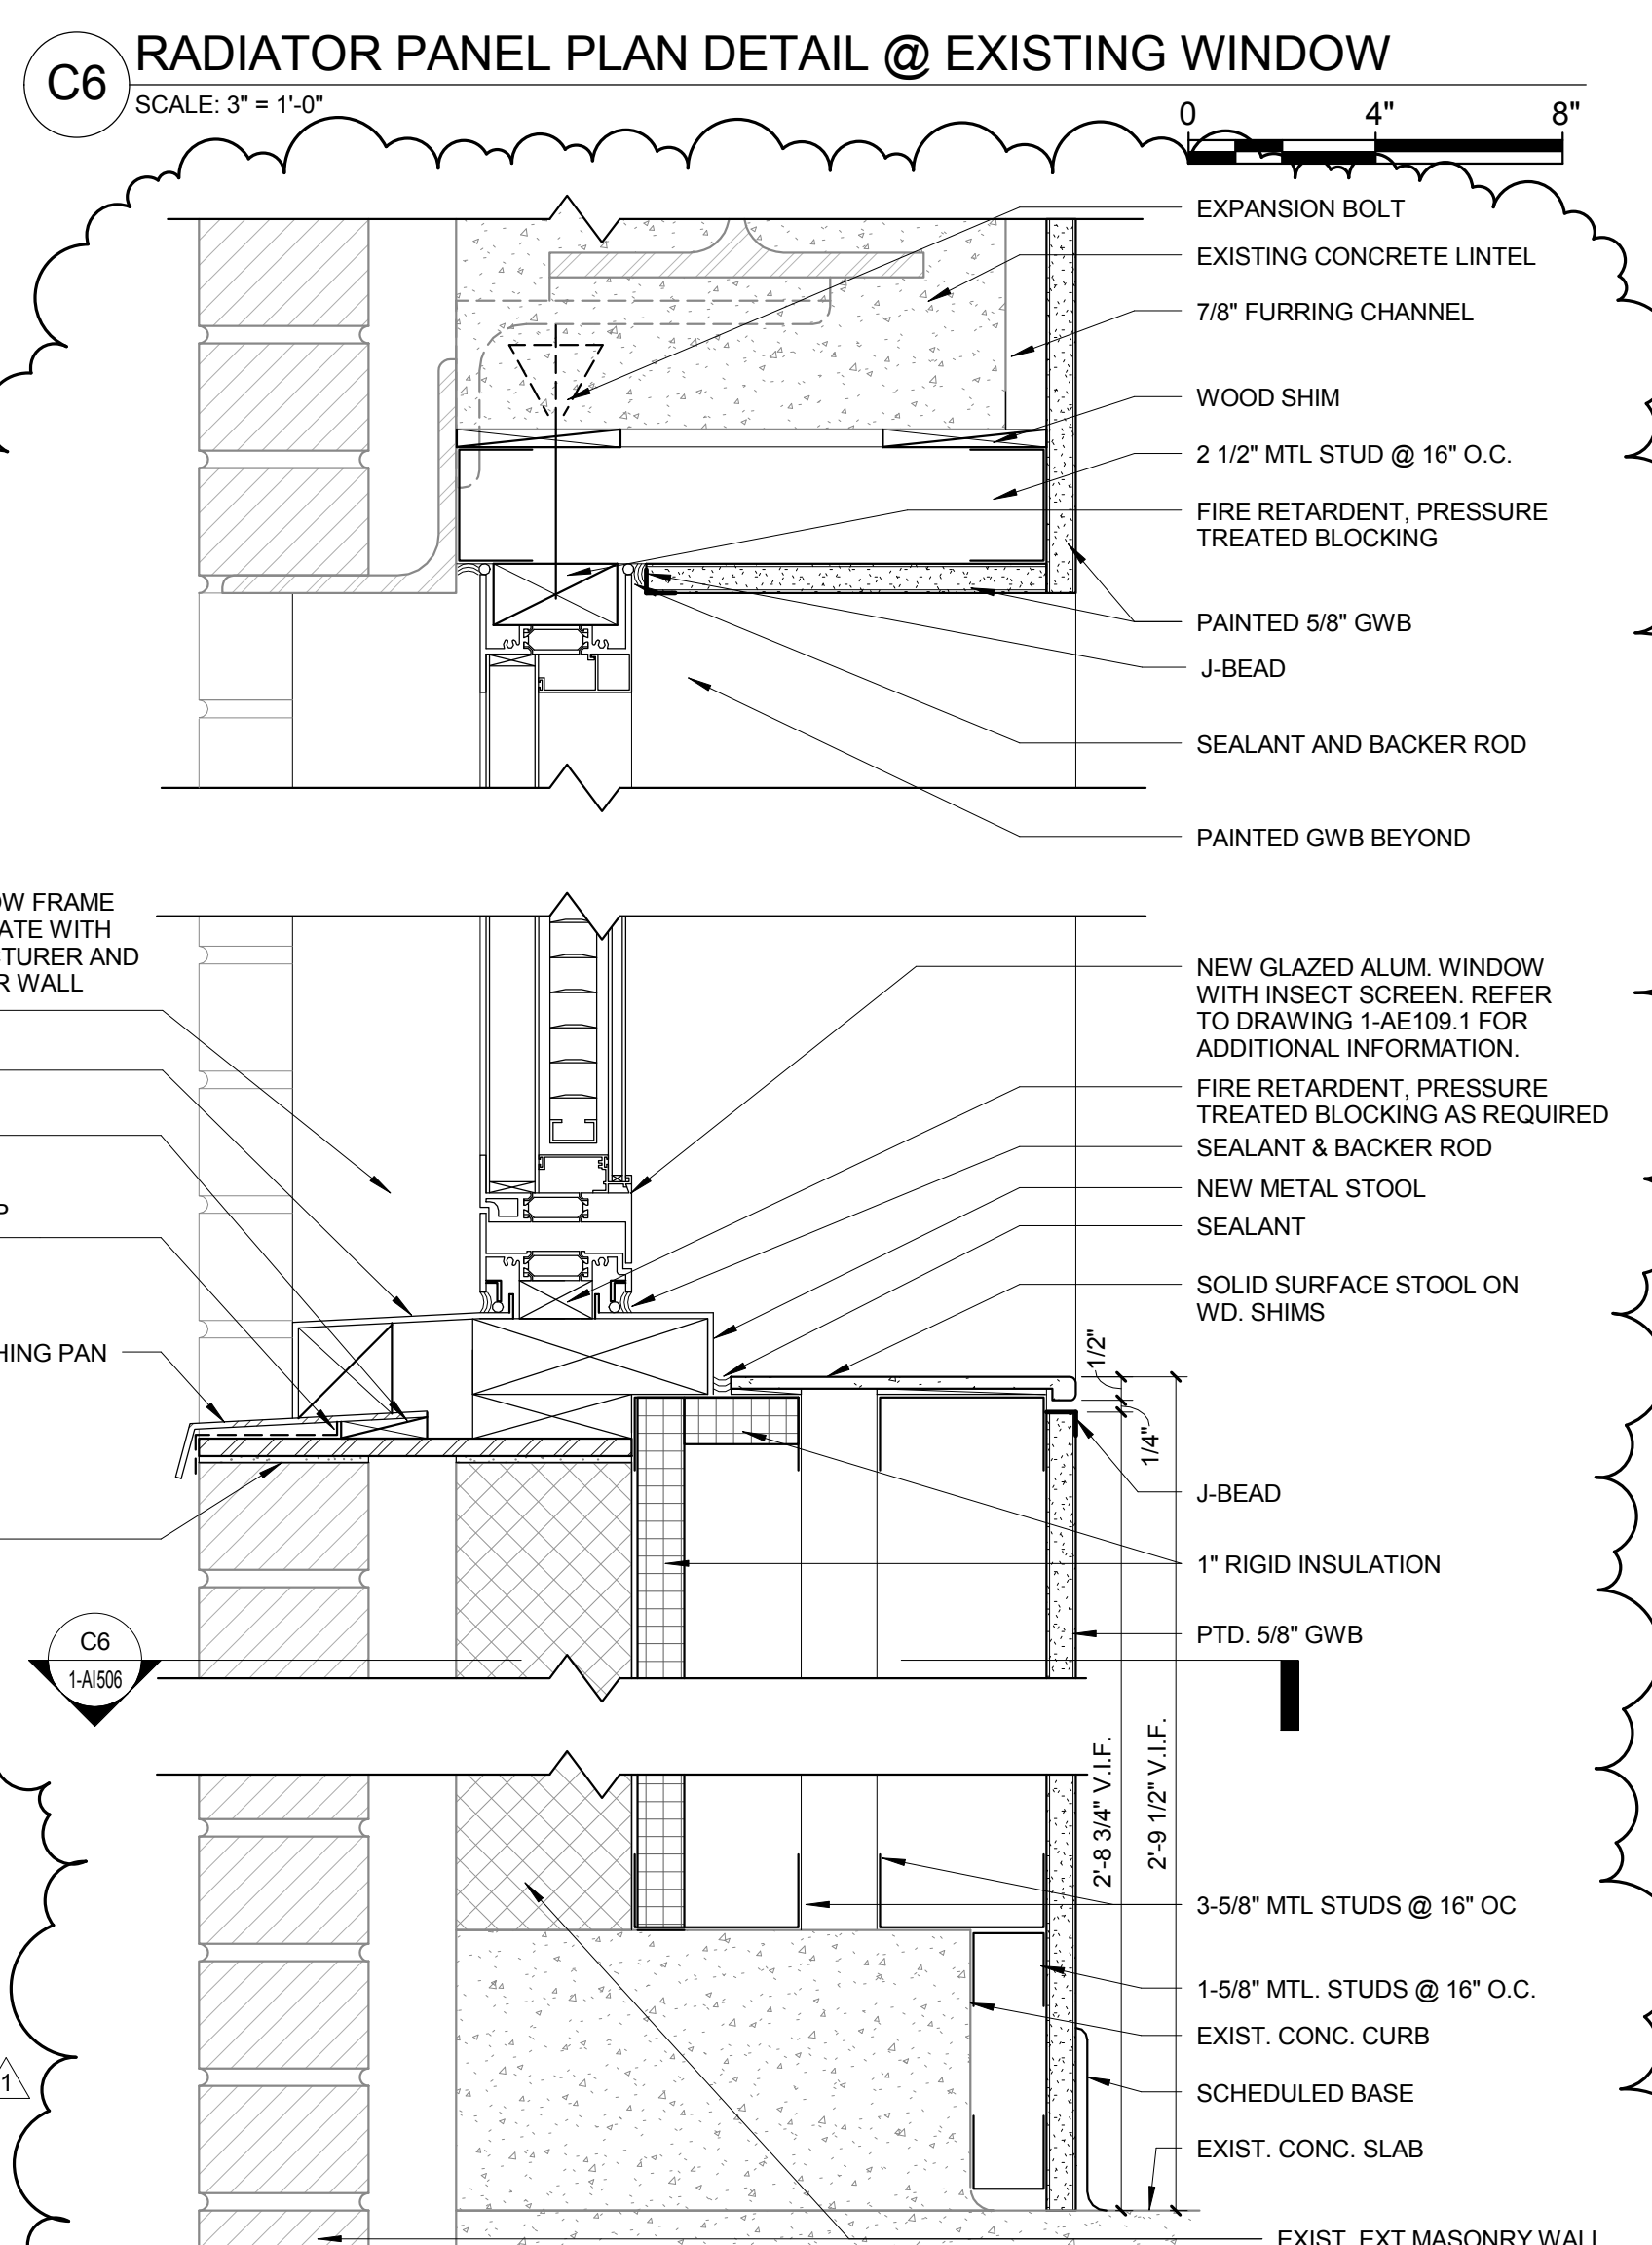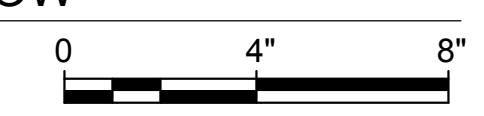

C6 RADIATOR PANEL PLAN DETAIL @ EXISTING WINDOW
SCALE: 3" = 1'-0"

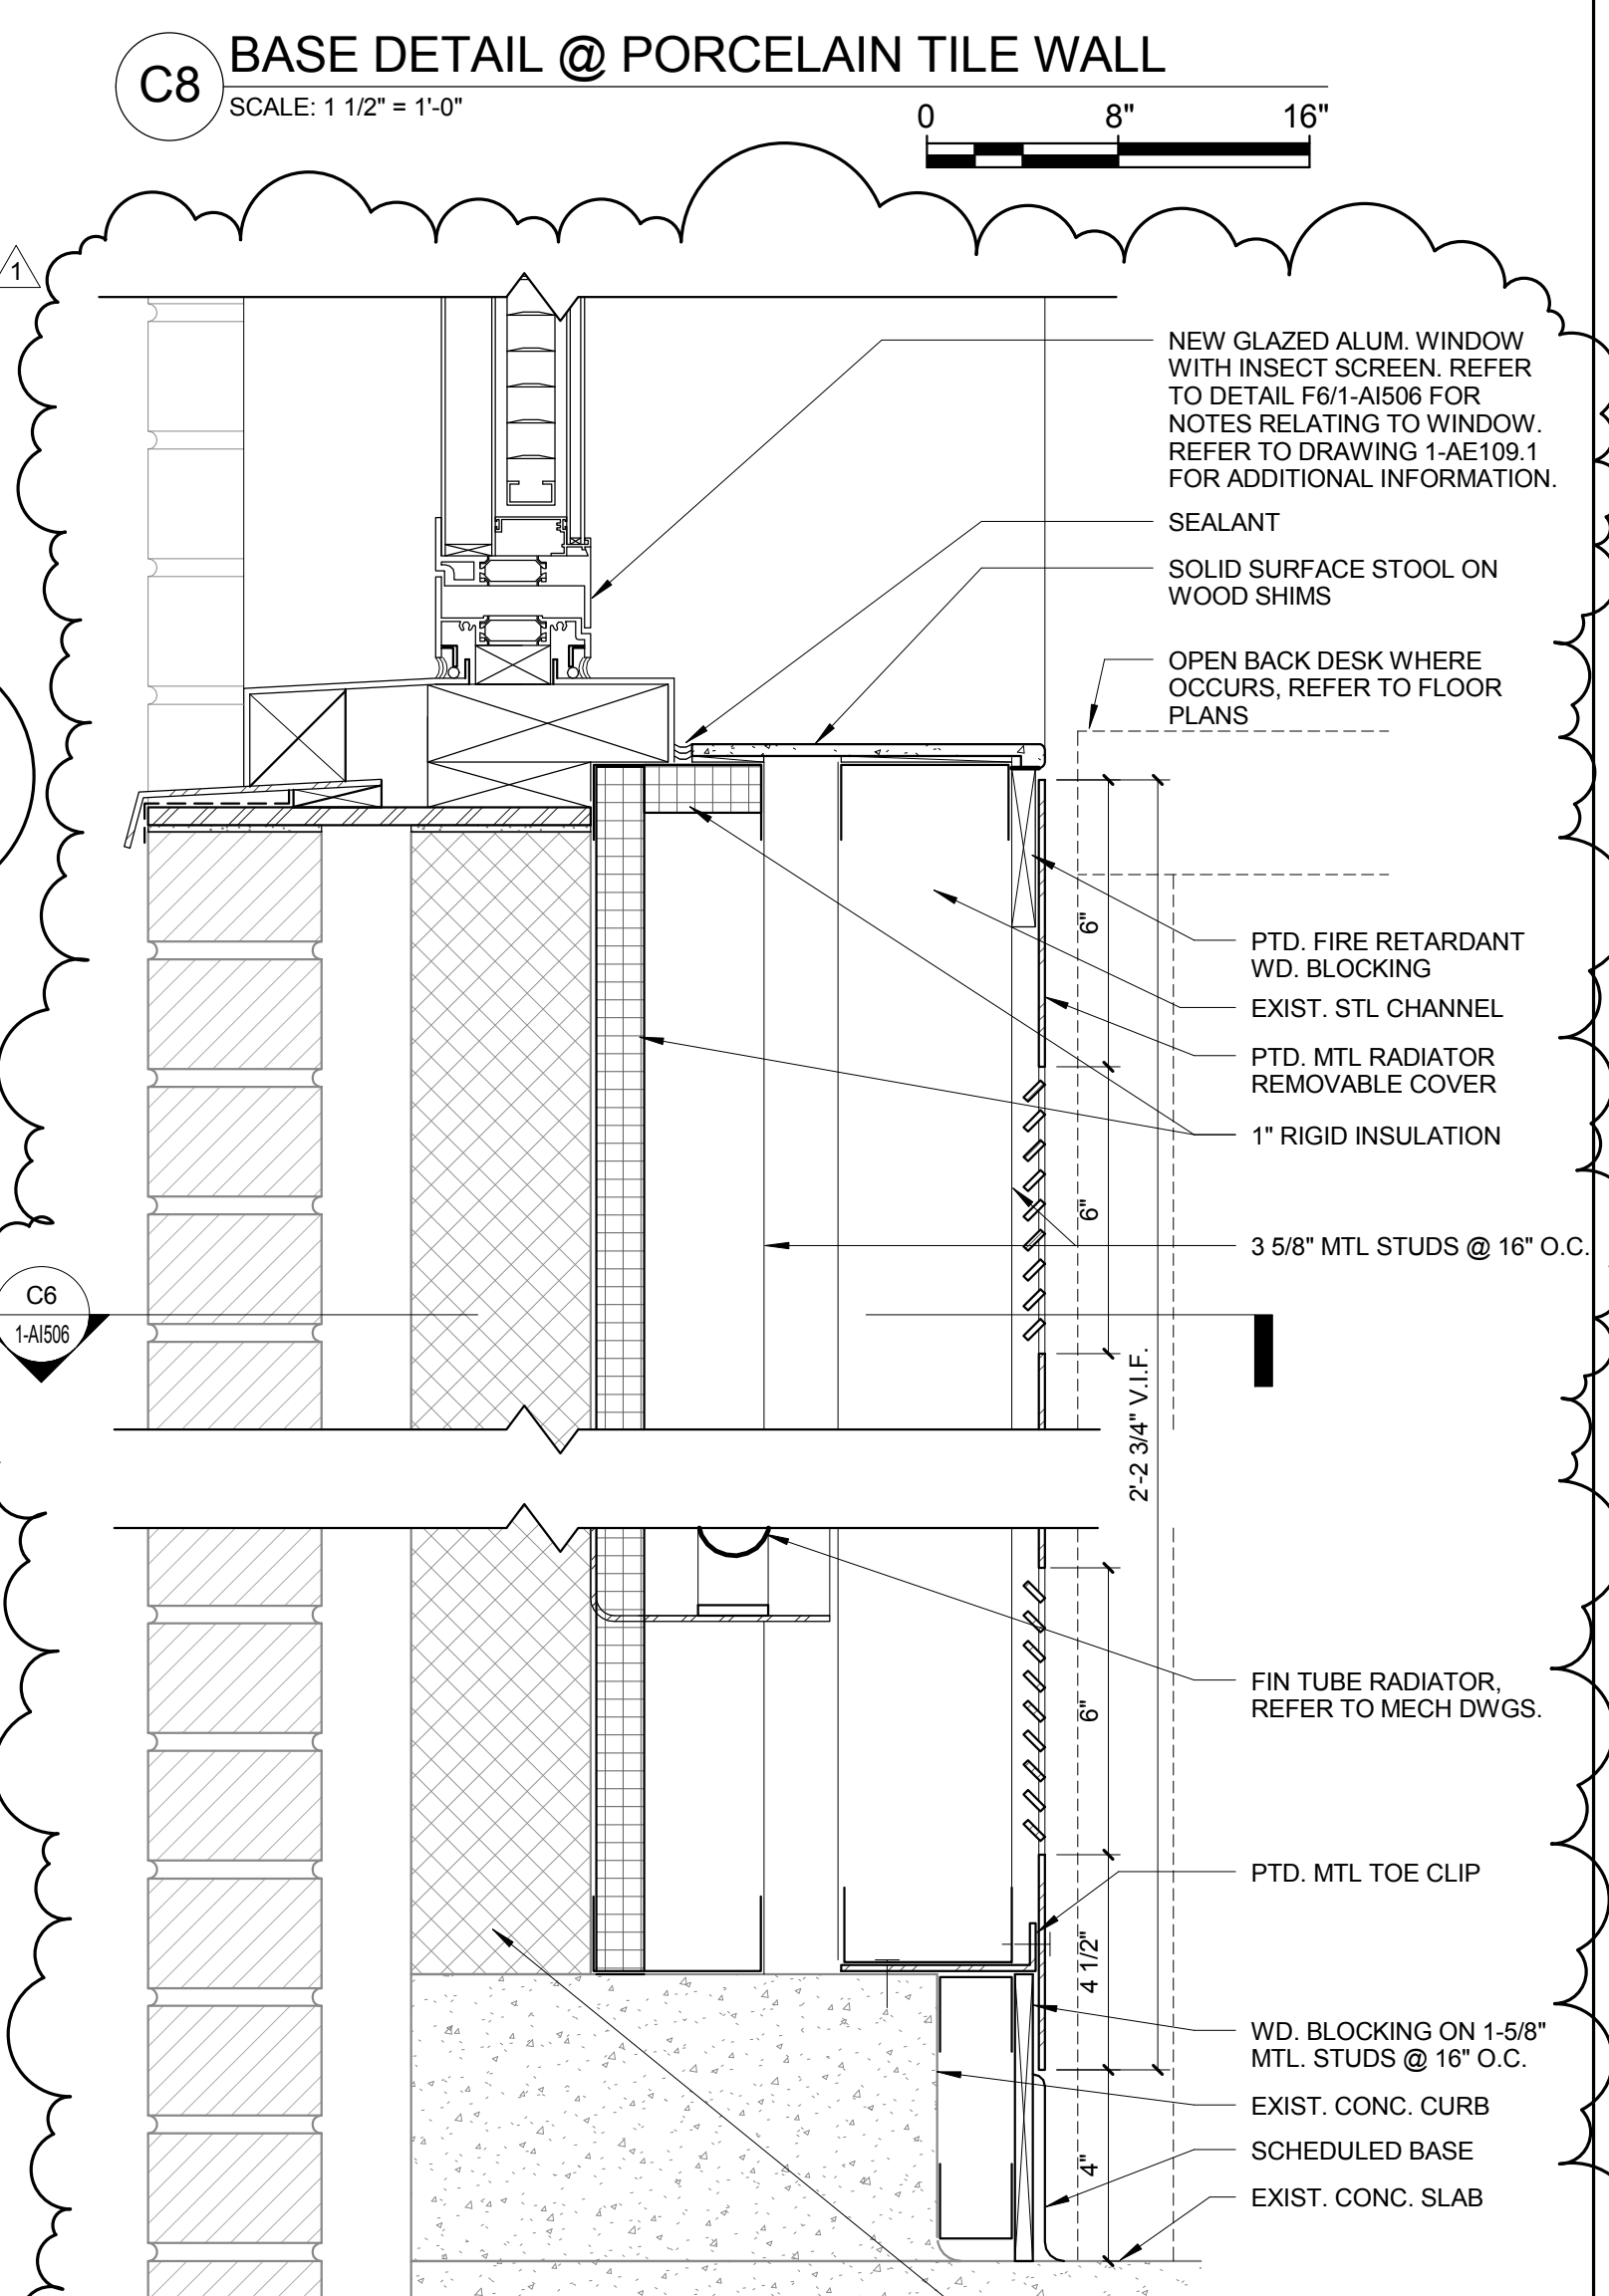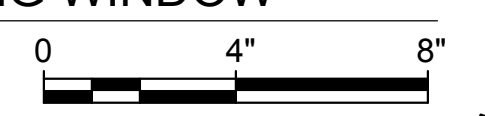

C8 BASE DETAIL @ PORCELAIN TILE WALL
SCALE: 1 1/2" = 1'-0"



CONSULTANTS: ASBESTOS ABATEMENT CONSULTANT: Egan Environmental Consulting, Inc. 14 HIGH STREET MAHWAH, NEW JERSEY 07430 Tel: (201) 848-7790 Fax: (201) 848-7791		KEY PLAN:		ARCHITECT/ENGINEERS: CANNONDESIGN 360 Madison Avenue, New York, New York 10017 212.972.9800 Baltimore • Boston • Buffalo • Calgary • Chicago Houston • Los Angeles • Mumbai • New York • Phoenix St. Louis • San Francisco • Shanghai • Toronto Vancouver • Victoria • Washington DC		Drawing Title INTERIOR DETAILS Approved: Project Director		Project Title VA NY HARBOR HEALTHCARE SYSTEM MANHATTAN VAMC - BUILDING 1 9TH FLOOR RENOVATIONS Location 423 EAST 23RD STREET NEW YORK, NY 10010 Date AUGUST 8, 2013 Checked AH/DT Drawn MK		Project Number 630PR2600 Building Number 1 Drawing Number 1-AI506 Scale: AS NOTED		Office of Construction & Facilities Management VA U.S. Department of Veterans Affairs	
ADDENDUM #4 Revisions: 09/24/2013 Date ISSUED FOR CONSTRUCTION													