


# Missoula CBOC

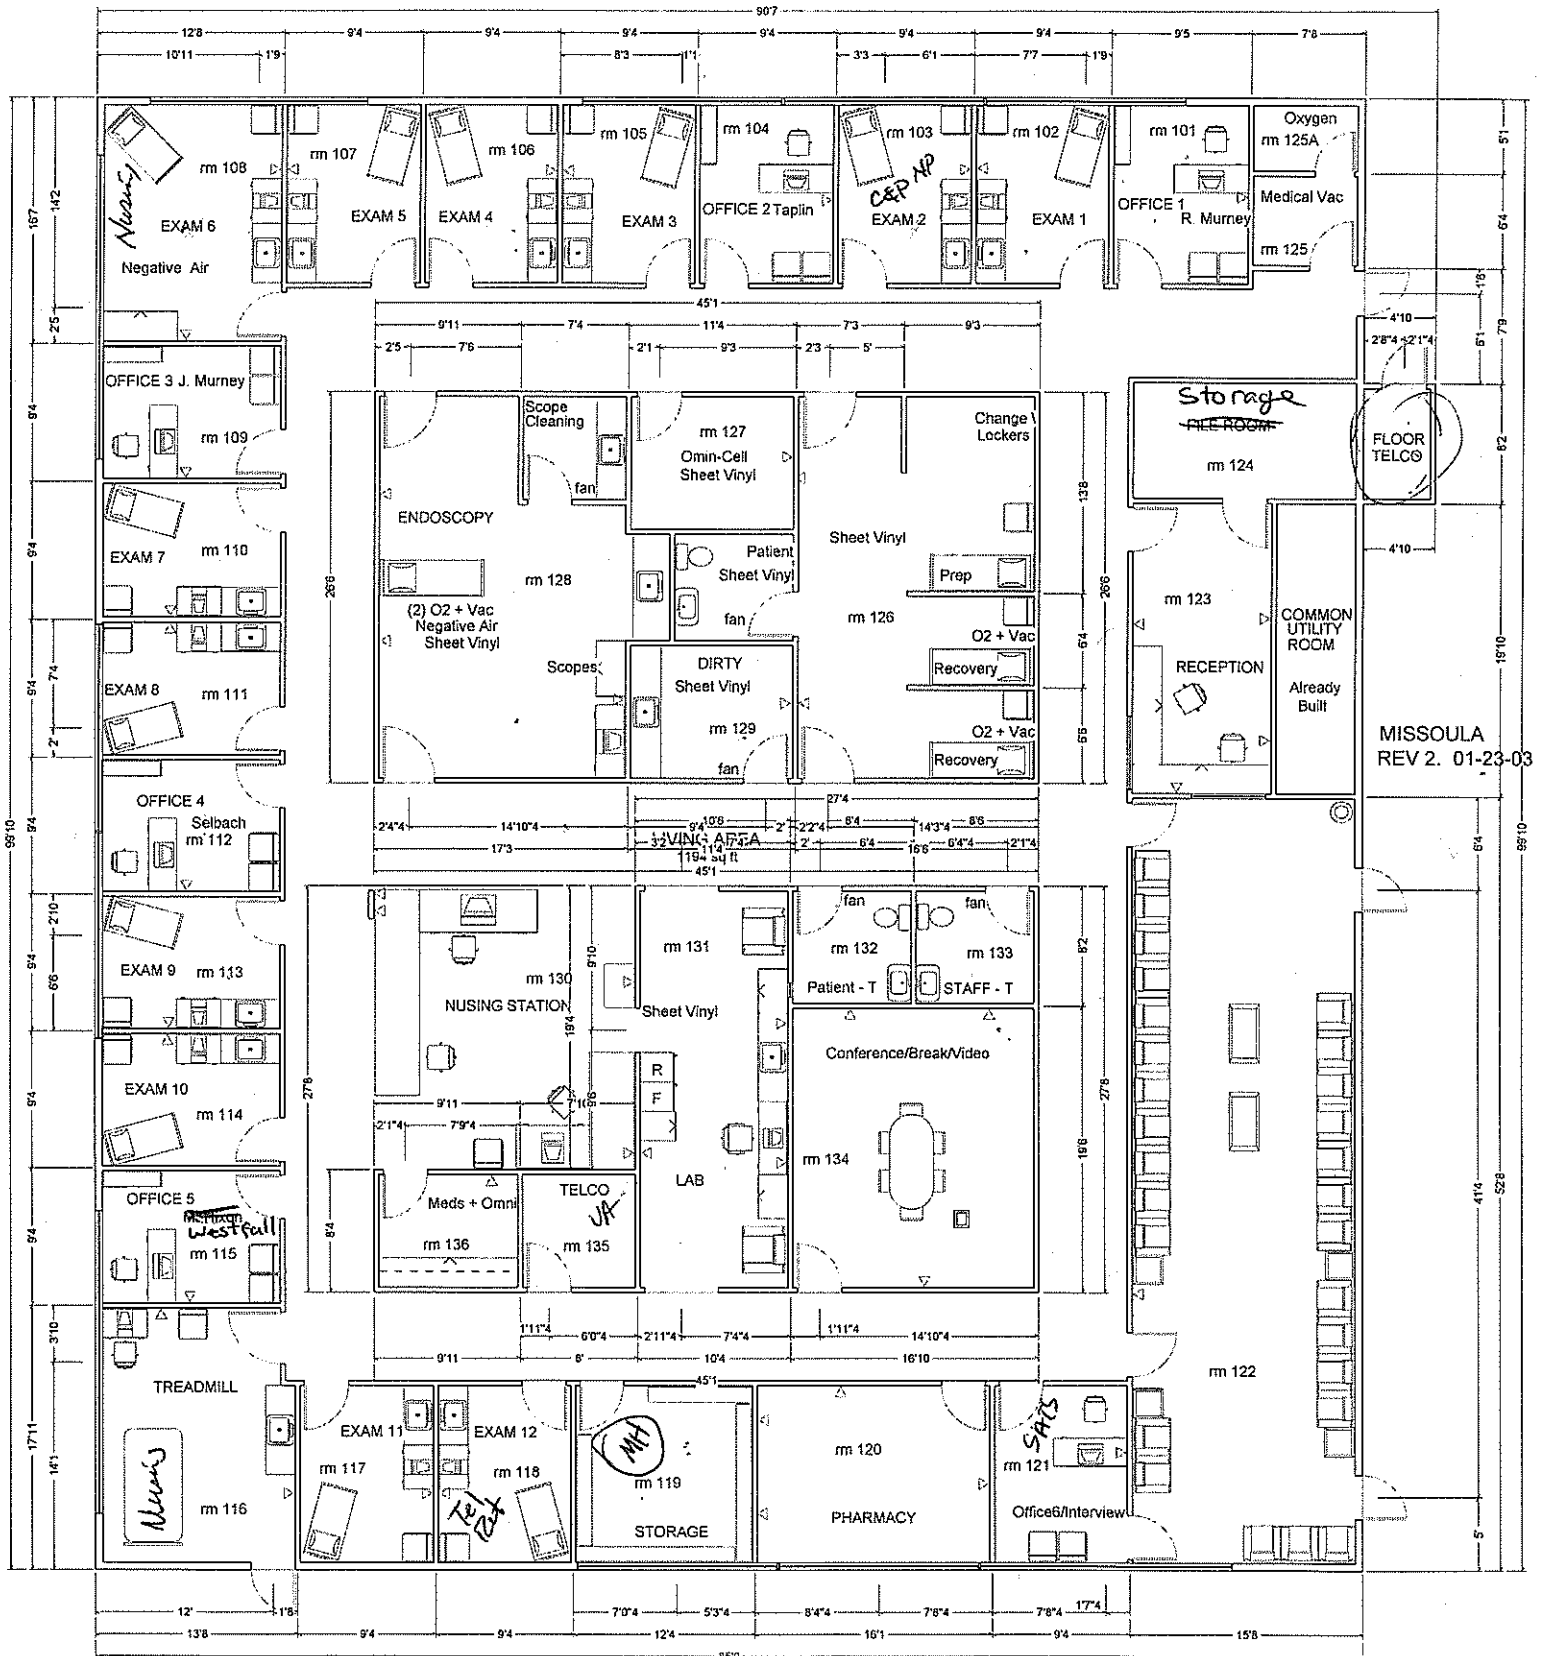

MISSOULA  
REV 2. 01-23-03