

**BUILDING IS FULLY SPRINKLERED**

[illegible]

**ARCHITECT/ENGINEERS:**

**ELMER BECKETT**

**FLF**

A JOINT VENTURE

145 Lincoln Avenue  
Wheaton, Md. 20789  
407 647 1030

1001 G Street, N.W., Suite 1000  
Washington, D.C. 20001  
202 654 9300

**WAREHOUSE  
LEVEL 1 AREA B  
CONSTRUCTION PLAN**

Approved Project Director

*Malin Stokic*

**Project Title**

**A NEW HOSPITAL FOR  
VAMC ORLANDO, FLORIDA**

**Location**

Orlando, Florida

**Date**

22 JUNE 2009

**Checked**

Checker

**Drawn**

EB / RJF

**Project Number**

673-460

**Building Number**

05


**Drawing Number**

W-AE1.1A2

Desig. 001 of 287

**OFFICE OF  
FACILITIES  
MANAGEMENT**

1001 G Street, N.W., Suite 1000  
Washington, D.C. 20001  
202 654 9300

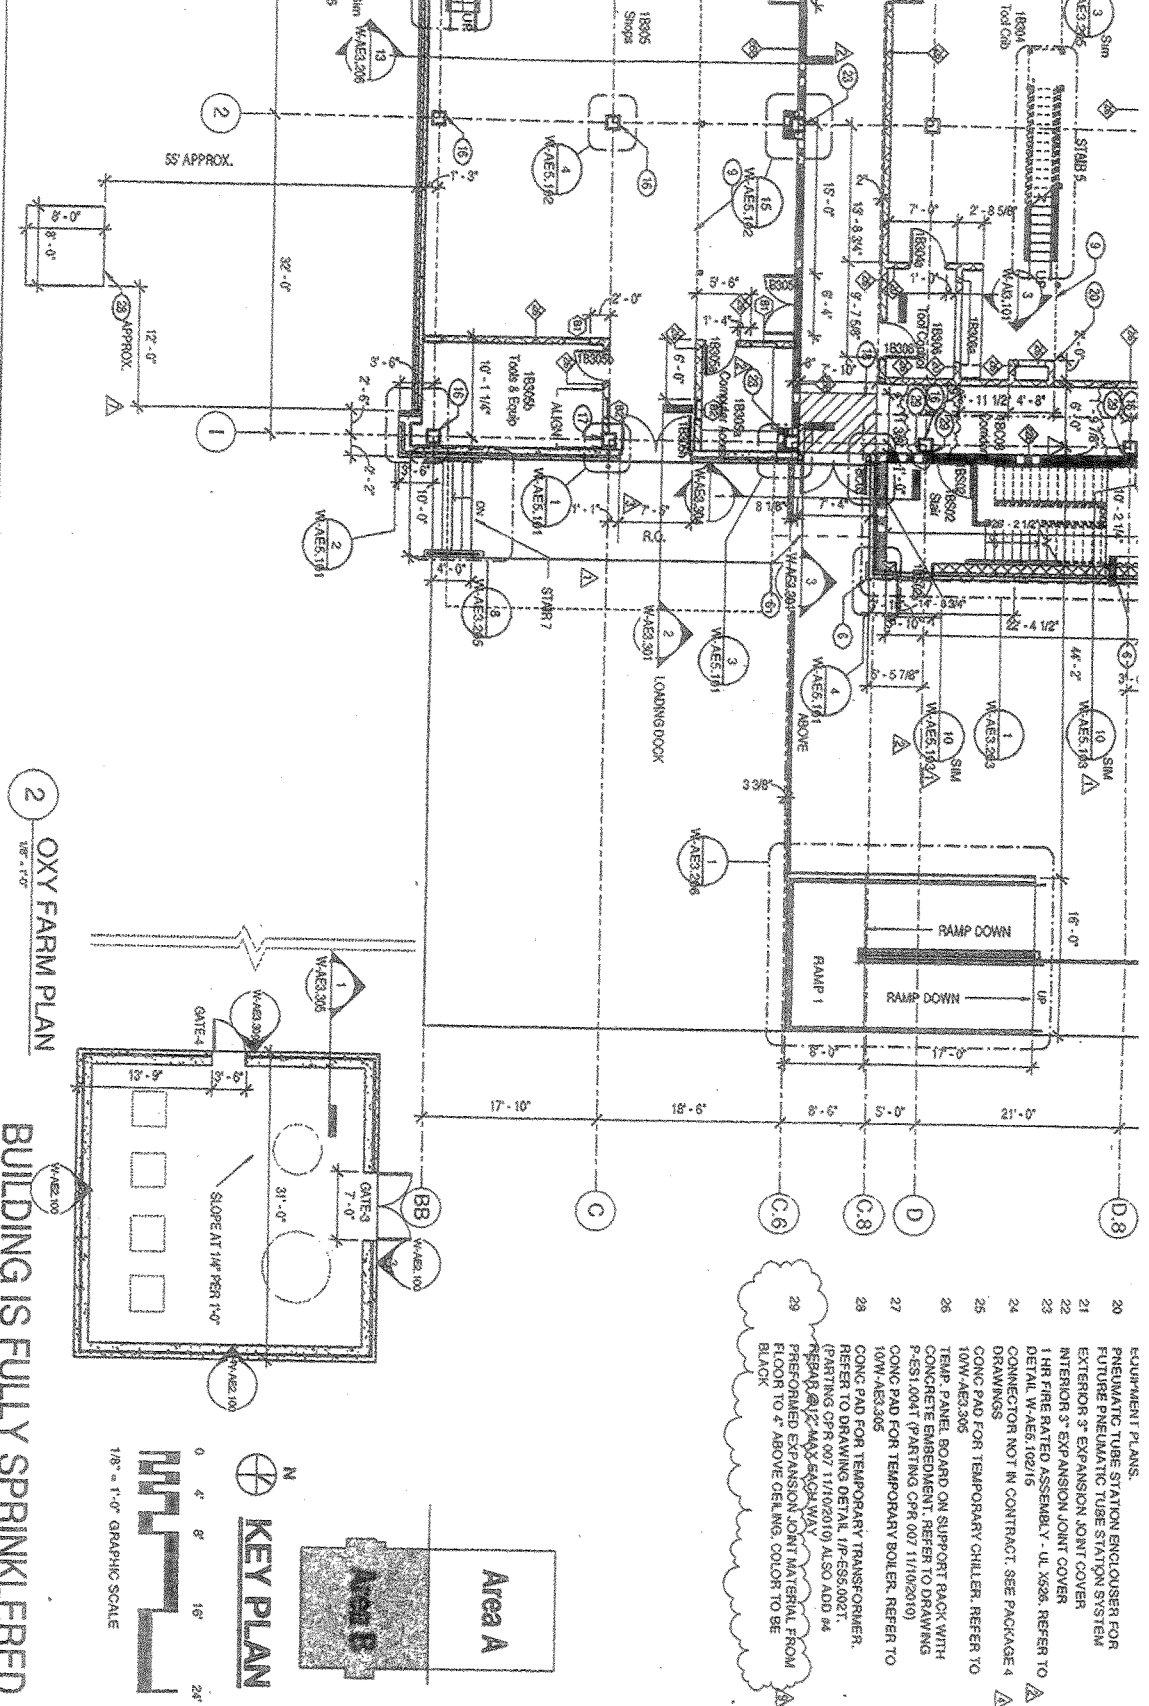

5 6 7 8 9