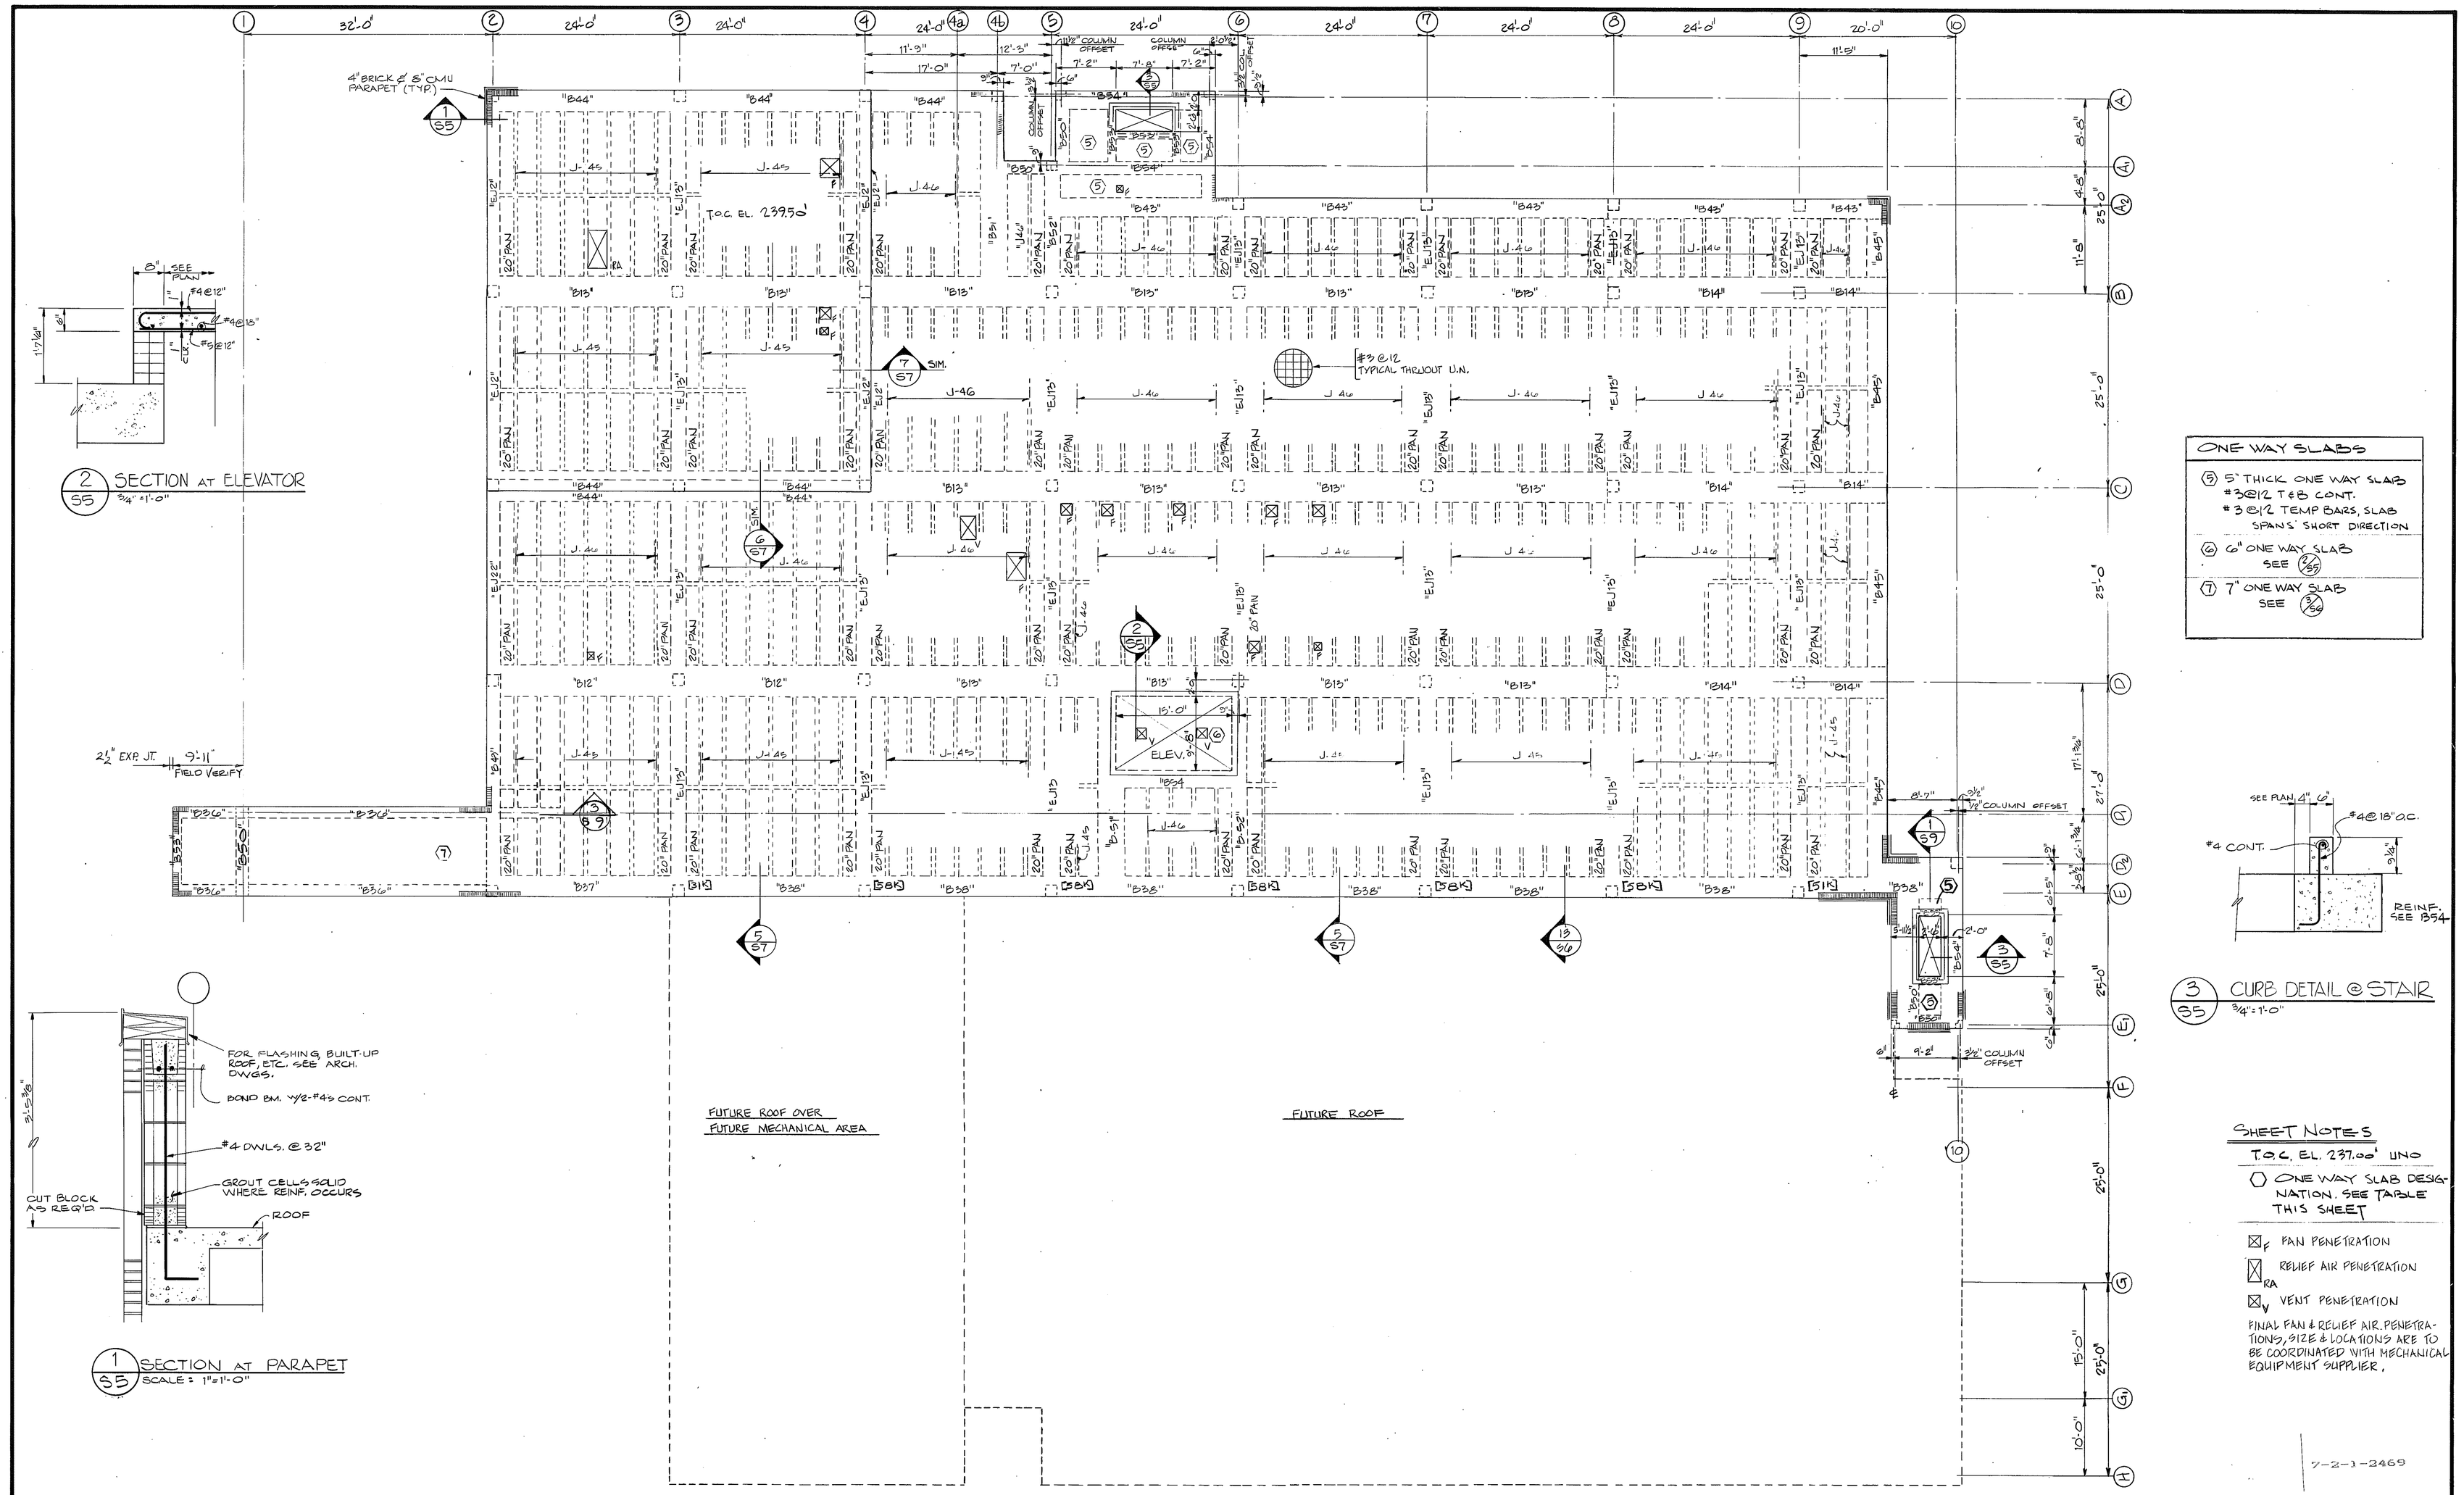

2/S5 SECTION AT ELEVATOR
3/4" = 1'-0"

1/S5 SECTION AT PARAPET
SCALE: 1" = 1'-0"

3/S5 CURB DETAIL @ STAIR
3/4" = 1'-0"

ONE WAY SLABS

(5)	5" THICK ONE WAY SLAB #3@12 T&B CONT. #3@12 TEMP BARS, SLAB SPANS SHORT DIRECTION
(6)	6" ONE WAY SLAB SEE 2/S5
(7)	7" ONE WAY SLAB SEE 3/S6

SHEET NOTES

T.O.C. EL. 237.00' UNO

○ ONE WAY SLAB DESIGNATION. SEE TABLE THIS SHEET

☒F FAN PENETRATION

☒RA RELIEF AIR PENETRATION

☒V VENT PENETRATION

FINAL FAN & RELIEF AIR PENETRATIONS, SIZE & LOCATIONS ARE TO BE COORDINATED WITH MECHANICAL EQUIPMENT SUPPLIER.

7-2-1-2469

AS BUILT JUN 1 1988

Revisions | Date

KEY PLAN

Planning Architecture Engineering
Odell Associates Inc.
222 South Church Street
Charlotte, NC 28202
ODELL

Drawing Title: ROOF FRAMING PLAN		Project Title: CLINICAL ADDITION	Date: MAR. 29, 1985
Approved: Division Chief	Drawn	Building Number: 1	Project No.: 565-027
Approved: Service Director	Checked	Location: V.A.M.C.-FAYETTEVILLE, N.C.	DRAWING No.: 1-S5 Dwg. Of

Veterans Administration

VA FORM 08-6231, OCT 1978

Proj. #1420