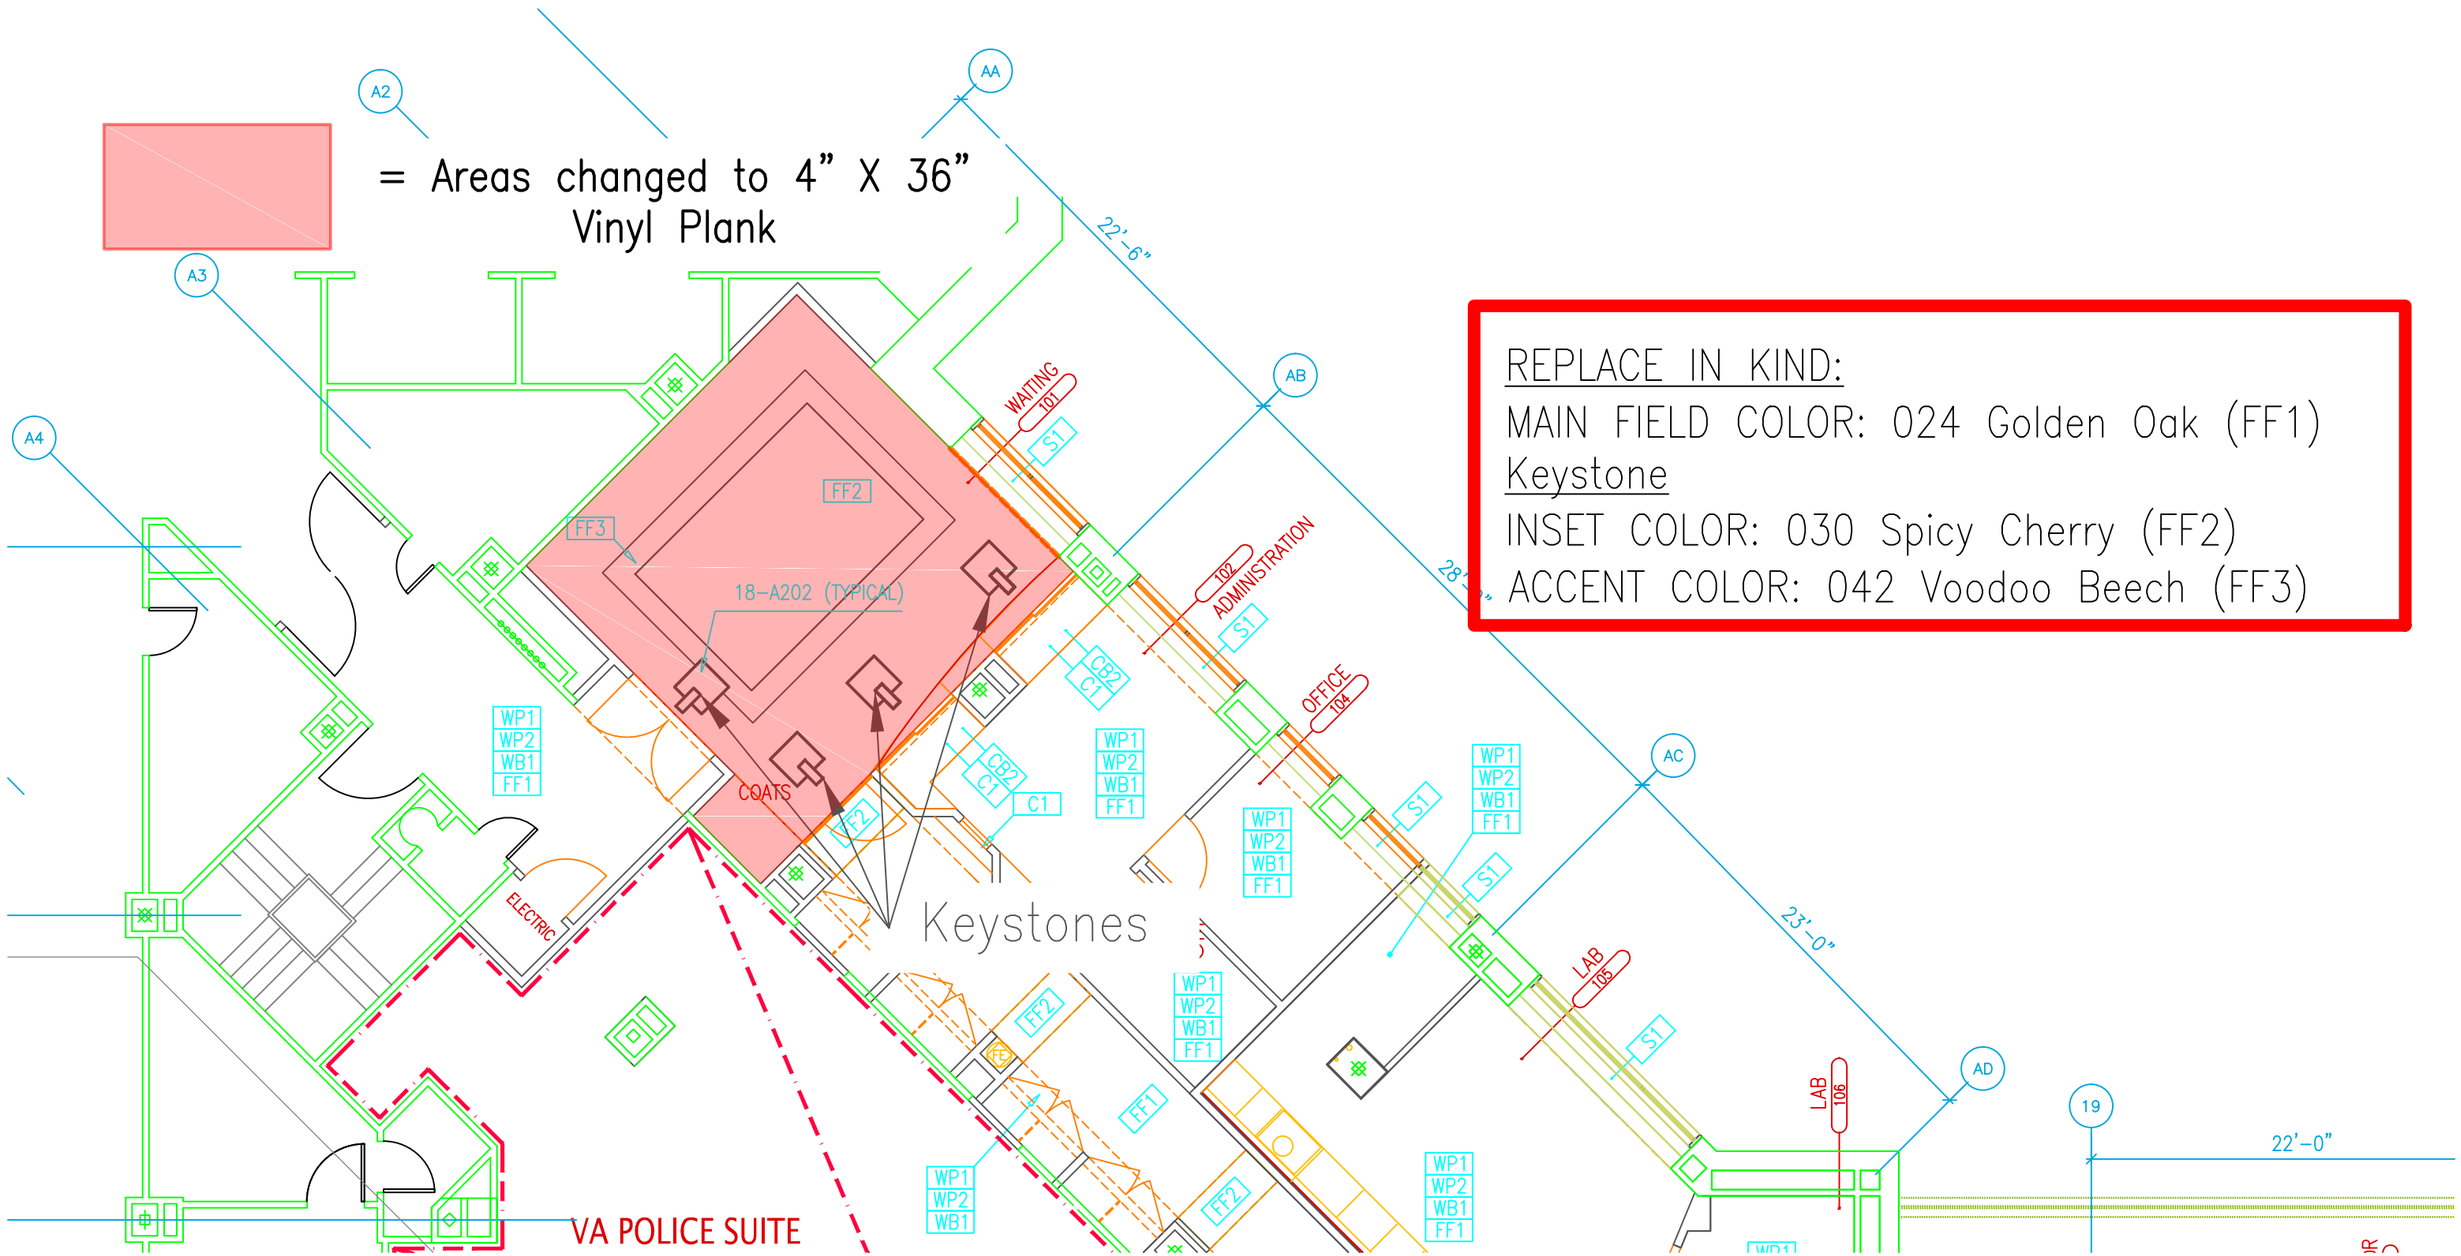

REPLACE IN KIND:
MAIN FIELD COLOR: 024 Golden Oak (FF1)
Keystone
INSET COLOR: 030 Spicy Cherry (FF2)
ACCENT COLOR: 042 Voodoo Beech (FF3)