


inches = one foot
 one and one-half inch = one foot
 one inch = one foot
 three-quarters inch = one foot
 one-half inch = one foot
 three-eighths inch = one foot
 quarter inch = one foot
 one-eighth inch = one foot

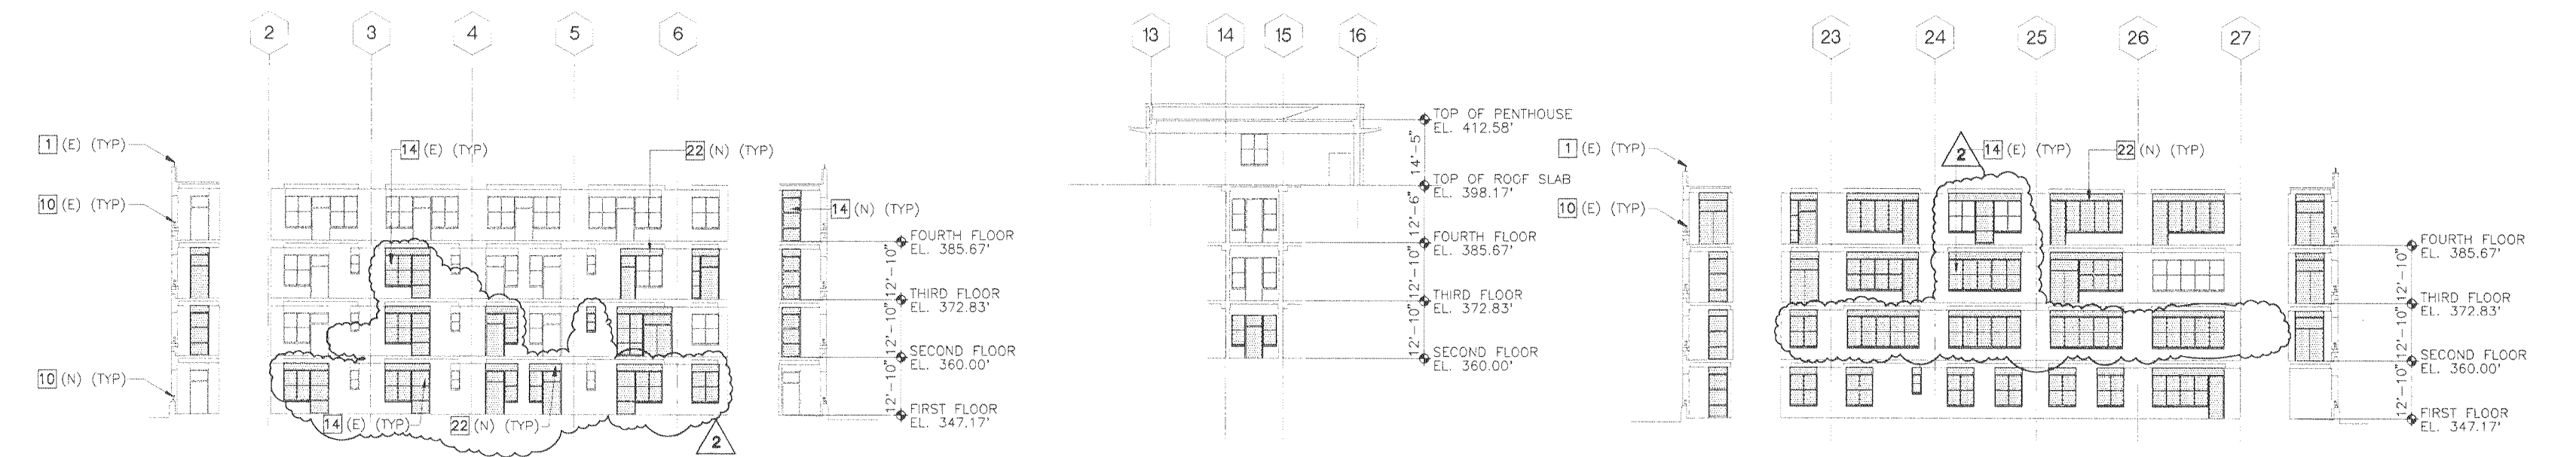

LANAI ELEVATIONS

SCALE 1/16" = 1'-0"

ELEVATION KEYNOTES

- 1 METAL PIPE RAILING
- 2 SHT. METAL LEADER PIPE
- 2A SHT. METAL GUTTER
- 3 SHT. METAL DOWNSPOUT
- 4 P.I.P. CONC. WALL
- 5 TILED CONC. OVERHANG
- 6 AREAWAY
- 7 CONC. TRIM
- 8 CERAMIC TILE VENEER, CLEAN & POLISH
- 9 AC GRILLE
- 10 ALUMINUM GUARDRAIL
- 11 LOUVER
- 12 ROLL-UP DOOR
- 13 CONC. WATERTABLE
- 14 ALUM. WINDOW
- 15 PIPE SPACE
- 16 SEISMIC JOINT
- 17 CMU BLOCK (8")
- 18 METAL DOOR
- 19 CMU WALL (12")
- 20 PRECAST CONC. SCUPPER
- 21 SKIM COAT PLASTER
- 22 METAL PANEL

NOTES:

1. PATCH TO MATCH EXISTING CHIPPED, SPALLED, DETERIORATED, & OTHER DAMAGED SURFACES, & SURFACES DAMAGED DURING, & DUE TO DEMOLITION WORK.
2. PATCH TO MATCH VOIDS, DUE TO REMOVAL OF DEMOLITION ITEMS.
3. PAINT NEW SURFACES. REPAINT PAINTED EXISTING SURFACES.

LEGEND:

- NEW
- EXISTING

ABBREVIATIONS:

- (N) NEW
- (E) EXISTING

AMENDMENT DRAWING - AMENDS 8HT. T1-74

<p>AMENDMENT NO. 2</p> <p>4/18/97</p>	<p>BID SET DOCUMENTS</p>	<p>ARCHITECTS HAWAII LIMITED</p> <p>1001 Bishop Street, Pacific 300 Honolulu, Hawaii 96813 Telephone: (808) 523-9636 FAX: (808) 521-3280</p>	<p>This work was prepared by me or under my supervision and construction of this project will be under my supervision.</p> <p><i>[Signature]</i> Signature</p> <p>NOTE: Contractor to check and verify all dimensions at job before proceeding with work.</p>	<p>WALTER H. MURDOCK LICENSED PROFESSIONAL ARCHITECT No. 5035 HAWAII, U.S.A.</p>	<p>Drawing Title PARTIAL EXTERIOR ELEVATIONS</p> <p>Approved: Area Project Manager <i>[Signature]</i></p>	<p>Project Title AMBULATORY CARE CLINIC AND RENOVATE E-WING PHASE II, E-WING RENOVATION</p> <p>Building Number T1</p> <p>Location VAMROC, HONOLULU, HAWAII</p>	<p>Date MARCH 20, 1997</p> <p>Project No. 459-002B</p> <p>Drawing No. T1-74R2 Dep. 126 of 392</p>	
---------------------------------------	--------------------------	--	--	---	--	--	--	--