



- Rev. 1 (8) Remove existing Exterior Door


- 1 It is the contractors responsibility to repair or replace any areas (walls, adjacent floors etc) that have been damaged by the contractor during construction.
- 2 Normal working hours are from 7am to 5:30pm Monday through Friday. Contractor can request different working hours in writing if needed.
- 3 Contractor is to keep work area clean of debris at all times.



- Rev. 1 **16** Repair existng crack in basement wall

- Rev. 1 **17** Install new Exterior metal door, frame and hardware. Hardware to match existing hardware used by Facility

1. It is the contractor's responsibility to repair or replace any areas (walls, adjacent floors etc) that have been damaged by the contractor during construction.
2. Normal working hours are from 7am to 5:30pm Monday through Friday. Contractor can request different working hours in writing if needed.
3. Contractor is to keep work areas clean of debris at all times.
4. Seal all penetrations in floors above and in existing walls. Seal around all wires, conduit, ductwork, pipes and any other items extending into or out of work area.
5. Contractor to give 48-hour notice prior to any power, water, gas or ARC interruptions.
6. Contractor to maintain negative pressure in work area when sealing CMU Walls and Concrete floors. If fumes or odors extend into the floors above the contractor is to use caulk application and schedule for either night or weekend application.
7. Contractor to rotate speaker heads to the downward position and extend to suspension ceiling. Install flush mount sprinkler heads.

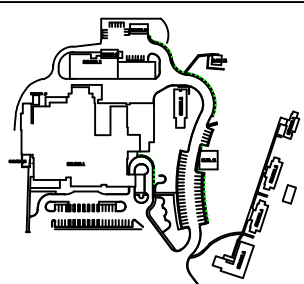

APPROVED:	APPROVED: SAFETY MANAGER	APPROVED: CHIEF, FACILITIES MANAGEMENT SERVICE LINE	APPROVED: MEDICAL CENTER DIRECTOR
	JUSTIN GREENE	TED HAMB	KARIN McGRAW, MSN, FACHE
APPROVED:	APPROVED: INFECTION CONTROL	APPROVED: ASSOCIATE DIRECTOR for PATIENT CARE SERVICES/EXECUTIVE NURSE	APPROVED: ASSOCIATE DIRECTOR
	CARLA RAYNES	DEBRA LEGG, RN, MSN	BRIAN NIMMO, MS
APPROVED:	APPROVED:	APPROVED: SERVICE LINE CHIEF	APPROVED: CHIEF OF STAFF
			JOHN D. BERRYMAN, M. D.

DRAWING TITLE: Demolition/ New Work			DRAWING No. AS-101
PROJECT TITLE: Correct Storage Area Building 6			PROJECT No. 517-14-108
			DRAWN BY: JPP
DATE 5/7/13	REV. Rev. 1	SCALE NTS	CHECKED BY: KB, JH

Medical Center  
200 Veterans Av  
Beckley, WV.  
25801



**NOT TO SCALE**