





EXTERIOR PERIMETER ELEVATIONS NOS. 1 THRU 8

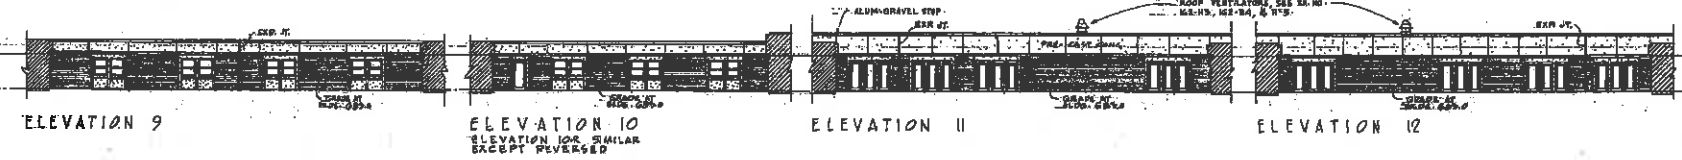


INTERIOR COURTS 1 & 2 - ELEVATIONS 9 THRU 12

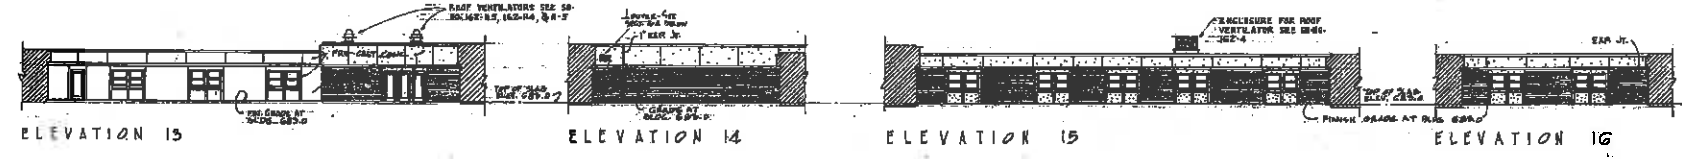

INTERIOR COURT 3 - ELEVATIONS 13 THRU 16

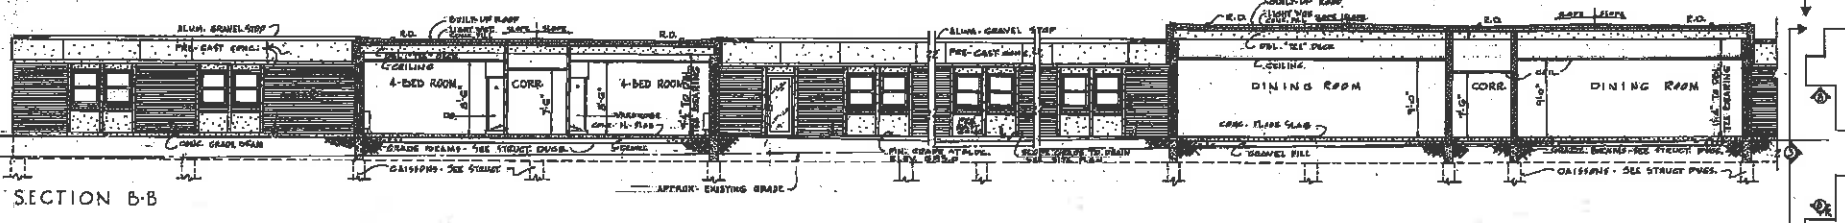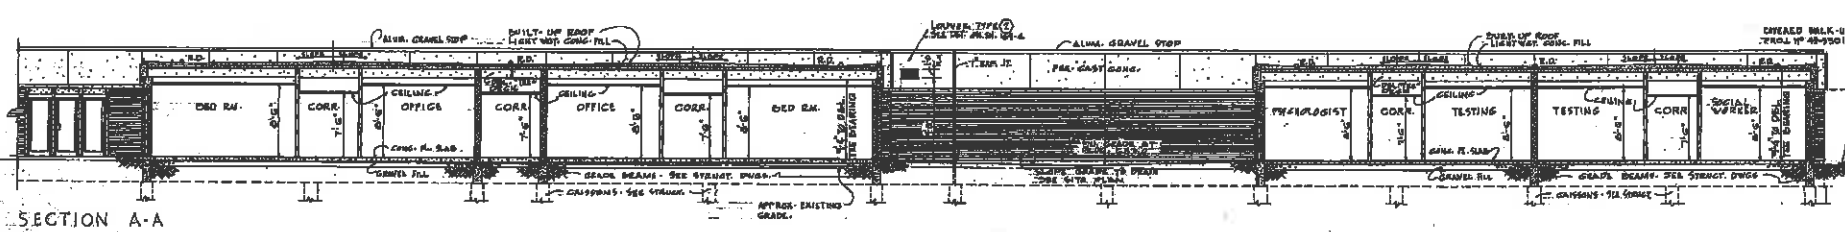


BUILDING CROSS SECTIONS A-A & B-B

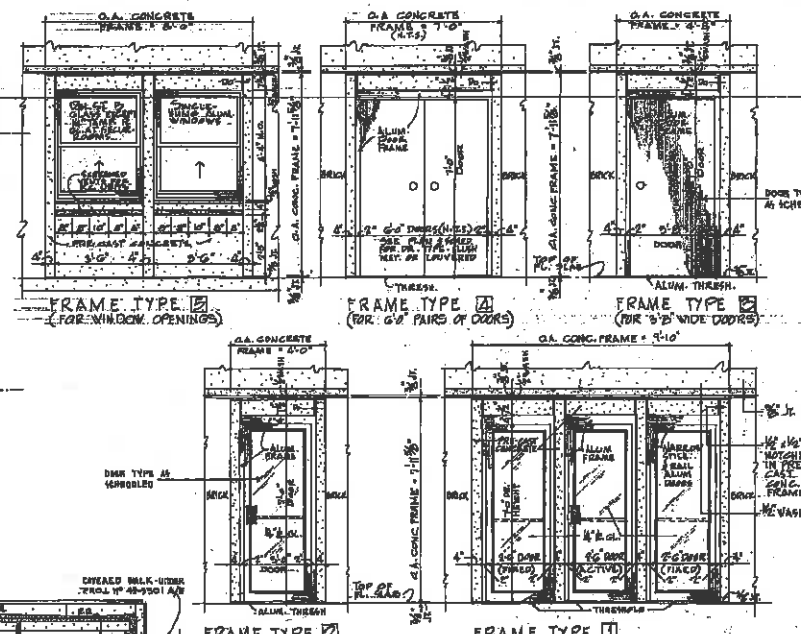


PRE-CAST CONCRETE FRAME TYPES

NOTES:
1. PRE-CAST CONCRETE FRAME TYPES ARE NOTED ON PLAN, THUS: [Symbol]
2. SEE MAIN ENTRANCE DETAIL ON 102-7 FOR DETAILS OF TYPE 1 FRAME.

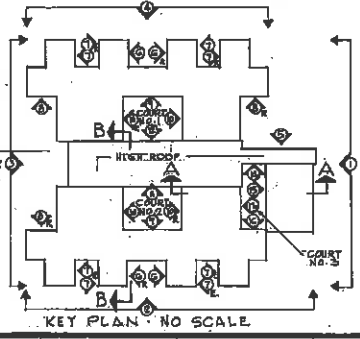

ELEVATIONS & BUILDING SECTIONS	
BUILDING NO. 102	
240 BED NEUROPSYCHIATRIC BUILDING & ALTERATIONS TO BUILDINGS 58 & 147	
VETERANS ADMINISTRATION	
TEMPLE, TEXAS	
Drawn: J.L.R.	Check: J.L.R.
Date: 5-1-64	Date: 5-1-64
Approved: Alex. H. Van Kester, Jr.	Division Chief
162-5	Rev. 5 of 12
APPROVED: DIRECTOR ARCH. STRUCT. SERVICE	File No. 42-5001

IF THIS PROJECT IS CHOSEN TO BE PHASED AS SHOWN, PHASE 1 MAY INCLUDE REPAIRING THE PORTION OF THE BUILDING TO REMAIN TEMPORARILY UNTIL THE PHASE 2 DEMO CAN BE COMPLETED. THIS WORK (ALTERNATE #1) IS INTENDED TO BE TEMPORARY TO ADD AESTHETIC APPEAL TO THE BUILDING BETWEEN PHASES.

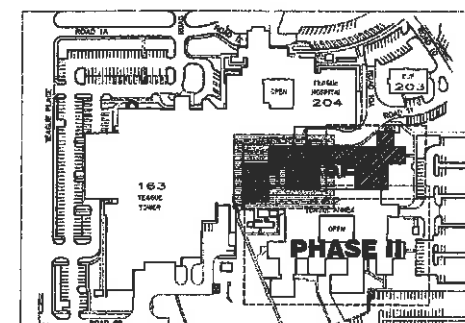

KEY PLANTS

1 SITE PLAN
3/32" = 1'-0"



DEMOLITION PLAN EXISTING

Approved: Project Manager
VICTOR GAW

Project Title
**DEMOLITION BLDG 162
PHASE 1 & 2**

	Location
--	----------

1	2	
---	---	---	---	---	---	---	---	---	----	----	-----	-----	

TEMPLE VAMC - TEMPLE, TX.



162-A-1.1

Dwg. of

Veterans

No.	Date	By	Revisions
-----	------	----	-----------

GENERAL NOTES:
IF THIS PROJECT IS CHOSEN TO BE PHASED AS SHOWN, PHASE 1 MAY INCLUDE REPAIRING THE PORTION OF THE BUILDING TO REMAIN TEMPORARILY UNTIL THE PHASE 2 DEMO CAN BE COMPLETED. THIS WORK (ALTERNATE #1) IS INTENDED TO BE TEMPORARY TO ADD AESTHETIC APPEAL TO THE BUILDING BETWEEN PHASES.

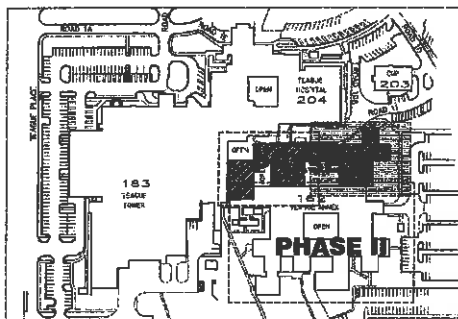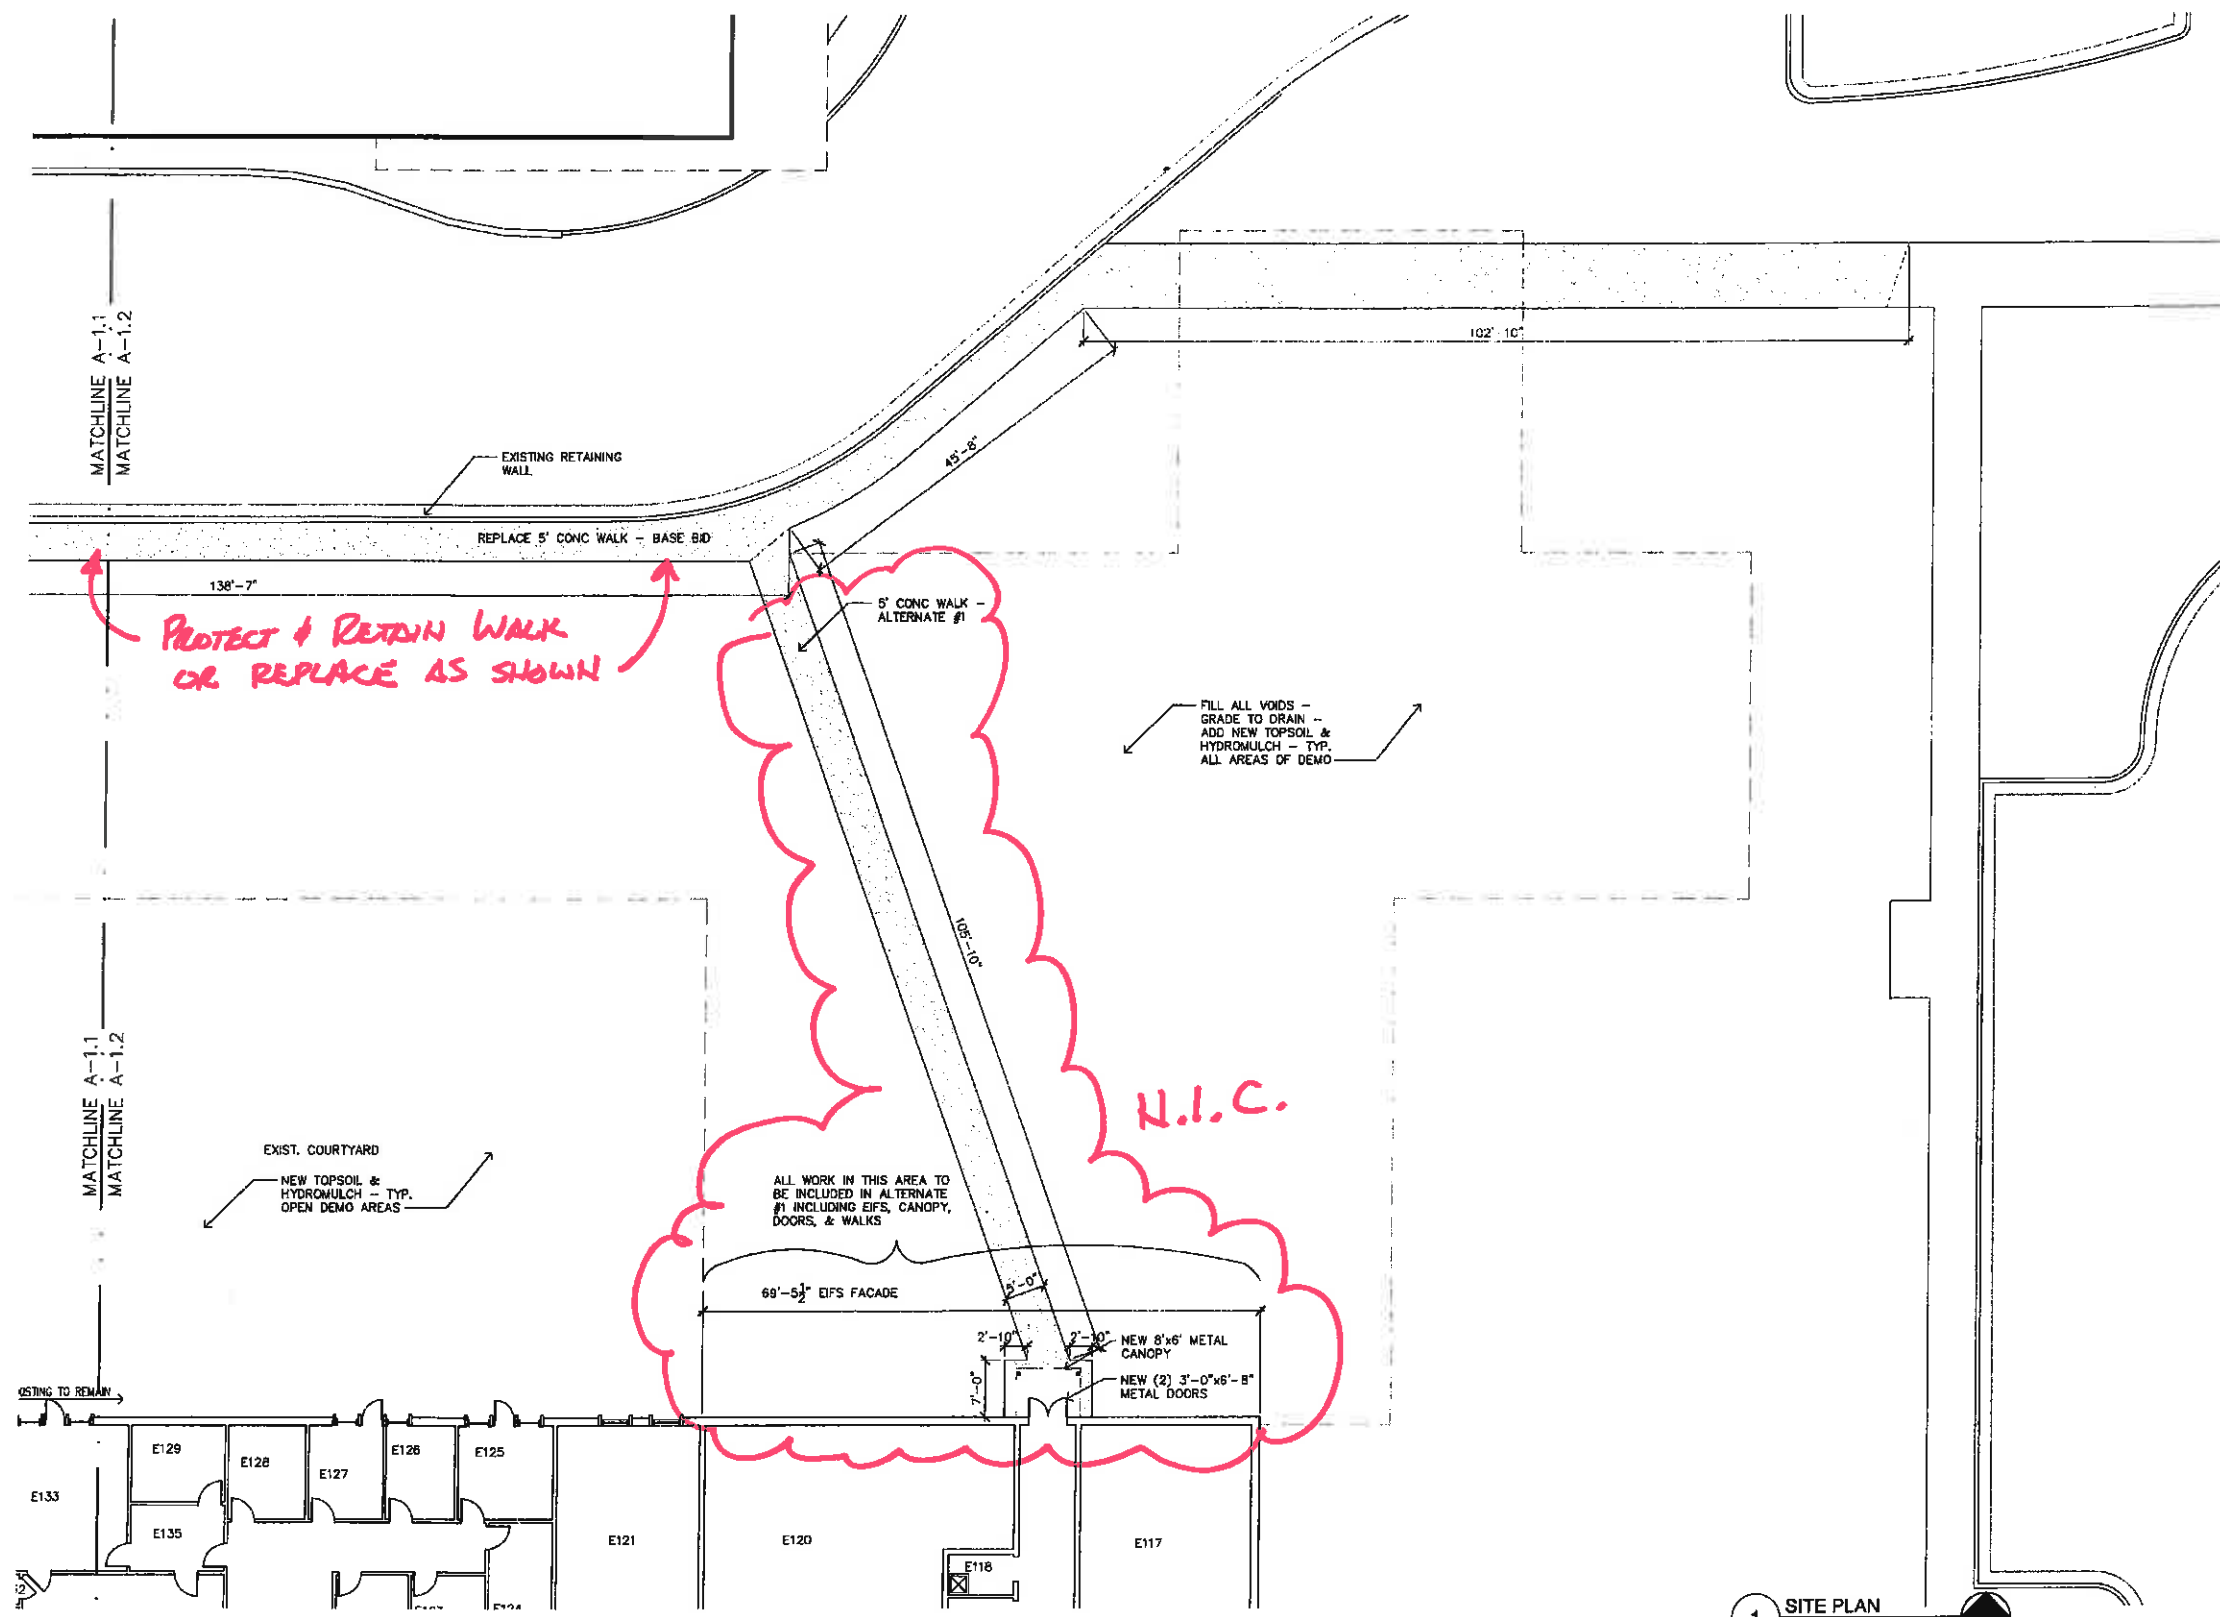

1 SITE PLAN
3/32" = 1'-0"

No.	Date	By	Revisions




**Architectural
Edge Inc.**

3010 Scott Blvd.
Suite 102
Temple, Texas
76504

254.771.2054 P
254.773.2144 F

•architecture
•design services
•consultation

email@archedge.com

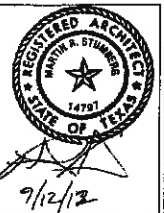

Drawing Title	DEMOLITION PLAN EXISTING	
Approved: Chief, Facilities Management Service	DAVID SUMMERS	
Approved: Project Manager	VICTOR GAW	

Project Title	DEMOLITION BLDG 162 PHASE 1 & 2	
Building Number	162	Checked
Location	TEMPLE VAMC - TEMPLE, TX.	

Date	09/13/12
PO No.	674-11-110
Drawing No.	162-A-1.2
Dwg	01

Veterans Affairs