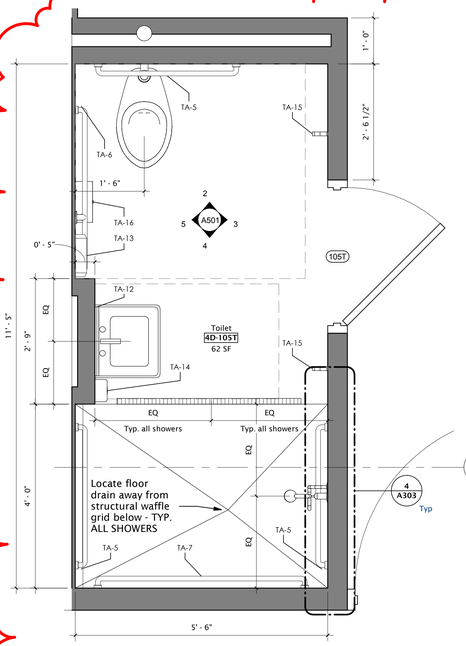

1 A204 **Enlarged Pat. Bathroom 105T**
3/4" = 1'-0"

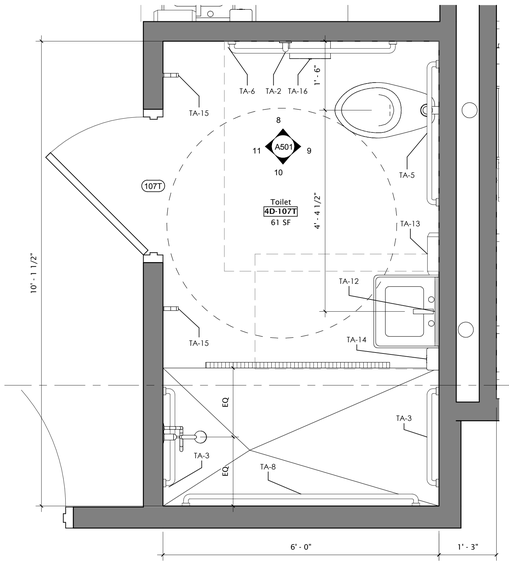

2 A204 **Enlarged Pat. Bathroom 107T**
3/4" = 1'-0"

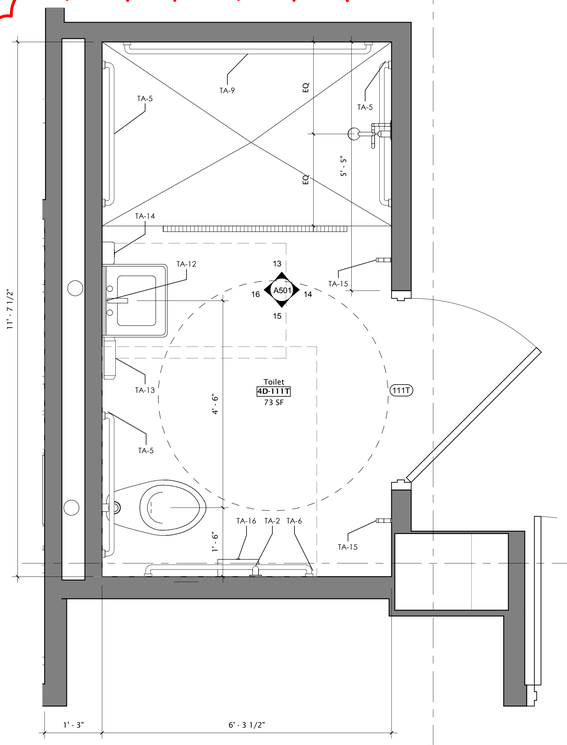

3 A204 **Enlarged Pat. Bathroom 111T**
3/4" = 1'-0"

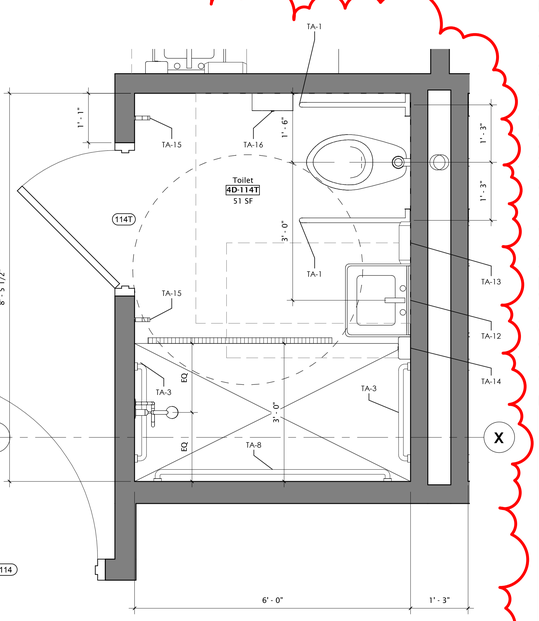

4 A204 **Enlarged Pat. Bathroom 114T**
3/4" = 1'-0"

TOILET ACCESSORY SCHEDULE		
Code	Item	Remarks
TA-1	Swing Up Grab Bar	Grab bar is manually lowered to horizontal support position and raised for departure. Bar is designed to prevent it from accidentally falling into position. Bar operates with less than 5 pounds of force.
TA-2	18" Grab Bar	
TA-3	24" Grab Bar	
TA-4	30" Grab Bar	
TA-5	36" Grab Bar	
TA-6	42" Grab Bar	
TA-7	54" Grab Bar	
TA-8	60" Grab Bar	
TA-9	63" Grab Bar	
TA-10	66" Grab Bar	
TA-11	Swing Up Grab Bar with Toilet Paper Hook	Grab bar is manually lowered to horizontal support position and raised for departure. Bar is designed to prevent it from accidentally falling into position. Bar operates with less than 5 pounds of force.
TA-12	Mirror 18" x 36"	
TA-13	Paper Towel Dispenser	To be furnished by VA and installed by GC
TA-14	Soap Dispenser	To be furnished by VA and installed by GC
TA-15	Robe Hook	
TA-16	Toilet Paper Dispenser	To be furnished by VA and installed by GC
TA-17	Soap Dish	
TA-18	Mop Rack	
TA-19	Stainless Steel Shelf	
TA-20	Shower Curtain Track	For Non-Wet and Wet Areas

SEE RCP AND ELEVATIONS FOR DETAILS.

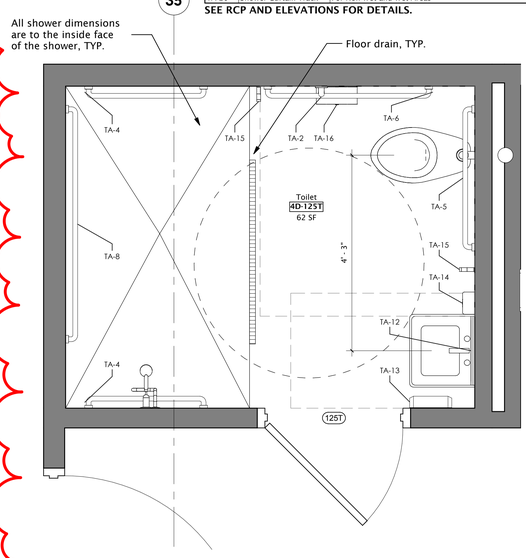

5 A204 **Enlarged Pat. Bathroom 125T**
3/4" = 1'-0"

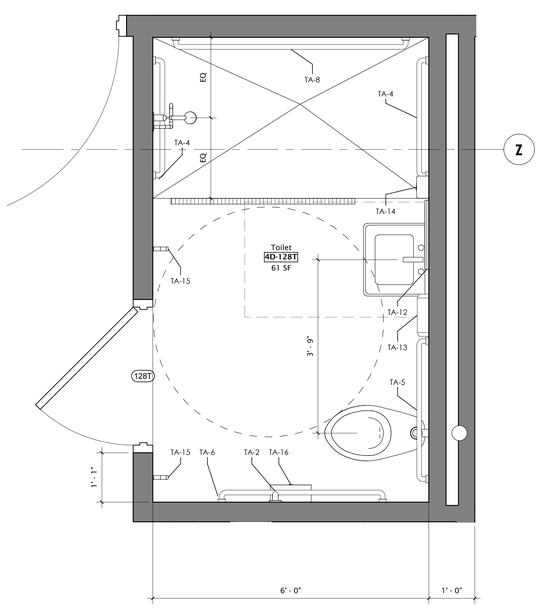

6 A204 **Enlarged Pat. Bathroom 128T**
3/4" = 1'-0"

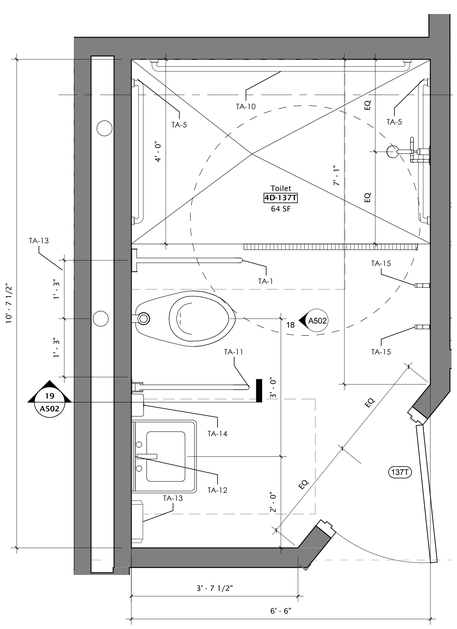

7 A204 **Enlarged Pat. Bathroom 137T**
3/4" = 1'-0"

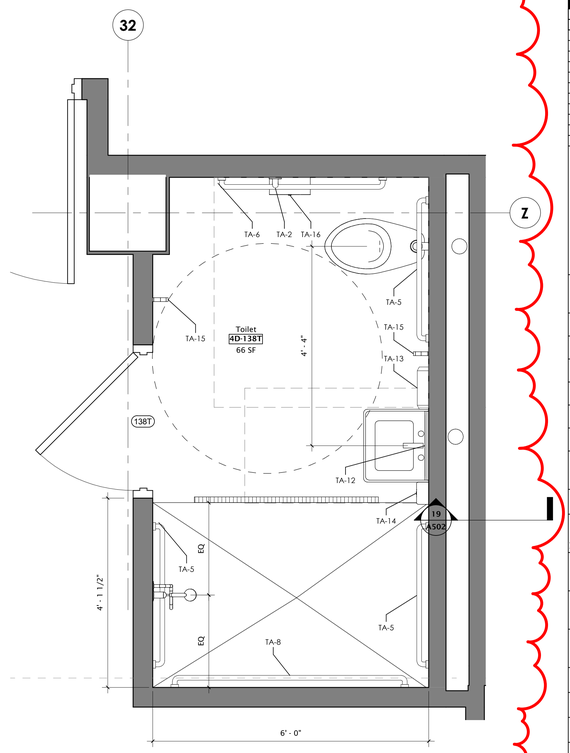

8 A204 **Enlarged Pat. Bathroom 138T**
3/4" = 1'-0"

ROUGHTON • NICKELSON • DE LUCA
Architects, PA
3608 University Drive, Suite 204
Durham, NC 27707
T 919.490.1266 F 919.490.1396
www.RNDpa.com

ROUGHTON NICKELSON DE LUCA ARCHITECTS, PA
REGISTERED ARCHITECTURAL CORPORATION
CERT. NO. 400
DURHAM, N. C.
NORTH CAROLINA

COMMONWEALTH OF VIRGINIA
Gustavo C. De Luca
0401016243
ARCHITECT
6/12/2013

REVISIONS

REV.	DESCRIPTION	DATE
1	Addendum # 1	11/14/13

© 2013 Roughton Nickelson De Luca Architects, PA. These drawings and specifications are instruments of service whose ownership and copyright are transferred to the US Department of Veterans Affairs(client) upon project completion, under the following conditions: Their use is restricted to the original site for which they were prepared and publication there-of is expressly limited to such use. The documents are project-specific and are not intended for re-use on other projects. Any re-use by the client without the involvement of Roughton Nickelson De Luca Architects (RND) will be at the client's sole risk. The client agrees to defend, indemnify, and hold RND harmless from any claims brought against RND arising out of the re-use. RND reserves the right to re-use standard details of the contract documents.

RECOMMEND APPROVAL

Requestor:	Date:
Chief of Service:	Date:
Infection Control:	Date:
Chief of Staff:	Date:
Assoc. Med. Ctr. Dir.:	Date:
Drawing Title: **Enlarged Patient Toilet/Shower Plans**	
Approved Chief, Engineering Svc.	Date:
APPROVED BY: MEDICAL CENTER DIRECTOR	Date:

Project Title:
Improve Patient Privacy 4D/C Richmond VA

Building No.	Designed by:	Drawn by:	Checked by:
Main	GDL	JLMS	GDL

Location
1201 Broad Rock Blvd Richmond, VA 23224

Date 06/12/2013
Project No. Owner Proj. # 652-11-112
Project ID No. RND 1232

DRAWING NO.
A204
Sheet of

Department of VETERANS AFFAIRS

11/13/2013 2:20:42 PM