


Changes to BSL3 Lab - Magnetic Door System

Note - No Lines Required on Revised

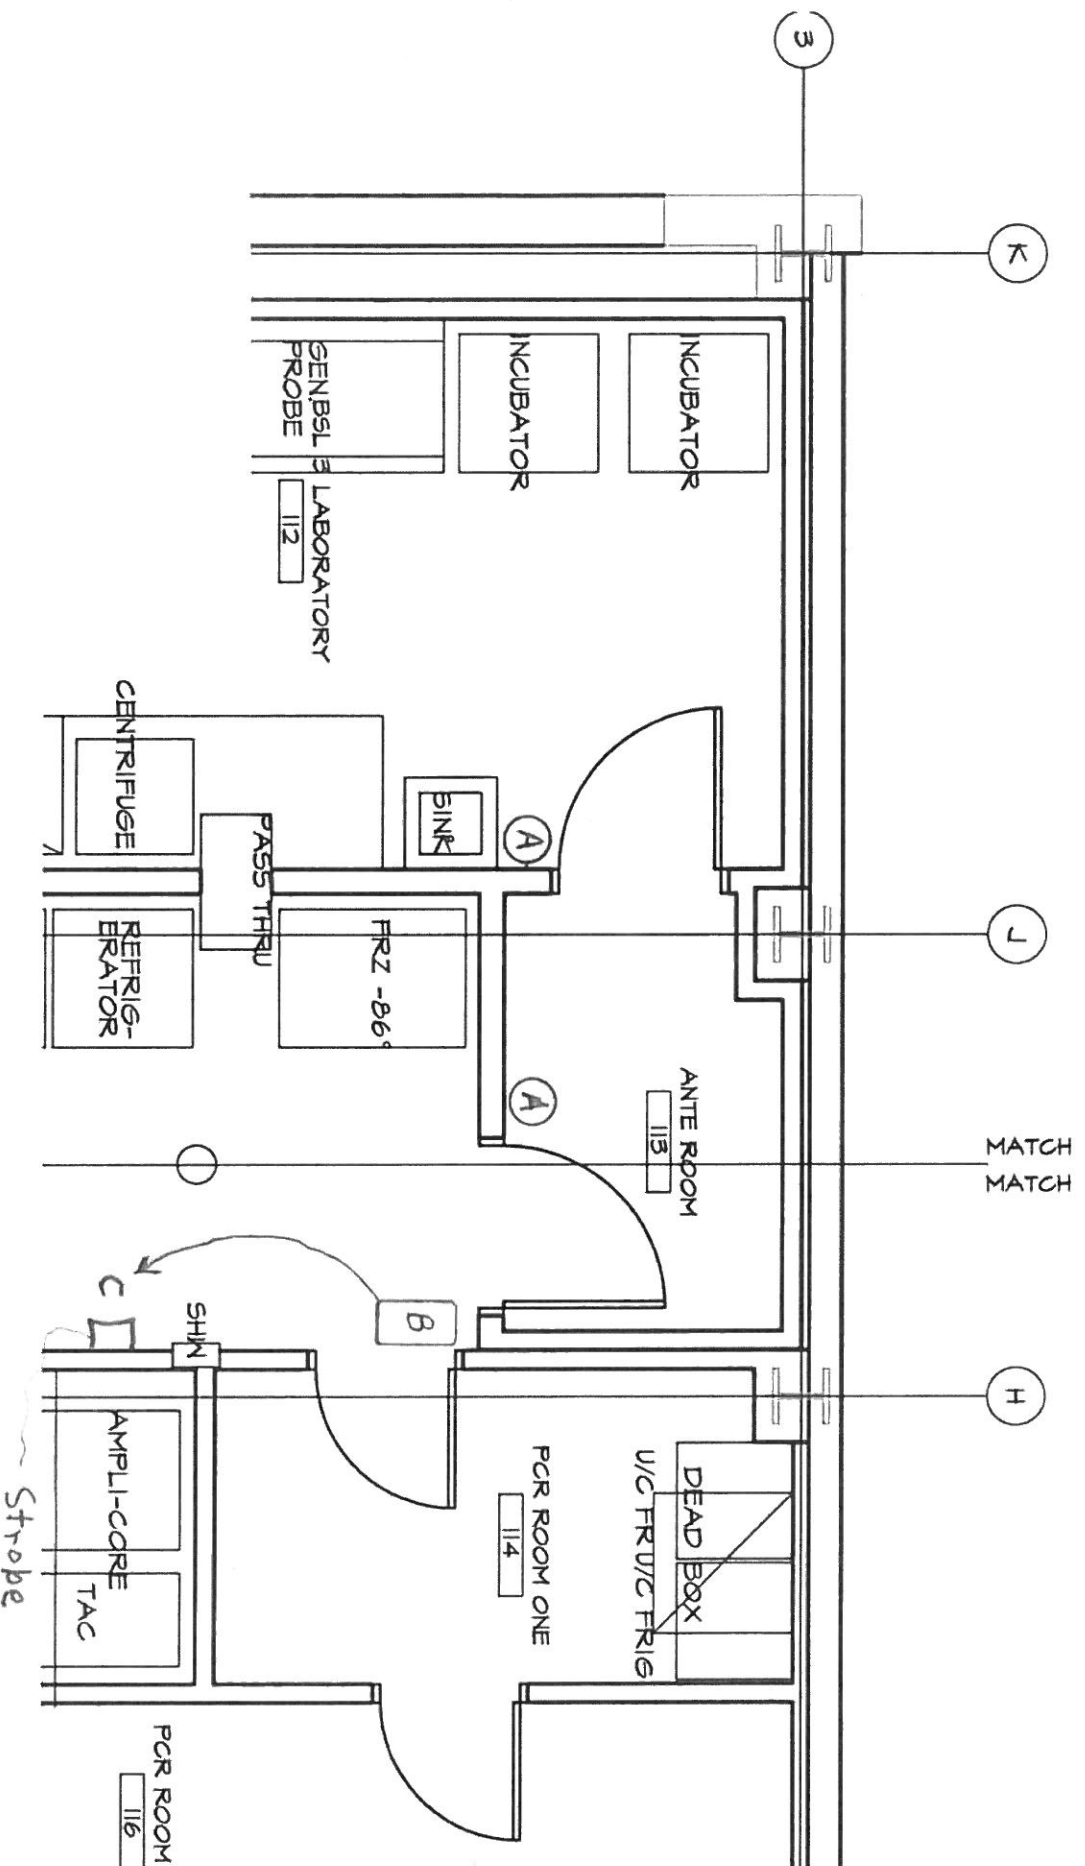

A - Emergency Release Switch (NC)

B - Power Supply and Control Panel

C - Connect system to sire alarm panel or strobe to release doors upon alarm