



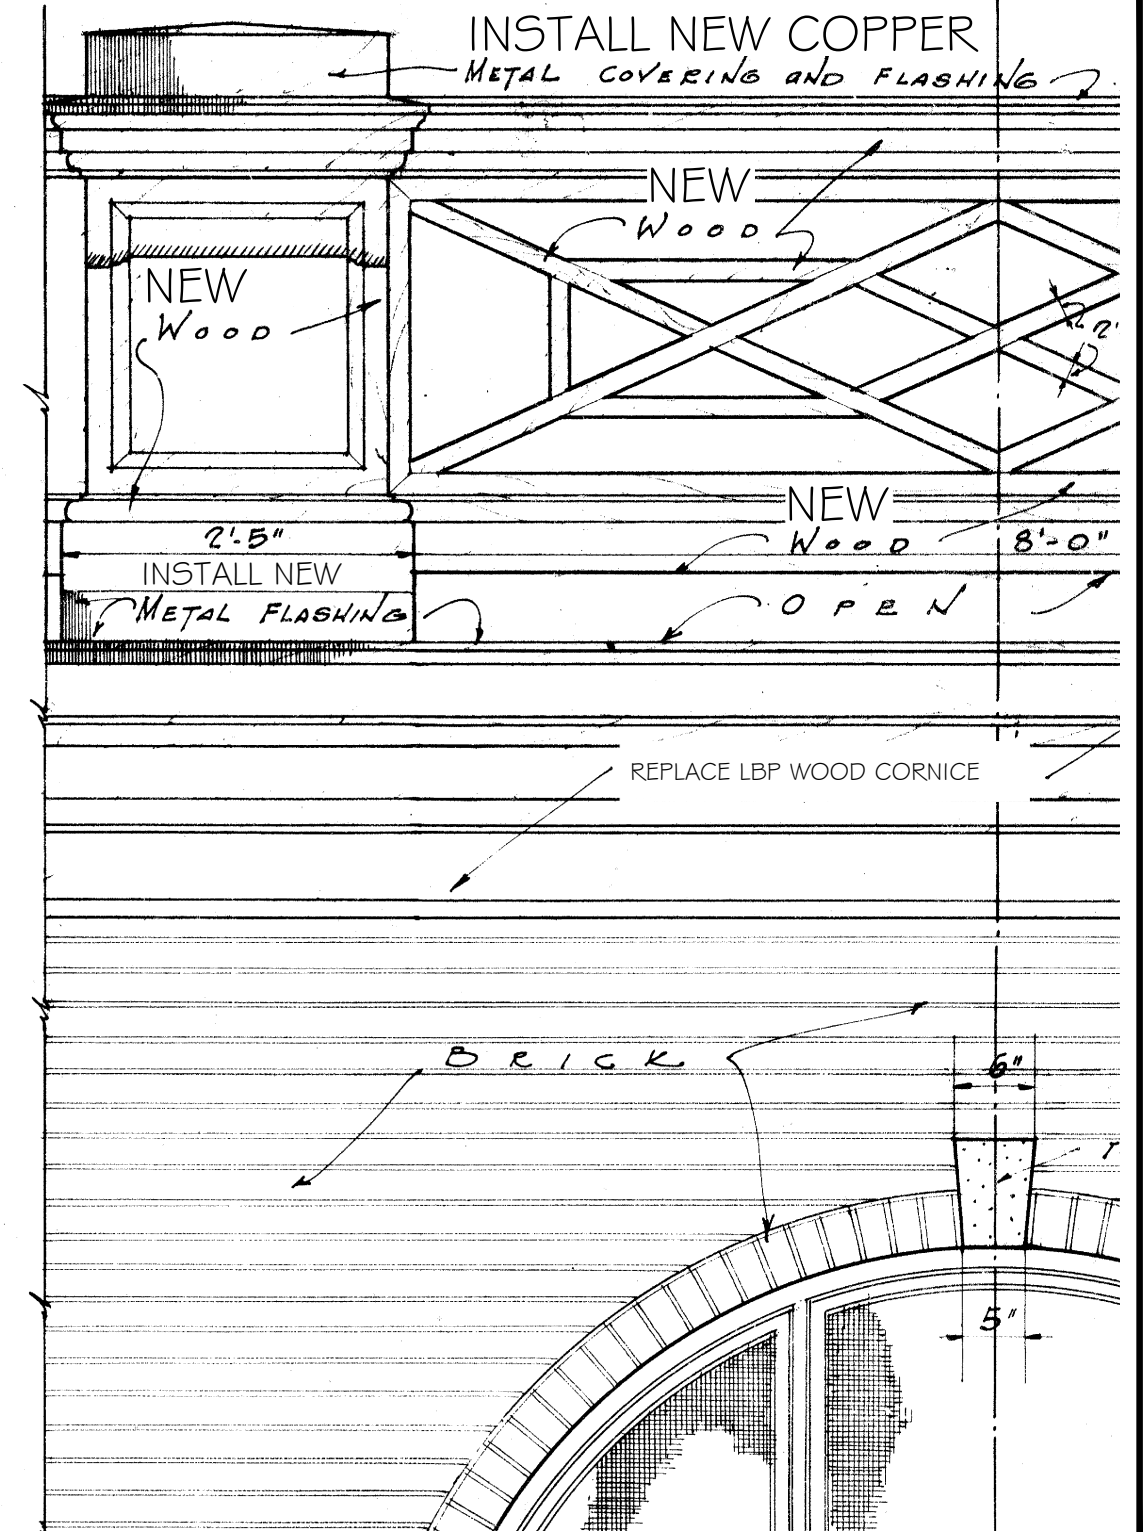

“A”

 

		Approved: Facility Manager	Project Title Replace Balustrades and Railings 1932 Era Buildings		Drawing Title OPPOSITE HAND SECTION "I -P"			Project Number 564-14-104		 Engineering Service  VETERANS HEALTH CARE SYSTEM OF THE OZARKS
								Building Number 01 (ONE)		
		Approved: Engineering Service Chief	One inch or not to scale! 		Scale: 3/4" = 1'-0"		Location Fayetteville, Arkansas		Drawing Number AE102	
Notes and/or Revisions:		Date					Checked WGG	Drawn JCH	Date 24-AUG-13	

CUSTOM VA FORM 08-6231B, MAY 2012