


Louis A. Johnson VA Medical Center Parking

locations for
Manual gate
* location for
automatic gates

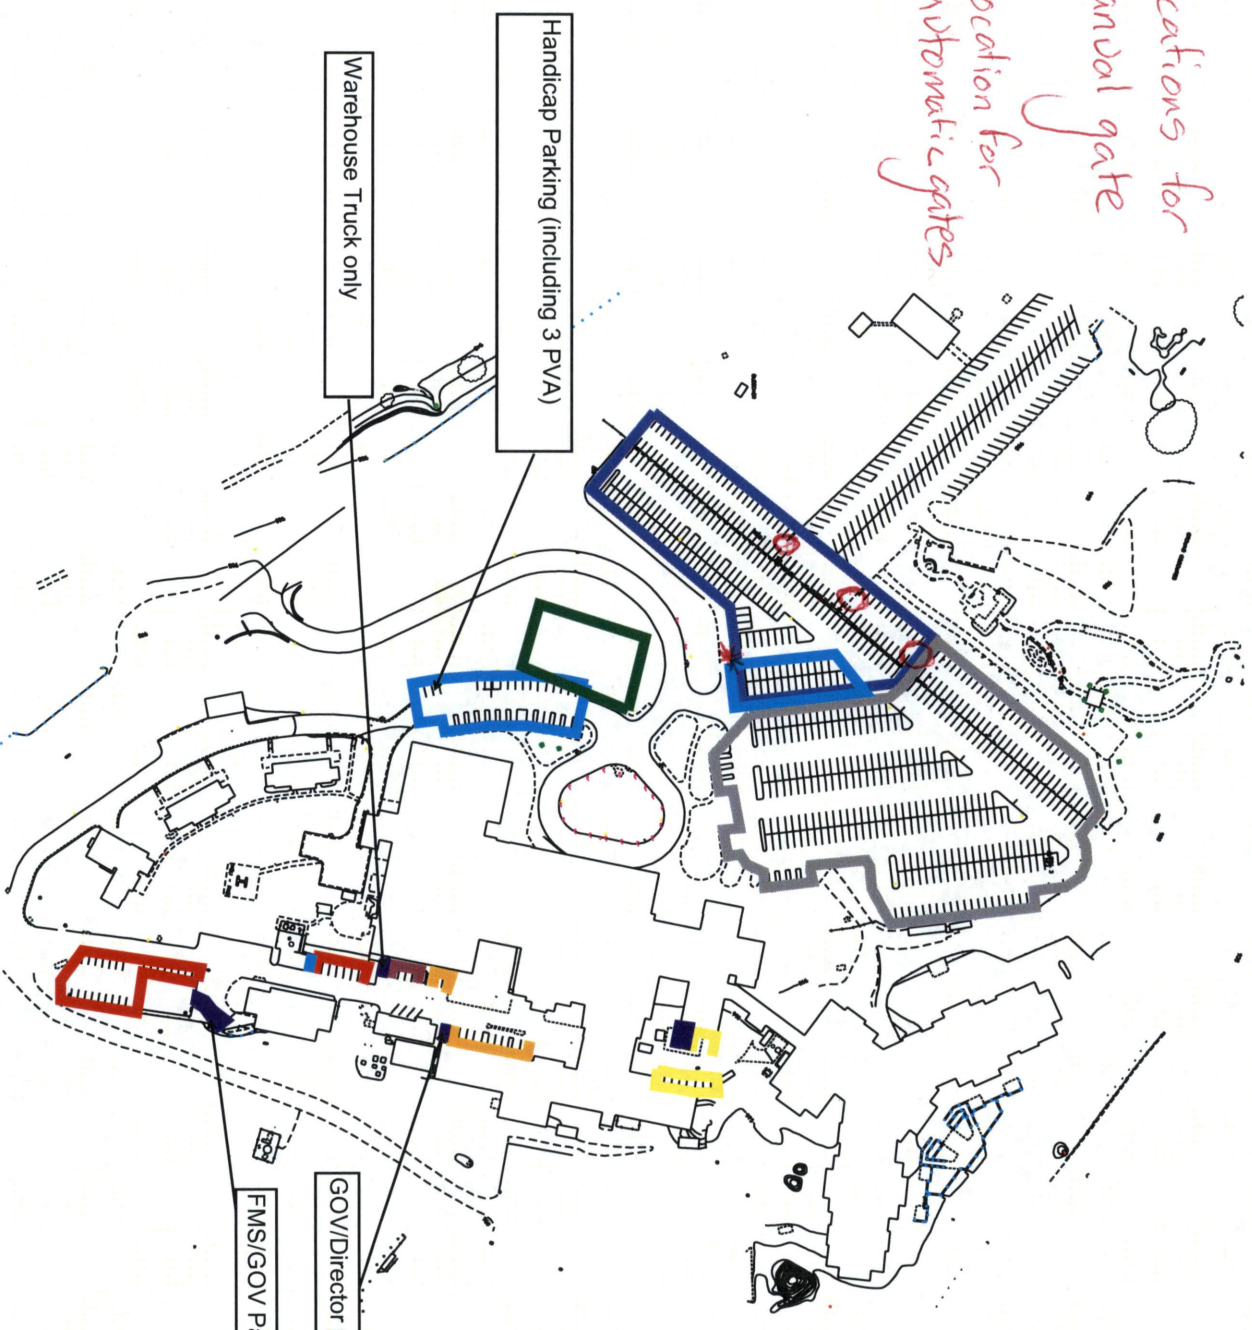

LEGEND	
Parking by Red permit only = 32	
Parking by Green permit only = 50	
Parking by Orange permit only = 11	
30 minute parking only = 5	
Handicap parking only = 38	
Valet parking or by Blue permit only between the hours of 2:00pm and 8:00am = 220	
GOV parking only = 7	
VTN parking only (Yellow) = 8	
Construction area	