SMITHGROUP JJR

SKETCH

CALL OUT OF TYP. WALL SECTION DRAWING TITLE	SKETCH A DRAWING NUMBER
1933 DESIGN DWGS. DRAWING REFERENCE	FORT SCOTT PROJECT NAME
NONE DRAWING SCALE	50407.024 1/22/14 PROJECT NUMBER DATE

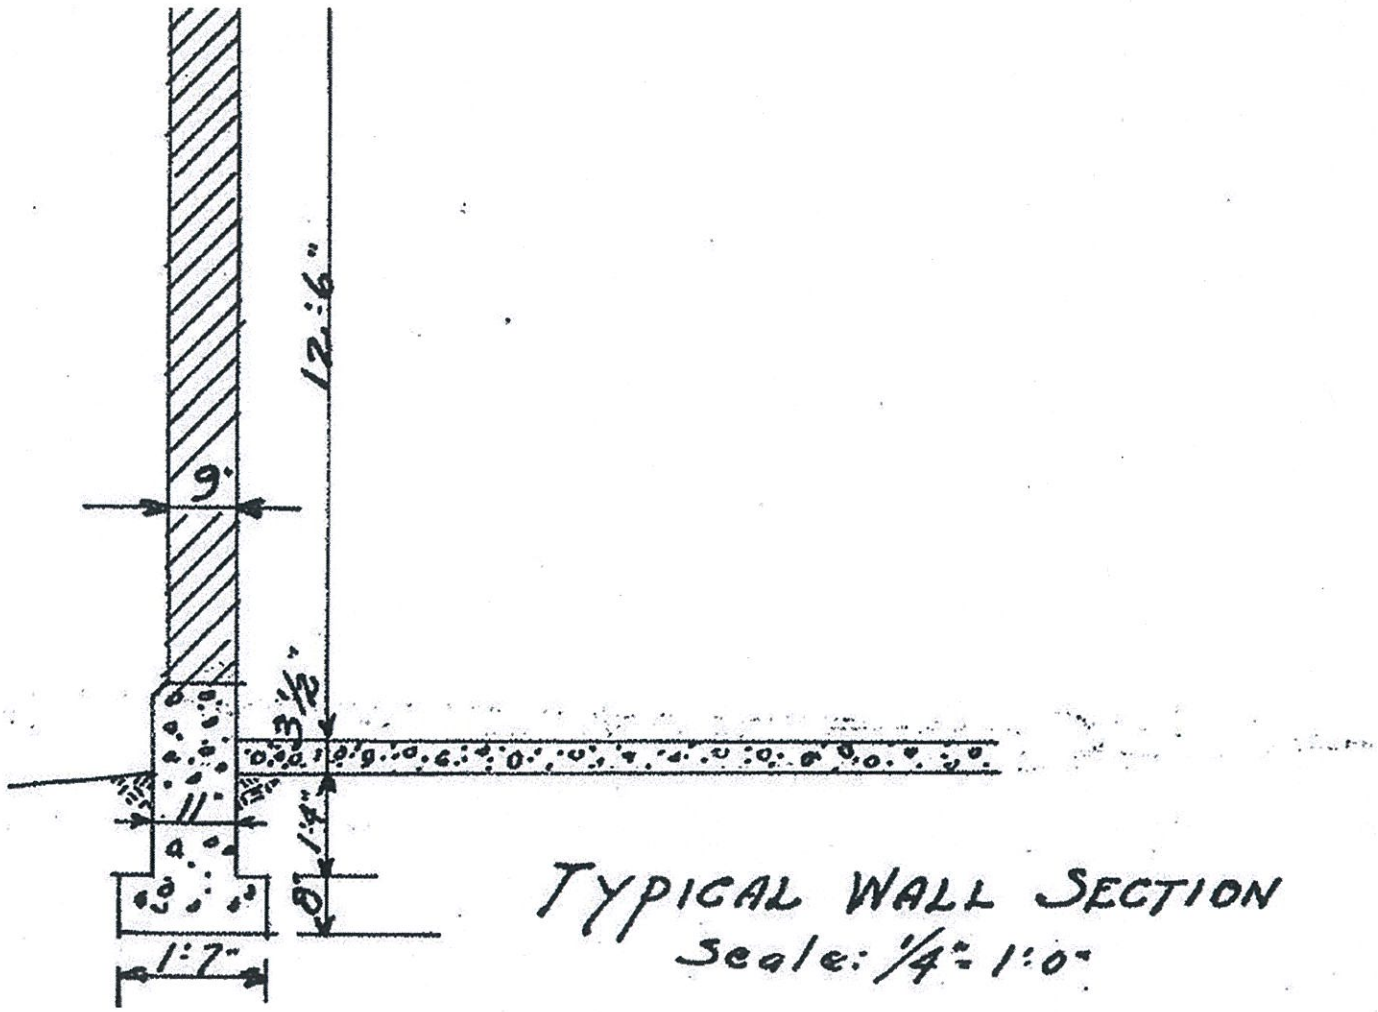

EXCERPT FROM EXISTING DESIGN DRAWINGS DATED OCT. 21, 1933.

SMITHGROUP JJR

SKETCH

FIRST FLOOR PLAN DRAWING TITLE	SKETCH B DRAWING NUMBER
1/A1.1 OF BID DOCUMENTS DRAWING REFERENCE	FORT SCOTT PROJECT NAME
NONE DRAWING SCALE	50407.024 1/22/14 PROJECT NUMBER DATE

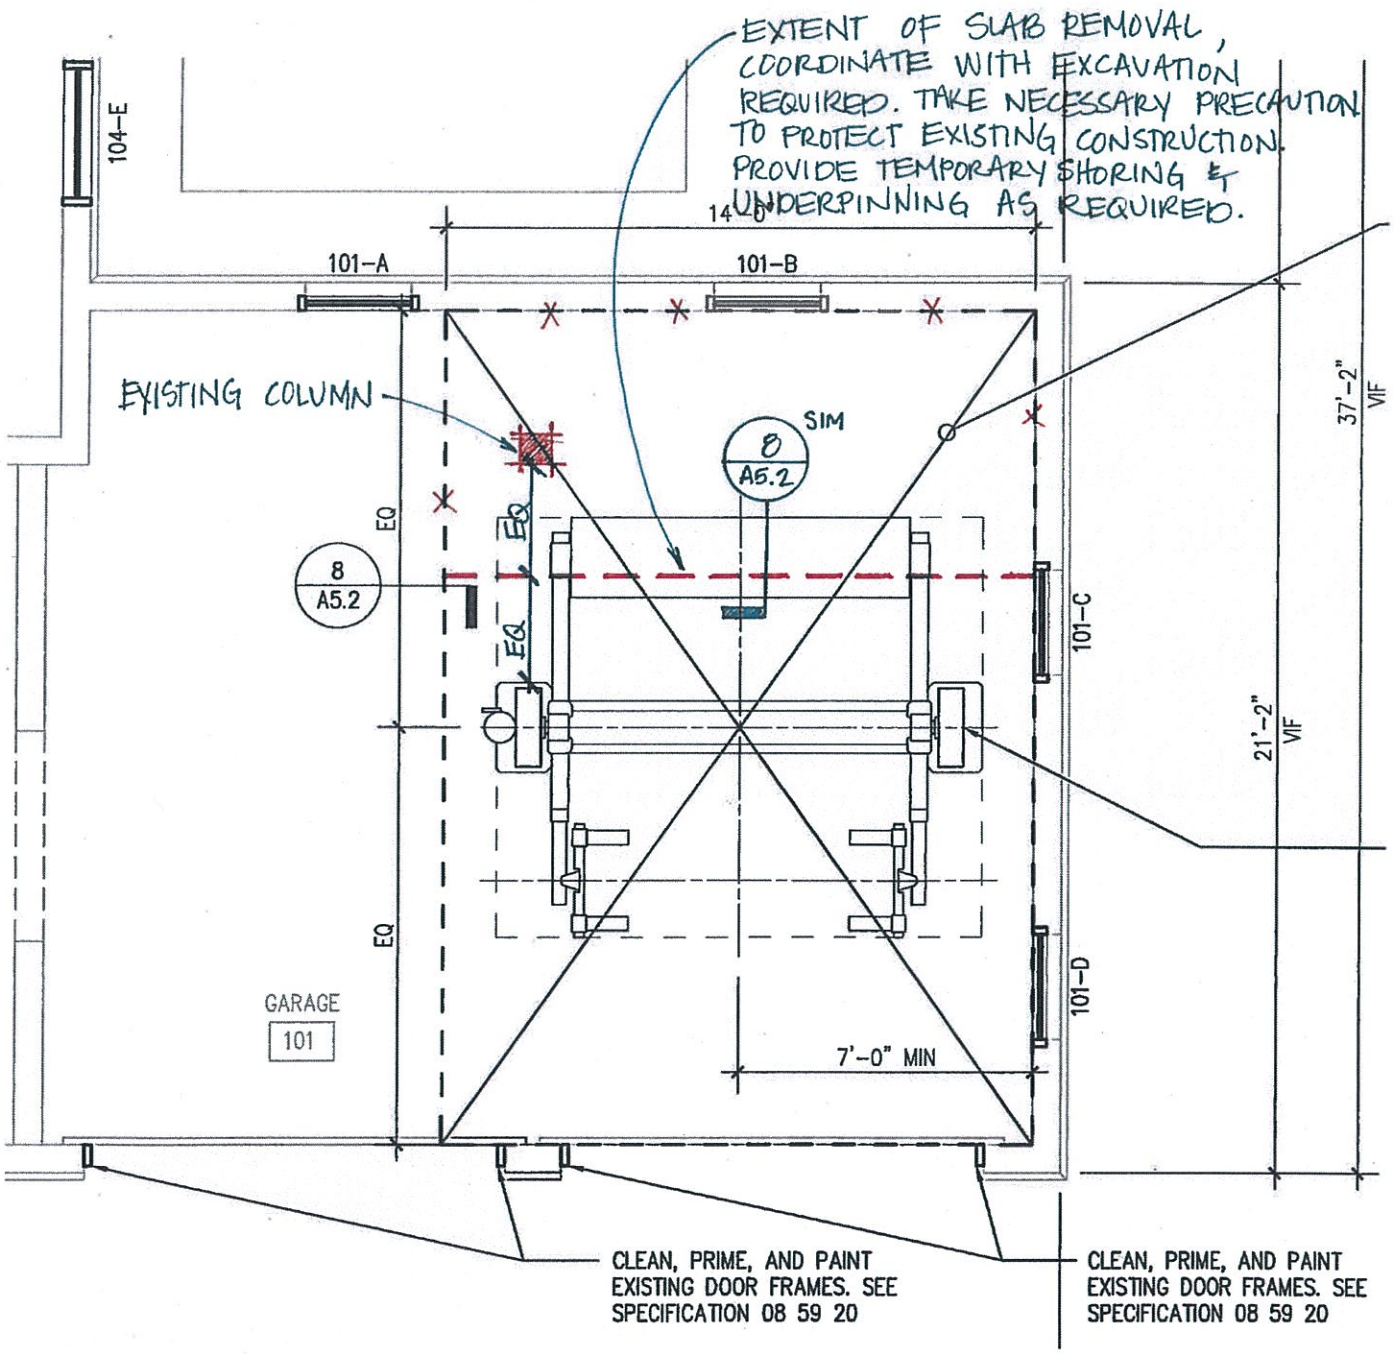

SMITHGROUP, INC. 500 GRISWOLD SUITE 1700 DETROIT MICHIGAN 48226 T 313.983.3600 F 313.983.3636