


three inches = one foot
one and one half inches = one foot
one inch = one foot
three quarters inch = one foot
one half inch = one foot
one quarter inch = one foot
one eighth inch = one foot

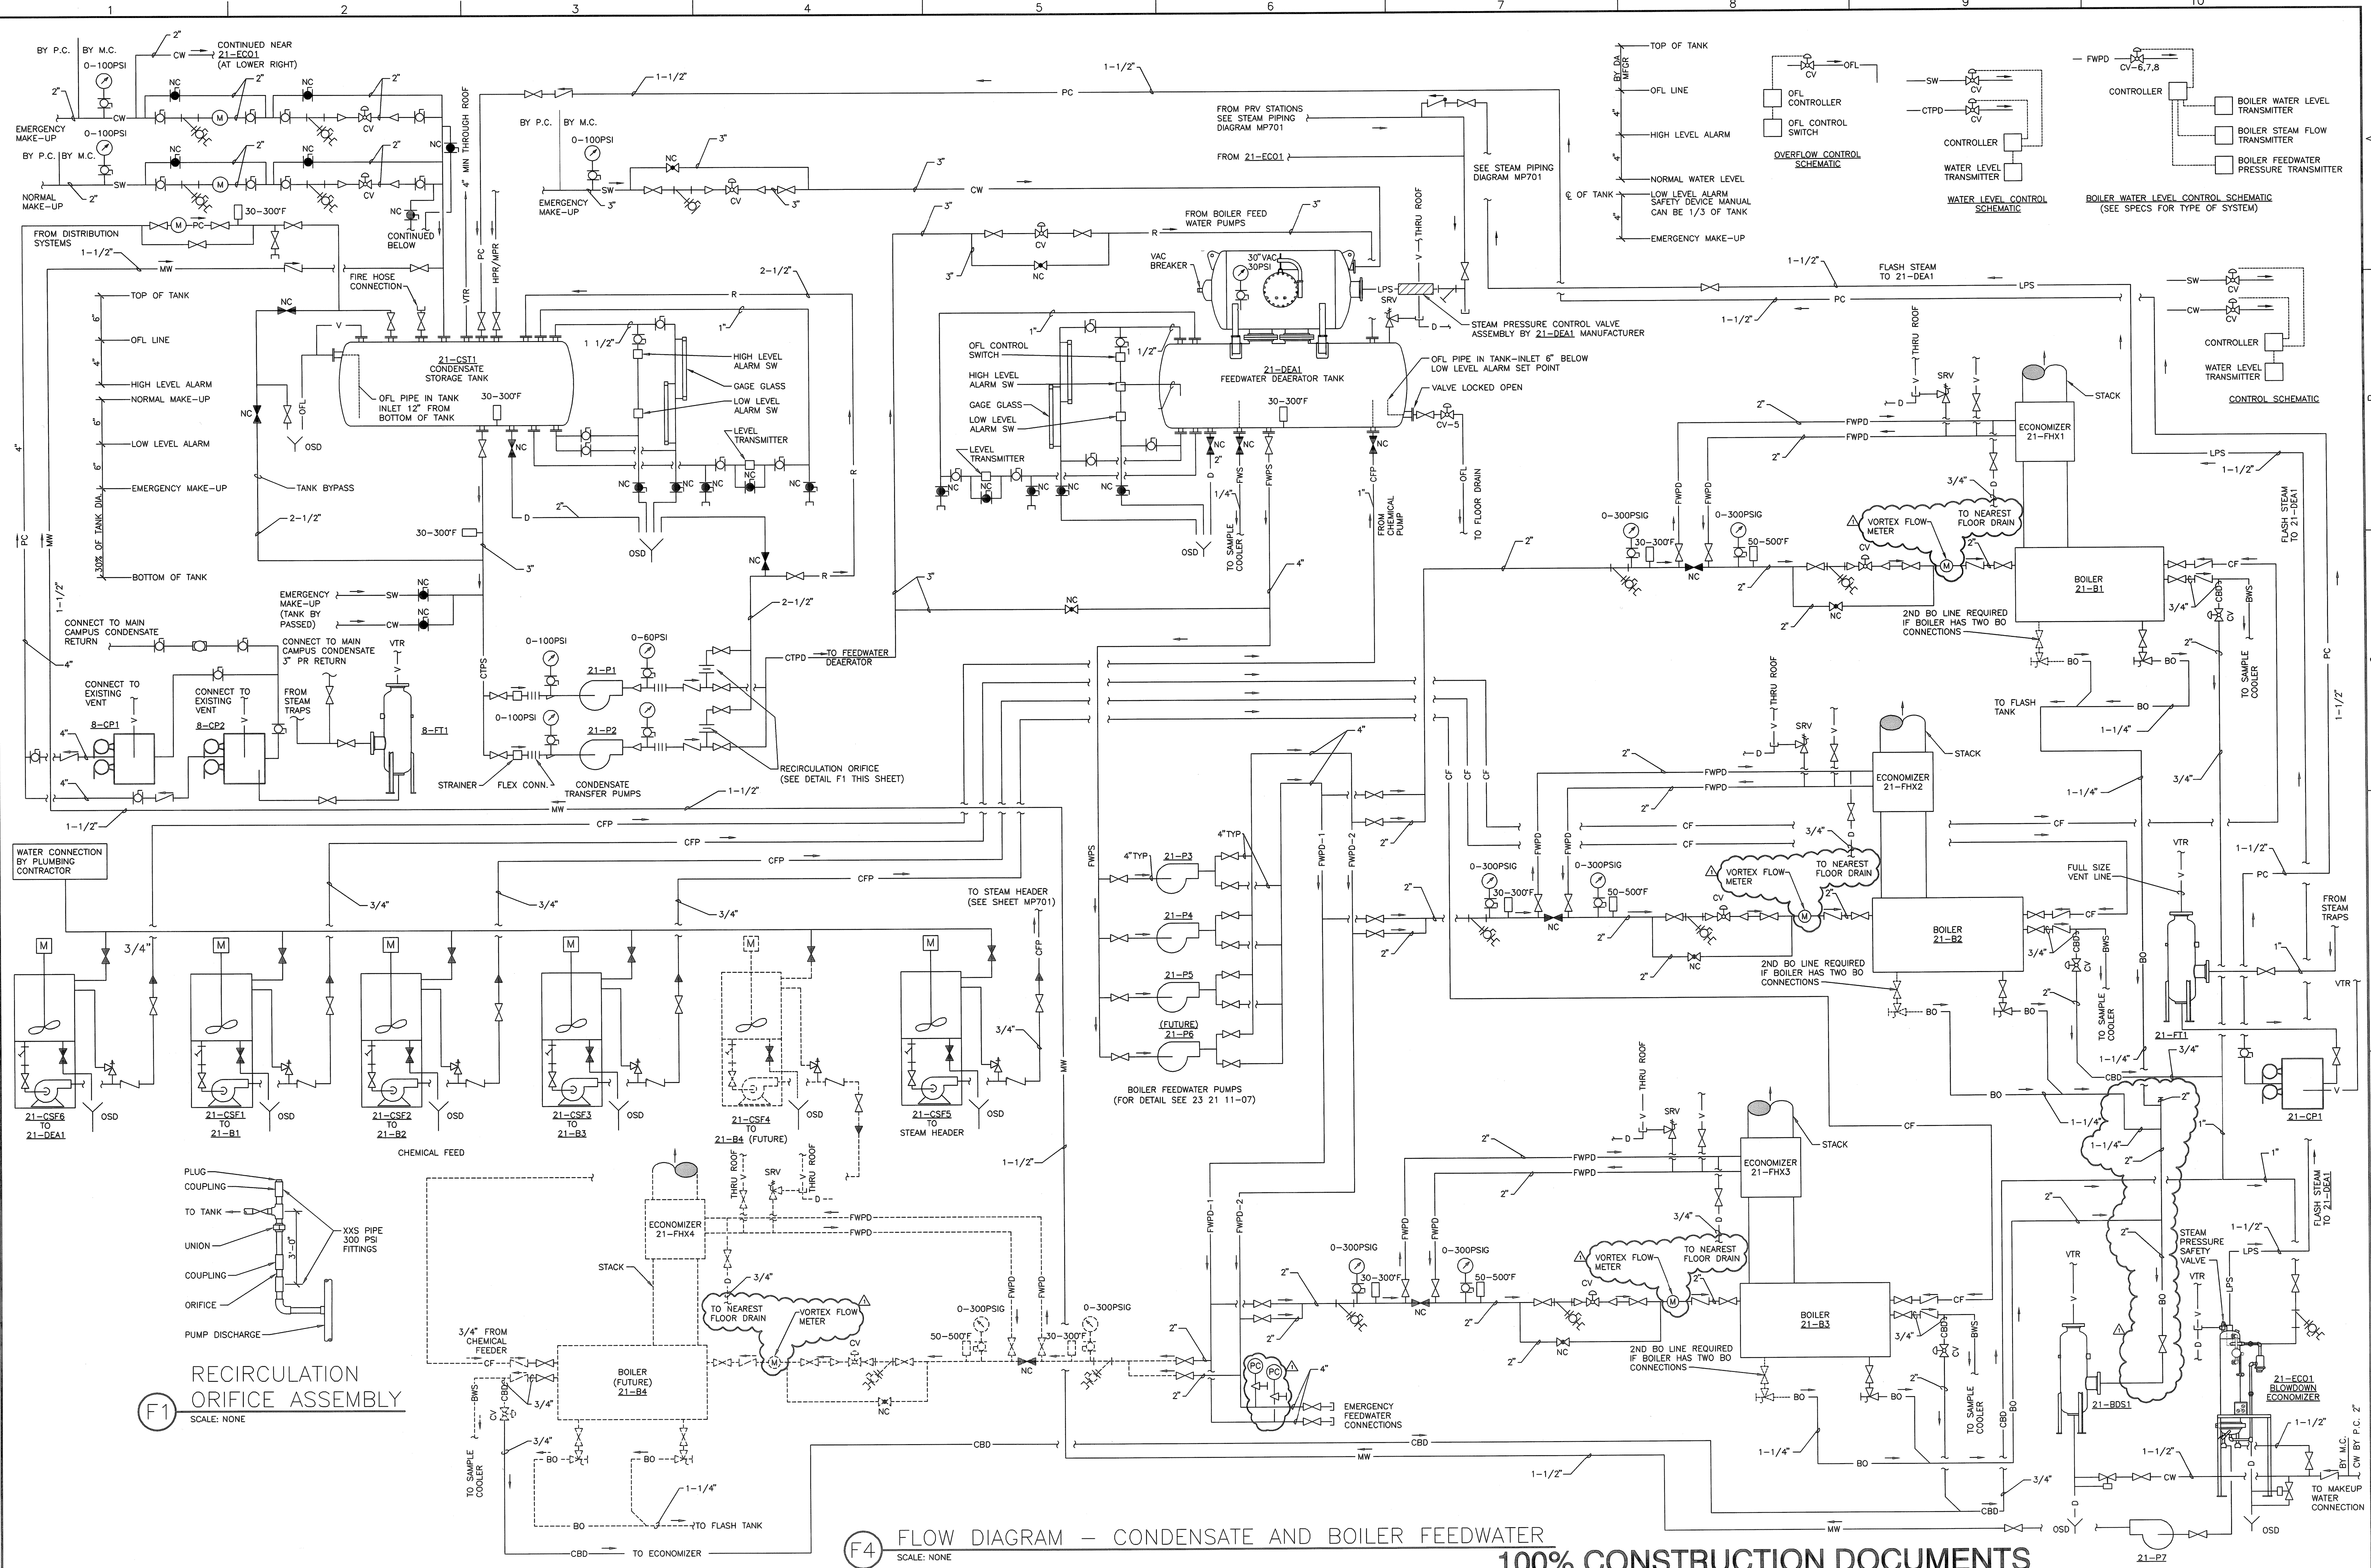

REVISION NO.	REVISION DESCRIPTION	DATE
1	SENSOR, NOTE AND PIPE REVISION	1/17/2014

Department of Veterans Affairs
William Jennings Bryan Dorn
VA Medical Center
6439 Garners Ferry Road
Columbia, SC 29209

Architect/Engineer Address
Harrell, Saltrick & Hopper
Design & Management Solutions for the Built Environment
8016 TOWER POINT DRIVE
CHARLOTTE, NC 28227
P 704.814.1320
F 704.321.0833
WWW.HSHPC.COM
COPYRIGHT © 2011 HARRELL, SALTRICK & HOPPER, PC
HSH PROJECT # 11015

Recommended Approvals:	
1. MEDICAL DIRECTOR	6. OPERATIONS SERVICE LINE MANAGER
2. ASSOCIATE DIRECTOR	7. INFECTION CONTROL MANAGER
3. CHIEF OF STAFF	8. SAFETY MANAGER
4. ASSOC. DIRECTOR	9. GENERAL ENGINEER
5. SERVICE LINE MGRS.	10. COTR

Drawing Title	
MECHANICAL BOILER FEED DIAGRAMS	
BUILDING IS FULLY SPRINKLERED	

Project Title	
REPLACE BOILER PLANT/ COGEN/CHP	
Drawn	Building Number 21
Checked	Reviewed
AutoCAD File Name	
Const. Contract No.	

Date	Project Number	Drawing No.
APRIL 30, 2012	544-11-101	MP702

Veterans Affairs