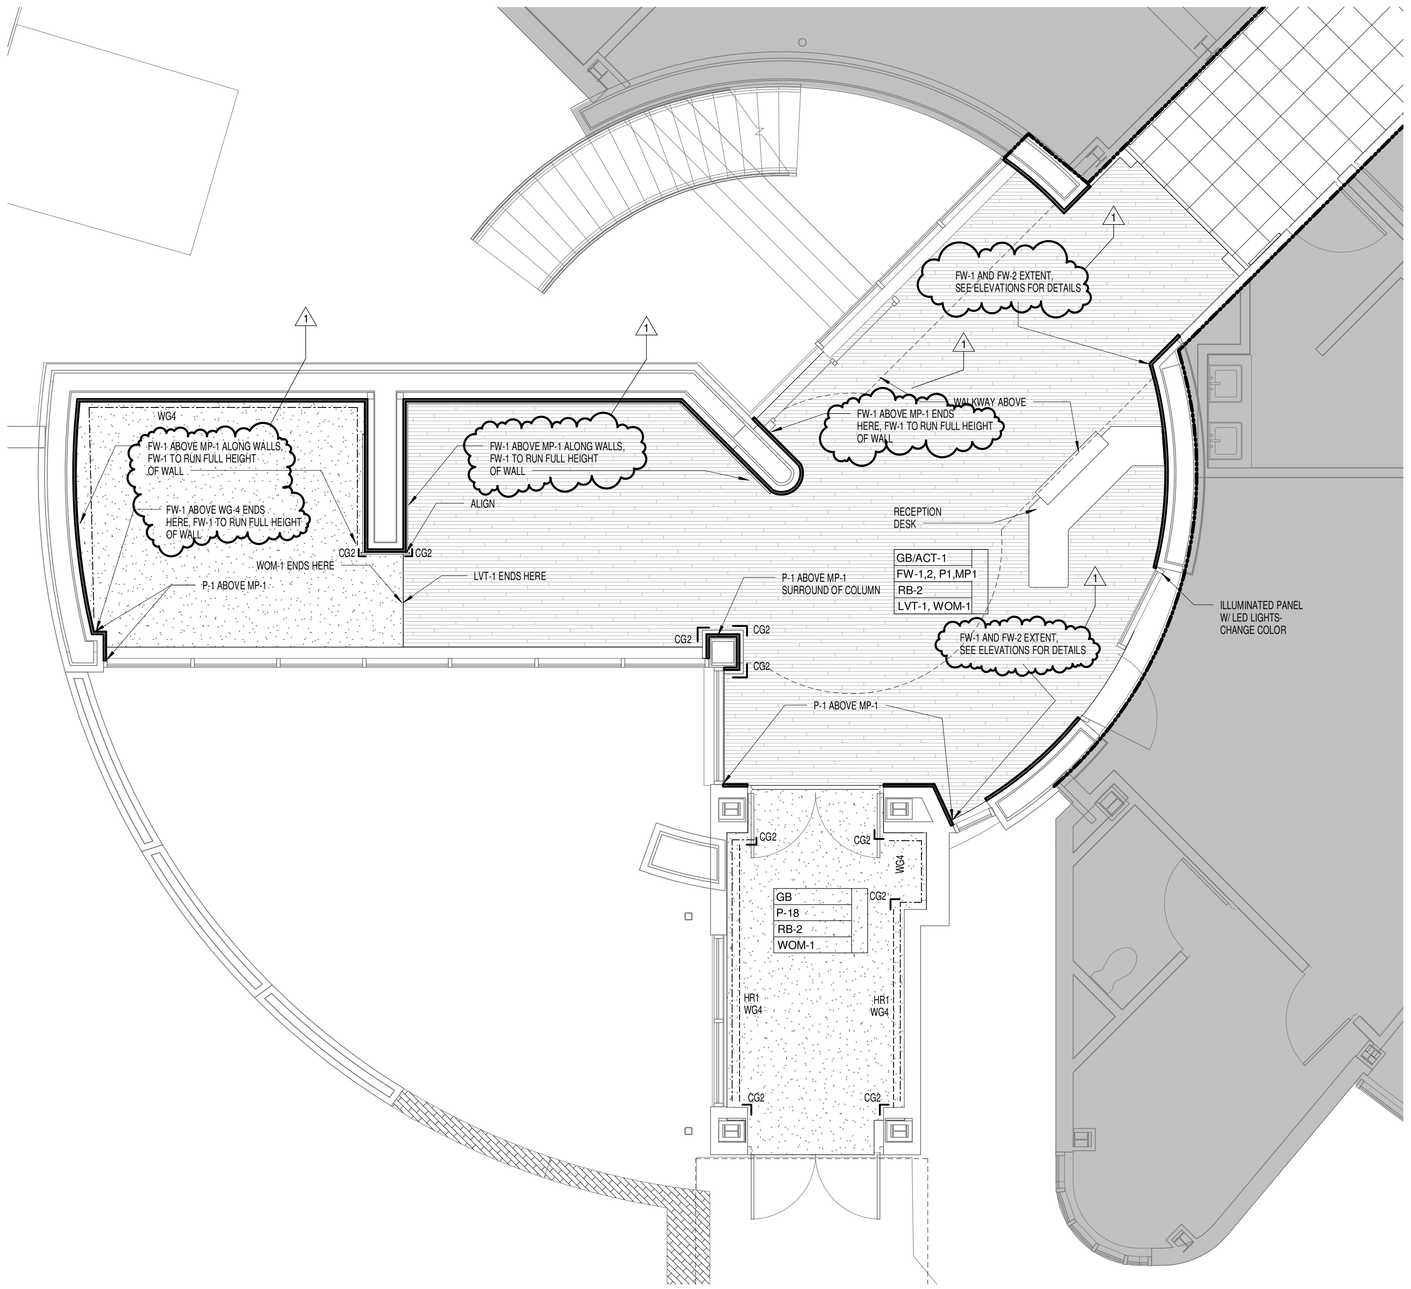

1 Enlarged Entry Finish Plan - First Floor
1/4" = 1'-0"

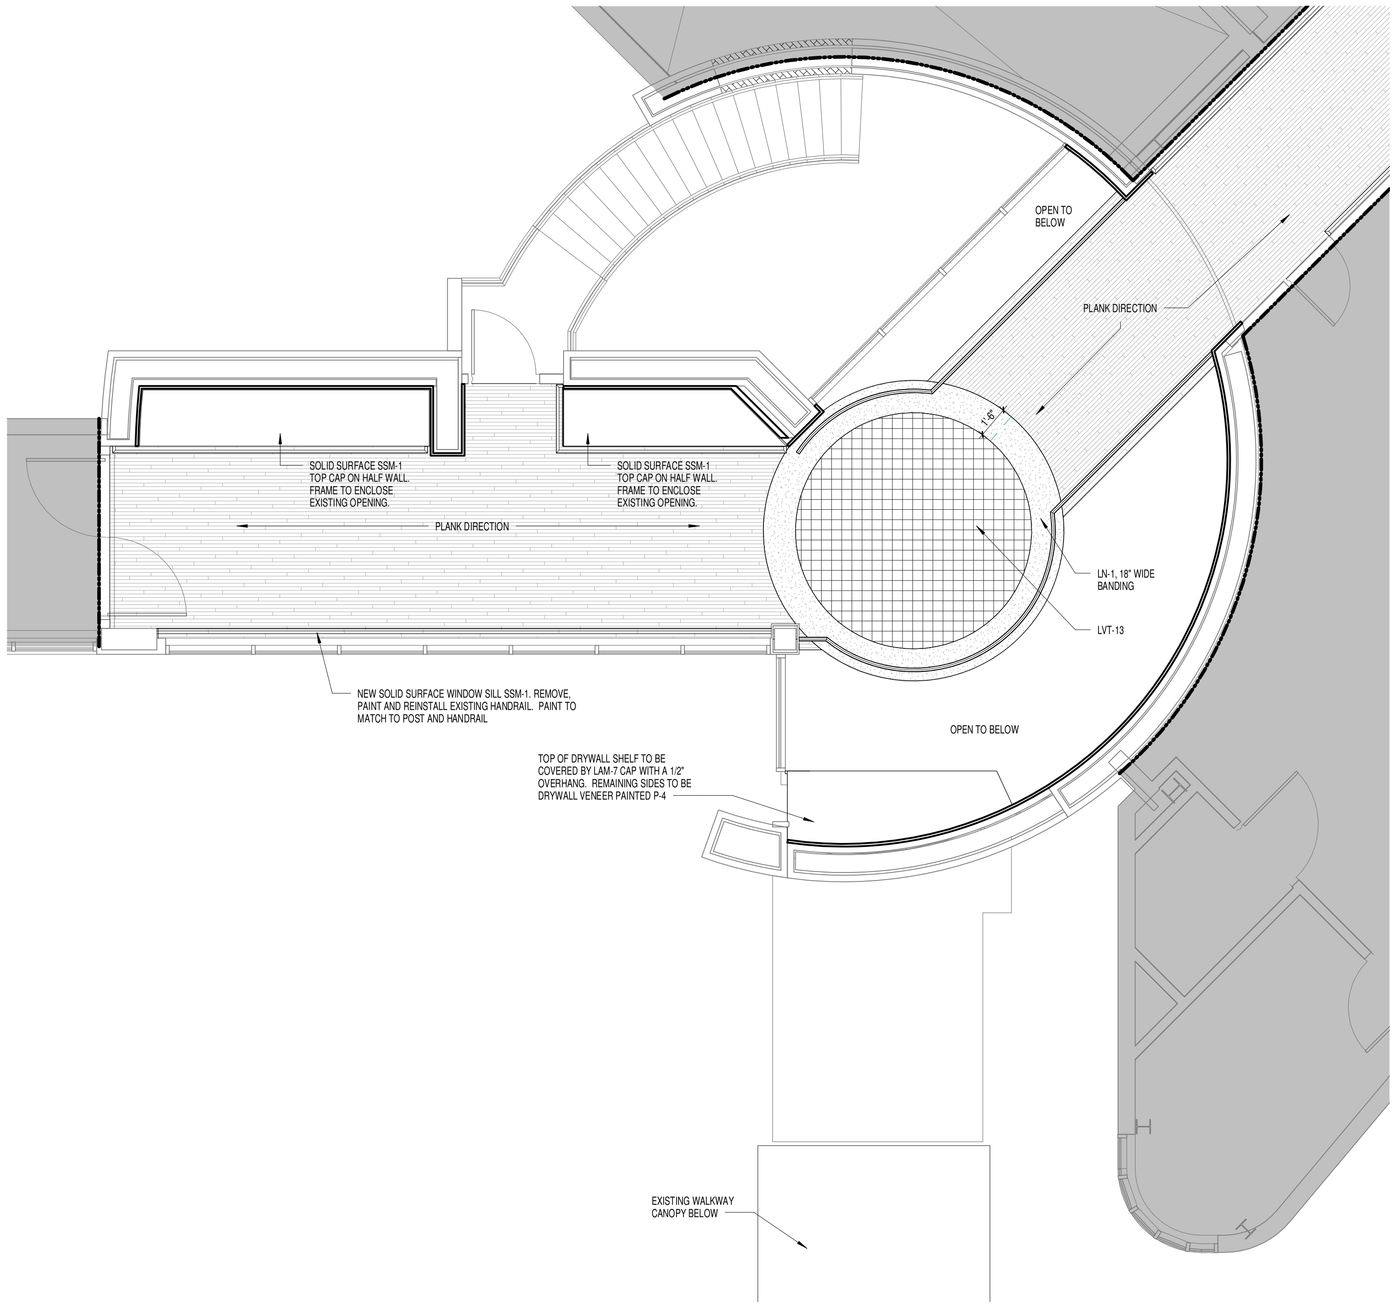

2 Enlarged Entry Finish Plan - Second Floor
1/4" = 1'-0"

This document is the property of RPA Design and RPA Design retains all rights therein, including copyrights.
It may only be used in a manner consistent with RPA Design's rights while RPA Design is providing services for the specific project identified or referred to herein or extensions thereto.
It may not be used for any other purpose except with the express written agreement of, and compensation to, RPA Design.

C:\Users\annie.barfield\Documents\09-0905-05_VAMC Salisbury_Phase III_Rain_C14_annie.barfield.rvt

2/3/2014 4:01:53 PM

Department of Veterans Affairs

Architect of Record

rpadesign
5960 Fairview Road
Suite 500
Charlotte, NC 28210

704
887.3500
887.3507 fax

Consultants

MECHANICAL/ELECTRICAL/PLUMBING/FIRE PROTECTION:
AME Consulting Engineers, PC
421 Penman Street, Suite 200
Charlotte, NC 28203
704.295.4263 PHONE
704.295.7543 FAX

STRUCTURAL:
ZAPATA, Inc.
6302 Fairview Rd., Ste. 600
Charlotte, NC 28210
704.378.4923 PHONE
704.358.8342 FAX

CIVIL:
COLEJENEST & STONE, P.A.
200 South Tryon Street, Suite 1400
Charlotte, North Carolina 28202
704.376.1555 PHONE
704.376.7851 FAX

Project

VAMC Salisbury Building 42 Additions & Renovation - Phase III

City, State
Salisbury, NC

VA Project Number
659-335

Issued For
Construction

Item	Date	Description
1	01/31/14	Amendment A00003

Drawn By SLS/SP/BR/FF/ES/AB
Checked By FF

Seal / Signature

Sheet Title
Enlarged Entry Finish Plans

Date December 21, 2012

Sheet Number
IF104