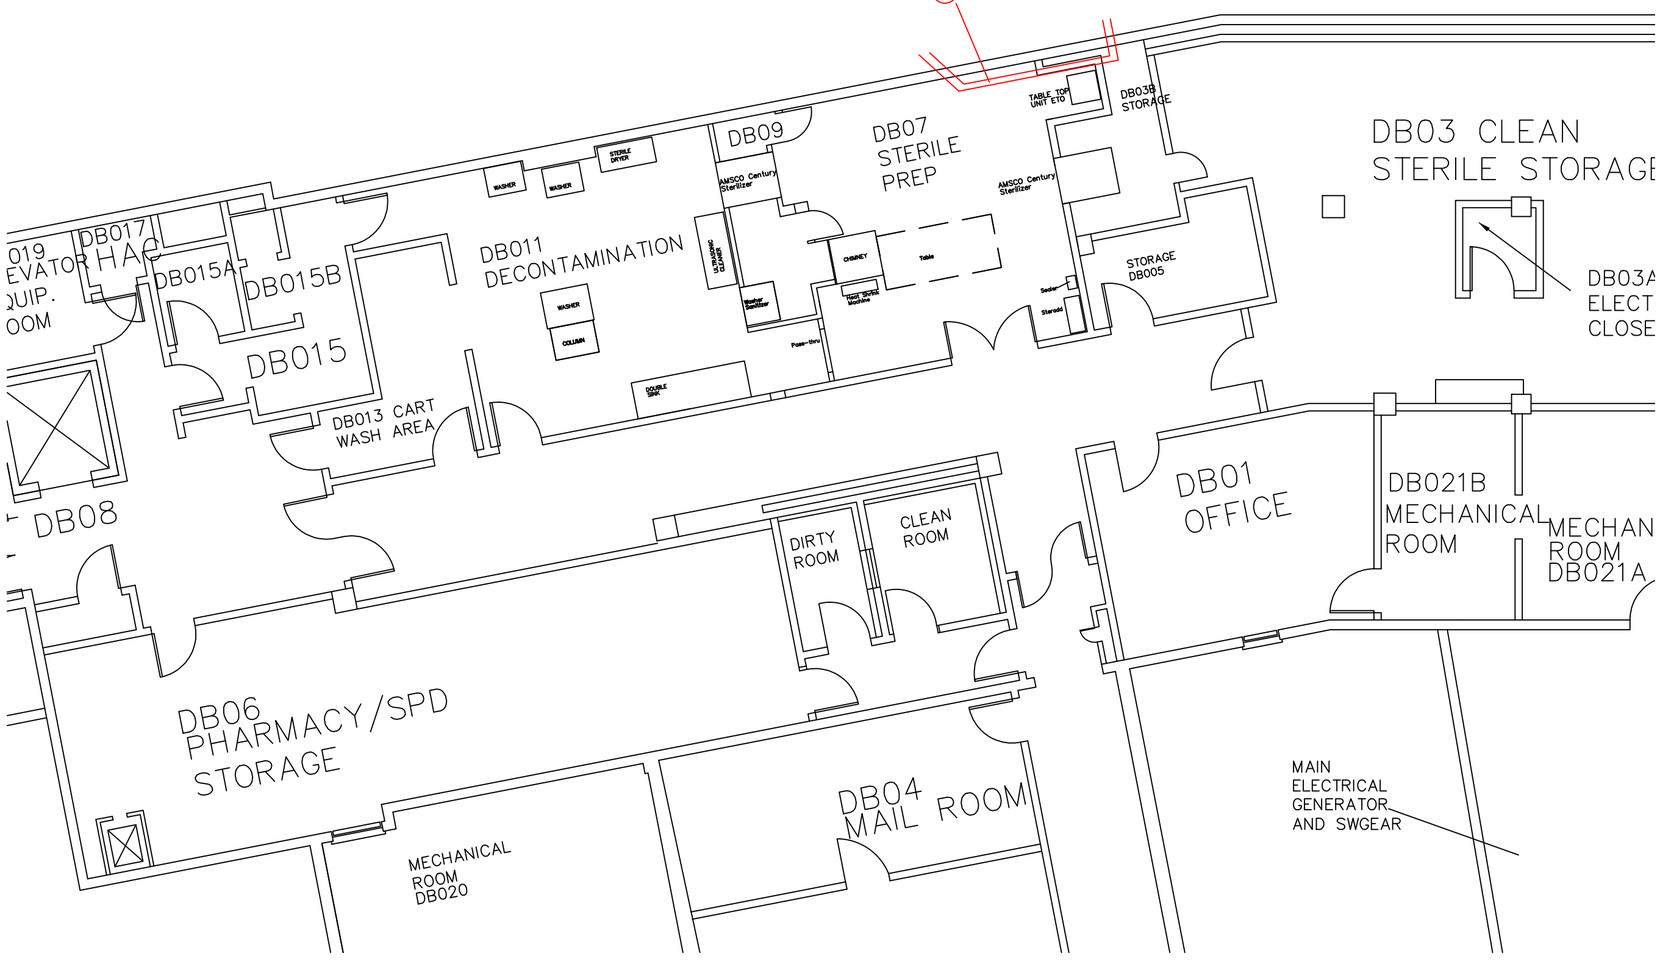1 REMOVE AND CAP EXISTING PIPES.
1/8" = 1'