








WATKINS

P-1
Catching
Bait


P.2 vacuum
R24

P.3 TEMPERED
STEEL.

p.4 BAYPOOD

P.S. OSWEGO
TH

1. THE PAINT TO
BE EMULSIFIED.
FINISH UNLESS
OTHERWISE
NOTED.

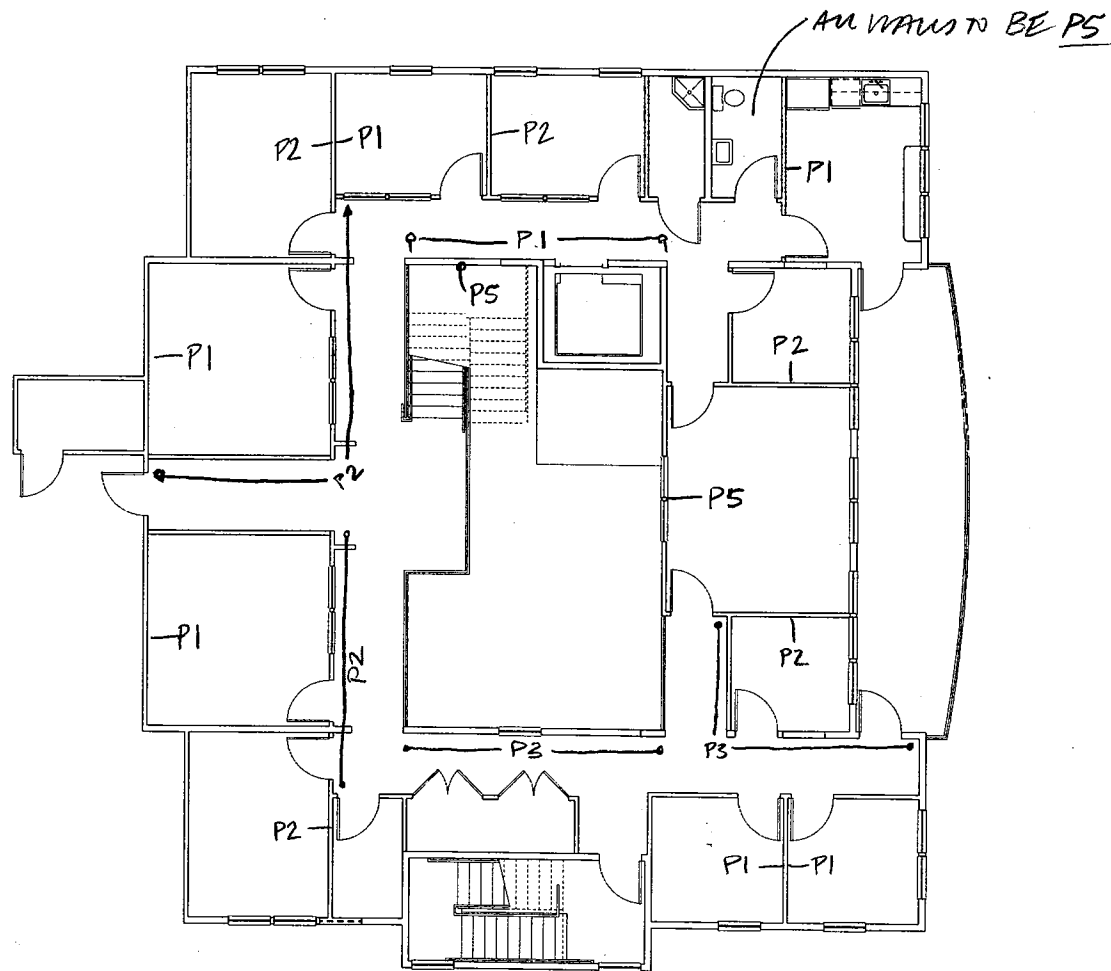

SECOND FLOOR PLAN

A New Facility For:
Parker Development
 1114 Georgiana St., Port Angeles, Washington

DATE: 04-10-13
 REVISED:
 COMM. NO.

316 South Peabody Street
 Port Angeles, Wa., 98282
 (206) 462-0110

LINDBERG
 ARCHITECTS

CHECK
 PRICEVA
 A2.1