



**PARKING LOT RESTRIPING**

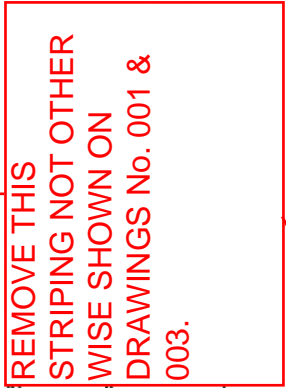

PROVIDED BY: JE  
DATED: 2/7/2014

ADDENDUM TO DRAWINGS No.004 & 006

PARKING LOT RESTRIPING

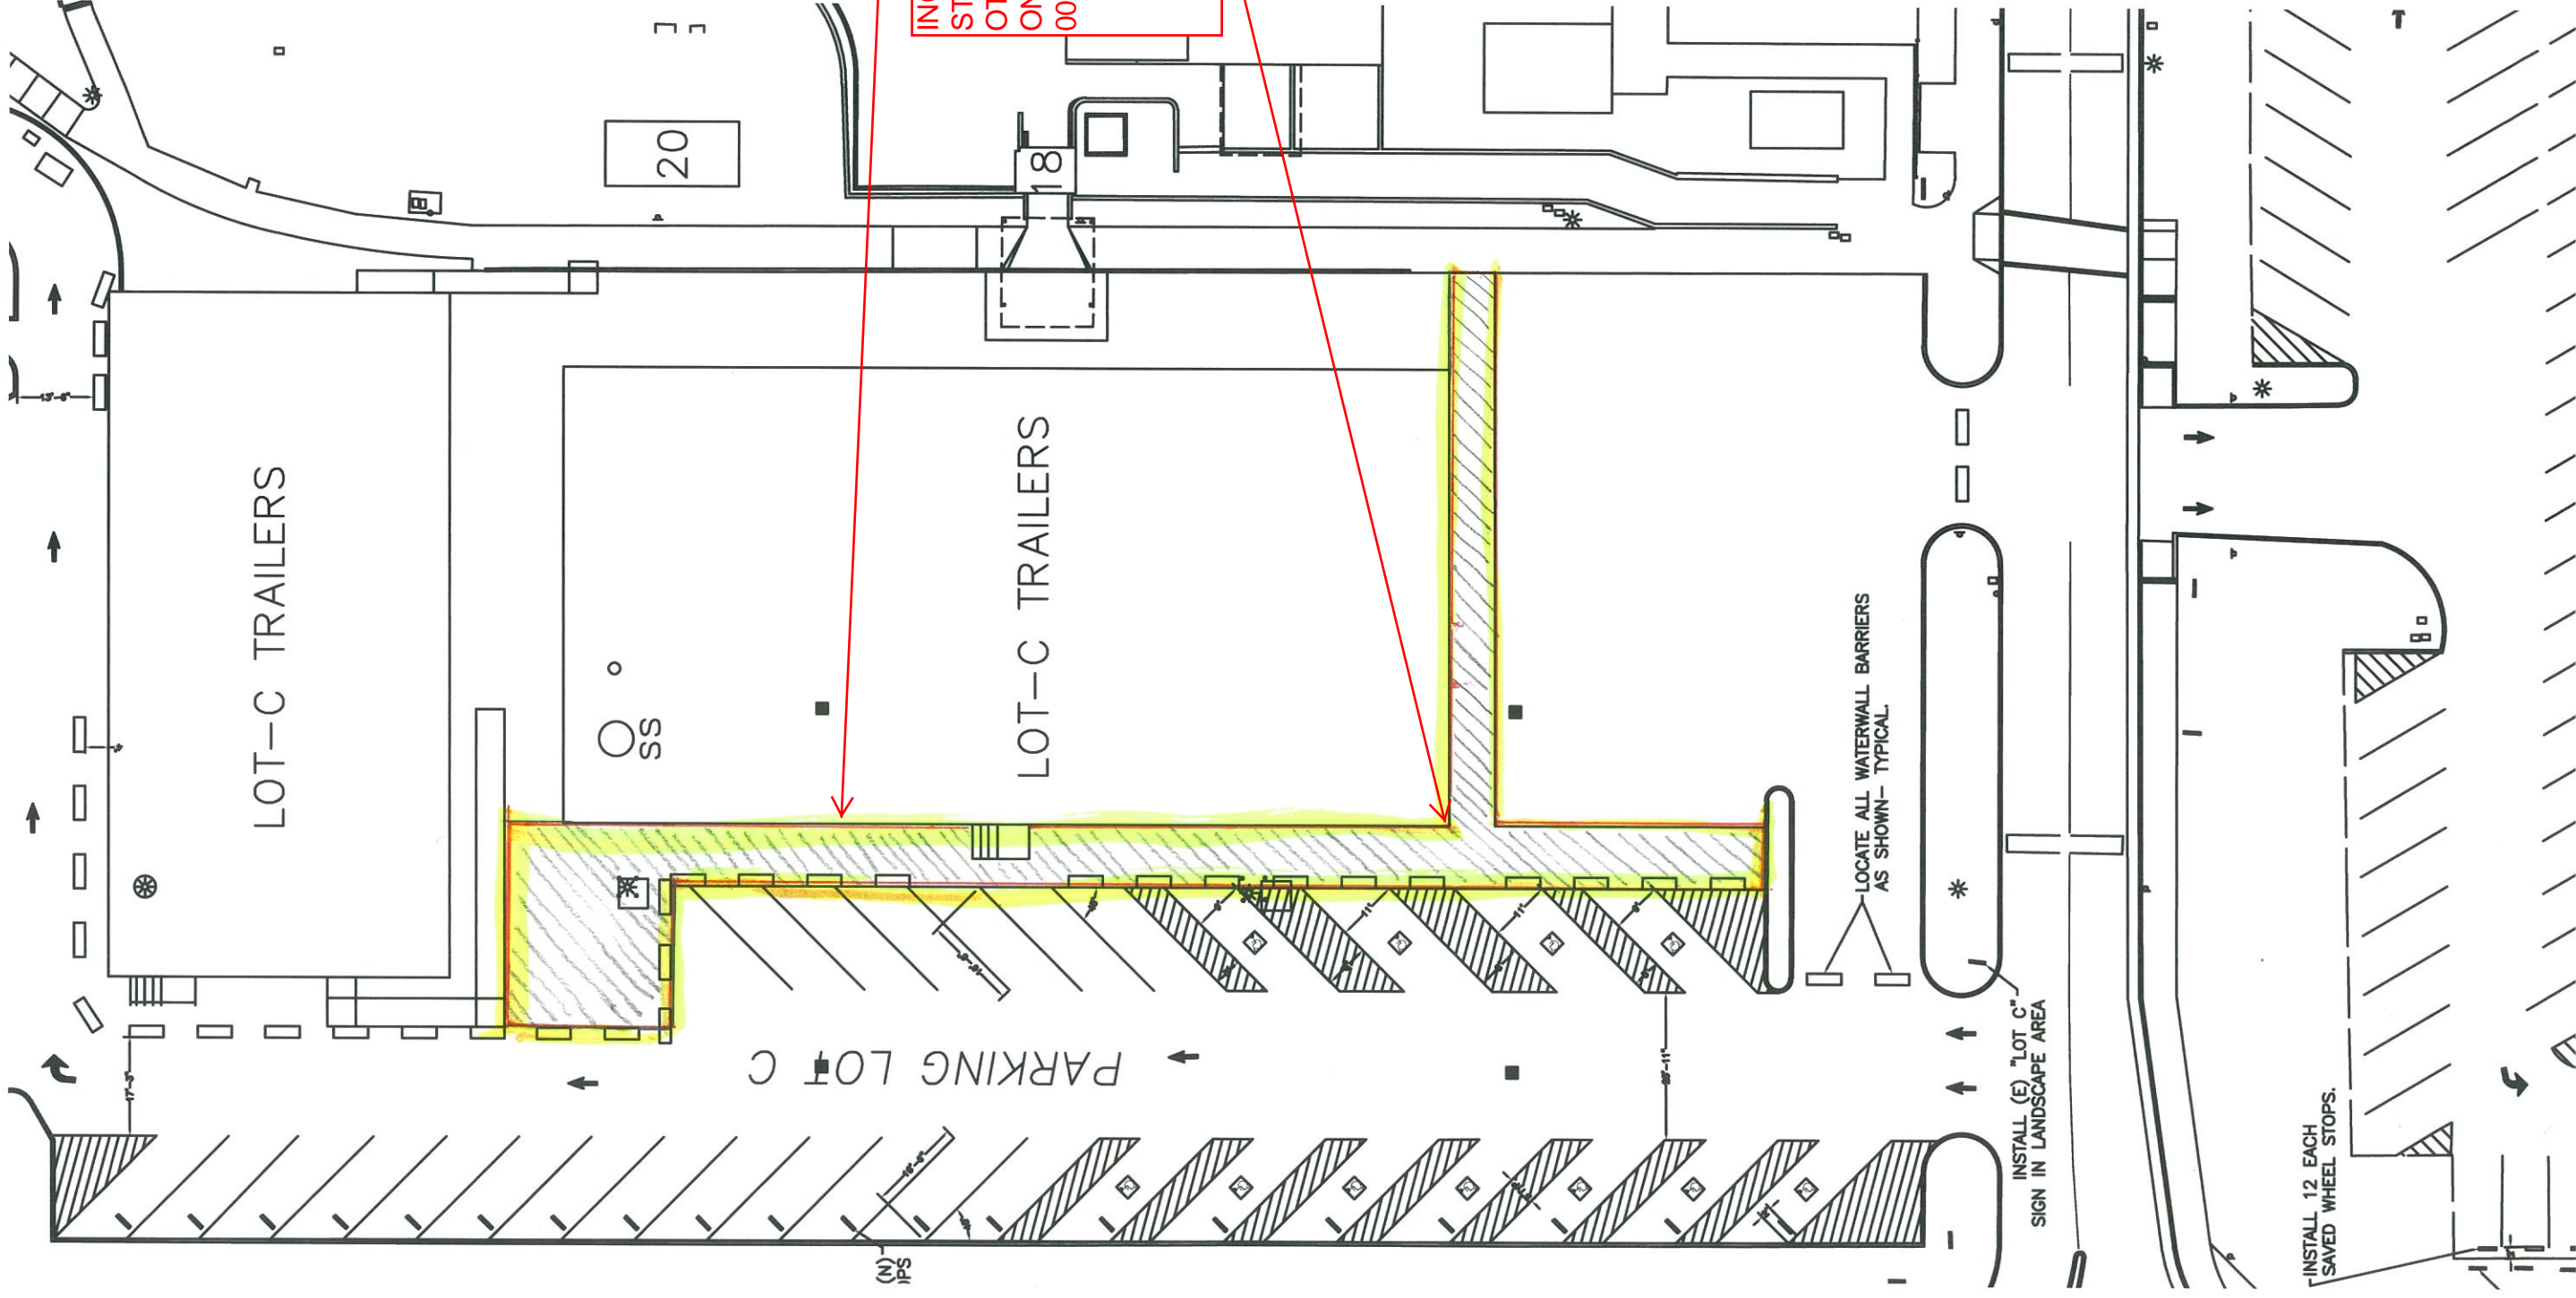

PROVIDED BY: JE  
DATED: 2/7/2014