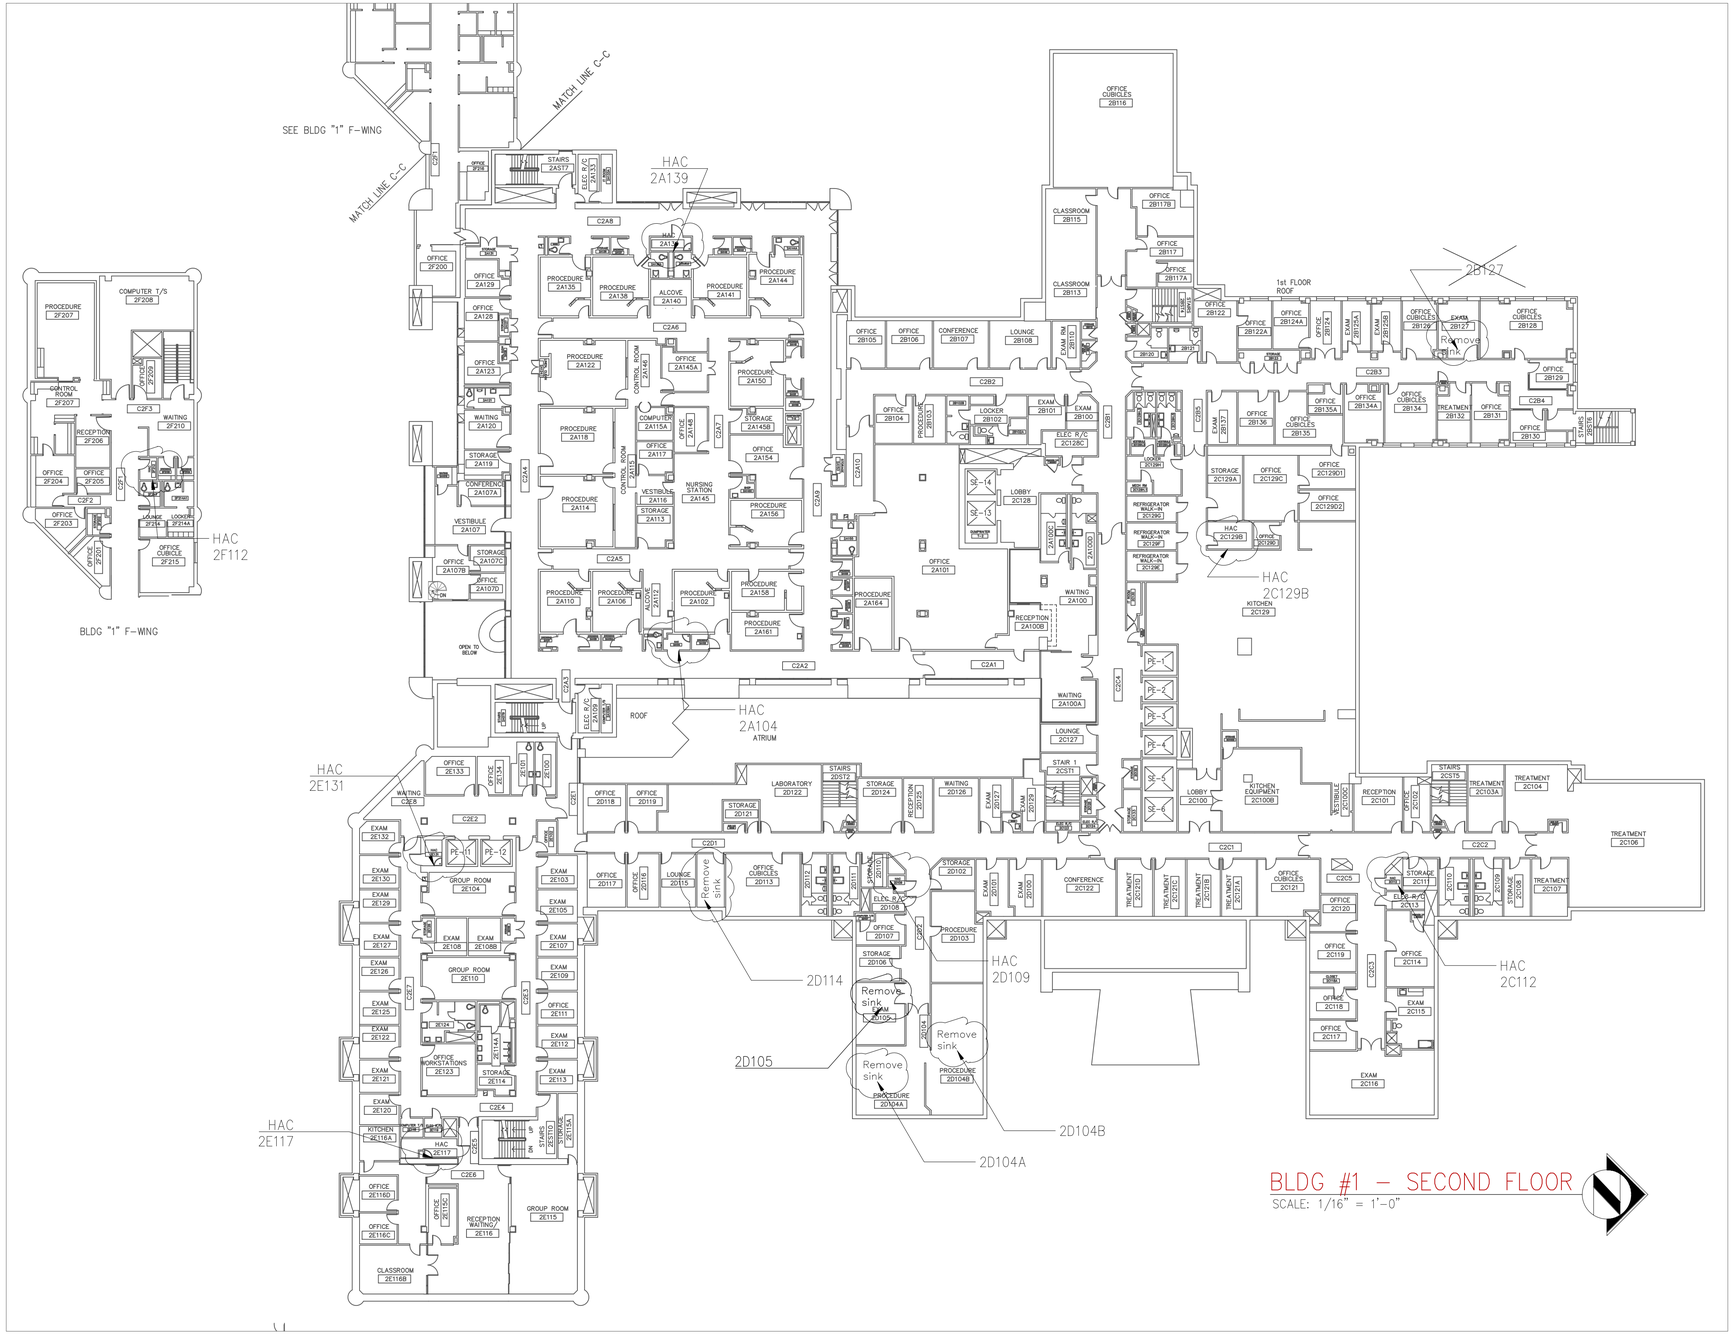

FULLY SPRINKLERED

CONTRACTOR SHALL INSTALL NEW FAUCETS WITH CHECK VALVES IN ALL HOUSEKEEPING AID CLOSETS (HAC'S), TO ENSURE NO COLD WATER BACK FEED INTO THE CHEMICAL INJECTION SYSTEM. WORK MAY REQUIRE MINOR DEMOLITION AND REPAIR TO ACCESS VALVES IN WALLS/CEILINGS.

HAC'S Room #
2A104
2A139
2C112
2C129B
2D109
2E117
2E131
2F212

REMOVE UNUSED/UNDERUSED SINKS, SHOWERS AND TOILETS IN LOCATIONS NOTED ON PLANS. PIPING WILL NEED TO BE CUT BACK AND CAPPED AT MAIN AND ALL "DEAD LEG" PIPING REMOVED.

Sink Removal Room #	
~~2B127~~	** Deleted from Project
2D104A	
2D104B	
2D114	
2D105	Add to Project – remove sink

Survey Updates	10/18/13

PLOTTING NOTES:
1. FULL SIZE V.A. "E" SHEET (AS INDICATED)
2. HALF SIZE V.A. "D" SHEET (1/2 THE INDICATED SCALE)
3. LETTER SIZE: (NOT SCALE)

GENERAL NOTES:
1. SCALED DIMENSIONS + ARCHITECTURAL FEATURES MAY NOT BE CORRECT.
2. CONTRACTORS + A/E's ARE RESPONSIBLE TO FIELD VERIFY ALL DIMENSIONS WITHIN THE PROJECT AREA.

DEPARTMENT OF VETERANS AFFAIRS
MEDICAL CENTER
1055 Clermont Street
Denver, Colorado, 80220

Drawing Title: SECOND FLOOR HOUSEKEEPING AID CLOSETS LOC	Project Title: Correct Hot Water System Deficiencies Phase 1	Project Number: 554-14-804	Office of Construction and Facilities Management
Approved Project Director	Location: DENVER VA MEDICAL CENTER	Building Number: BUILDING 1	
	Date: 27 DEC, 2012 / Checked: T. VIGIL / Drawn: D. ZETHREN	Drawing Number: A103 Rev	
		Dwg. 4 of 26	Department of Veterans Affairs

VA FORM 08-6231

SA ENG All Stores\Projects\554-14-804 Correct Hot Water System Deficiencies Ph 1\554-14-804 (new)\Design\DRAWINGS\dwgs\Autocad\04Rev A103 Bldg 1 – 2nd Floor w HACs.dwg 1-23-14 02:37:43 PM VHAECHKoyesM