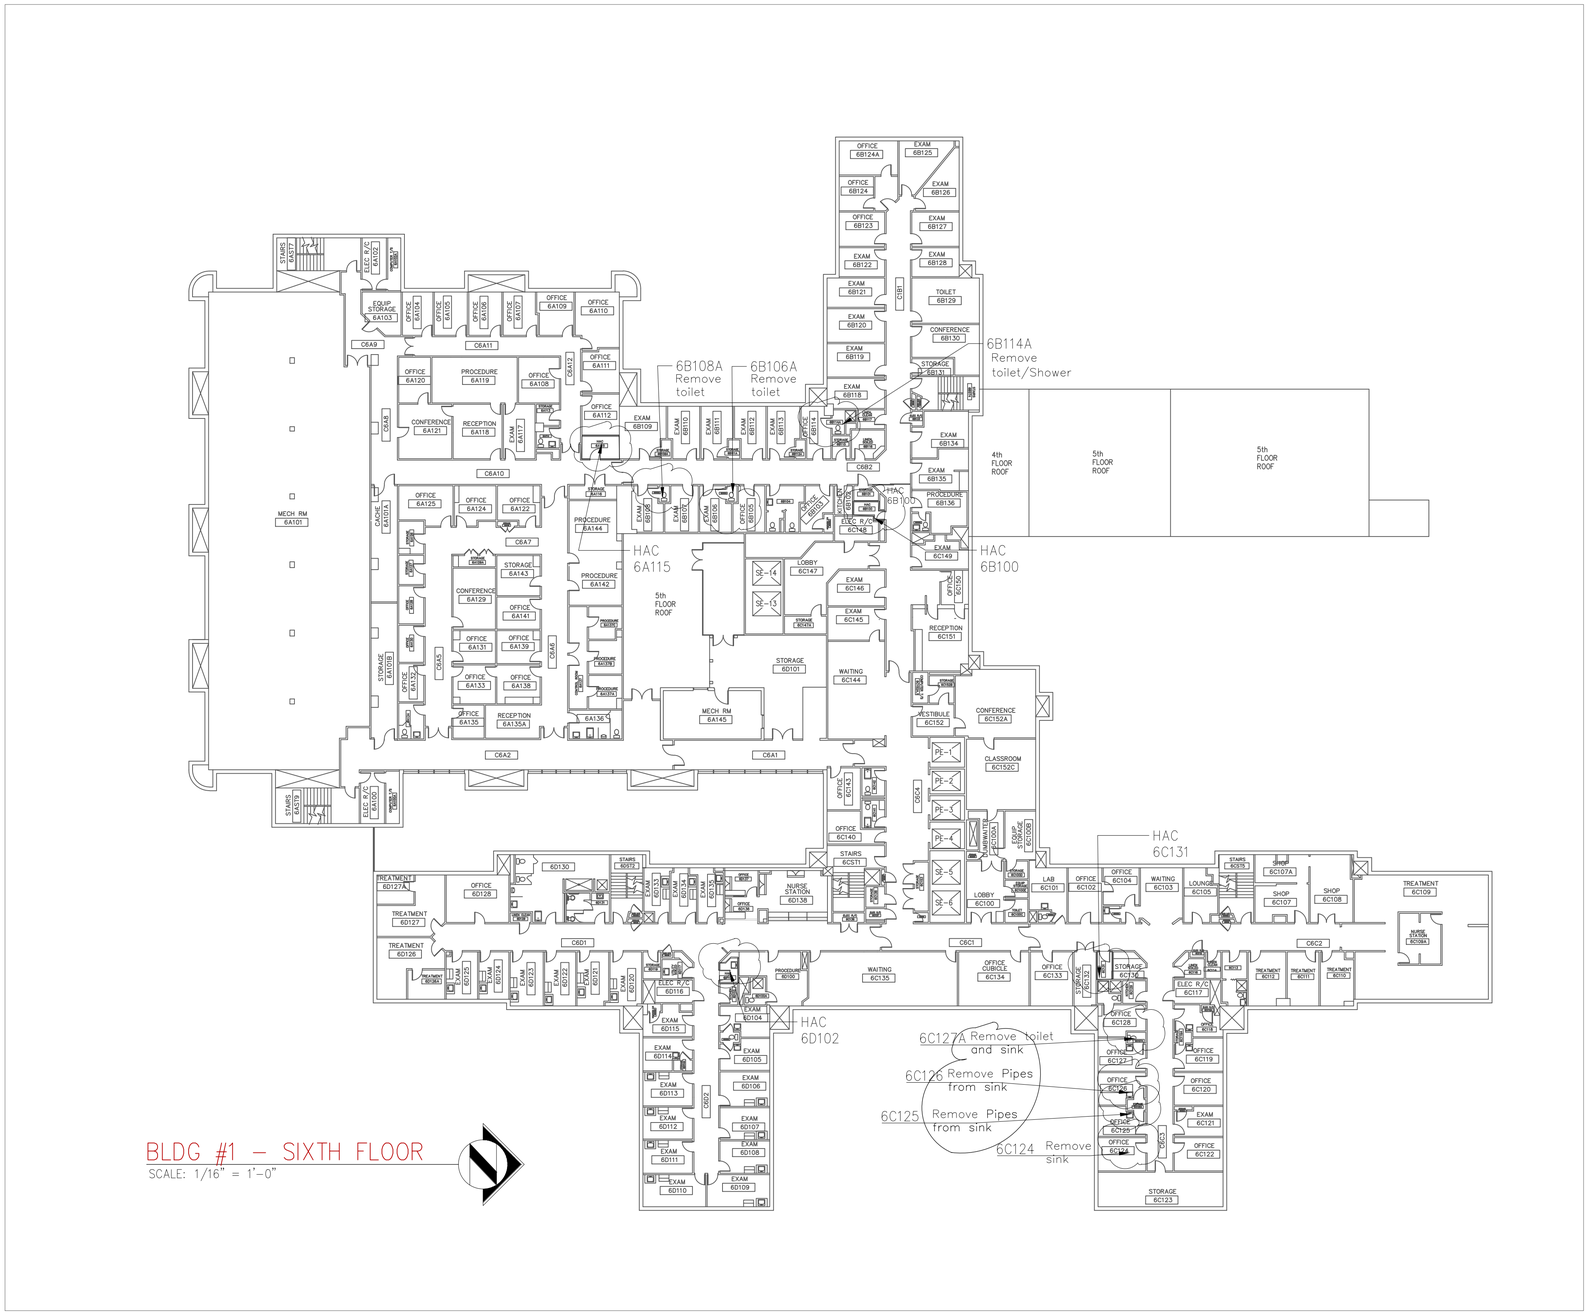

BLDG #1 – SIXTH FLOOR

SCALE: 1/16" = 1'-0"

FULLY SPRINKLERED

CONTRACTOR SHALL INSTALL NEW FAUCETS WITH CHECK VALVES IN ALL HOUSEKEEPING AID CLOSETS (HAC'S), TO ENSURE NO COLD WATER BACK FEED INTO THE CHEMICAL INJECTION SYSTEM. WORK MAY REQUIRE MINOR DEMOLITION AND REPAIR TO ACCESS VALVES IN WALLS/CEILINGS.

HAC'S Room #
6A115
6B100
6C131
6D102

REMOVE UNUSED/UNDERUSED SINKS, SHOWERS AND TOILETS IN LOCATIONS NOTED ON PLANS. PIPING WILL NEED TO BE CUT BACK AND CAPPED AT MAIN AND ALL "DEAD LEG" PIPING REMOVED.

Fixture (s) Removal Room #	
6B106A	
6B108A	
6B114A	
6C124	
6C125	Sink already removed, remove pipes
6C126	Sink already removed, remove pipes
6C127A	Add "and remove Sink"
6C128A	Added to Project "Remove toilet & shower"

PLOTTING NOTES:

1. FULL SIZE V.A. "E" SHEET (AS INDICATED)
2. HALF SIZE V.A. "D" SHEET (1/2 THE INDICATED SCALE)
3. LETTER SIZE: (NOT SCALE)

GENERAL NOTES:

1. SCALED DIMENSIONS + ARCHITECTURAL FEATURES MAY NOT BE CORRECT.
2. CONTRACTORS + A/E's ARE RESPONSIBLE TO FIELD VERIFY ALL DIMENSIONS WITHIN THE PROJECT AREA.

DEPARTMENT OF VETERANS AFFAIRS
MEDICAL CENTER
1055 Clermont Street
Denver, Colorado, 80220

Drawing Title: SIXTH FLOOR HOUSEKEEPING AID CLOSETS LOC	Project Title: Correct Hot Water System Deficiencies Phase 1	Project Number: 554-14-804	Office of Construction and Facilities Management
Approved Project Director	Location: DENVER VA MEDICAL CENTER	Building Number: BUILDING 1	
	Date: 27 DEC, 2013 / Checked: T. VIGIL / Drawn: D. ZETHREN	Drawing Number: A107Rev	Department of Veterans Affairs
		Dwg. 8 of 26	

VA FORM 08-6231

S:\ENG All Shared\Projects\554-14-804 Correct Hot Water System Deficiencies PH 1\554-14-804 (new)\Design\DRAWINGS\dwgs\Autocad\008Rev A107 Bldg 1 - 6th Floor w HACs.dwg 1-29-14 02:24:52 PM VHAECHKoysnM