


A
B
C
D
E
F

one eighth inch = one foot
one quarter inch = one foot
three eighths inch = one foot
one half inch = one foot
one inch = one foot
three quarters inch = one foot
one and one half inches = one foot
two inches = one foot
three inches = one foot
SA:ENG All Shared\Projects\554-14-804 Correct Hot Water System Deficiencies PH 1\554-14-804 (new)\Design\DRAWINGS\dwgs\Autocad\009Rev A108 Bldg 1 - 7th Floor w HACs.dwg 1-29-14 02:52:10 PM VHA:CHKoyenM

FULLY SPRINKLERED

A
B
C
D
E
F

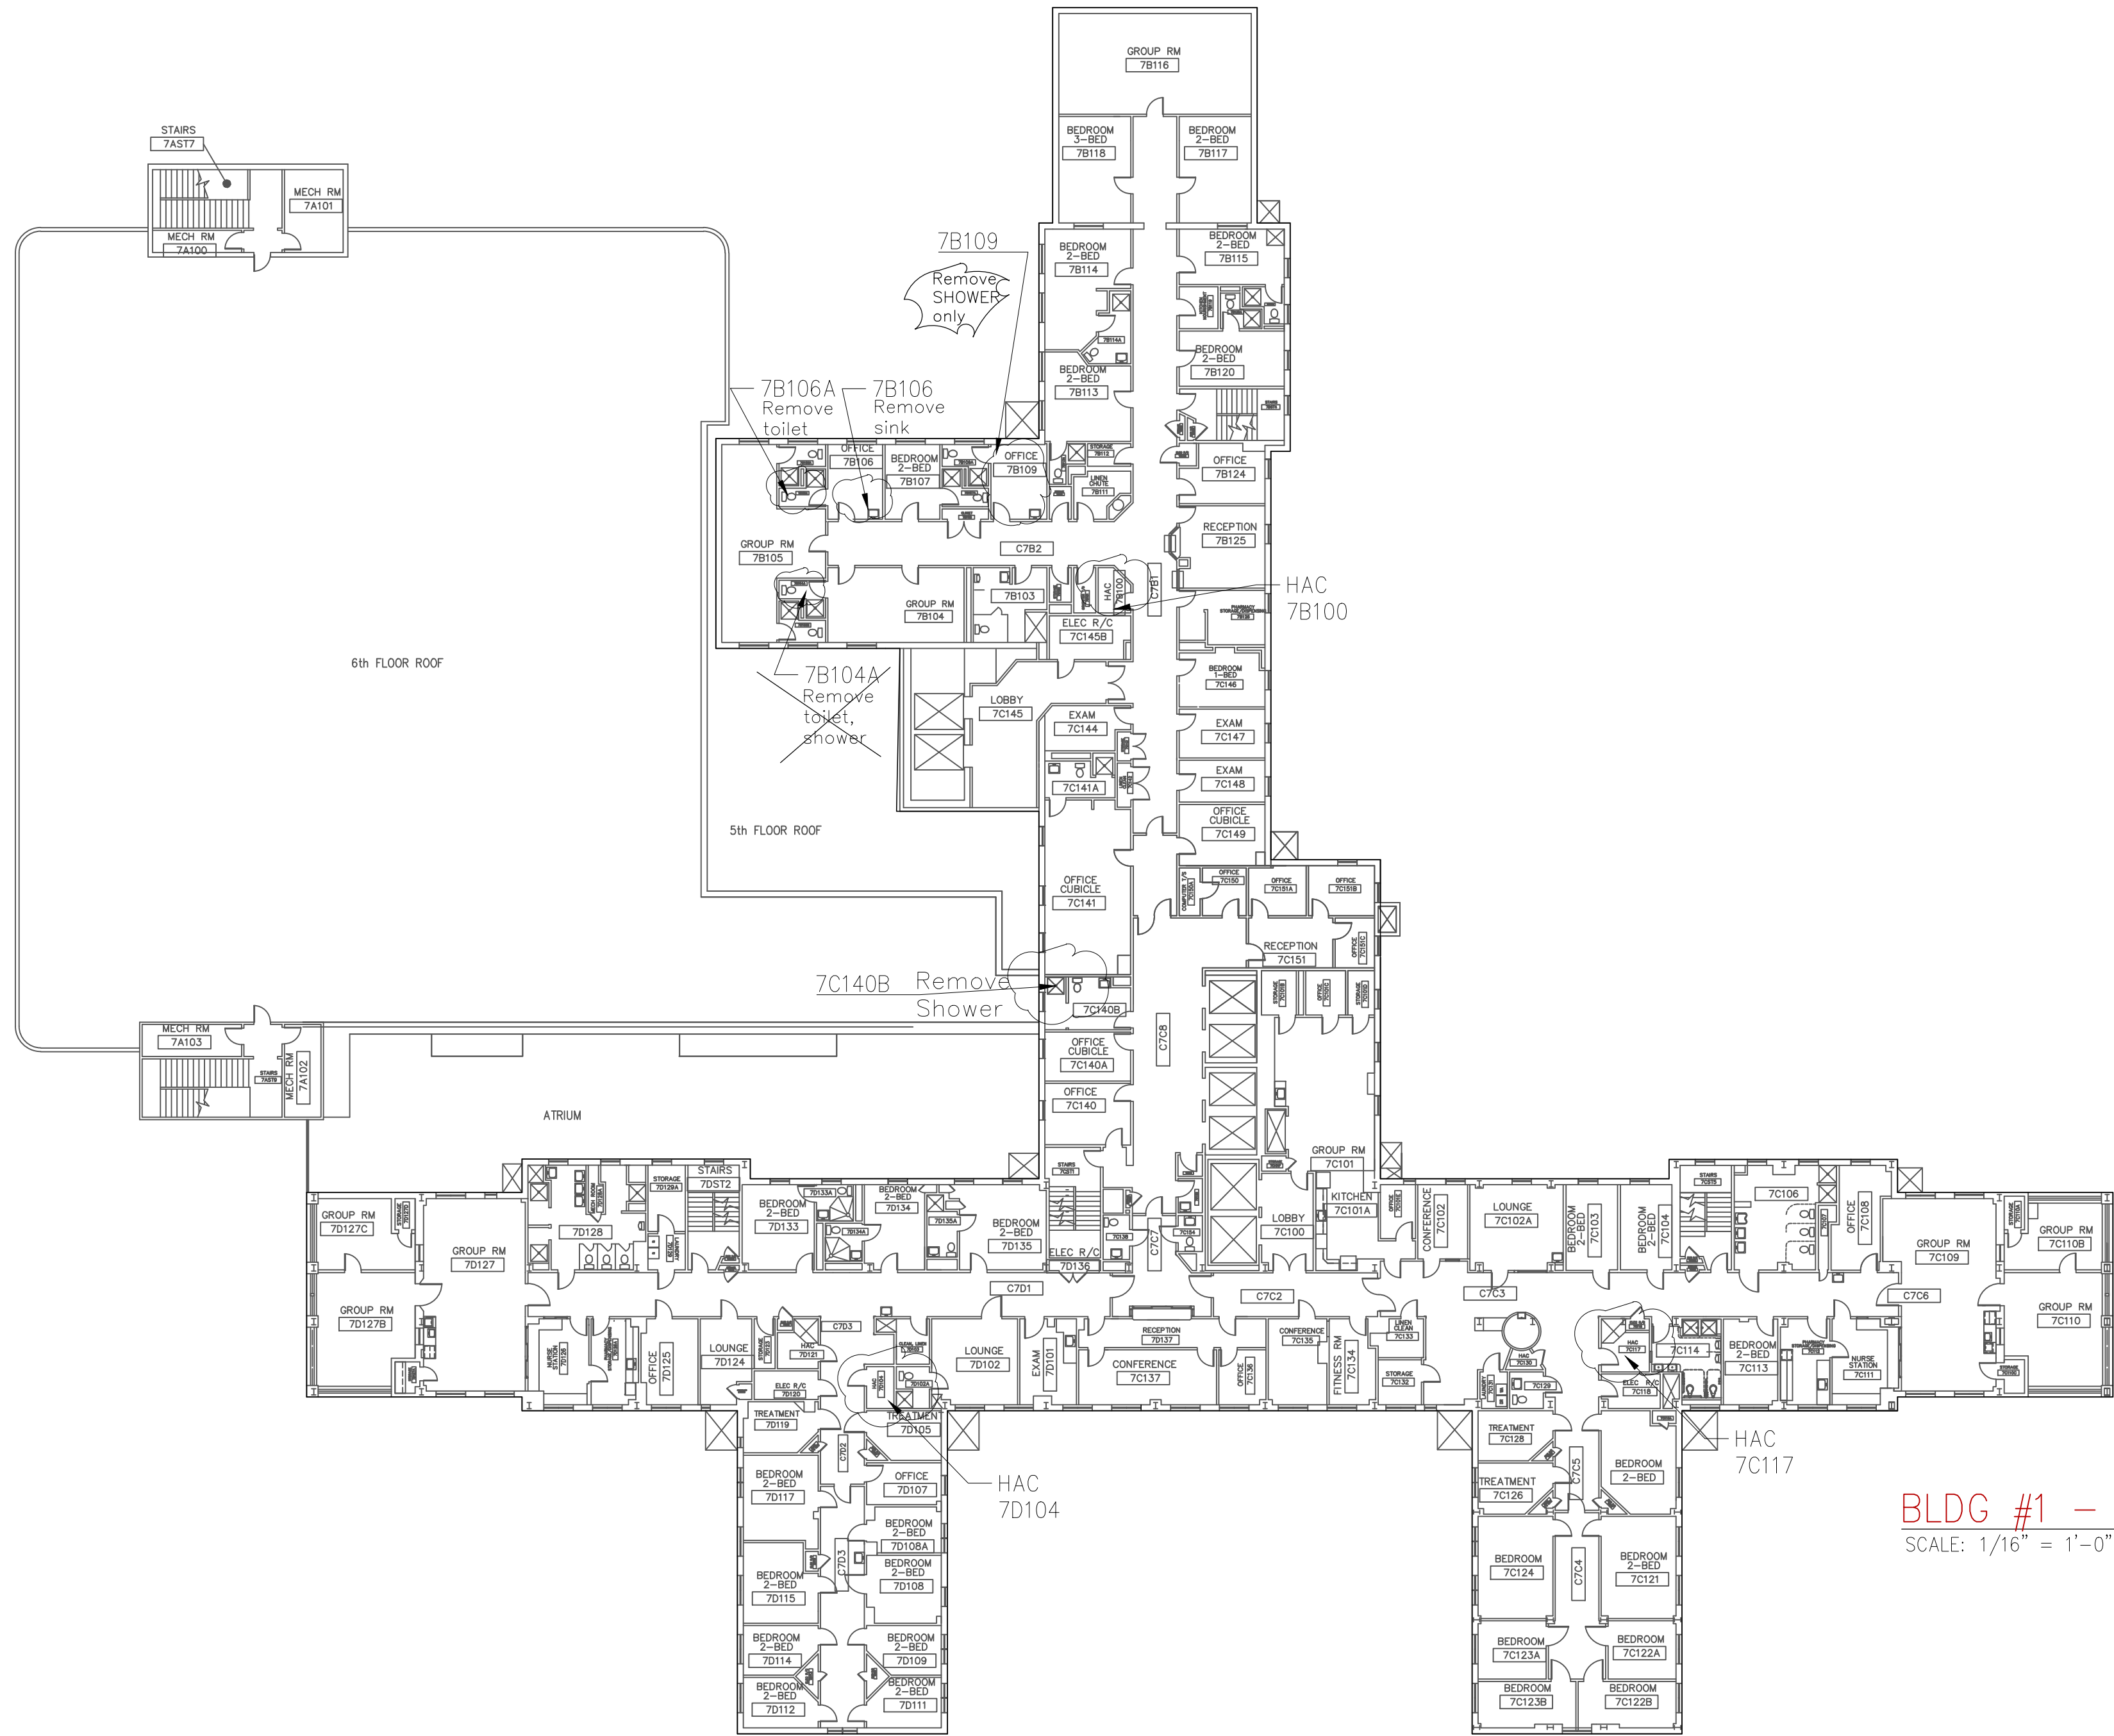

CONTRACTOR SHALL INSTALL NEW FAUCETS WITH CHECK VALVES IN ALL HOUSEKEEPING AID CLOSETS (HAC'S), TO ENSURE NO COLD WATER BACK FEED INTO THE CHEMICAL INJECTION SYSTEM. WORK MAY REQUIRE MINOR DEMOLITION AND REPAIR TO ACCESS VALVES IN WALLS/CEILINGS.

HAC'S Room #
7C117
7D104


REMOVE UNUSED/UNDERUSED SINKS, SHOWERS AND TOILETS IN LOCATIONS NOTED ON PLANS. PIPING WILL NEED TO BE CUT BACK AND CAPPED AT MAIN AND ALL "DEAD LEG" PIPING REMOVED.

Fixture (s) Removal Room #
7B104A
7B106
7B106A
7B109
7C140B

** Deleted from Project

Remove Shower, not sink

BLDG #1 - SEVENTH FLOOR
SCALE: 1/16" = 1'-0"

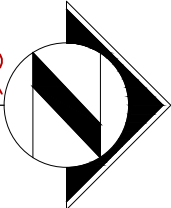

PLOTTING NOTES:

1. FULL SIZE V.A. "E" SHEET (AS INDICATED)
2. HALF SIZE V.A. "D" SHEET (1/2 THE INDICATED SCALE)
3. LETTER SIZE: (NOT SCALE)

GENERAL NOTES:

1. SCALED DIMENSIONS + ARCHITECTURAL FEATURES MAY NOT BE CORRECT.
2. CONTRACTORS + A/E's ARE RESPONSIBLE TO FIELD VERIFY ALL DIMENSIONS WITHIN THE PROJECT AREA.

DEPARTMENT OF VETERANS AFFAIRS
MEDICAL CENTER
1055 Clermont Street
Denver, Colorado, 80220

Drawing Title
**SEVENTH FLOOR
HOUSEKEEPING AID CLOSETS LOC**

Approved Project Director

Project Title
**Correct Hot Water System
Deficiencies Phase 1**

Location
DENVER VA MEDICAL CENTER

Date
12 DEC, 2012

Checked
T. VIGIL

Drawn
D. ZETHREN

Project Number
554-14-804

Building Number
BUILDING 1

Drawing Number
A108Rev
Dwg. 9 of 26

Office of
Construction
and Facilities
Management

