

REFER TO SHEET M-10

ADM-1

SHEET NUMBER

SHEET TITLE
DETAILS

PROJECT NUMBER	528A7-11-724
DATE	07/07/04
DRAWN BY	TJR
CHECKED BY	GHS
SCALE	AS NOTED
ITC PROJECT NUMBER	356



Towne
Engineering
18 South Street
Utica, New York 13501



VA MEDICAL CENTER, ROME OUTPATIENT CLINIC


REPAIR ROME CBOC MECHANICAL SYSTEMS PROJECT 528A7-11-724

125 BROOKLEY ROAD

ROME, NEW YORK 13441

PIPING CONNECTIONS AT STEAM PRESSURE REDUCING STATION

SCALE: NONE

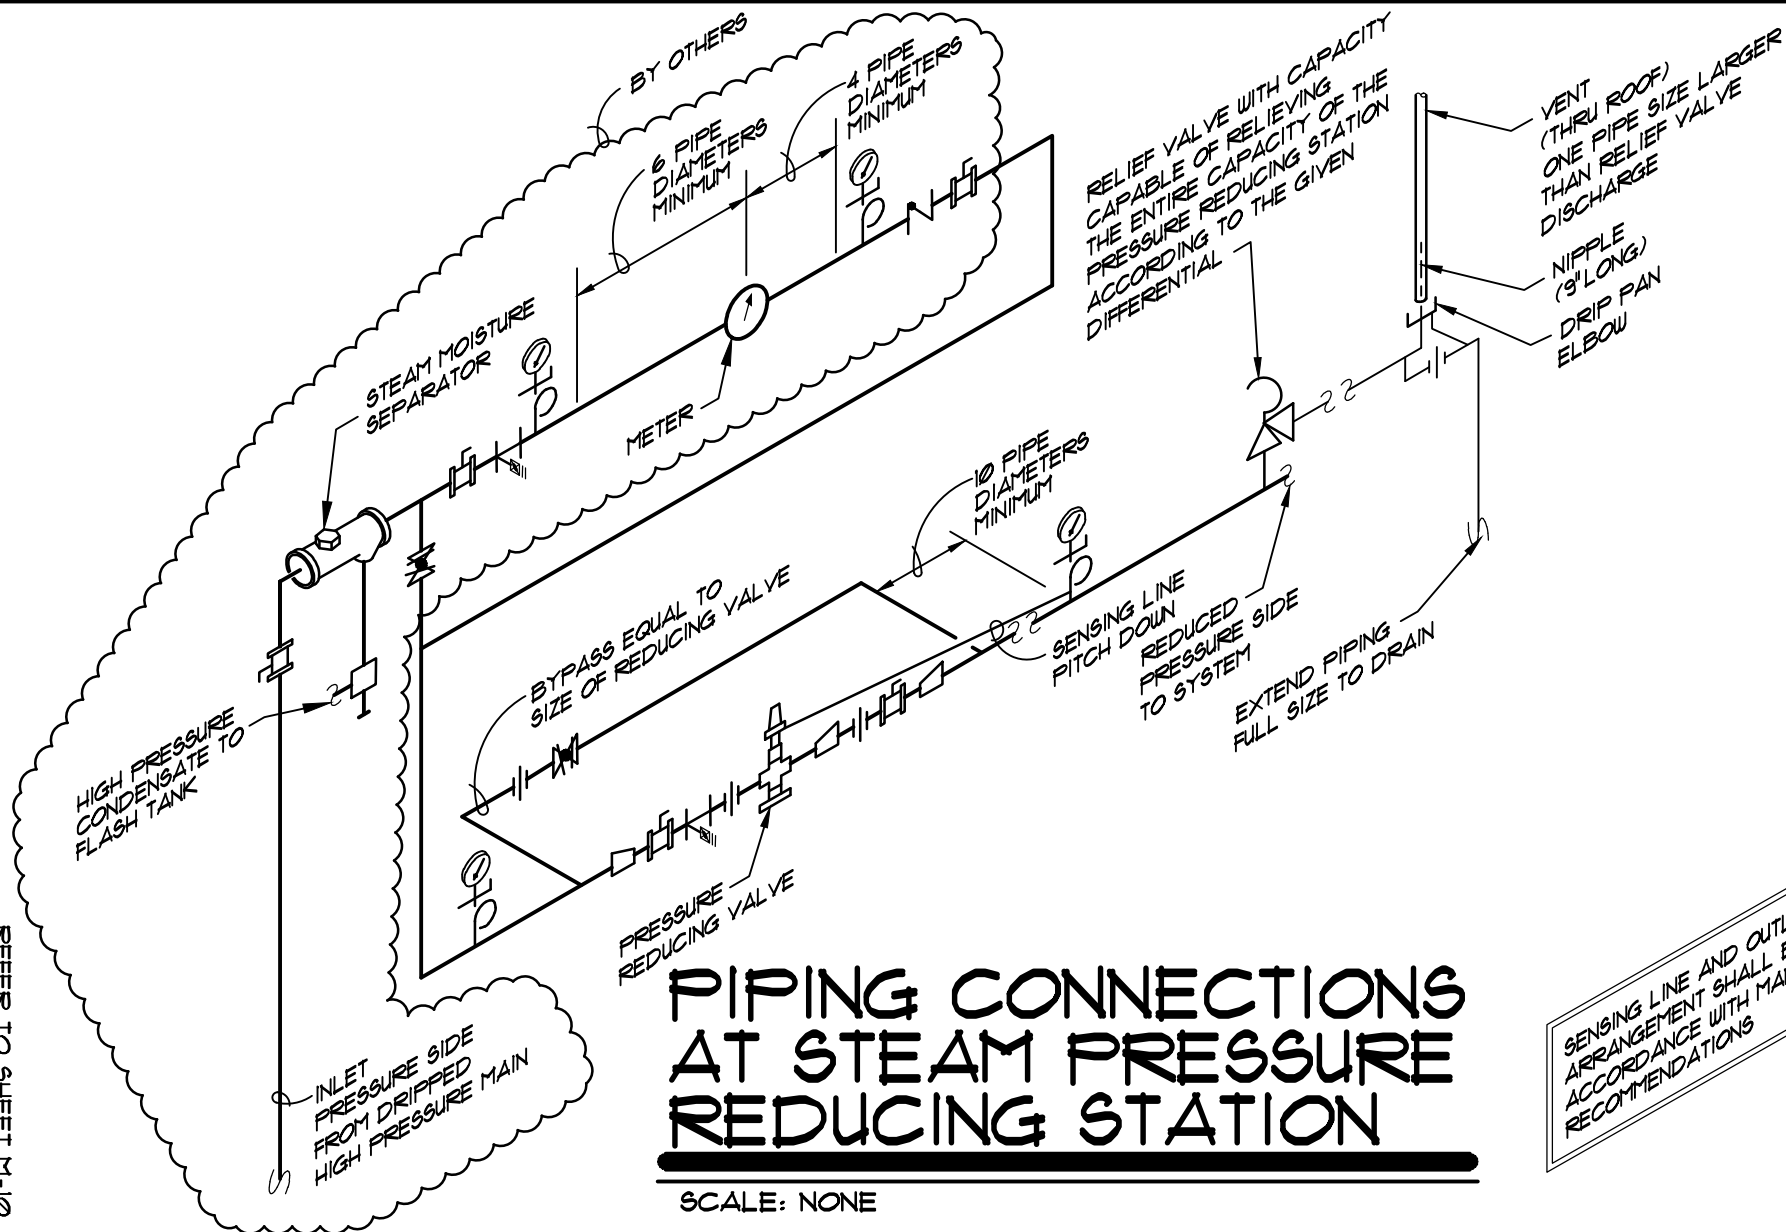

SENSING LINE AND OUTLET EXPANDER
ARRANGEMENT SHALL BE IN STRICT
ACCORDANCE WITH MANUFACTURER'S
RECOMMENDATIONS