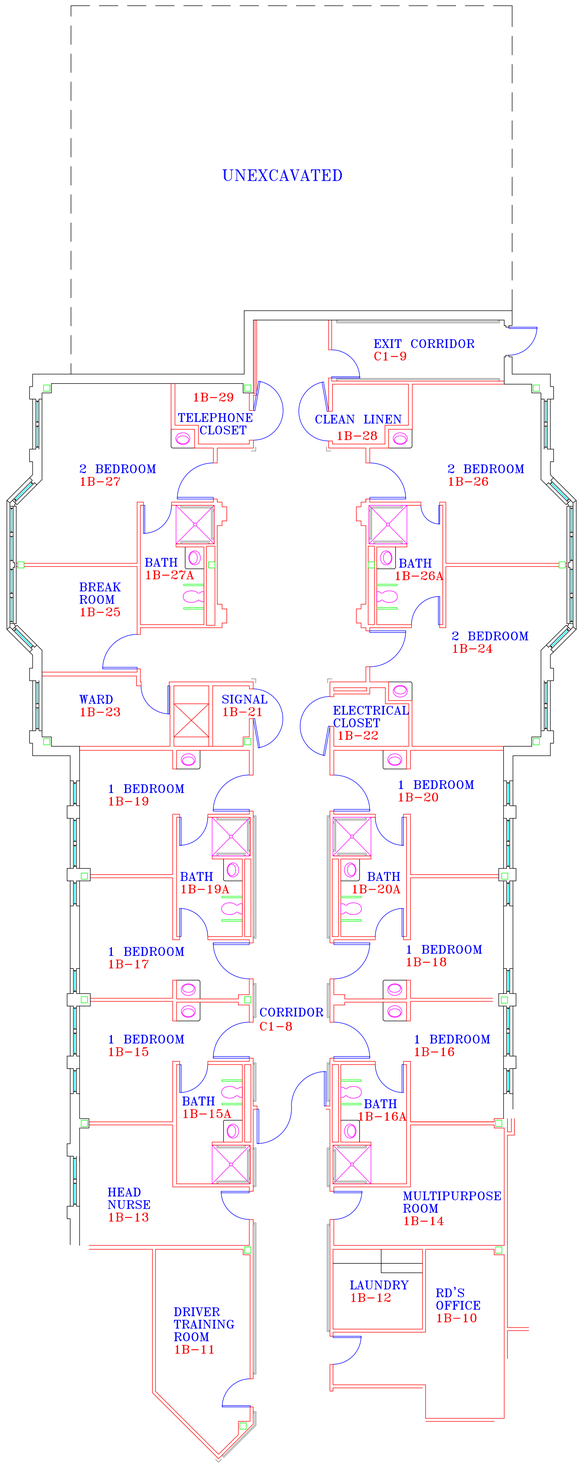

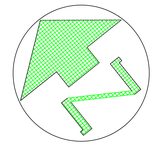

BRECC BLDG.#1
1ST FLOOR ZONE B

Revisions	Date	Professional Seal	Drawing Title: FIRST FLOOR PLAN ARCHITECTURAL / ZONE B BRECC	Project Title: AS-BUILT Drawings	Date: 10-12-2005
			Approved:	Building Number: 01 / Checked / Drawn: LM	Project No.
			Approved:	Location: VAMC, LOCH RAVEN, MARYLAND	Drawing No.

VAMC, LOCH RAVEN

Department of Veterans Affairs

VA FORM 08-6231, OCT 1978