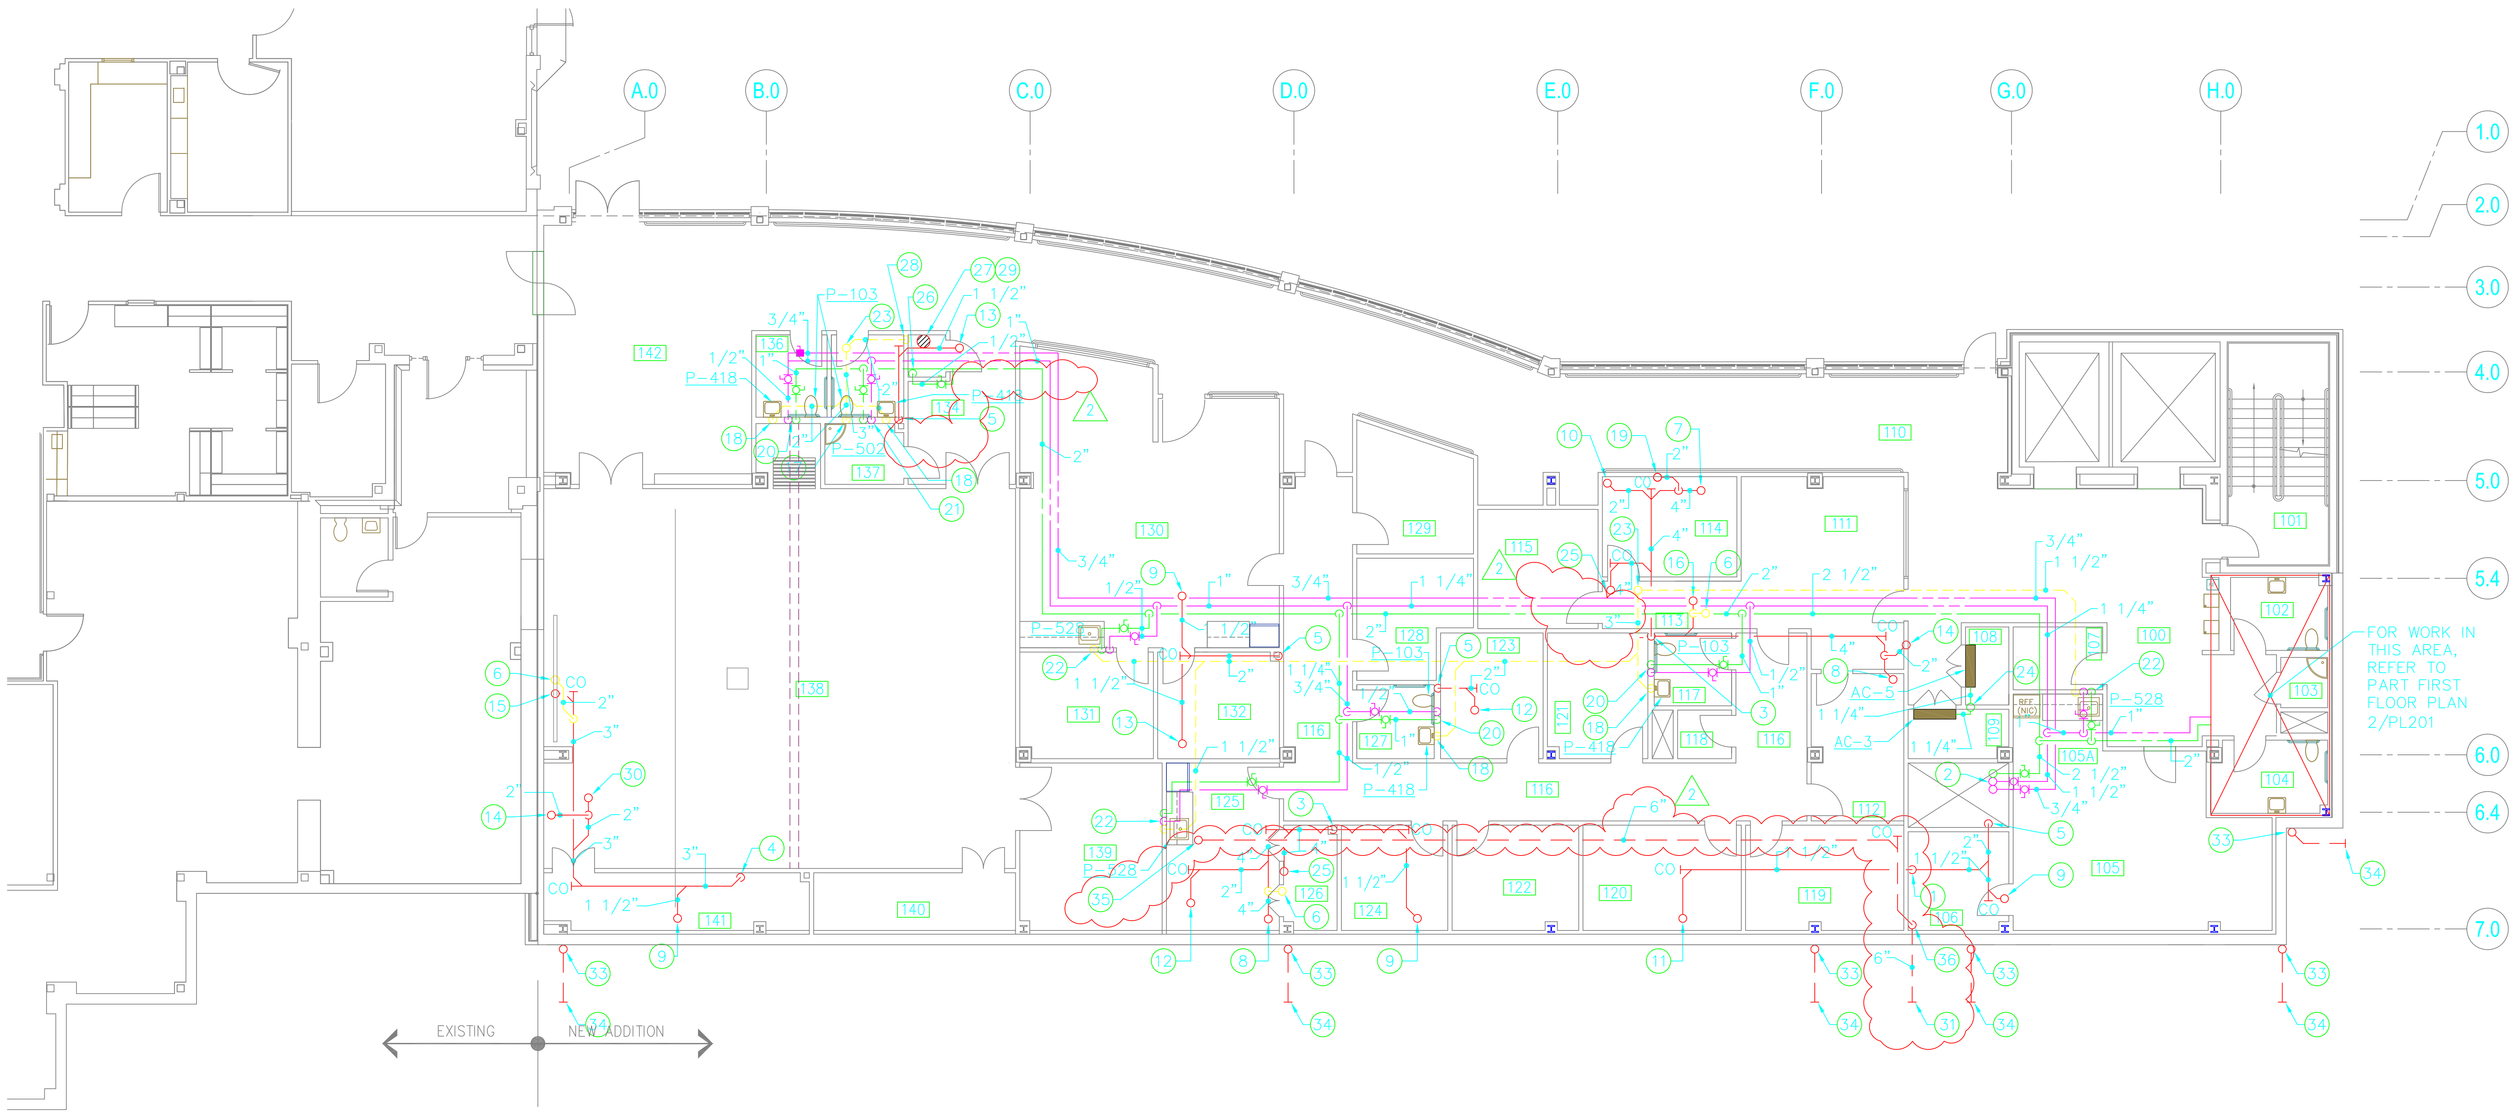

PART FIRST FLOOR PLAN - PLUMBING - NEW WORK

1 / PL103

SCALE: 1/8" = 1'-0"

N

ROOM NAME LIST

100	LOBBY
101	STAIR
102	WOMEN'S TOILET
103	HAS
104	MEN'S TOILET
105	CONFERENCE
105A	KITCHEN AREA
106	STORAGE
107	STORAGE
108	TEL. ROOM
109	ELECTRIC ROOM
110	CONCOURSE
111	RECEP./WAITING
112	COMM.
113	CORRIDOR
114	DIR. PM & R OFFICE
115	CAMPUS MGR. OFFICE
116	CORRIDOR
117	WOMEN'S TOILET
118	STORAGE
119	EXECUTIVE OFFICE
120	DEP. CHIEF OFFICE
121	SWING OFFICE
122	VOL. OFFICE
123	SWING OFFICE
124	VOL. OFFICE
125	VOL. LOUNGE
126	STORAGE
127	MEN'S TOILET
128	RT STORAGE
129	DIR. GERIATRICS OFFICE
130	RECREATION THERAPY
131	RT OFFICE
132	RT OFFICE
134	CLOSET
135	WOMEN'S TOILET
136	MEN'S TOILET
137	HAC
138	ACTIVITY CENTER
139	STORAGE
140	A/V EQUIPMENT STORAGE
141	STORAGE
142	MEDIA CENTER

GENERAL NOTES:

1. REFER TO PL001 FOR PLUMBING LEGEND, ABBREVIATIONS, GENERAL NOTES AND SPRINKLER GENERAL NOTES.

DRAWING NOTES:

1. OFFSET 1 1/2" WASTE BELOW DUCTWORK.
2. 1 1/2" HOT WATER, 3/4" HOT WATER RECIRCULATING, 2 1/2" COLD WATER UP AND 2" HOT WATER, 1" HOT WATER RECIRCULATION AND 3" COLD WATER DOWN.
3. 4" SANITARY DOWN.
4. 3" WASTE DOWN.
5. 2" WASTE DOWN.
6. 2" VENT UP.
7. 4" SANITARY UP TO P-106.
8. 4" SANITARY UP TO P-103.
9. 1 1/2" WASTE UP TO P-528.
10. 2" WASTE UP TO P-808.
11. 2" WASTE UP TO (2) P-528.
12. 2" WASTE UP TO (1) P-418 AND (1) P-528.
13. 1 1/2" WASTE UP TO P-418.
14. 2" WASTE UP TO P-418.
15. 3" WASTE UP TO P-502.
16. 2" WASTE UP TO P-302.
17. 2" VENT DOWN TO 3" WASTE.
18. 2" VENT DOWN TO P-418 AND 2" WASTE.
19. 2" WASTE UP TO P-408.
20. 1/2" HW AND 1" CW DOWN TO (1) P-418 AND (1) P-103.
21. 3/4" HW AND 1" CW DOWN TO (1) P-418, (1) P-103 AND P-502.
22. 1/2" HW, 1 1/2" VENT AND 1/2" CW DOWN TO P-528 AND 1 1/2" WASTE.
23. 3" VENT UP.
24. 1 1/4" CONDENSATE UP AND 1 1/2" CONDENSATE DOWN.
25. 4" WASTE UP.
26. 1/2" CW DOWN TO ICE MAKER UNDER ANOTHER DIVISION, UNDER THIS DIVISION PROVIDE SHUT-OFF BALL VALVE, ASSE 1035 BACKFLOW PREVENTER, ROUGH-IN AND FINAL CONNECTION.
27. 2" FUNNEL FLOOR DRAIN WITH 1/2" TRAP PRIMING LINE.
28. 2" VENT DOWN TO 2" WASTE.
29. PROVIDE 1 1/2" INDIRECT WASTE FROM ICE MAKER TO FUNNEL FLOOR DRAIN.
30. 2" WASTE UP TO 2" FUNNEL FLOOR DRAIN WITH 1/2" TRAP PRIMING LINE.
31. 6" STORM WATER, INVERT ELEVATION @ 225.00'±, FOR CONTINUATION REFER TO CIVIL DRAWINGS. (2)
32. NOT USED.
33. 6" STORM WATER UP TO DOWNSPOUT BOOT, REFER TO DETAIL1/PL302.
34. 6" STORM WATER, FOR CONTINUATION REFER TO CIVIL DRAWINGS. (PROVIDE 3'-0" MIN. GROUND COVER).
35. 6" STORM WATER UP.
36. 6" STORM WATER DOWN.

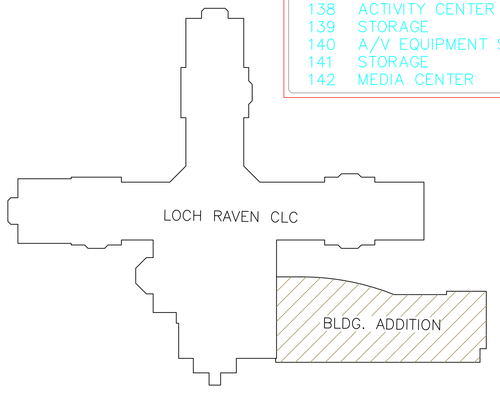

KEY PLAN

NORTH

CONSTRUCTION SET 02-19-10

Addendum No. 1	08-04-09		
Addendum No. 2	08-06-09		
Revisions:	Date	VAMHCS Signature	Date

ARCHITECT:

ERNEST BLAND ASSOCIATES, P.C.
TECHNICAL FACILITIES DESIGN
802 SLIGO AVENUE, SILVER SPRING, MARYLAND 20910
TELEPHONE (301) 589-4811 FAX (301) 589-3810

CONSULTANTS:

MPE ENGINEERS
BURDETTE KOEHLER MURPHY & ASSOC.
1423 CLARKVIEW ROAD
SUITE 500
BALTIMORE, MARYLAND 21209

FIRE PROTECTION
KOFFEL ASSOCIATES, INC.
6322 MEADOWRIDGE ROAD
ELKRIDGE, MD 21075

STRUCTURAL ENGINEER
ALPHA CORPORATION
21351 RIDGETOP CIRCLE
SUITE 200
DULLES, VIRGINIA 20166

COST ESTIMATING
ALPHA CORPORATION
1800 WASHINGTON BLVD.
SUITE 425
BALTIMORE, MARYLAND 21230

TRANSPORTATION
ROBERT L. SEYMORE & ASSOCIATES
182 Thomas Johnson Drive
SUITE 200
FREDERICK, MARYLAND 21702

TELECOMMUNICATIONS
USSI
1726 Reistertown Road
SUITE 206
PIKESVILLE, MARYLAND 21208

Drawing Title: PART FIRST FLOOR PLAN PLUMBING NEW WORK	Project Title: VA LOCH RAVEN CLC ADDITION		Project Number: 512-541
			Solicitation Number: 101-05-15
Approved: Project Director	Location: BALTIMORE, MARYLAND		Drawing Number: PL103
	Date: February 19, 2009	Checked: MAF	Drawn: FJK
			Dwg.109 of 204

Department of Veterans Affairs

VA FORM 08-6231, OCT 1978

BKM# 081130.010