


B208 ATTIC

- — ○ — ○ — ○ NEW SPRINKLERS
- Ⓢ NEW SMOKE DETECTOR
- ⊕ DUPLEX OUTLET

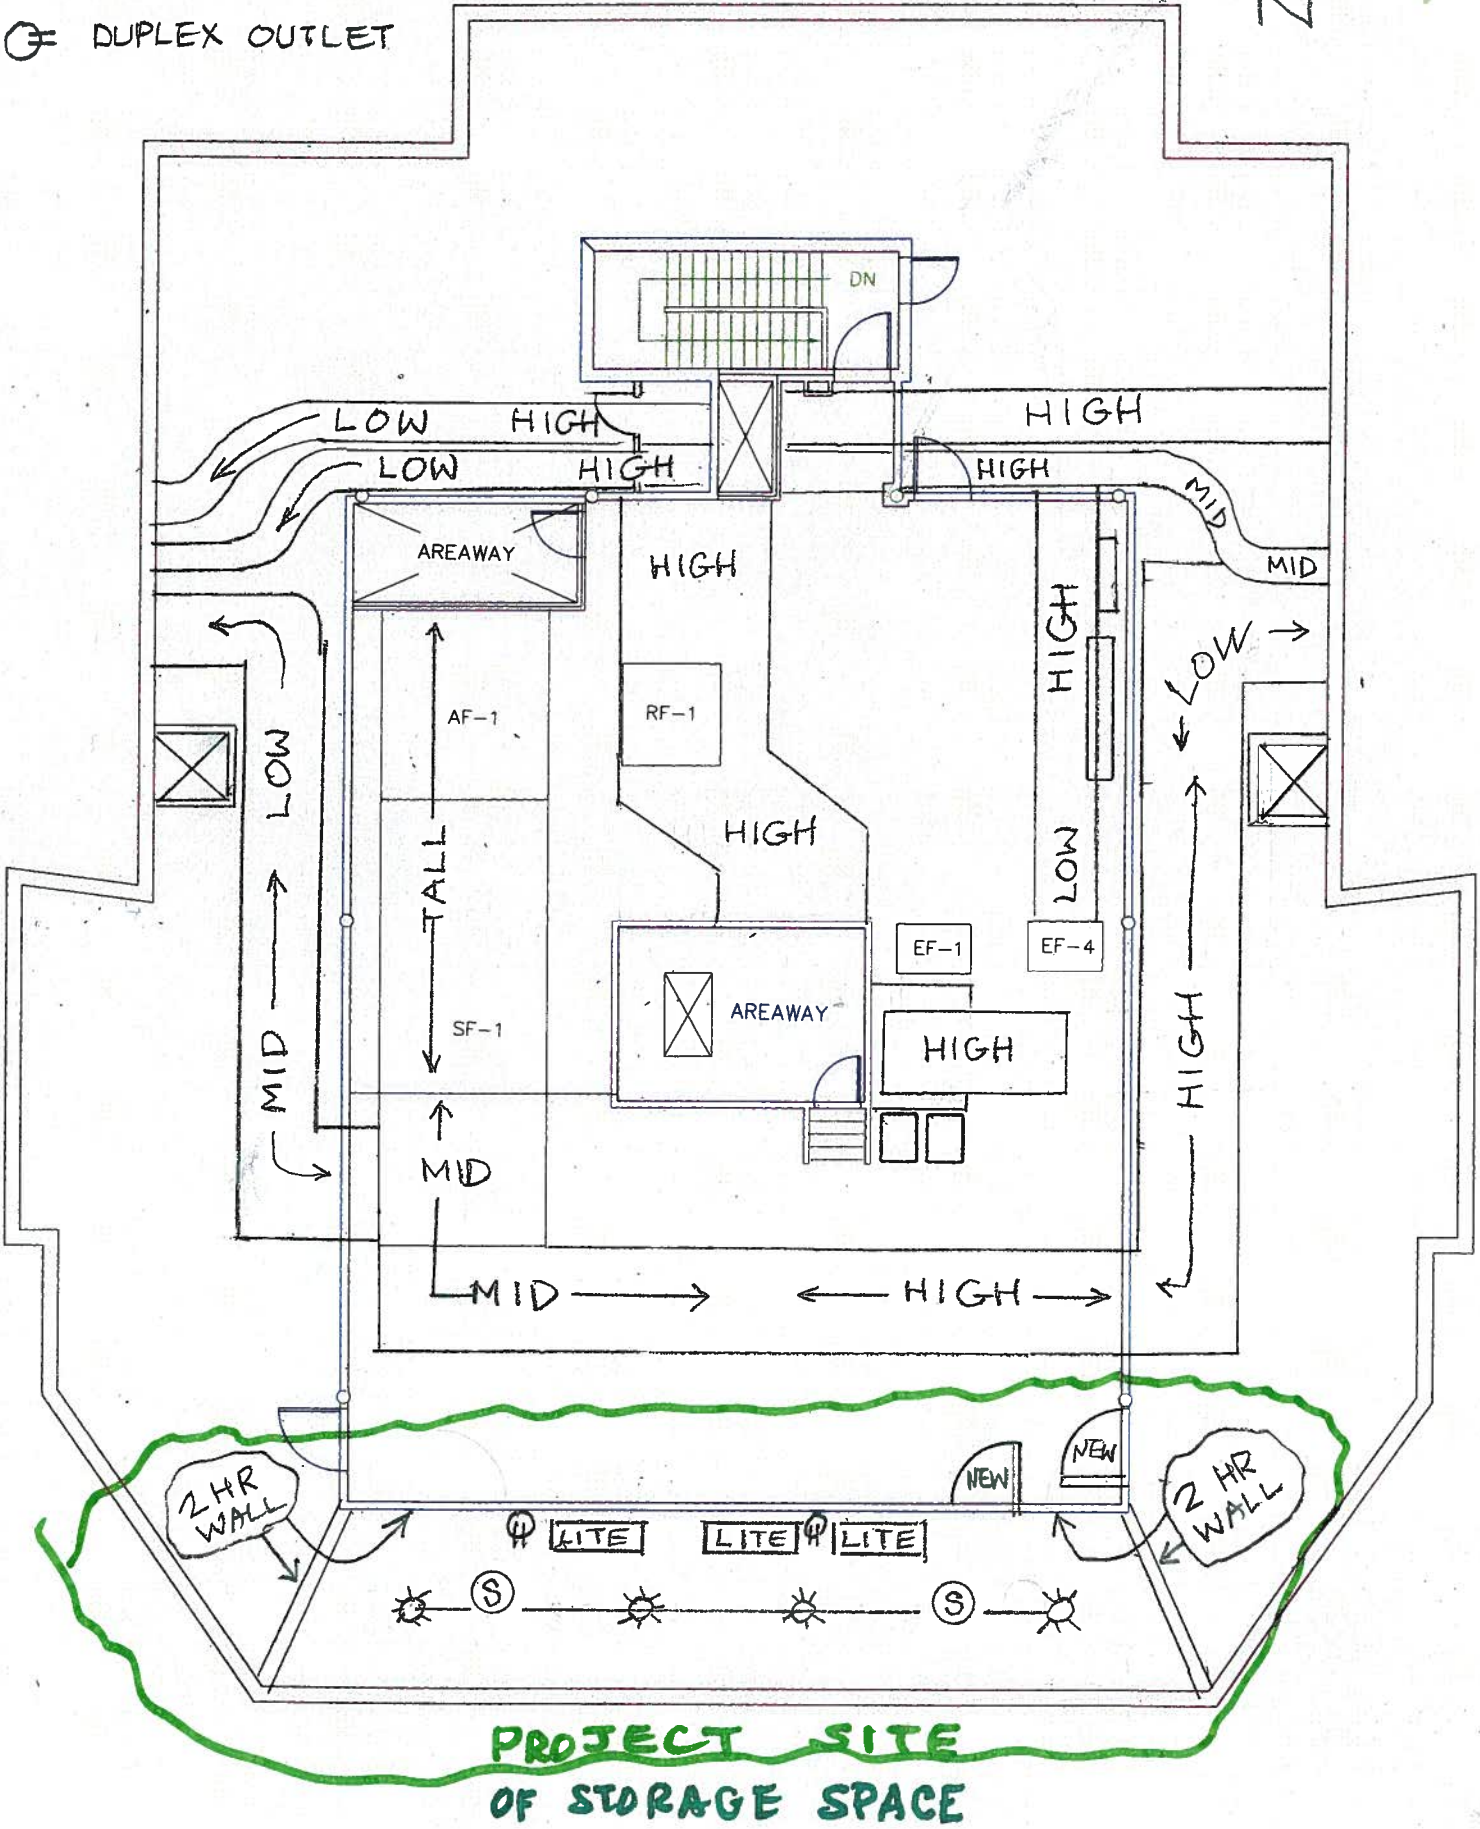



# ATTACHMENT-F

(P2)

