


three inches = one foot
one and one half inches = one foot
one inch = one foot
three quarters inch = one foot
one half inch = one foot
three eighths inch = one foot
one quarter inch = one foot
one eighth inch = one foot

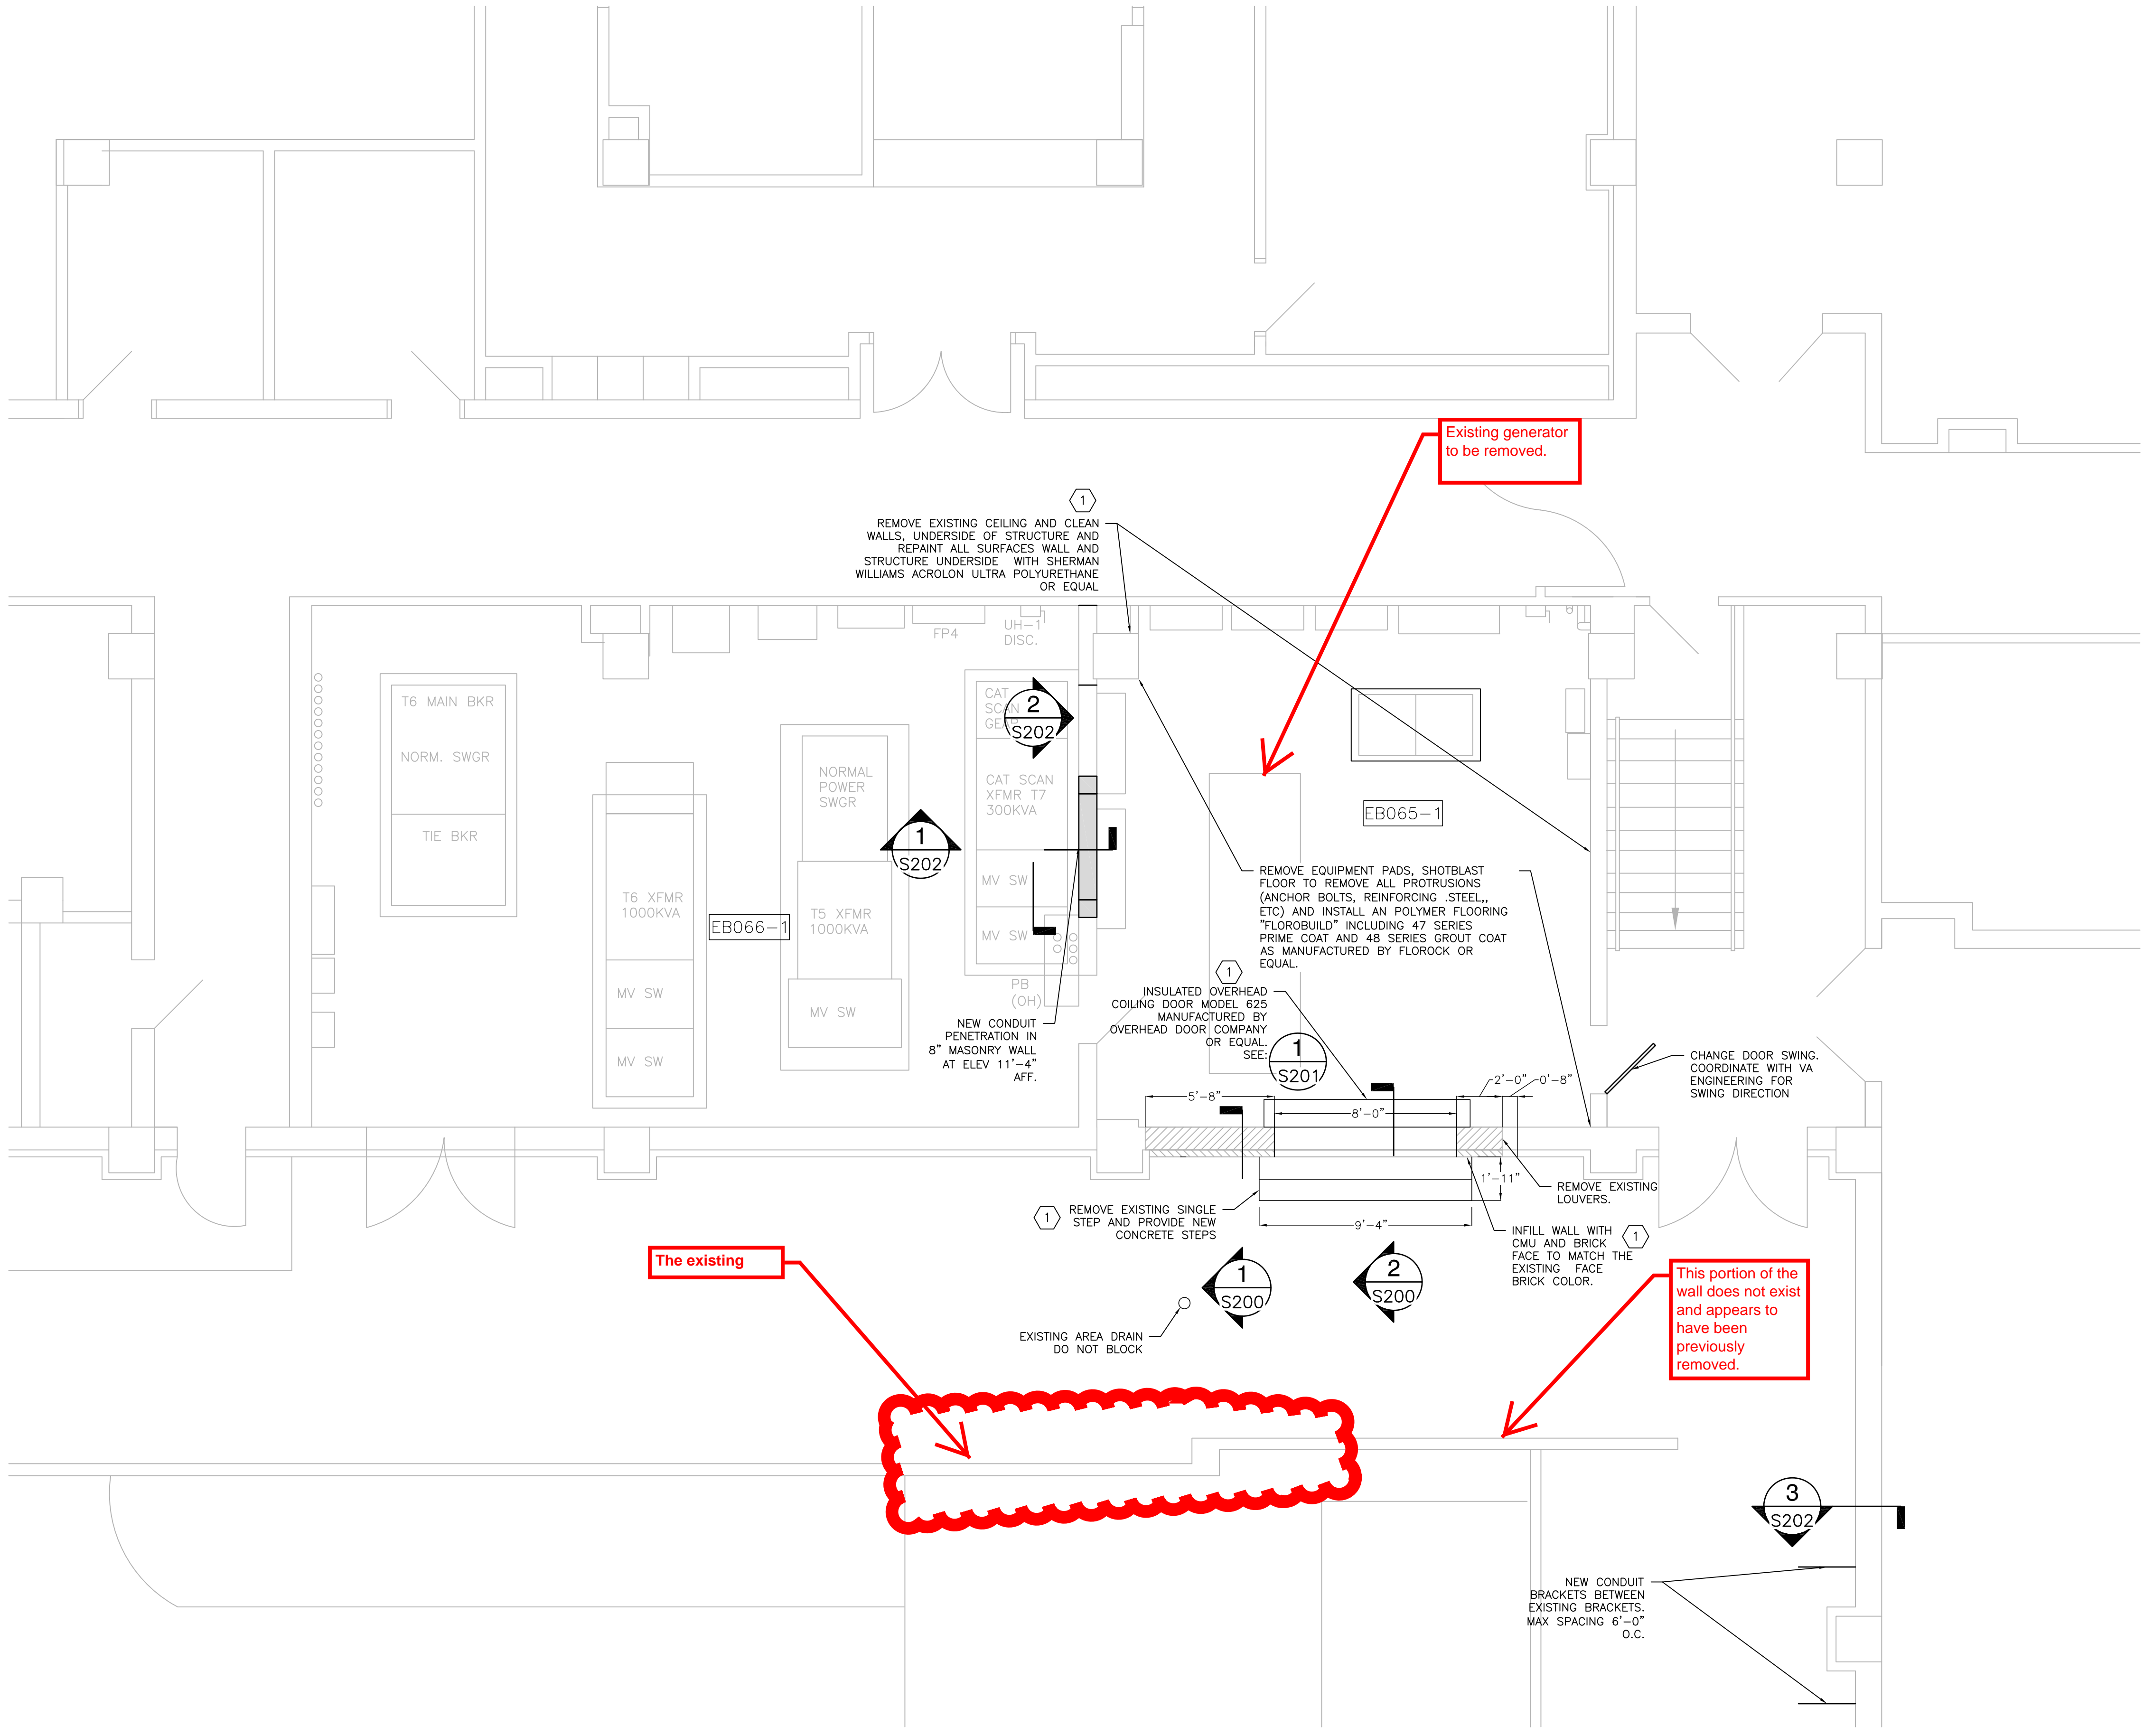

NOTE:
A. SEE SHEETS G002 AND E202 FOR PROPOSED CONSTRUCTION SEQUENCE.
B. SEE SHEET A001 FOR WALL RATINGS.


KEYNOTE:
1. THIS WORK SHALL NOT BE INCLUDED IN DEDUCTIVE ALTERNATE #2.

BID ITEMS SUMMARY:
REFER TO SPECIFICATION SECTION 01 00 00 FOR MORE DETAIL.

BASE BID: PROVIDE ALL EQUIPMENT AND WORK INDICATED ON PLANS AND IN SPECIFICATIONS.

DEDUCTIVE ALTERNATE #1: SAME AS BASE BID, EXCEPT DEDUCT 6 NEW E-WING AUTOMATIC TRANSFER SWITCHES. ALSO, DEDUCT REPLACEMENT OF PANELS FPQ-4 AND FPE-5.

DEDUCTIVE ALTERNATE #2: SAME AS DEDUCTIVE ALTERNATE #1 EXCEPT ALSO DEDUCT SELECTED ROOM MODIFICATIONS FOR EB65-1 (CEILING DEMOLITION, LOUVER DEMOLITION, BLOCK WALL WITH ROLL UP DOOR, FAN COIL UNITS, WALL REPAINTING).

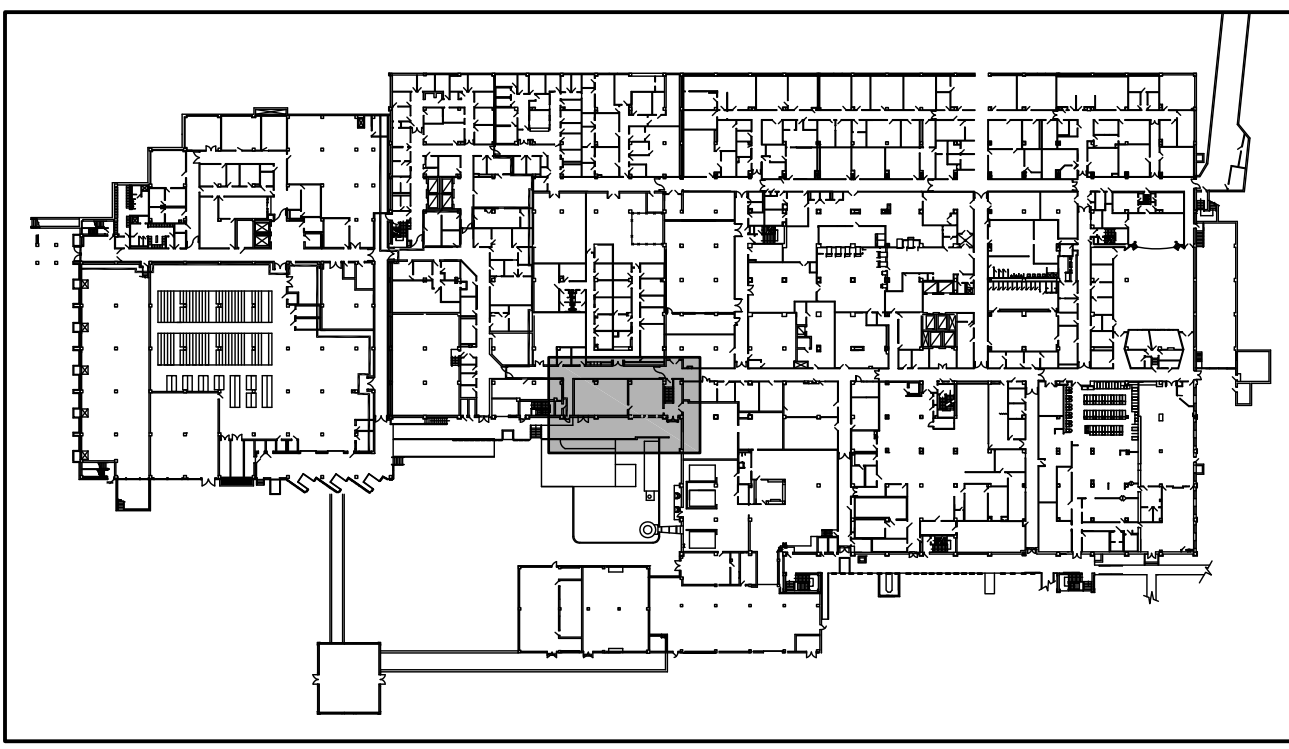

BASEMENT FLOOR PLAN - MISC. STRUCTURAL
SCALE: 1/8" = 1'-0"

FINAL BID DOCUMENTS
APPROVED FOR CONSTRUCTION

--	--	