

Item	Date	Description
1	02/21/14	Amendment A00004



GENERAL NOTES

- | | |
|--|--|
| <p>1. ALL PENETRATIONS THROUGH FIRE RATED WALLS SHALL COMPLY WITH THE BUILDING CODE AND NFPA.</p> | <p>7. REPAIR/REPLACE SPRAY APPLIED/FIREPROOFING WHERE WORK REVEALS EXPOSED STRUCTURAL STEEL MEMBERS.</p> |
| <p>2. PENETRATIONS SHALL BE FIRE STOPPED WITH FIRE BARRIER PRODUCTS AS REQUIRED TO MAINTAIN FIRE RATINGS. INSTALL IN ACCORDANCE WITH ALL ACCESSORIES AND MANUFACTURERS INSTRUCTIONS FOR THEIR USE.</p> | <p>8. ALL WOOD TO BE FIRE RETARDANT TREATED. SEE SPECIFICATIONS FOR OTHER REQUIREMENTS.</p> |
| <p>3. PROVIDE SHOP DRAWINGS FOR APPROVAL SHOWING PENETRATIONS, MATERIALS USED FOR FIRE RATING AND UL ASSEMBLY NO.</p> | <p>8. ALL WOOD USED IN EXTERIOR WALLS, ROOFS, OR EXTERIOR TO THE BUILDING SHALL BE FIRE RETARDANT TREATED AND PRESERVATIVE TREATED. SEE SPECIFICATIONS FOR OTHER REQUIREMENTS.</p> |
| <p>4. PROVIDE BLOCKING AT PARTITIONS AS REQUIRED FOR MOUNTING OF FINISHED AND UNFINISHED WALL MOUNTED ITEMS.</p> | <p>10. CONTRACTOR TO PROVIDE SPECIFICATION FOR ALL ROOMS EXCEPT CORRIDORS. REFER TO SPECIFICATION SECTION 10.14.10. REFER TO DRAWING 1001 FOR SIGNAGE STYLE AND FINISHES. FINAL TEXT AND FINISHES TO BE DETERMINED BY THE OWNER.</p> |
| <p>5. PROVIDE SUPPLEMENTAL, FINISH, INSULATION, AND FINISH MATERIALS AS REQUIRED TO MAINTAIN PARTITION FIRE RESISTANCE RATING AT ACCESSIBLE ITEMS.</p> | <p>10.1 CONTRACTOR ALSO TO PROVIDE ALL CODE REQUIRED SIGNAGE FOR TOILETS, ROOMS, MECHANICAL ROOMS, FIRE EXTINGUISHER CABINETS, ETC.</p> |
| <p>6. REFER TO SHEET A601 FOR DOOR SCHEDULE AND DOOR TYPES.</p> | <p>11. AREAS IN GRAY ARE NOT IN CONTRACT.</p> |
| | <p>12. ALL GYP IN DIN TOILET AND BATH-ROOMS SHALL BE MOISTURE RESISTANT.</p> |

◆ DRAWING NOTES




 
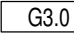









1. FIRE PLACE, ALT.
2. ADD CARD READER CONTROLS TO EXISTING AUTOMATIC DOOR SYSTEM.
3. EXISTING WALLS IN THIS AREA MAY NOT CURRENTLY GO TO DECK, ADD FRAMING AND GYPSUM BOARD AS REQUIRED TO TAKE TO DECK.
4. REPLACE EXISTING EXPANSION JOINT.
5. MAINTAIN FIRE RATINGS OF EXISTING X BRACING. SEPARATE NEW DUCTWORK, PIPING AND CONDUIT PENETRATIONS FROM EXISTING WITH SHAFTWALL OR OTHER APPROVED FIRE RATING METHOD.
6. CONTINUE 1 HOUR FIRE BARRIER AROUND EXISTING DUCTWORK ABOVE TO SEAL TO STRUCTURE.
7. 5 TIER LOCKERS.
8. SEE SHEET A321 FOR ELEVATOR FINISHES, REFLECTED CEILING PLAN AND WALL FINISHES. ALT.
9. INTERIOR PARTITIONS AROUND MECHANICAL ROOM SHALL RECEIVE LAYERS OF 5/8" GYPSUM BOARD ON EACH SIDE OF 3/8" STUDS. STUD CAVITY TO HAVE 1" THICK SOUND-ATTENUATION INSULATION PARTITIONS SHALL SEAL TO STRUCTURE.
10. SEE SHEET A321 FOR ELEVATOR FINISHES, REFLECTED CEILING PLAN AND WALL FINISHES.

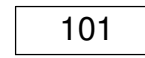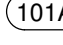Wall Schedule						
Type	Face	Structure	Fire Rating	UL #	Comments	
F1.0	5/8" Gyp. Bd., 1 layer 1 side	7/8" Metal Channels				
F2.0	5/8" Gyp. Bd., 1 layer 1 side	1 5/8" Metal Channels				
F3.0	5/8" Gyp. Bd., 1 layer 1 side	2 1/2" Metal Studs				
F4.0	5/8" Gyp. Bd., 1 layer 1 side	3 5/8" Metal Studs				
F6.0	5/8" Gyp. Bd., 1 layer 1 side	6" Metal Studs				
G4.0	5/8" Gyp. Bd., 1 layer ea. side	3 5/8" Metal Studs				
G4.1	5/8" Fire-Rated Gyp. Bd., 1 layer ea. side	3 5/8" Metal Studs	1-HR	U419		
G6.0	5/8" Gyp. Bd., 1 layer ea. side	6" Metal Studs				
G6.1	5/8" Fire-Rated Gyp. Bd., 1 layer ea. side	6" Metal Studs	1-HR	U419		
S3.1	5/8" Gyp. Bd., 1 layer 1 side, 1" liner panel, shaft side	2 1/2" C-H Stud	1-HR	U415		
S4.1	5/8" Fire-Rated Gyp. Bd., 1 layer 1 side, 1" liner panel, shaft side	4" C-H Studs	1-HR	U415		

1. ALL INTERIOR PARTITIONS TO BE TYPE G4.0 UNLESS NOTED OTHERWISE.
2. STUDS AND FURRING STRIPS AT 16" O.C.
3. DO NOT FASTEN TOP RUNNER TO STUDS. CRIMP RUNNER ON BOTH SIDES TO STABILIZE STUDS.
4. ALL INTERIOR PARTITIONS TO SEAL TO STRUCTURE ABOVE.
5. ALL INTERIOR PARTITIONS TO HAVE SOUND ATTENUATION INSULATION FOR FULL HEIGHT OF WALL.

REFERENCE LEGEND



Room name

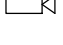	ROOM TAG
	DOOR TAG
	WINDOW TAG
	REVISION TAG
	KEYNOTE TAG
	WALL TAG
	FIRE EXTINGUISHER
	FIRE EXTINGUISHER CABINET
	PUSH PLATE
	CARD READER
	SECTION TAG
	DETAIL TAG
	ELEVATION TAG
	SECURITY CAMERA (NC)
	SECURITY PAN. TILT. ZOOM CAMERA (NC)


Life Safety Legend

[illegible]


KEY PLAN

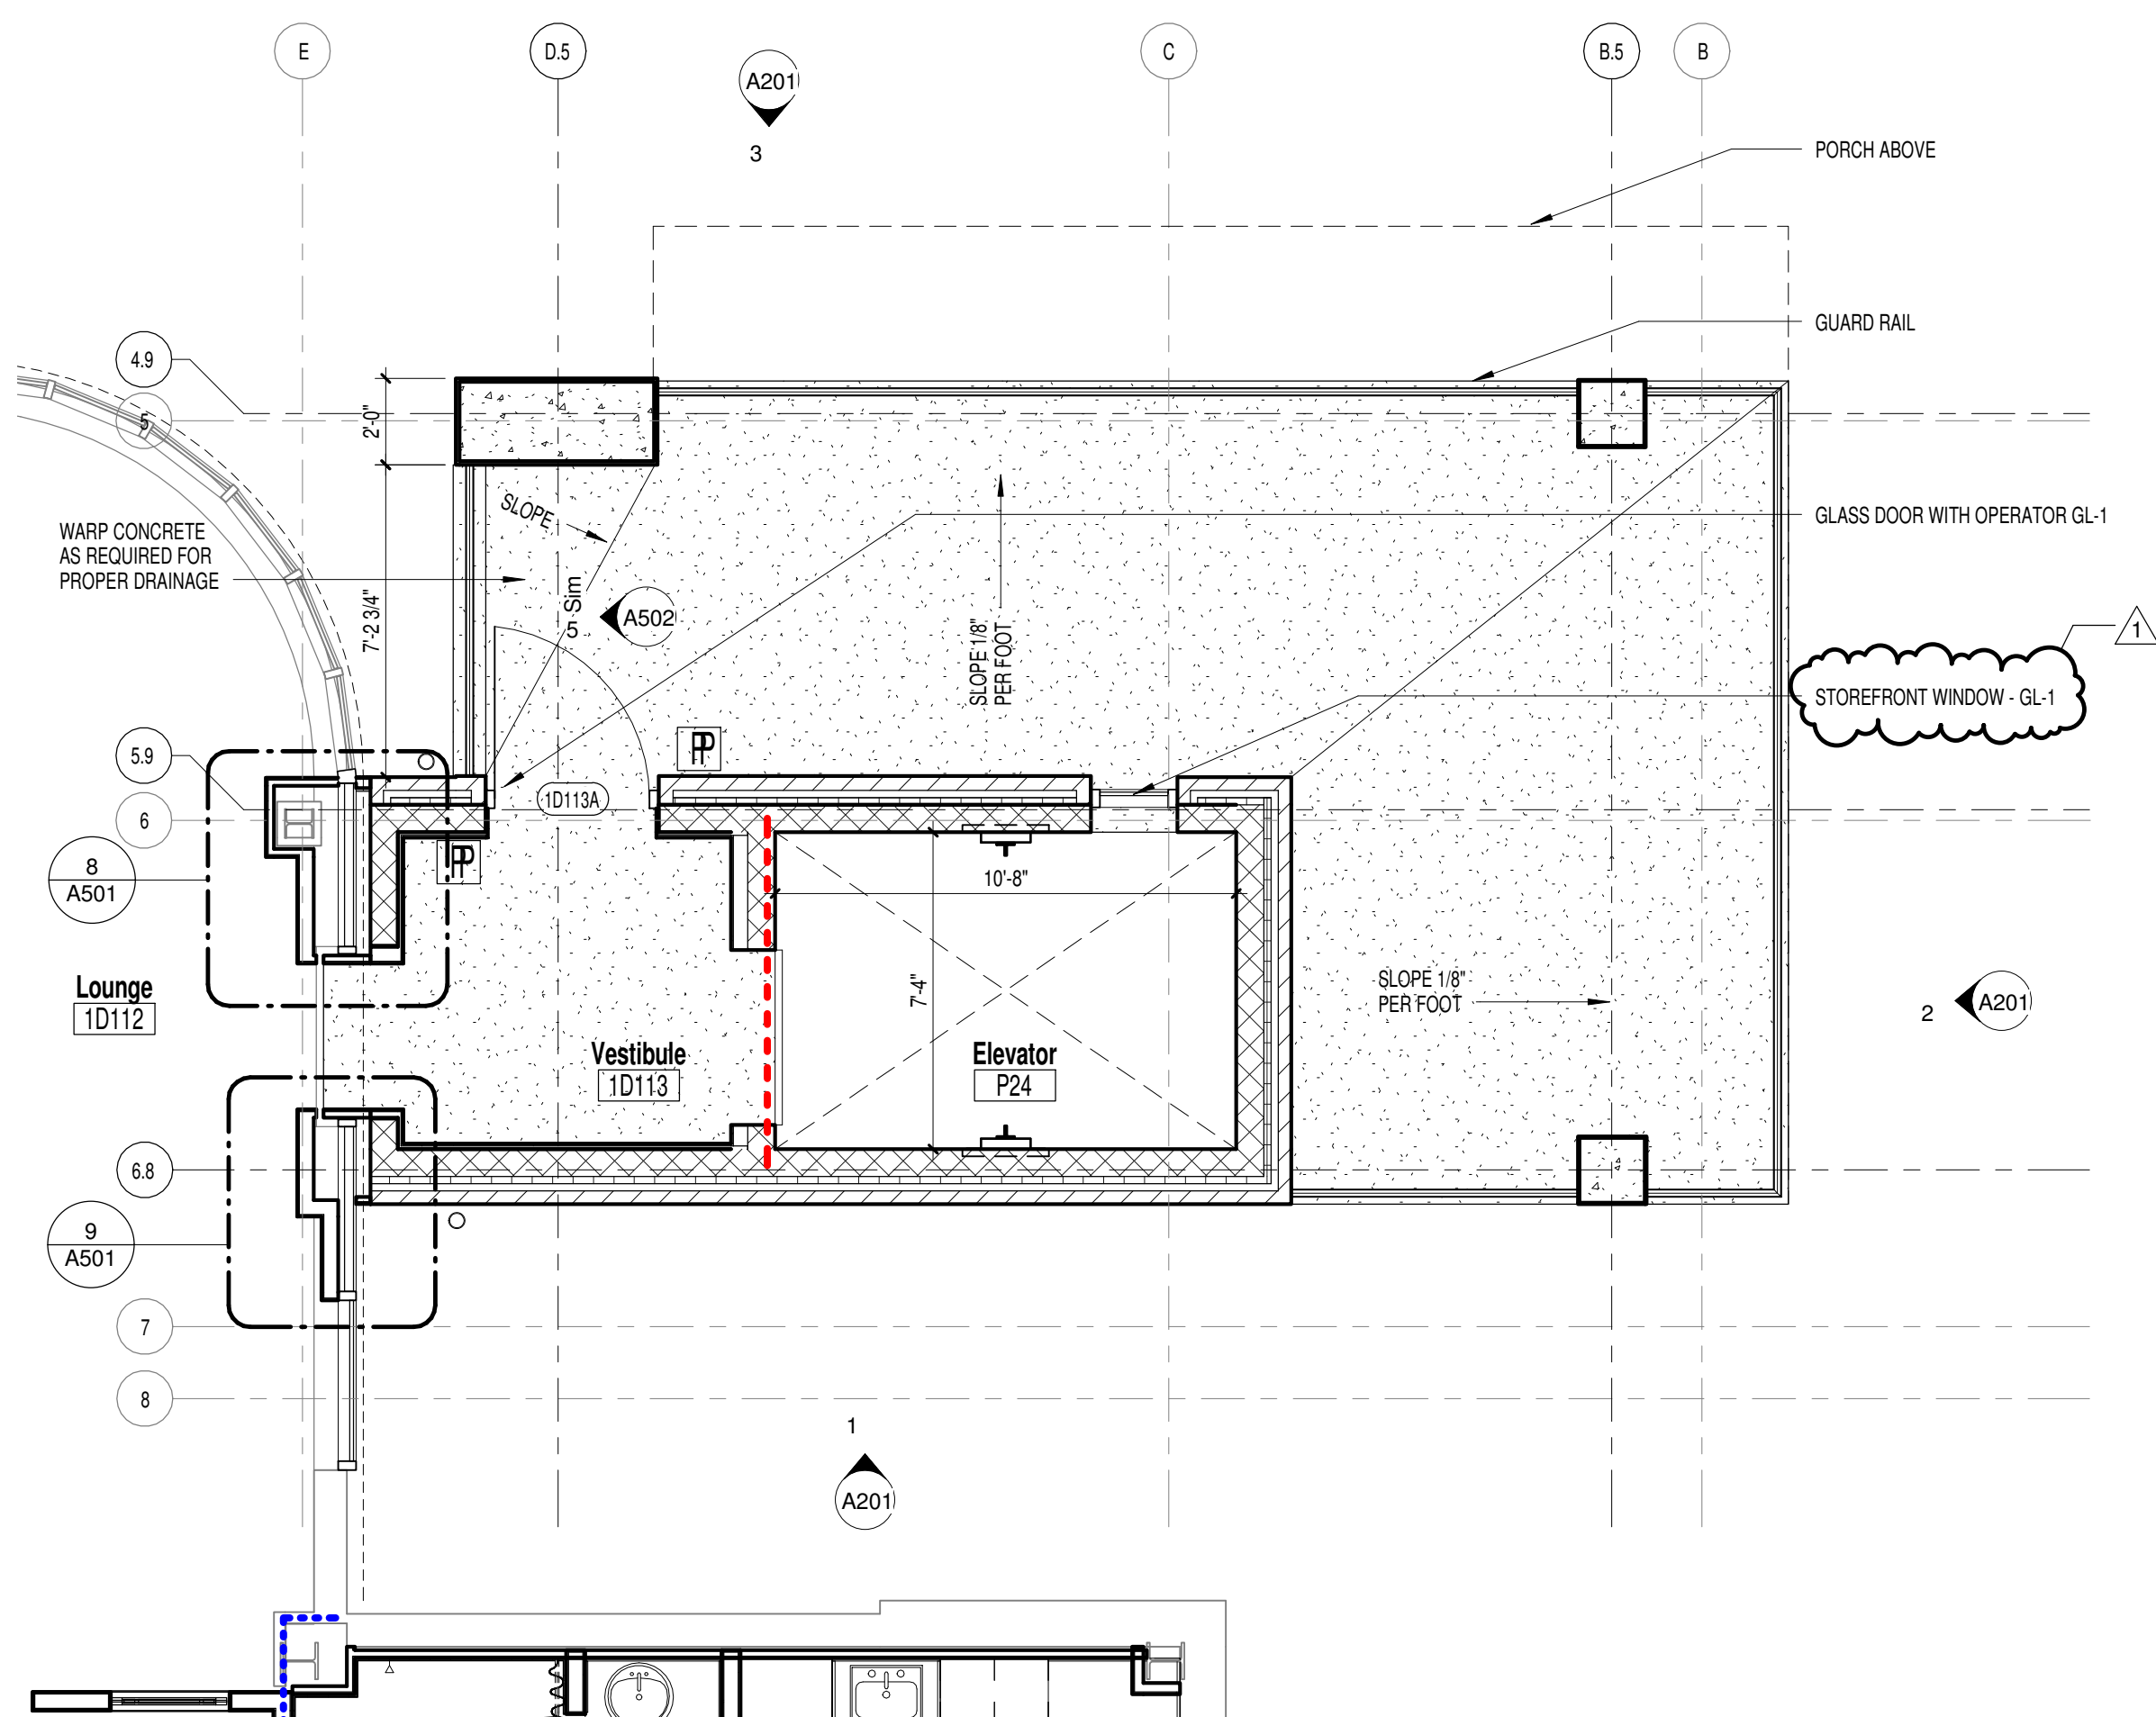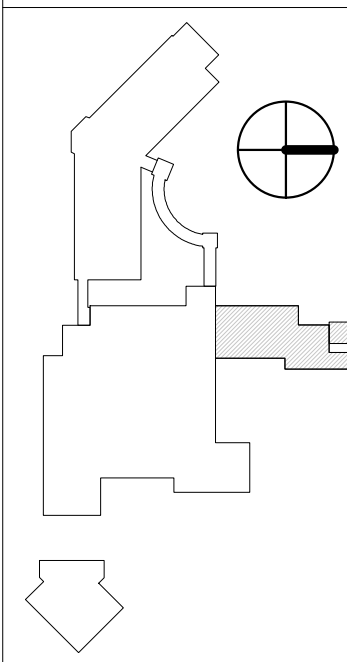


3 Enlarged Elevator Floor Plan - First Floor
1/4" = 1'-0"

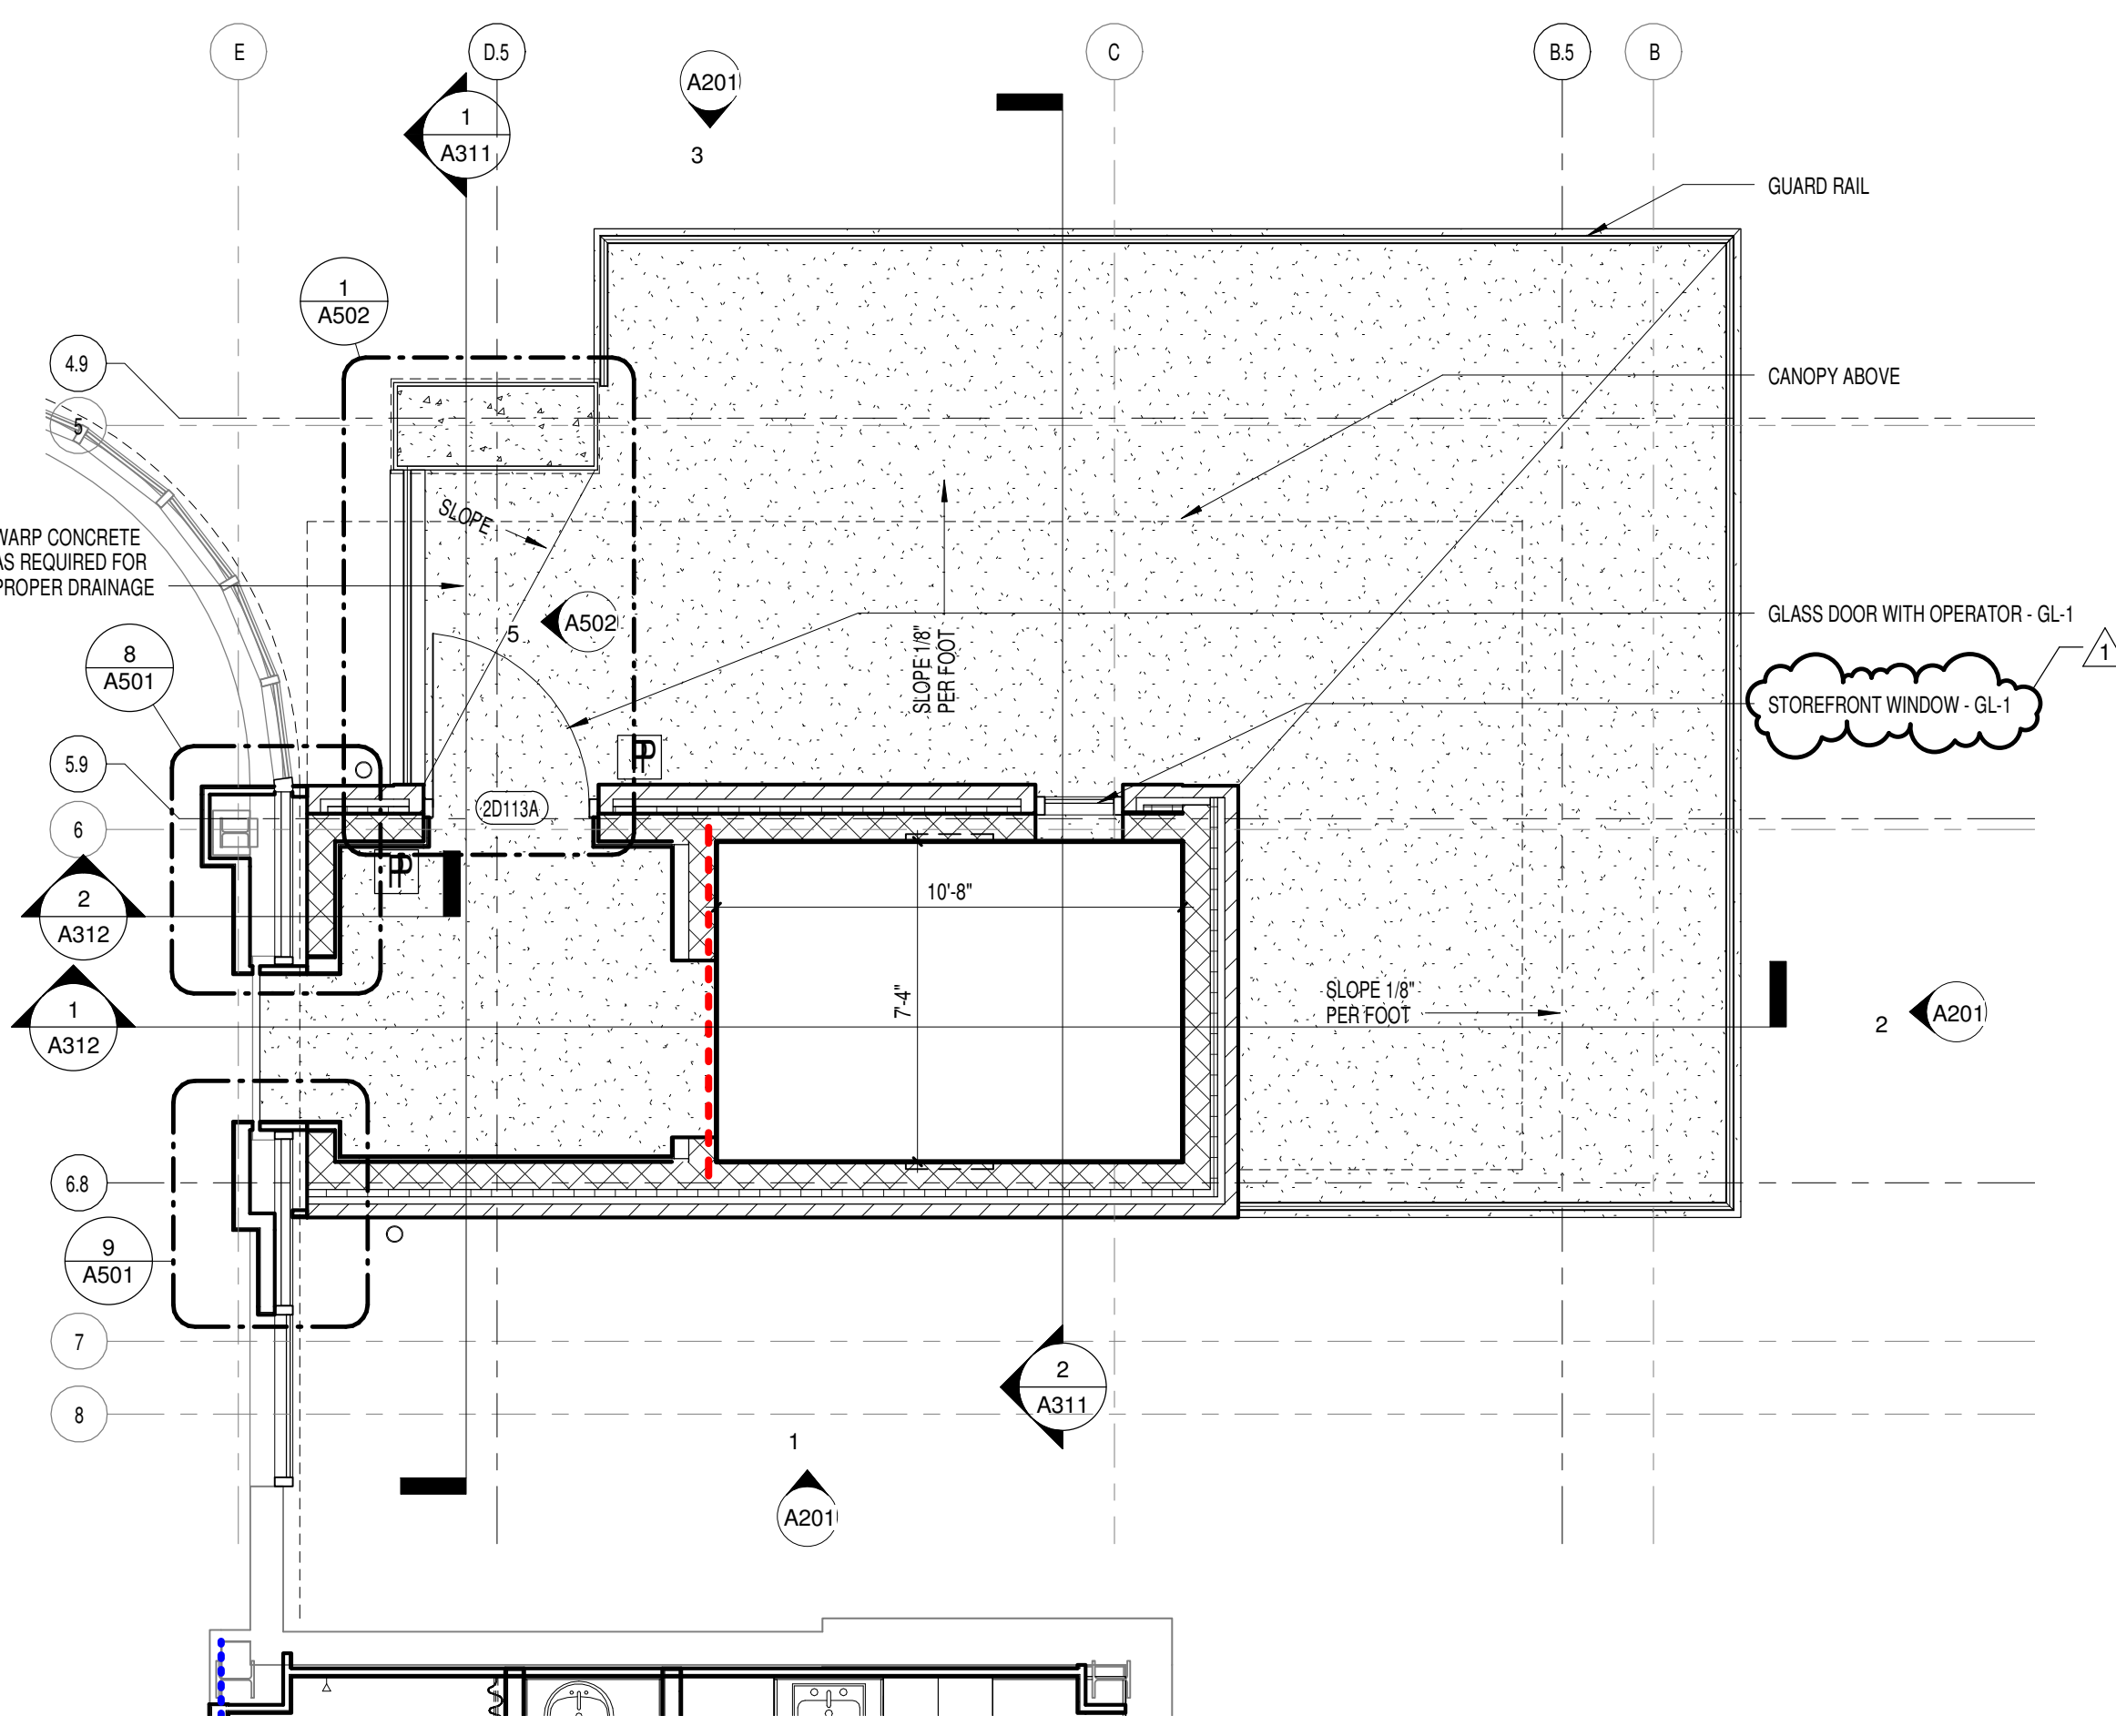

4 Enlarged Elevator Floor Plan - Second Floor
1/4" = 1'-0"

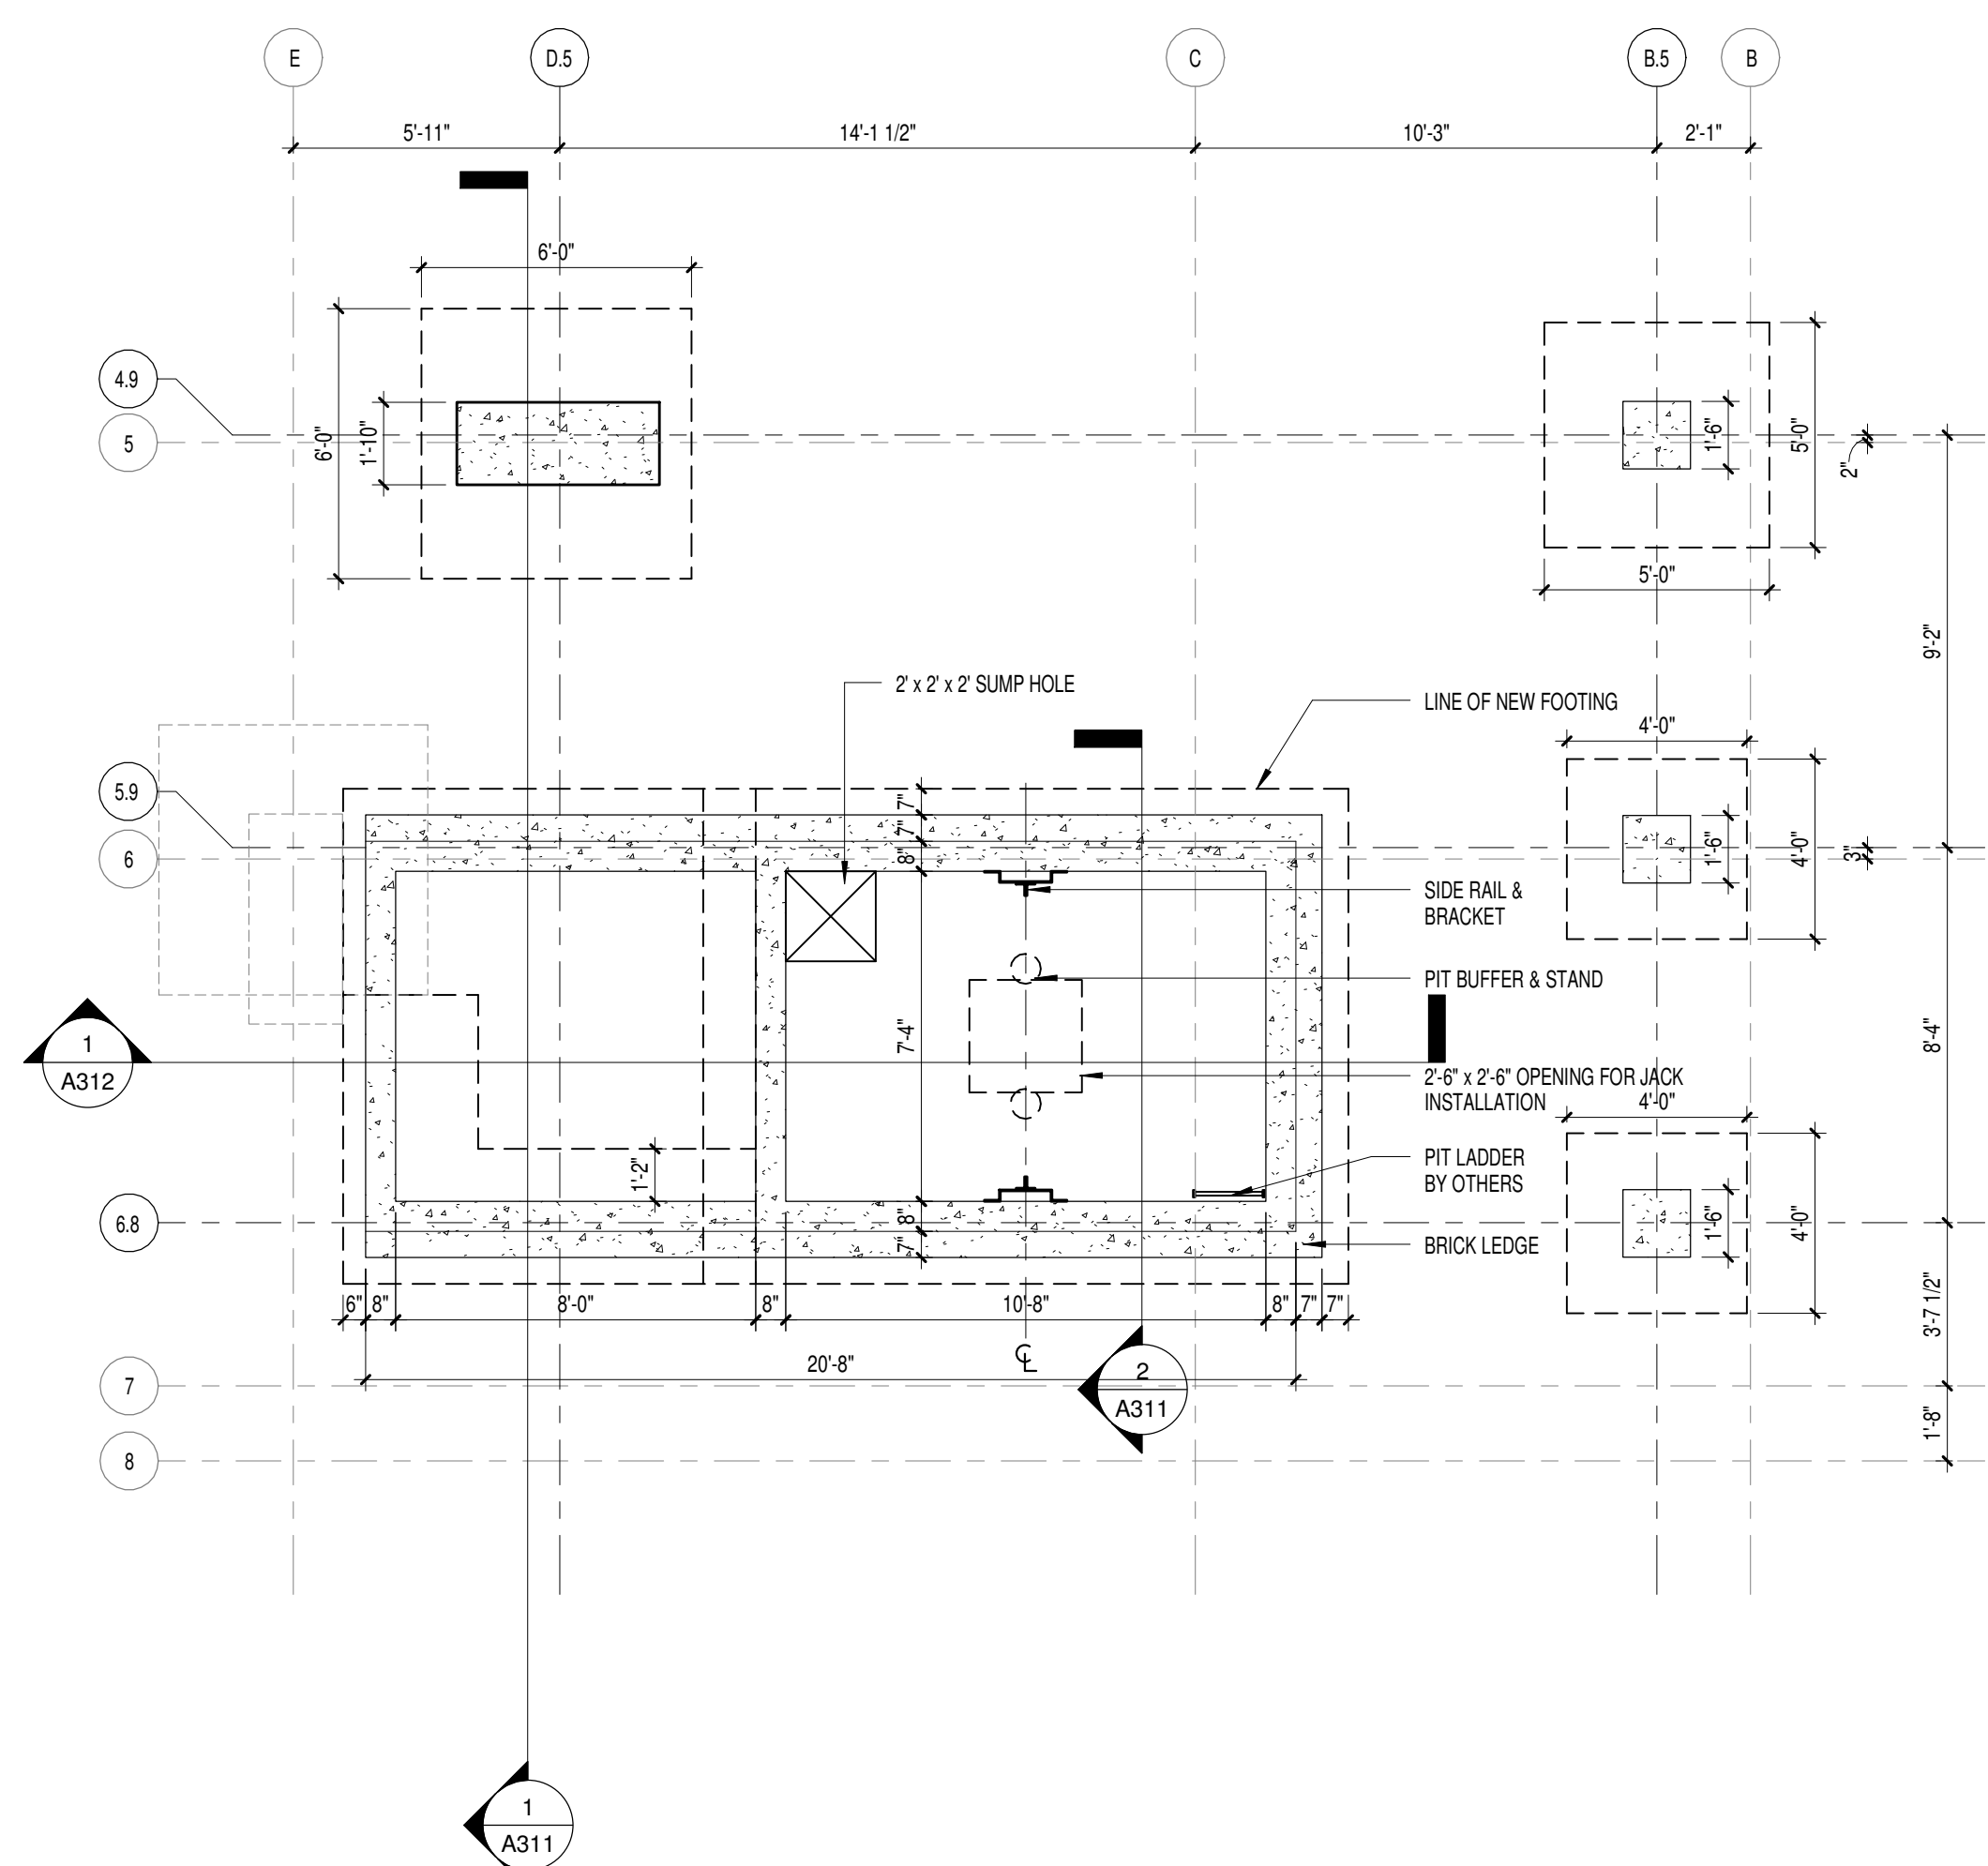

1 Elevator Pit
1/4" = 1'-0"

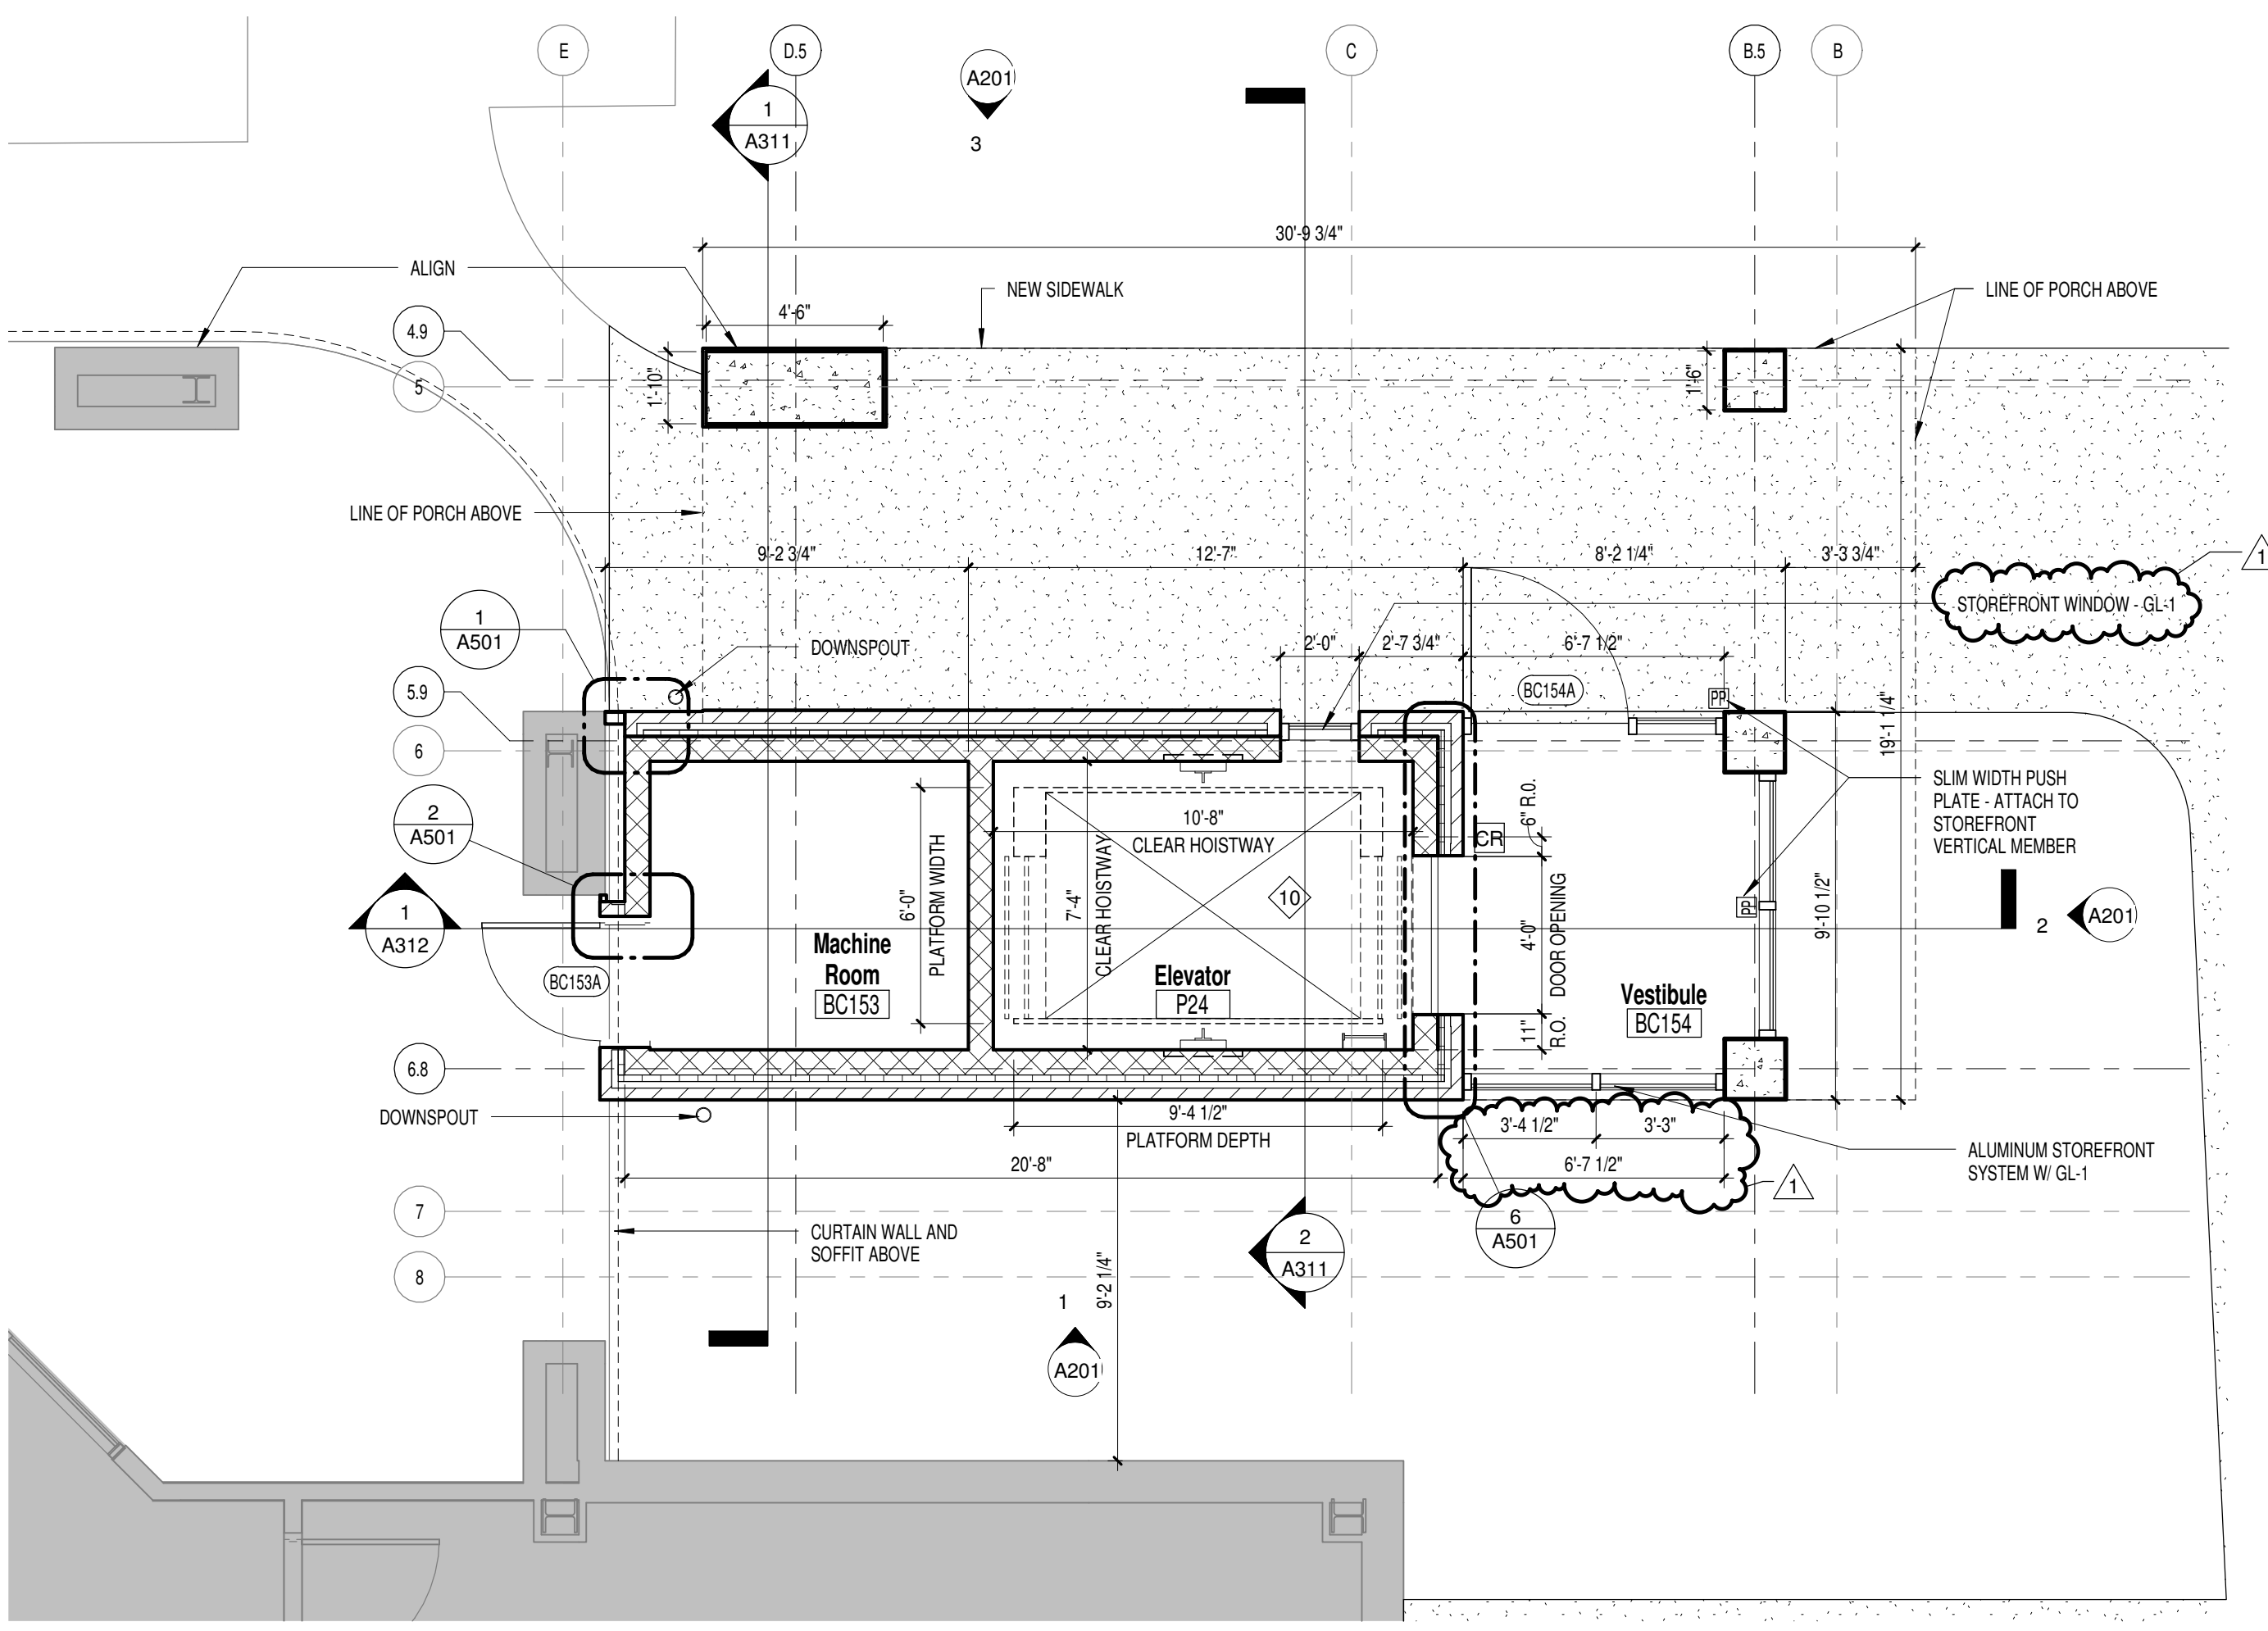

2 Enlarged Elevator Floor Plan - Ground Floor
1/4" = 1'-0"

**NOTE: CONTRACTOR TO FIELD
VERIFY ALL DIMENSIONS, MATERIALS,
AND OTHER EXISTING CONDITIONS.**