



Item	Date	Description
1	02/21/14	Amendment A00004

Drawn By **SLS/SP/BR/FF/ES/AB**
Checked By **FF**


Seal / Signature

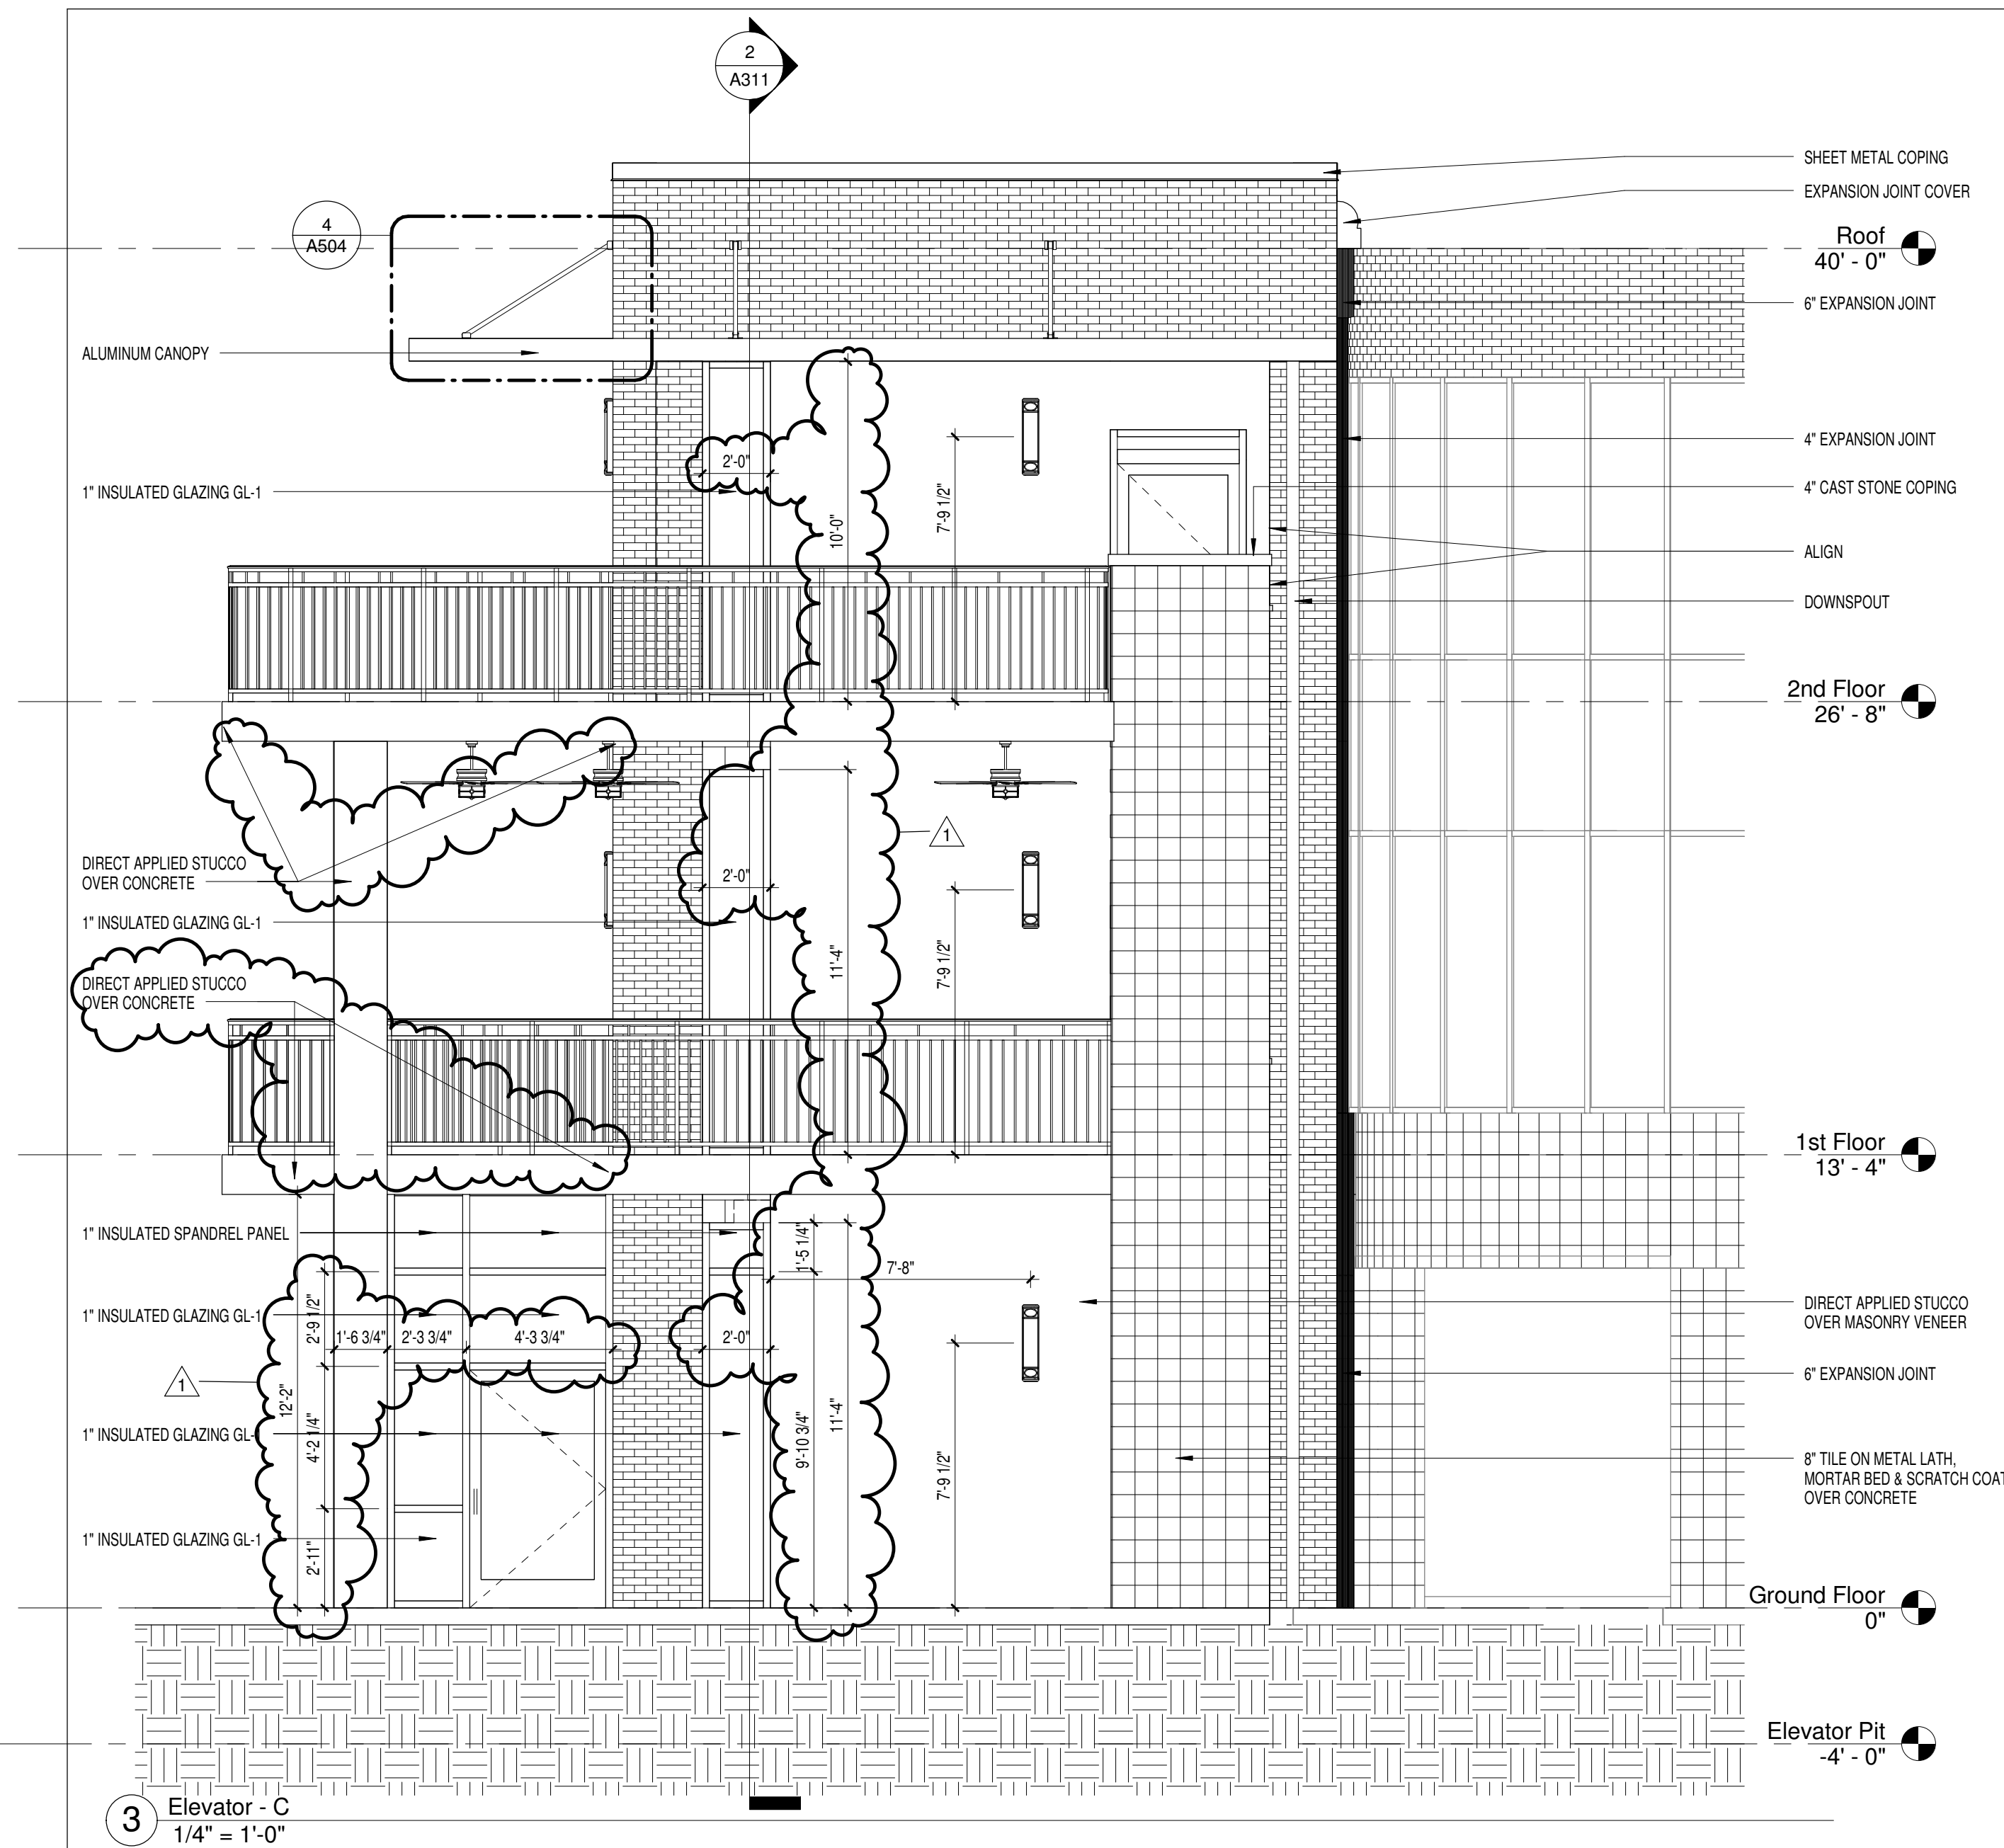


3 Elevator - C
1/4" = 1'-0"

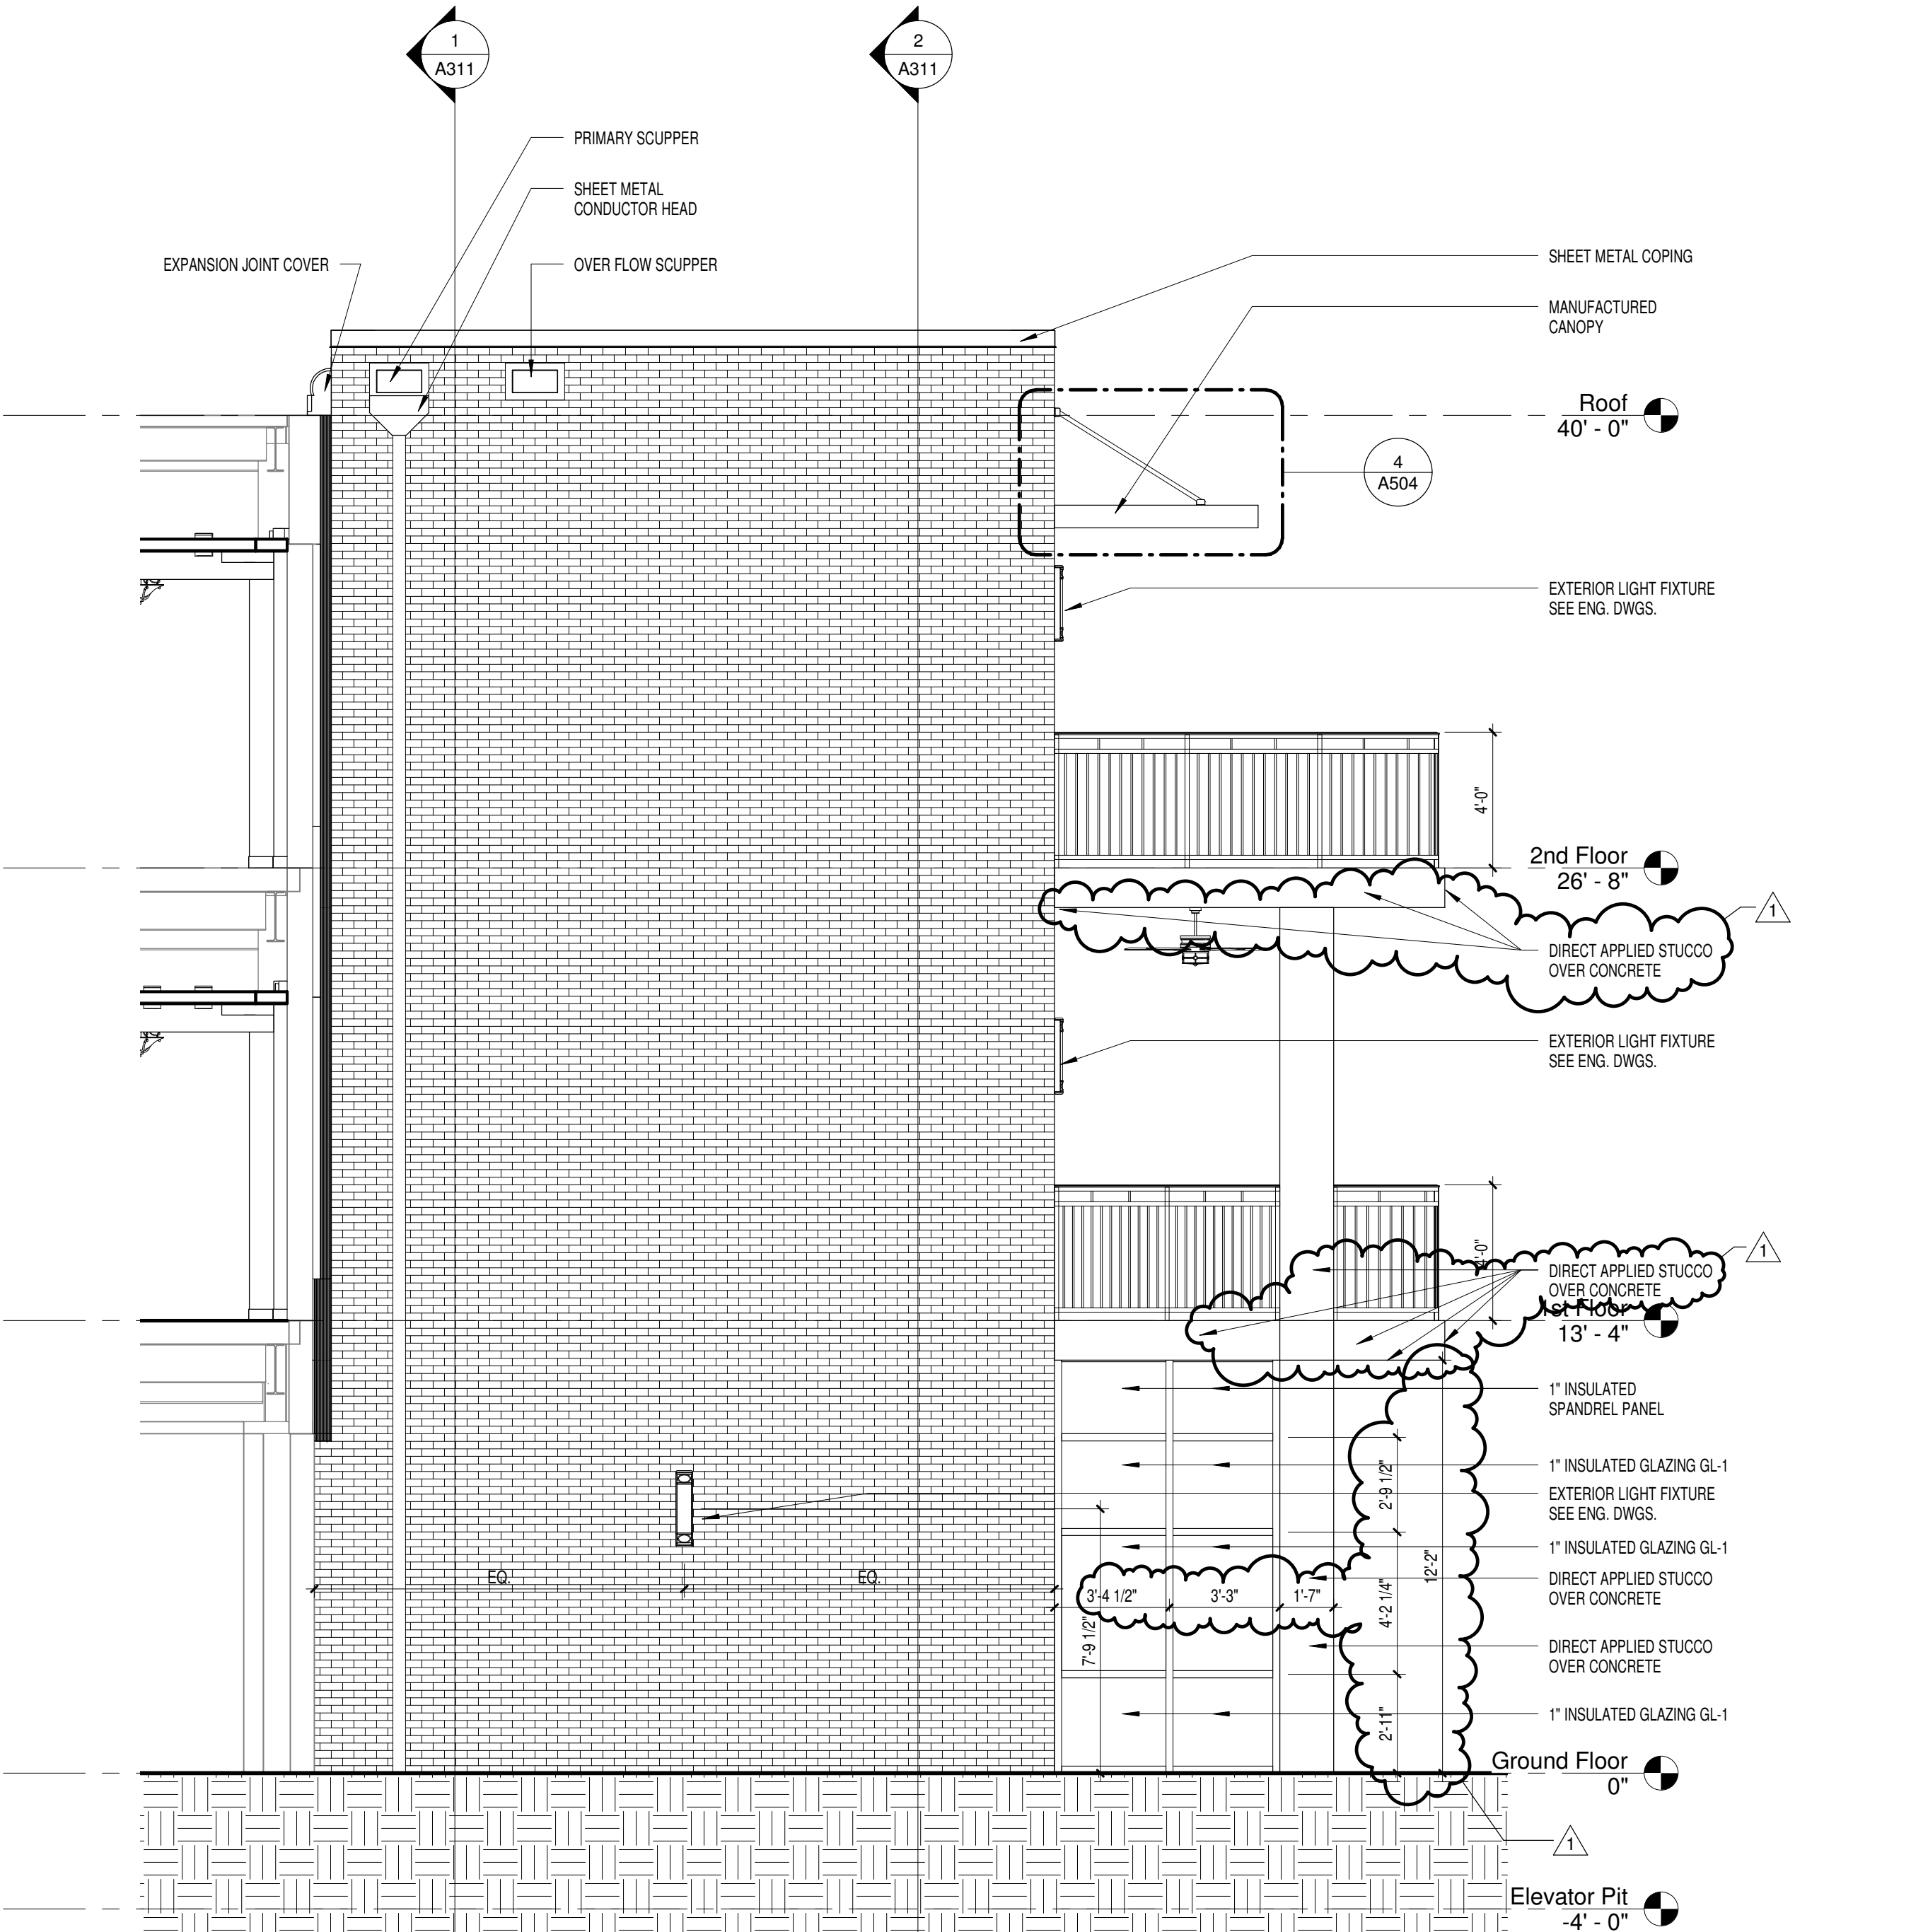

1 Elevator - A
1/4" = 1'-0"

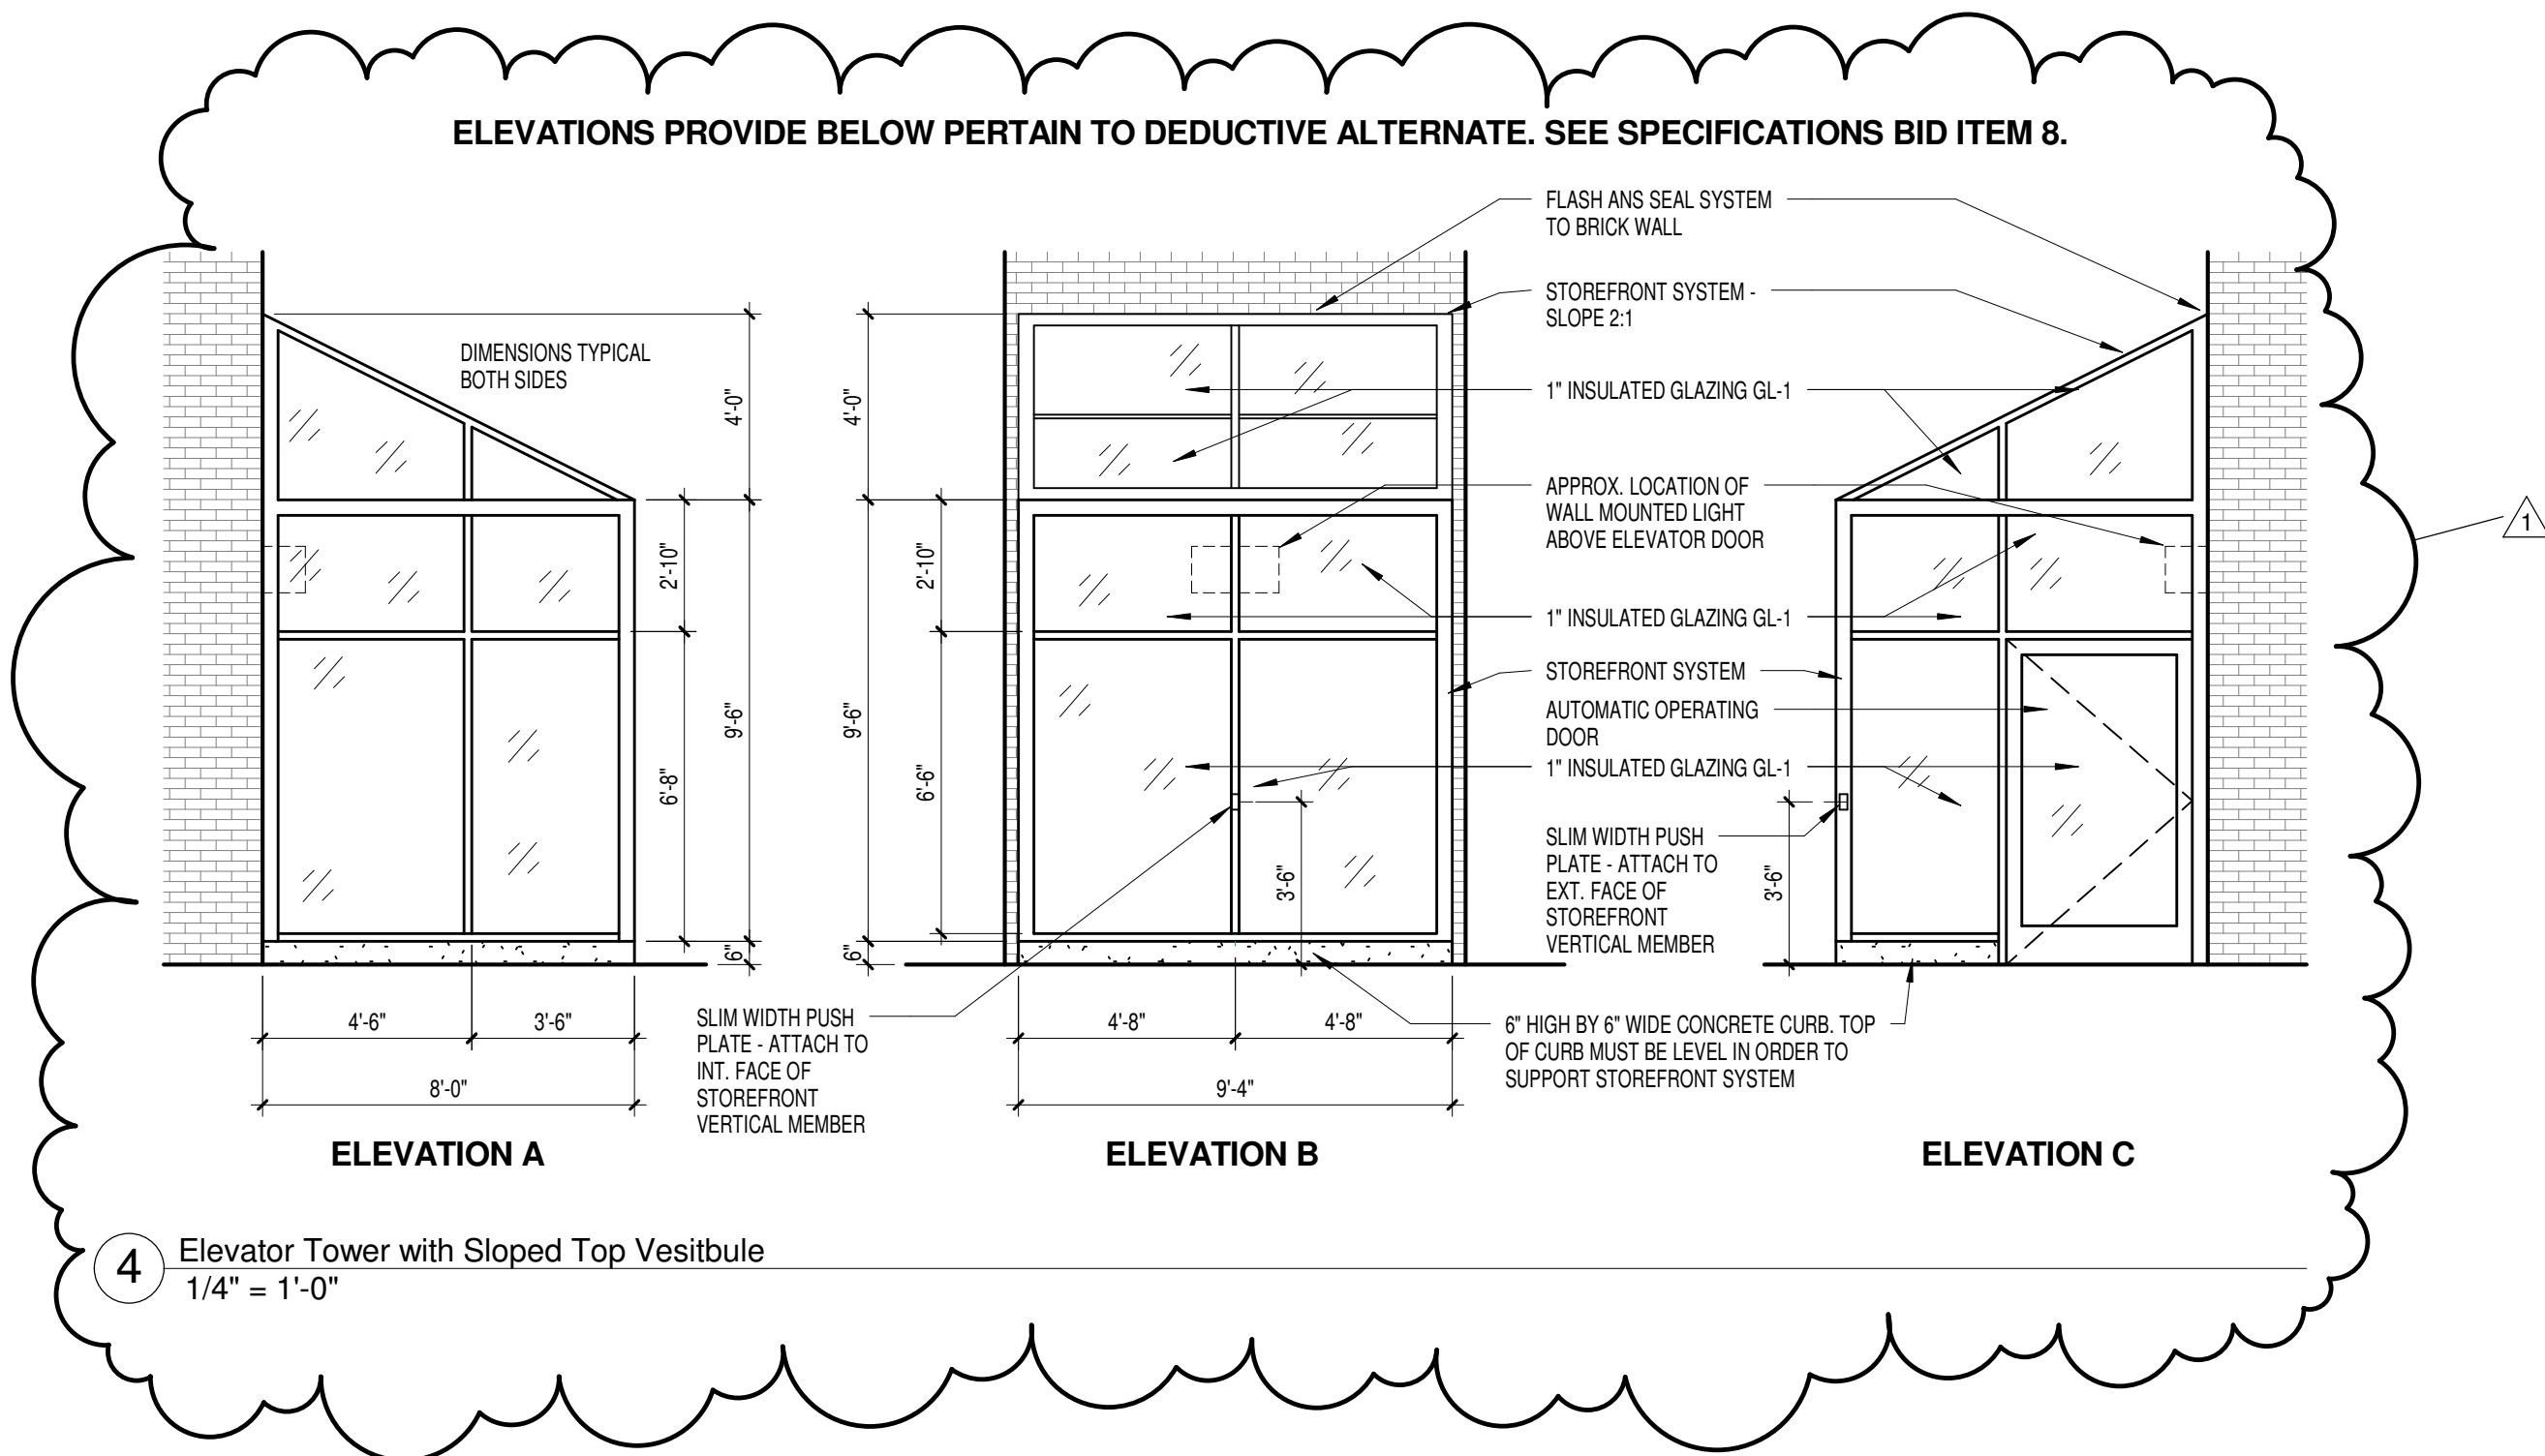

4 Elevator Tower with Sloped Top Vestibule
1/4" = 1'-0"

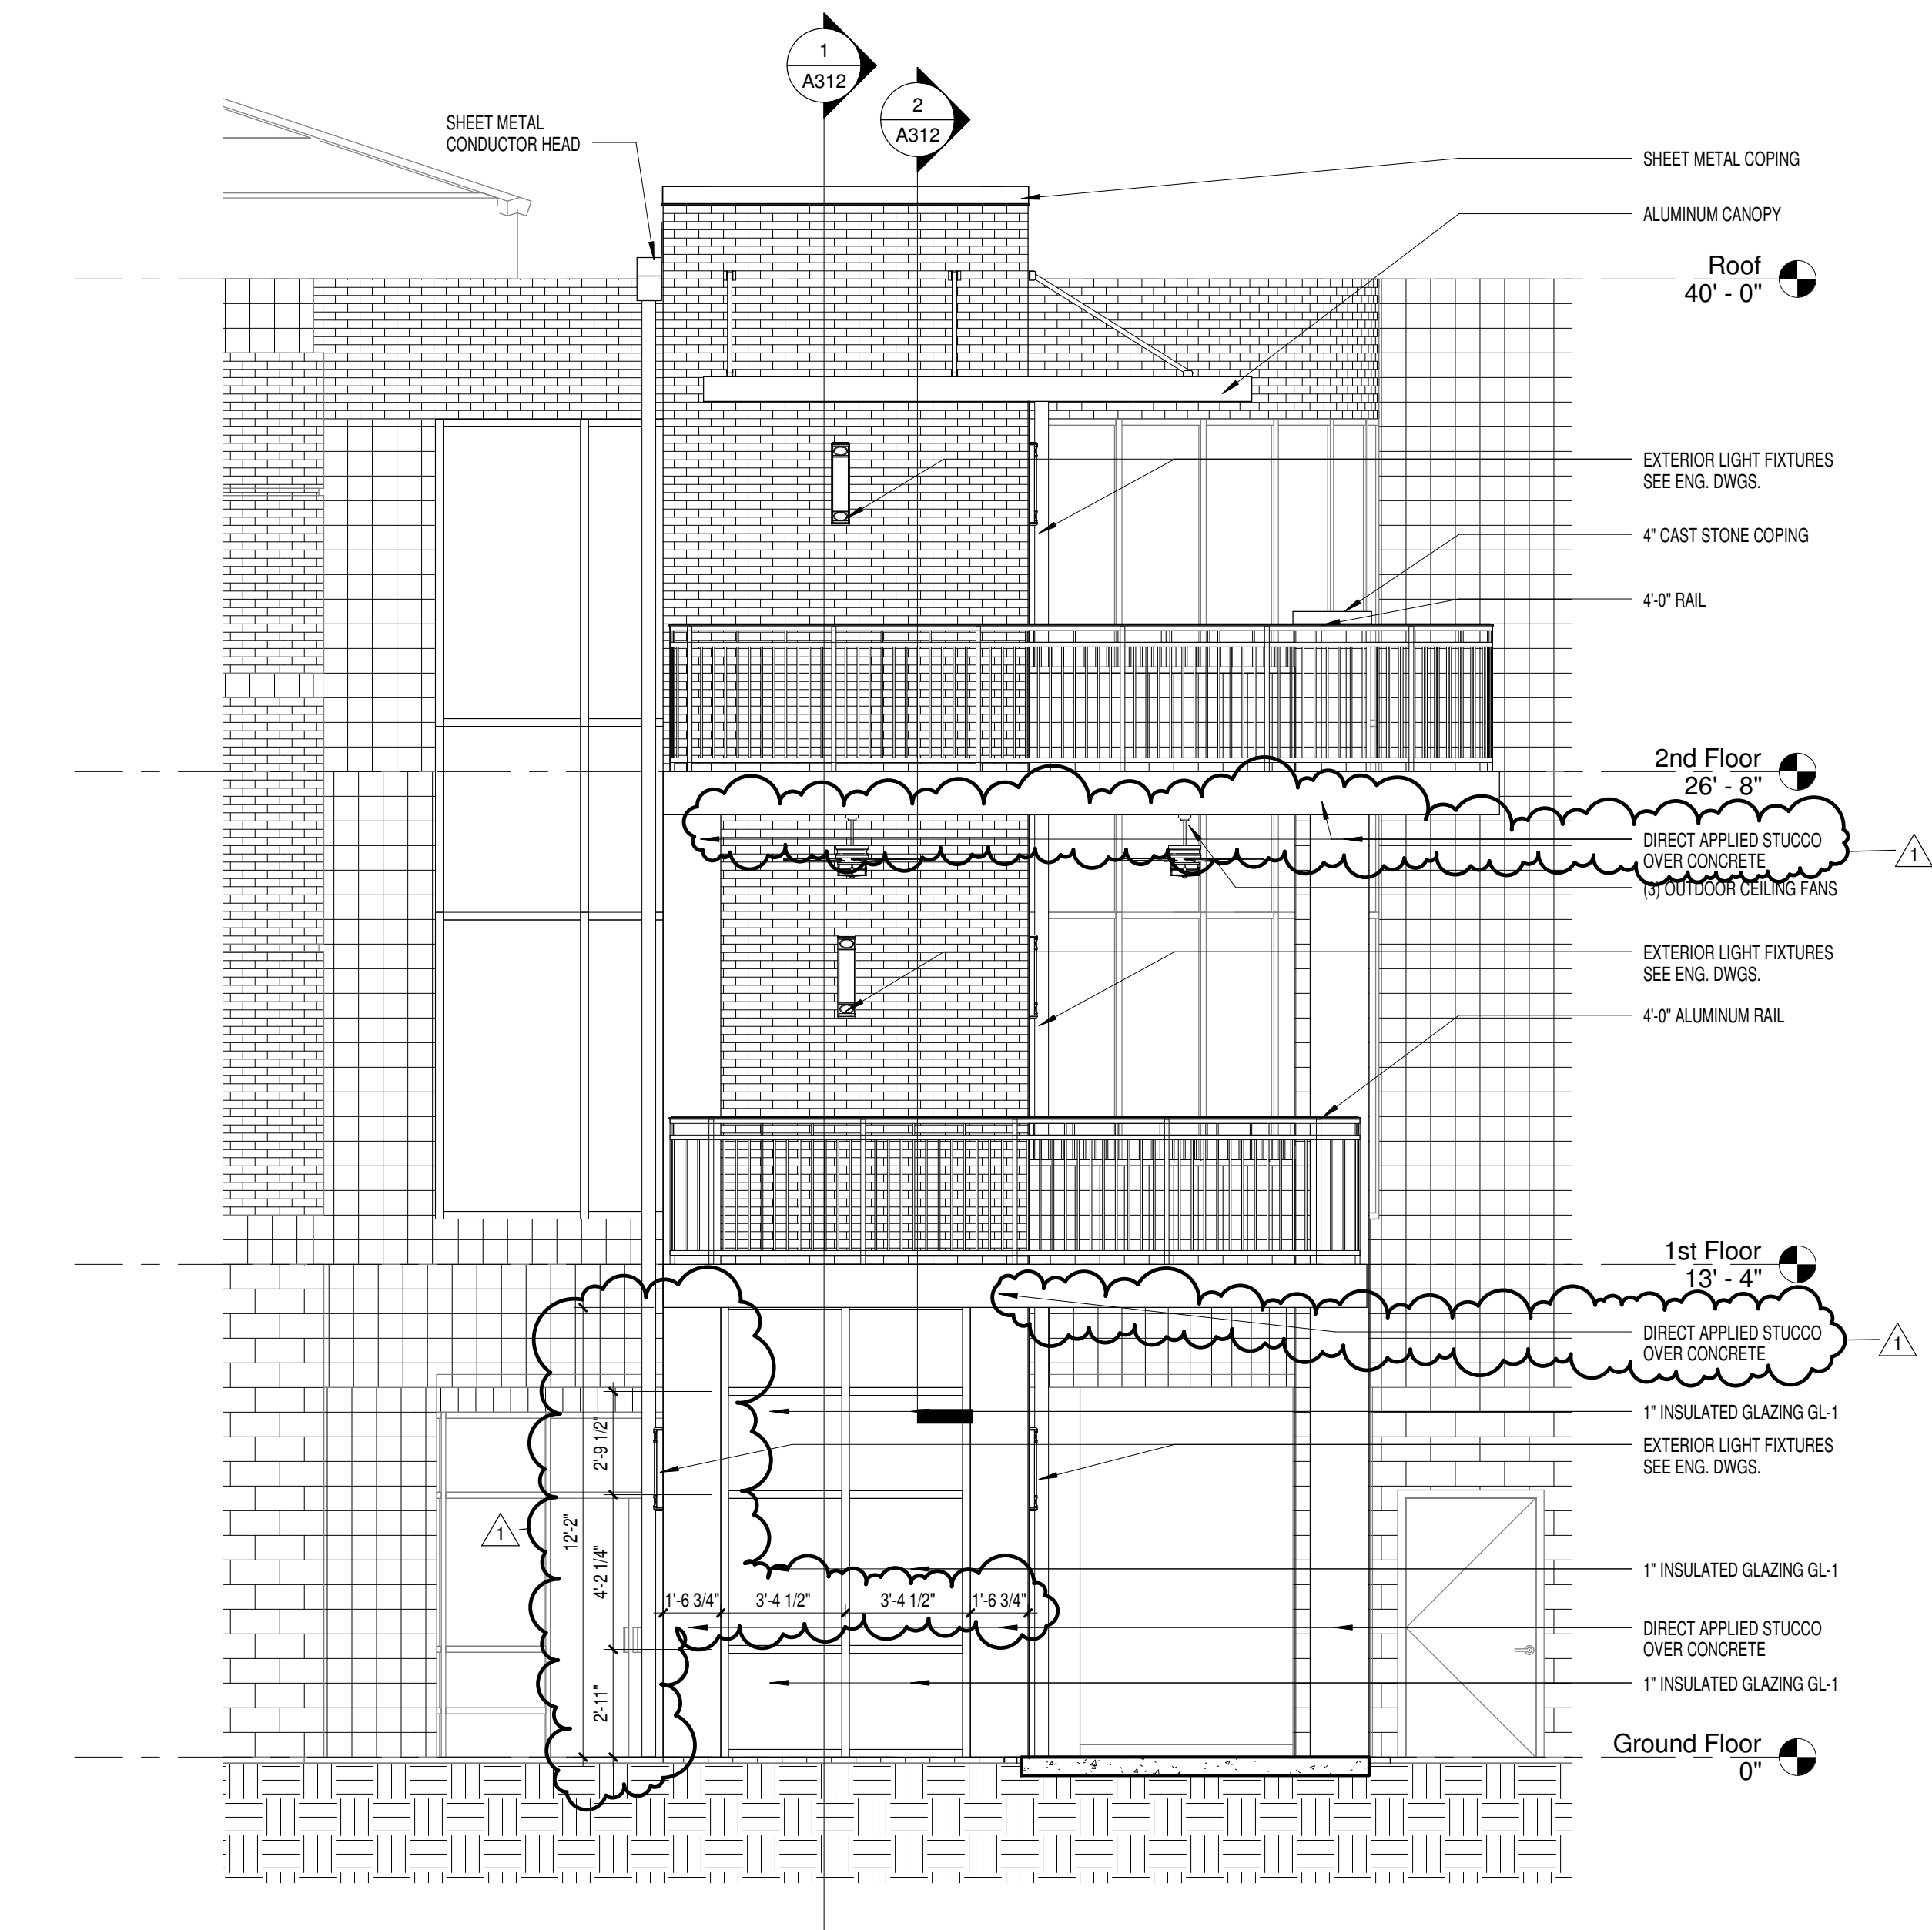

2 Elevator - B
1/4" = 1'-0"