



5960 Fairview Road
Suite 500
Charlotte, NC 28210

704
887.3500
887.3507 fax

Consultants

MECHANICAL/ELECTRICAL/PLUMBING/FIRE PROTECTION:

AME Consulting Engineers, PC
421 Pannan Street, Suite 200
Charlotte, NC 28203
704.295.4263 PHONE
704.295.7543 FAX

STRUCTURAL:

ZAPATA, Inc.
6302 Fairview Rd., Ste. 600
Charlotte, NC 28210
704.378.4923 PHONE
704.358.8342 FAX

CIVIL:

COLEJENEST & STONE, P.A.
200 South Tryon Street, Suite 1400
Charlotte, North Carolina 28202
704.376.1555 PHONE
704.376.7851 FAX

Project

**VAMC Salisbury
Building 42 Additions &
Renovation - Phase III**

City, State
Salisbury, NC

VA Project Number
659-335

Issued For

Construction

Item	Date	Description
1	02/21/14	Amendment A00004

Drawn By SLS/SP/BR/FF/ES/AB
Checked By FF

Seal / Signature




Sheet Title

**Enlarged Elevator
Section and Details**


Date December 21, 2012

Sheet Number

A311

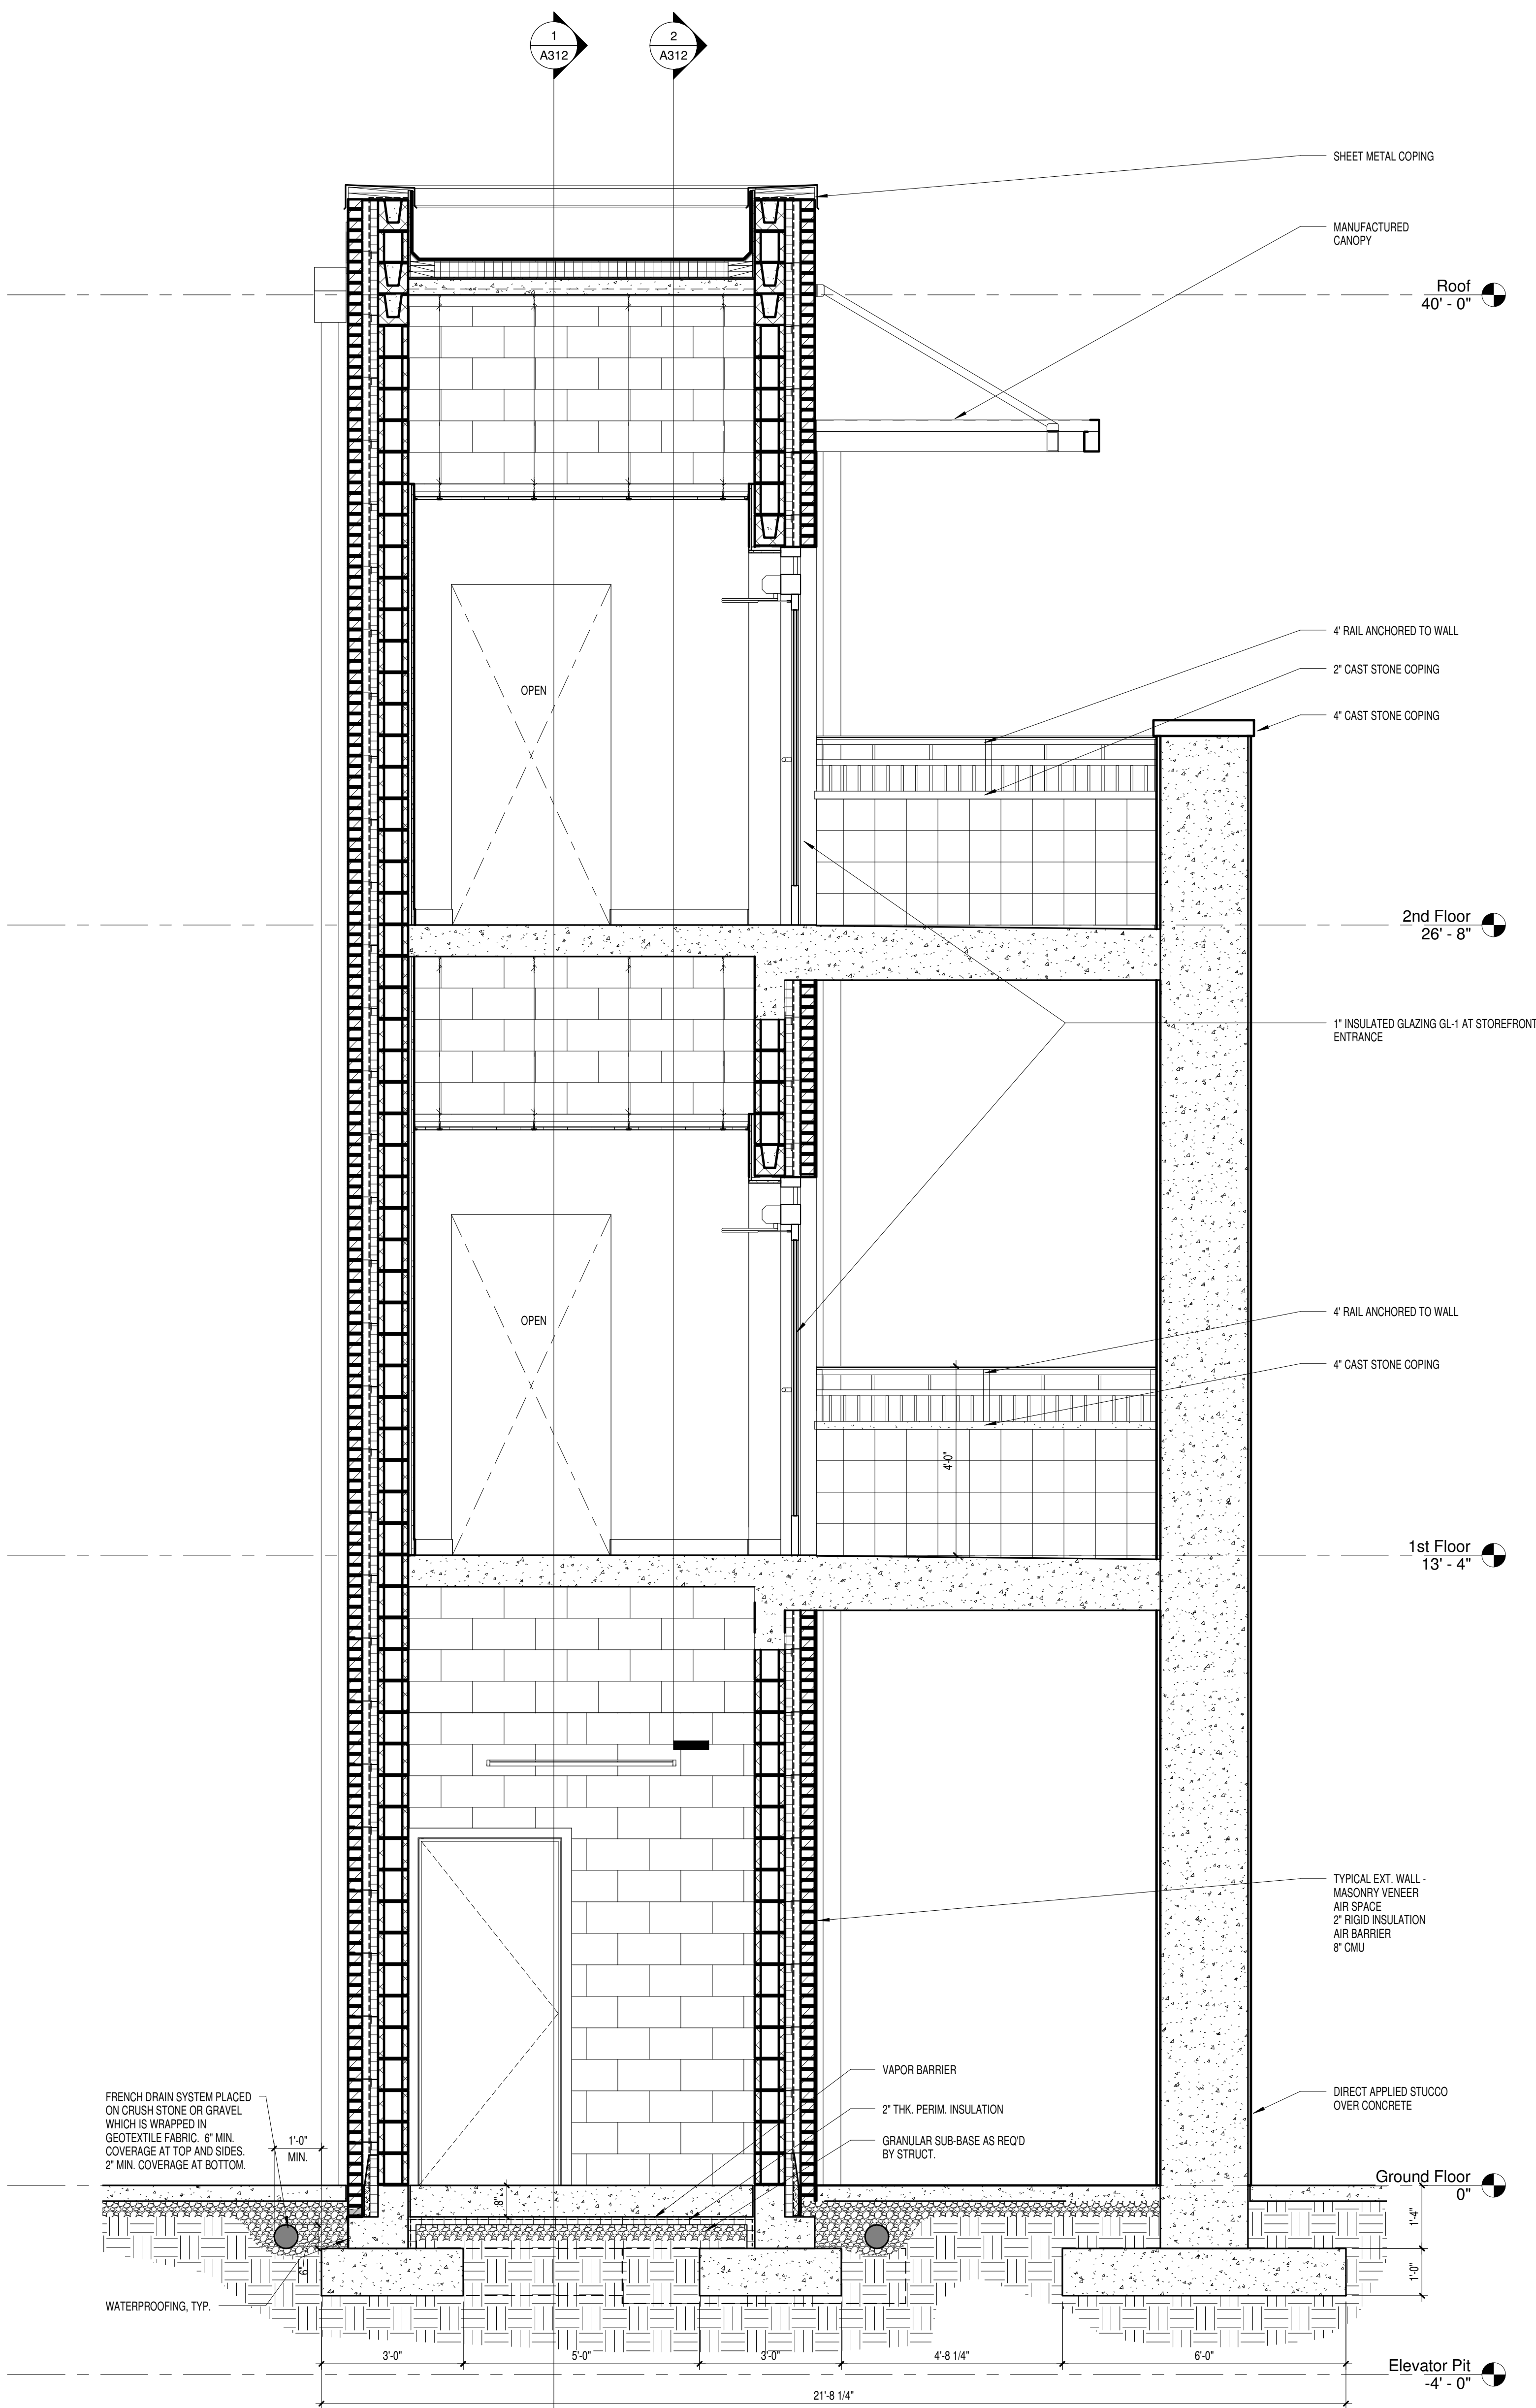

1 Elevator Section 2
1/2" = 1'-0"

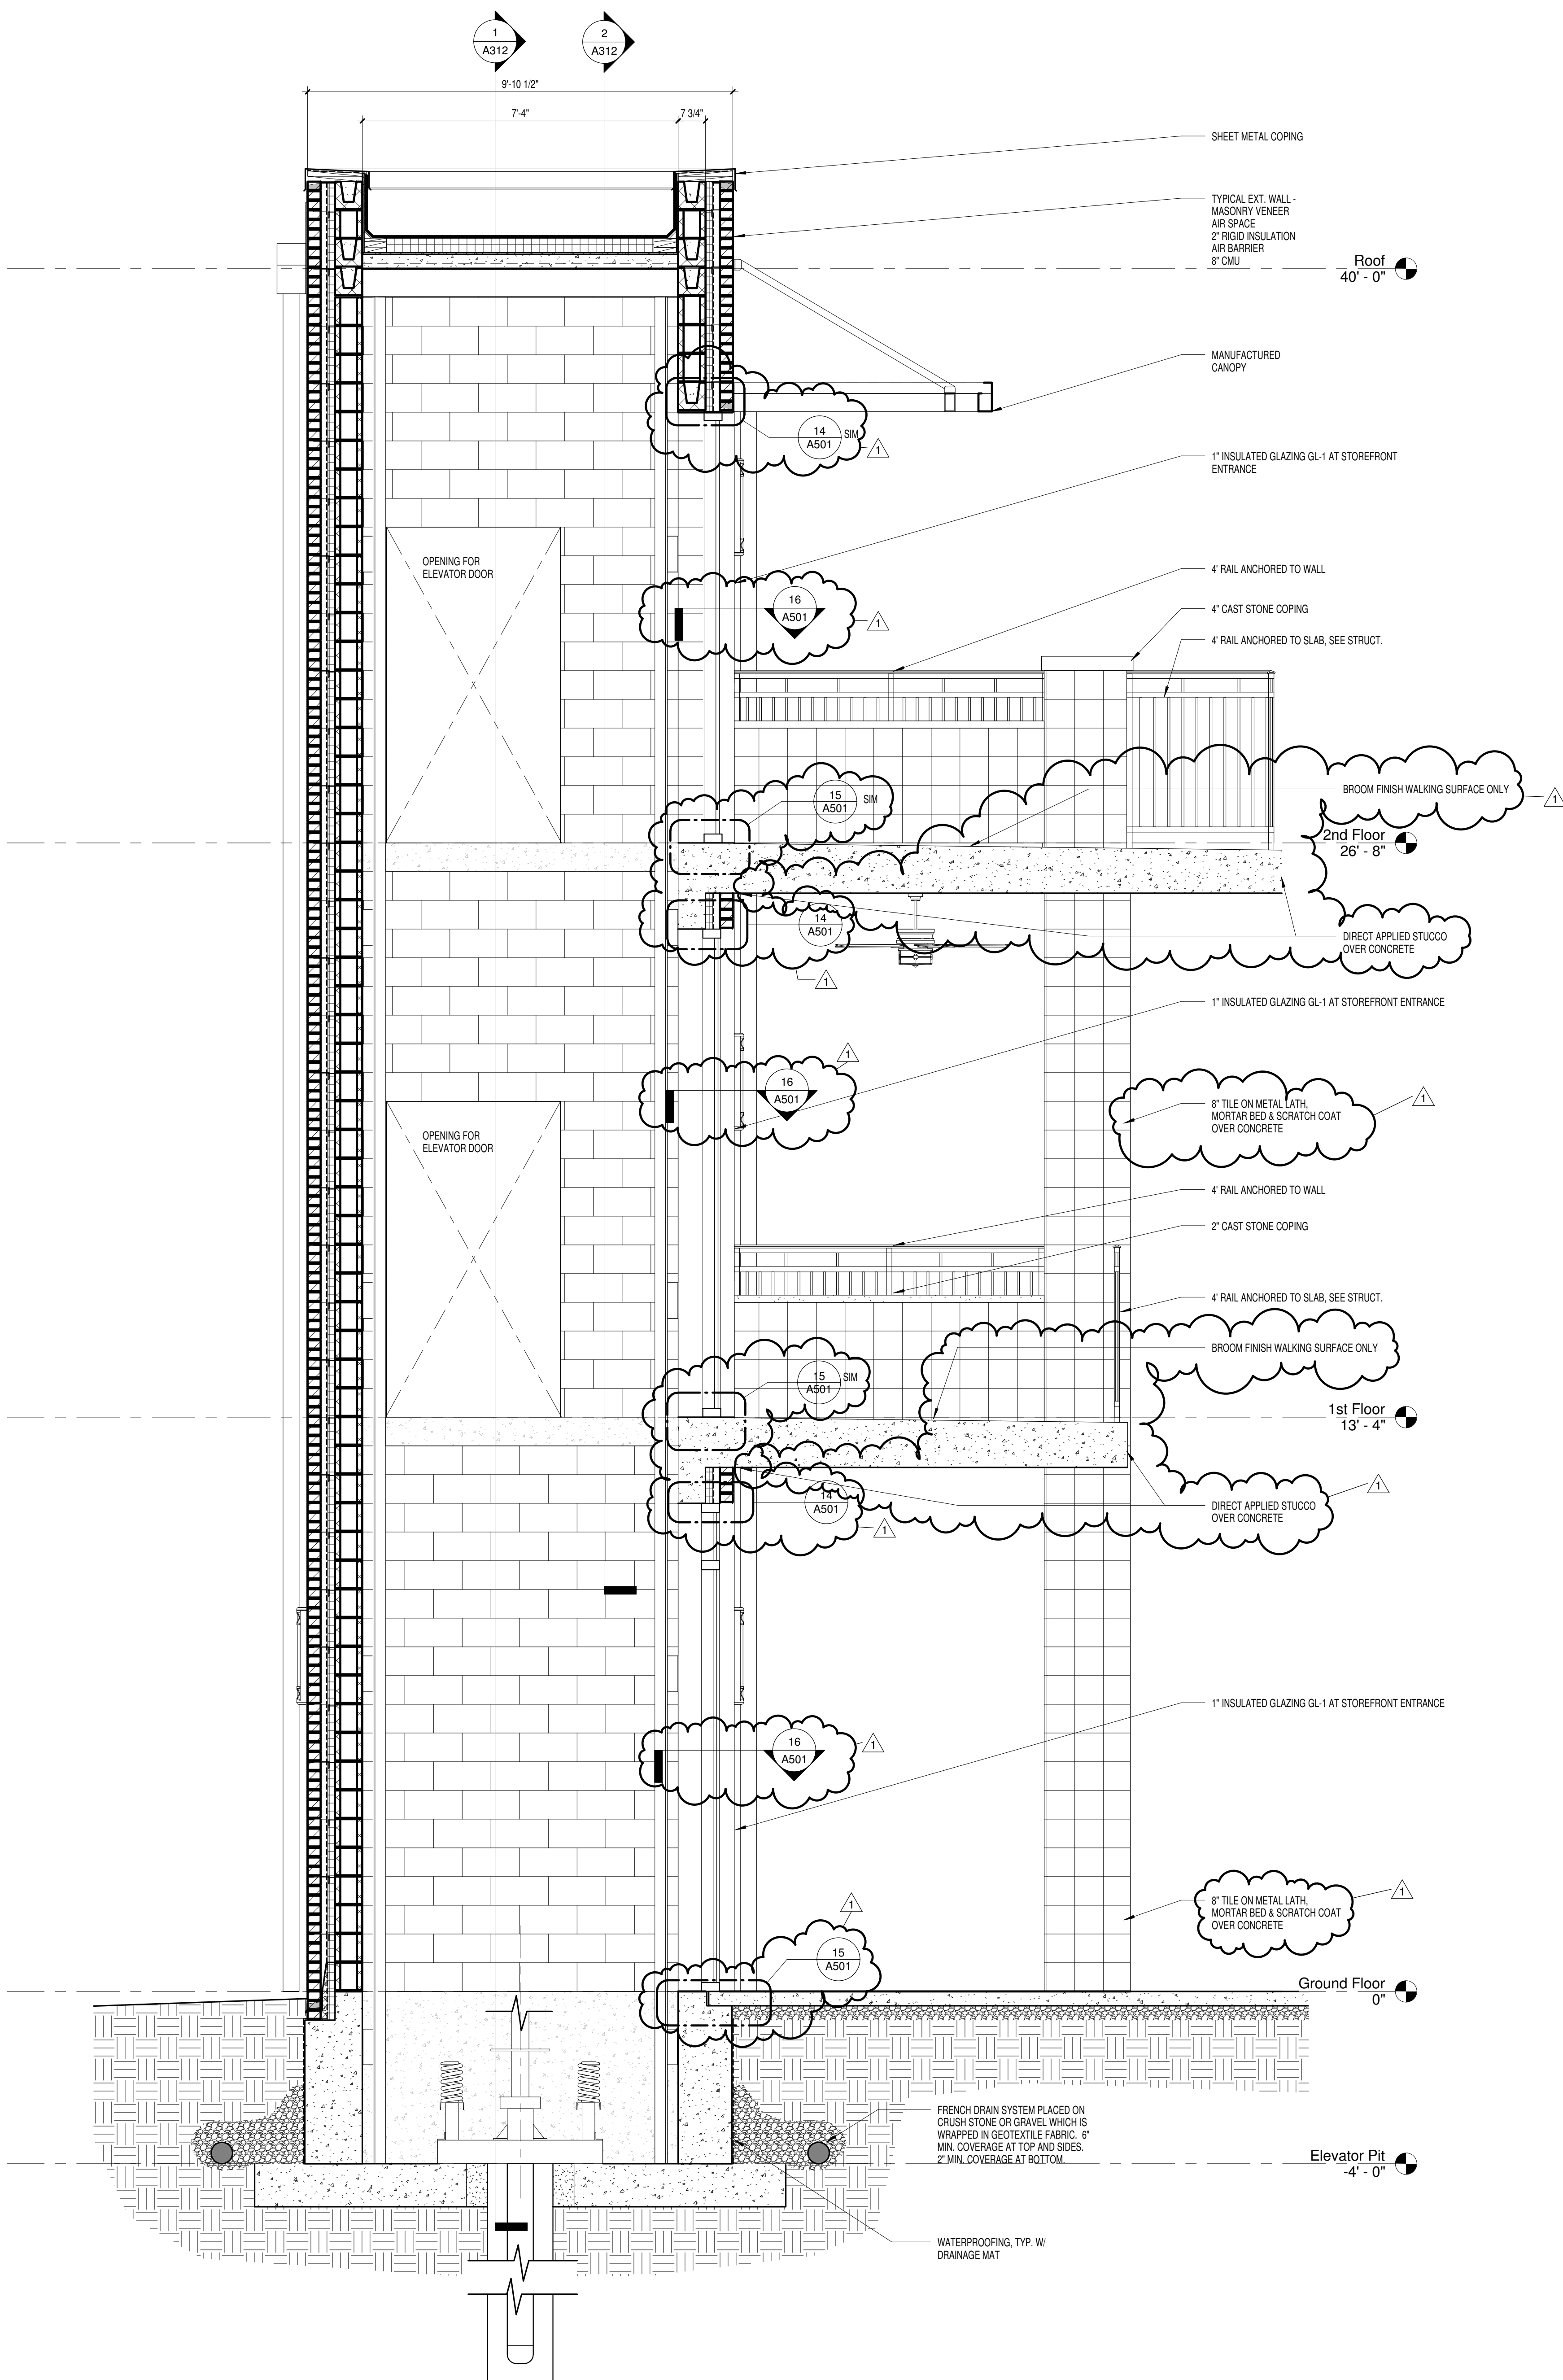

2 Elevator Section 3
1/2" = 1'-0"