


- GENERAL NOTES:
1. SEE SITE PLAN FOR FINISH GRADE ELEVATIONS
  2. SEE STRUCTURAL DRAWINGS FOR STRUCTURAL STEEL FRAMING.
  3. SPRAY ON FIREPROOFING SHOWN ON LARGER SECTIONS.

1B SECTION THRU EXTRACTOR SPACE

3C SECTION THRU LOADING DOCK

2F SECTION THRU REFUSE ROOM

4F SECTION THRU REFUSE ROOM

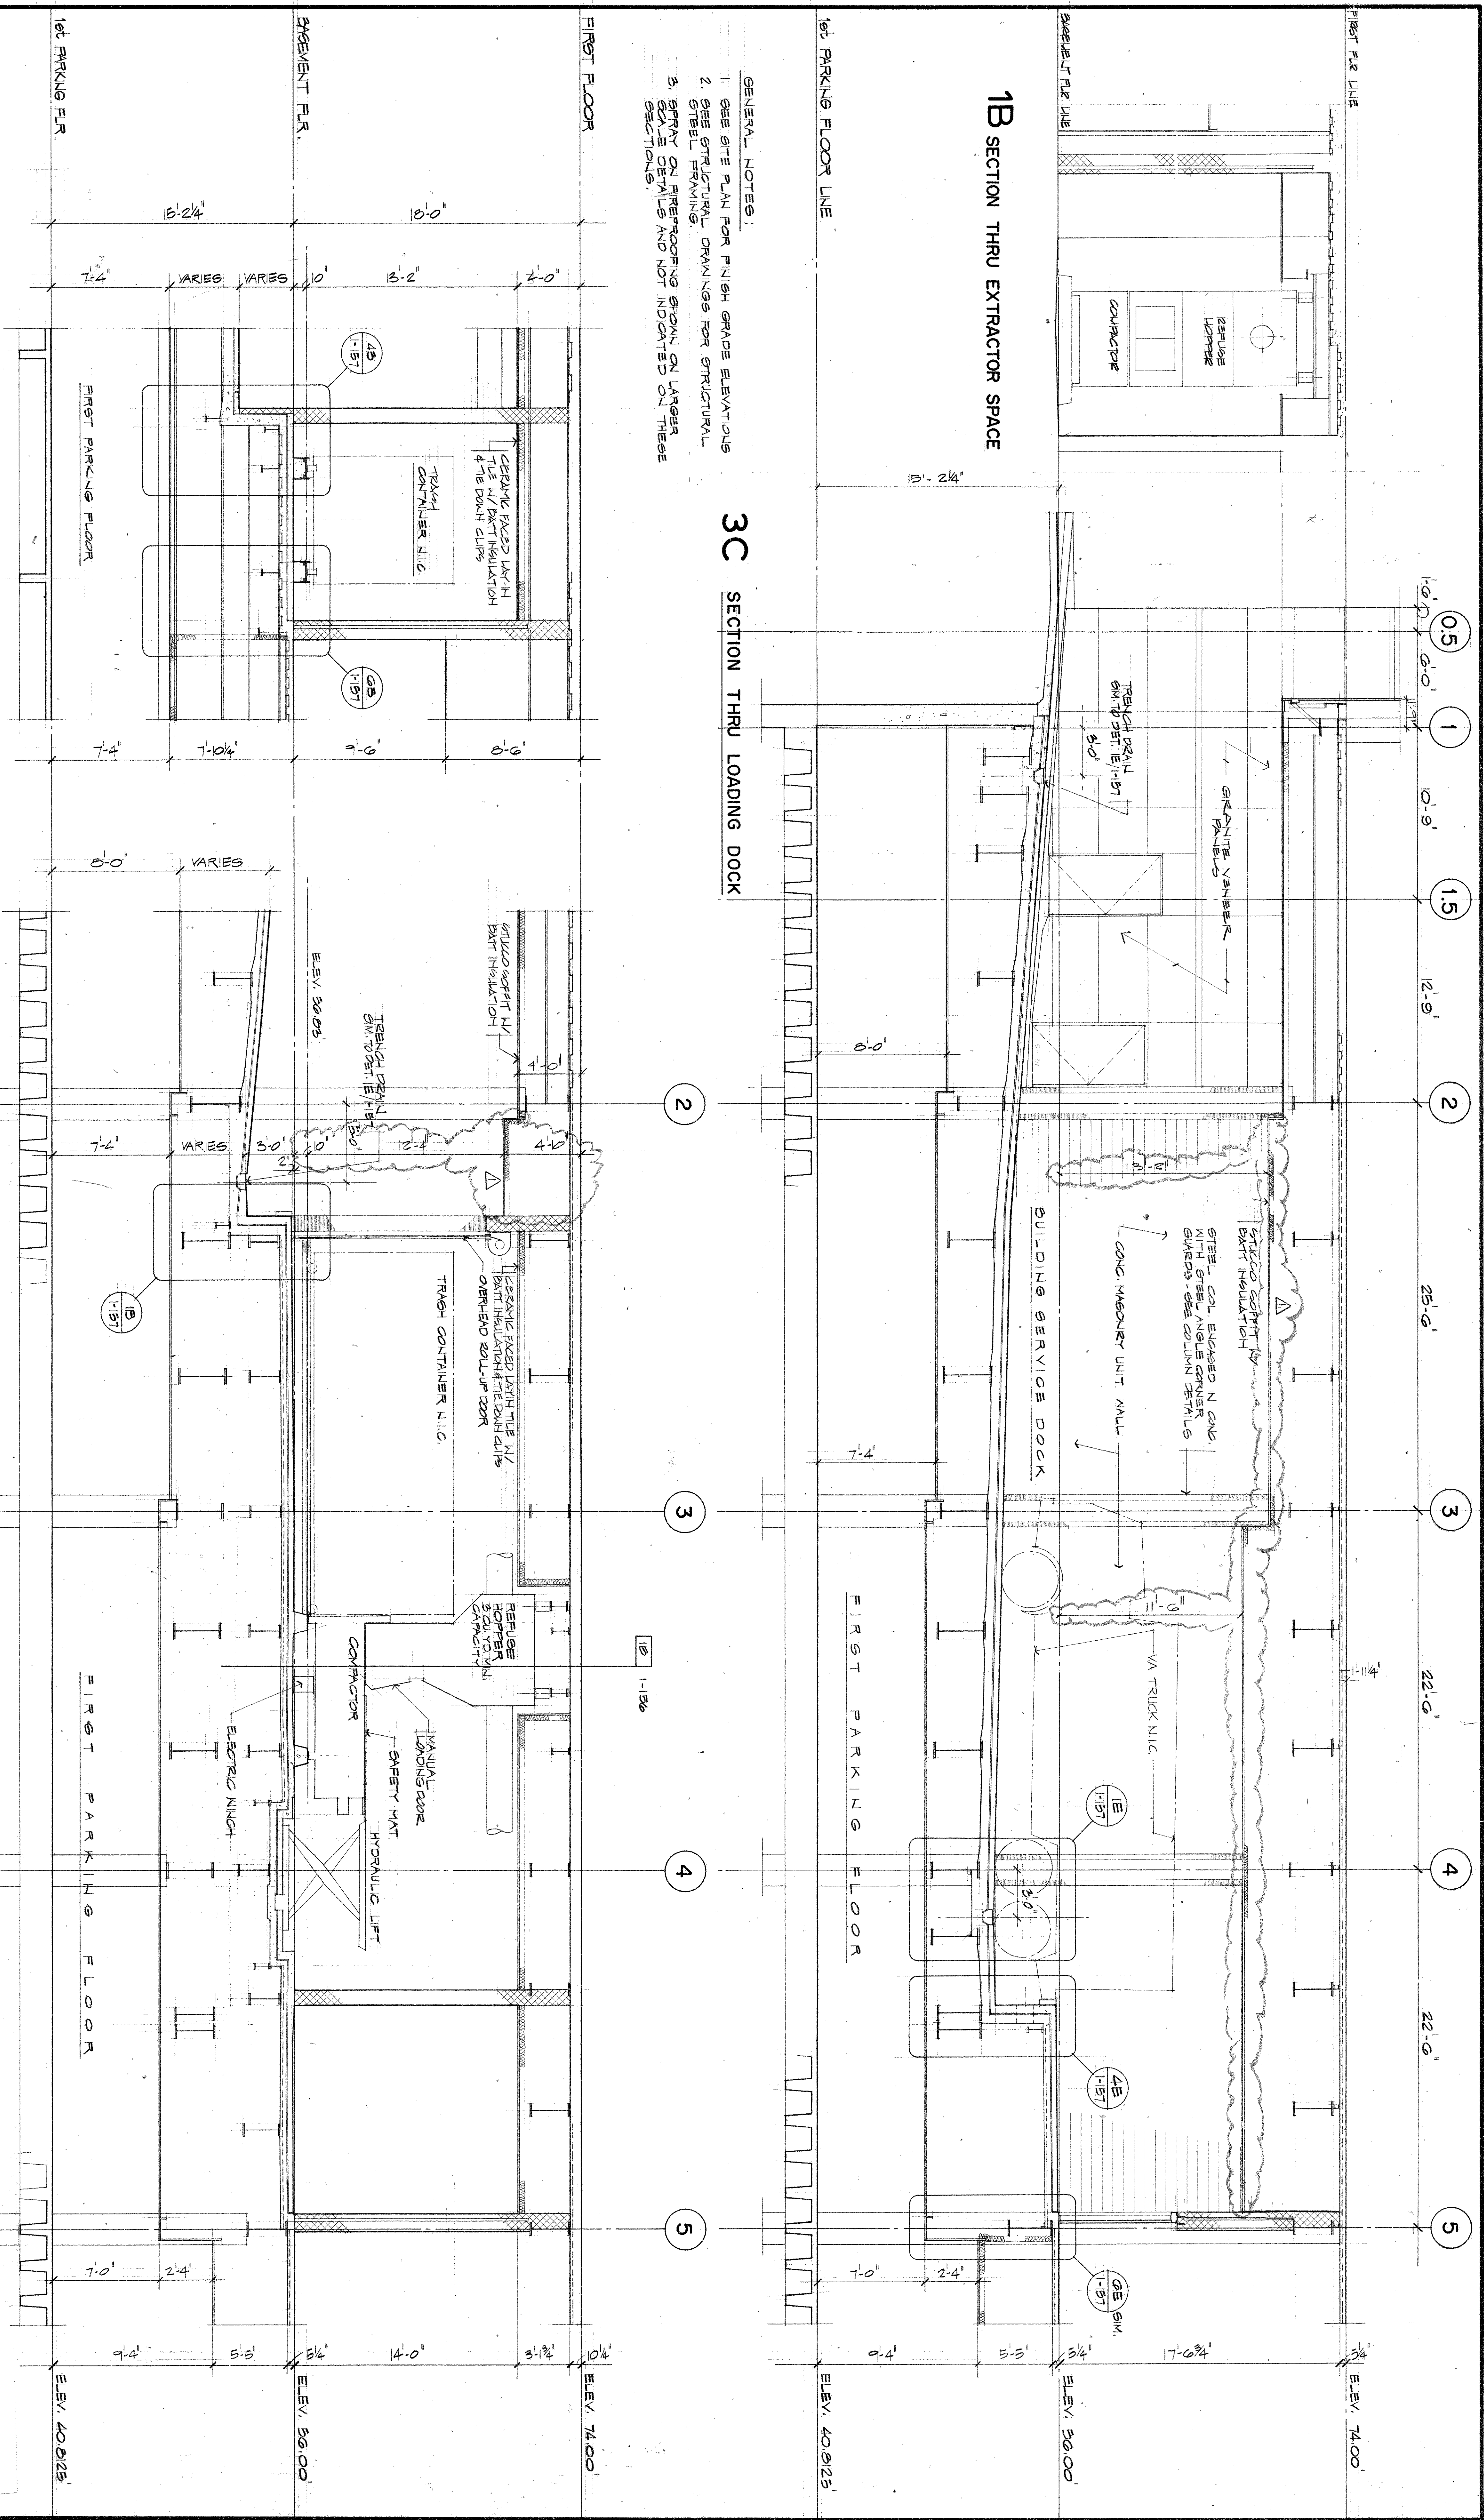

Revised Drawing RPT # 402 Date 3/26/84 1/2/82	
Key Plan	
Architectural Registration Board 3095 E. Pratt Street Baltimore, MD 21202	
RTKL/CS&D/HENRY ADAMS ARCHITECTS AND ENGINEERS 400 E. PRATT STREET BALTIMORE, MD 21202	
Drawing Title LOADING DOCK & REFUSE ROOM WALL SECTIONS	
Project Title 324-BED REPLACEMENT HOSPITAL - PHASE II	
Scale 1/4" = 1'-0"	Building Number 1
Checked 1	Location VAMC - BALTIMORE, MD
DWG 1-156	Date 9/1/88 Project No. 51000 Drawing No. 1-156
Veterans Administration	