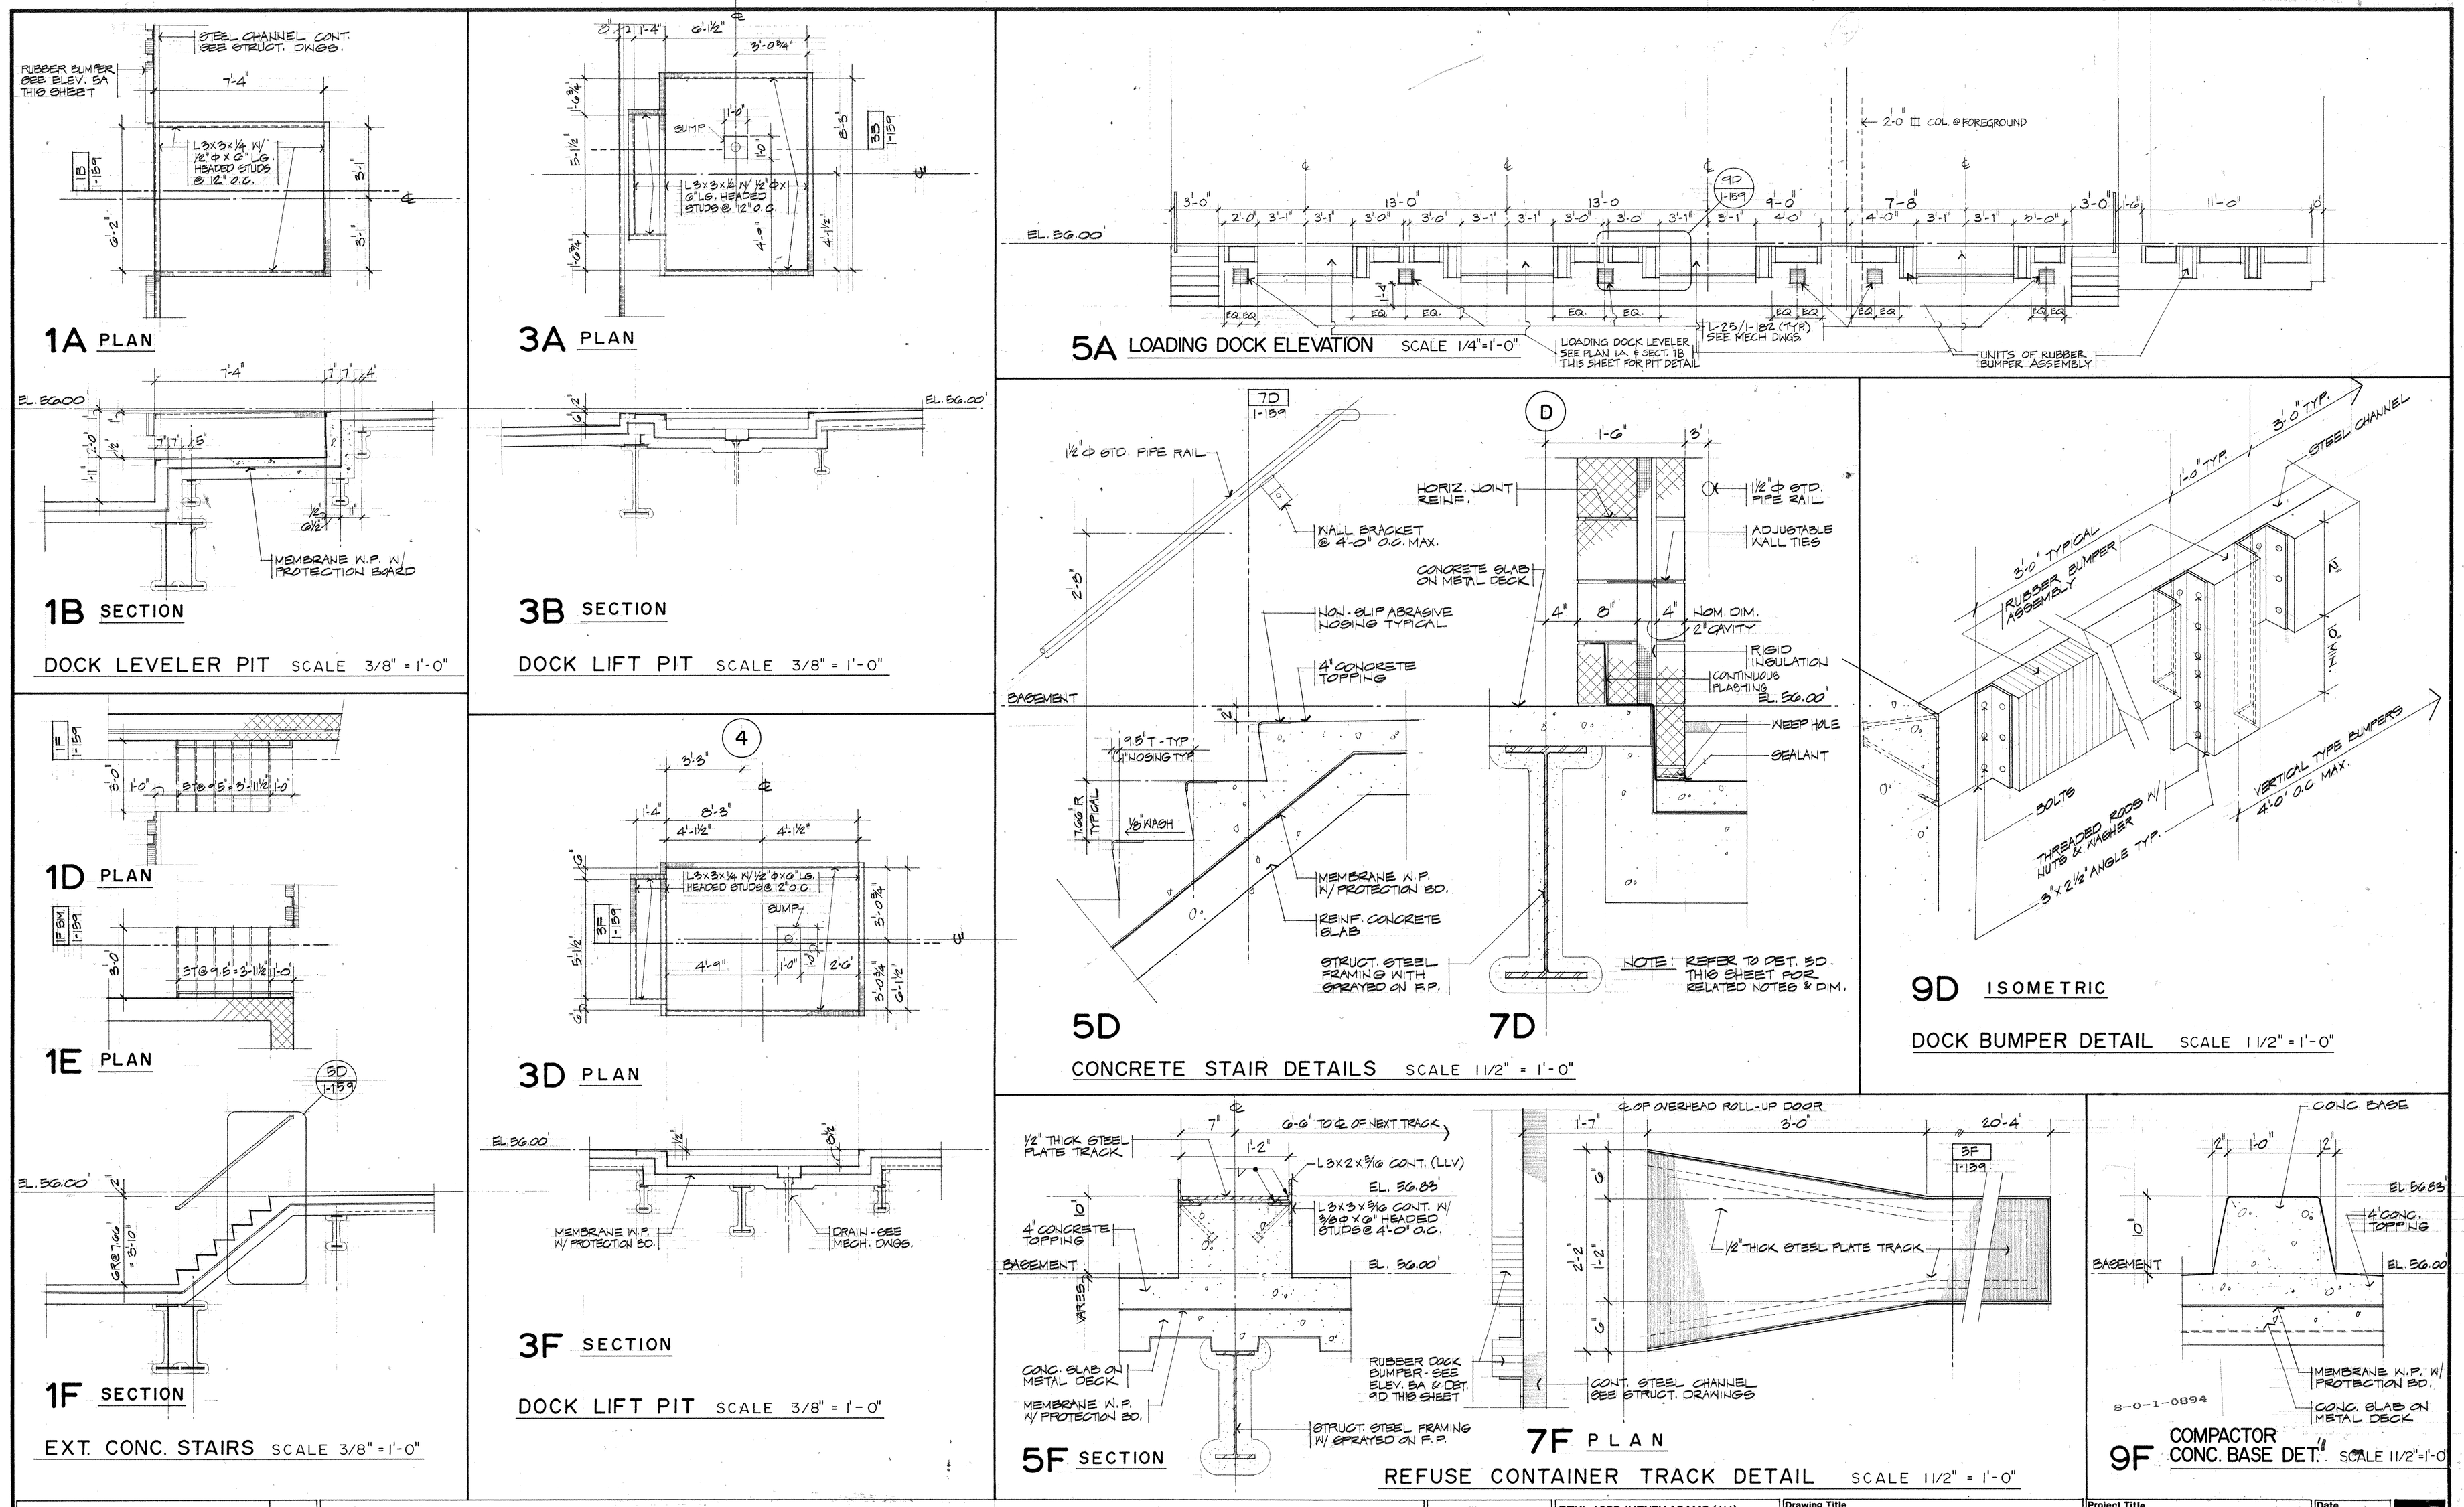

Revisions	Date
⚠ RECORD DRAWING	3.25.94

VA FORM 08-6231, OCT 1978

Seal

RTKL / CSD / HENRY ADAMS (J.V.)
ARCHITECTS AND ENGINEERS
400 E. PRATT STREET
BALTIMORE, MD 21202

Drawing Title: LOADING DOCK MISCELLANEOUS DETAILS

Approved Project Director: Albert Miller

Scale: AS NOTED

Checked

Project Title: 324-BED REPLACEMENT HOSPITAL - PHASE II

Building Number: 1

Location: VAMC - BALTIMORE, MD.

Date: 9/1/88

Project No.: 511-0010

DRAWING NO.: 1-159

Dwg. No.

Veterans Administration