



three inches = one foot
one inch = one foot
one and one half inches = one foot
one inch = one foot
one and one half inches = one foot
three quarters inch = one foot
one half inch = one foot
three quarters inch = one foot
one half inch = one foot
three eighths inch = one foot
one quarter inch = one foot
one eighth inch = one foot

K:\2013504 VA Lake City Upgrade EMS\13504_38 M102.dwg 2-27-14 06:21:04 PM dslanley

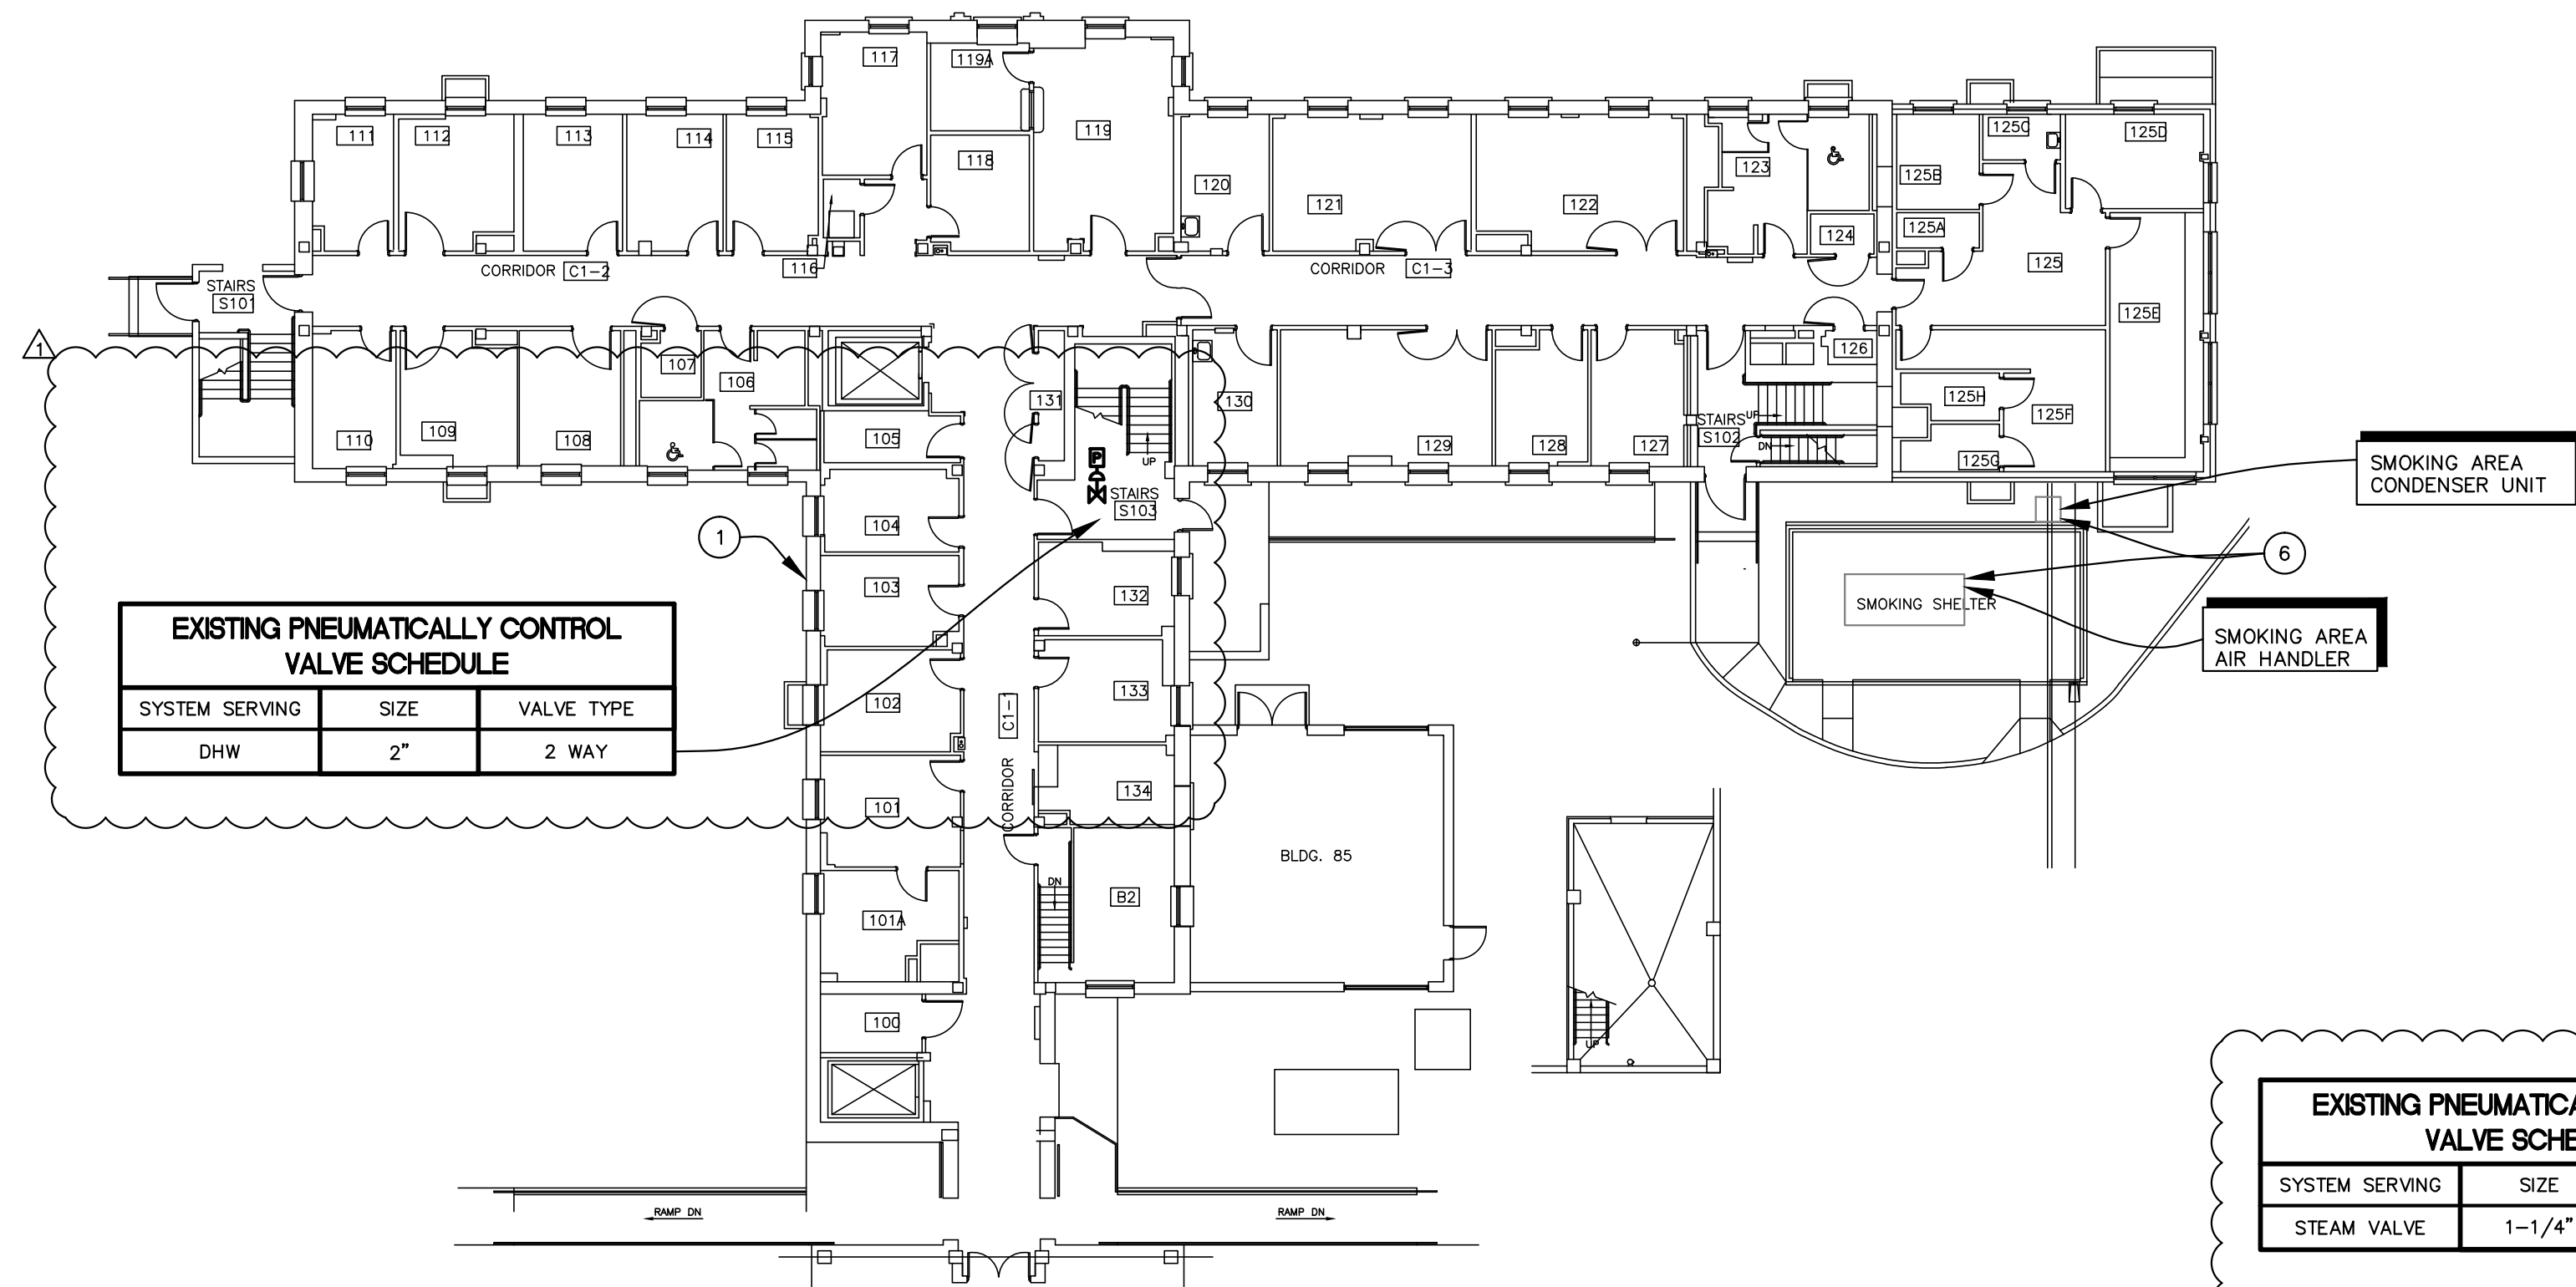


**BUILDING 38
FIRST FLOOR PLAN - MECHANICAL**

SCALE: 1/16\" = 1'-0"

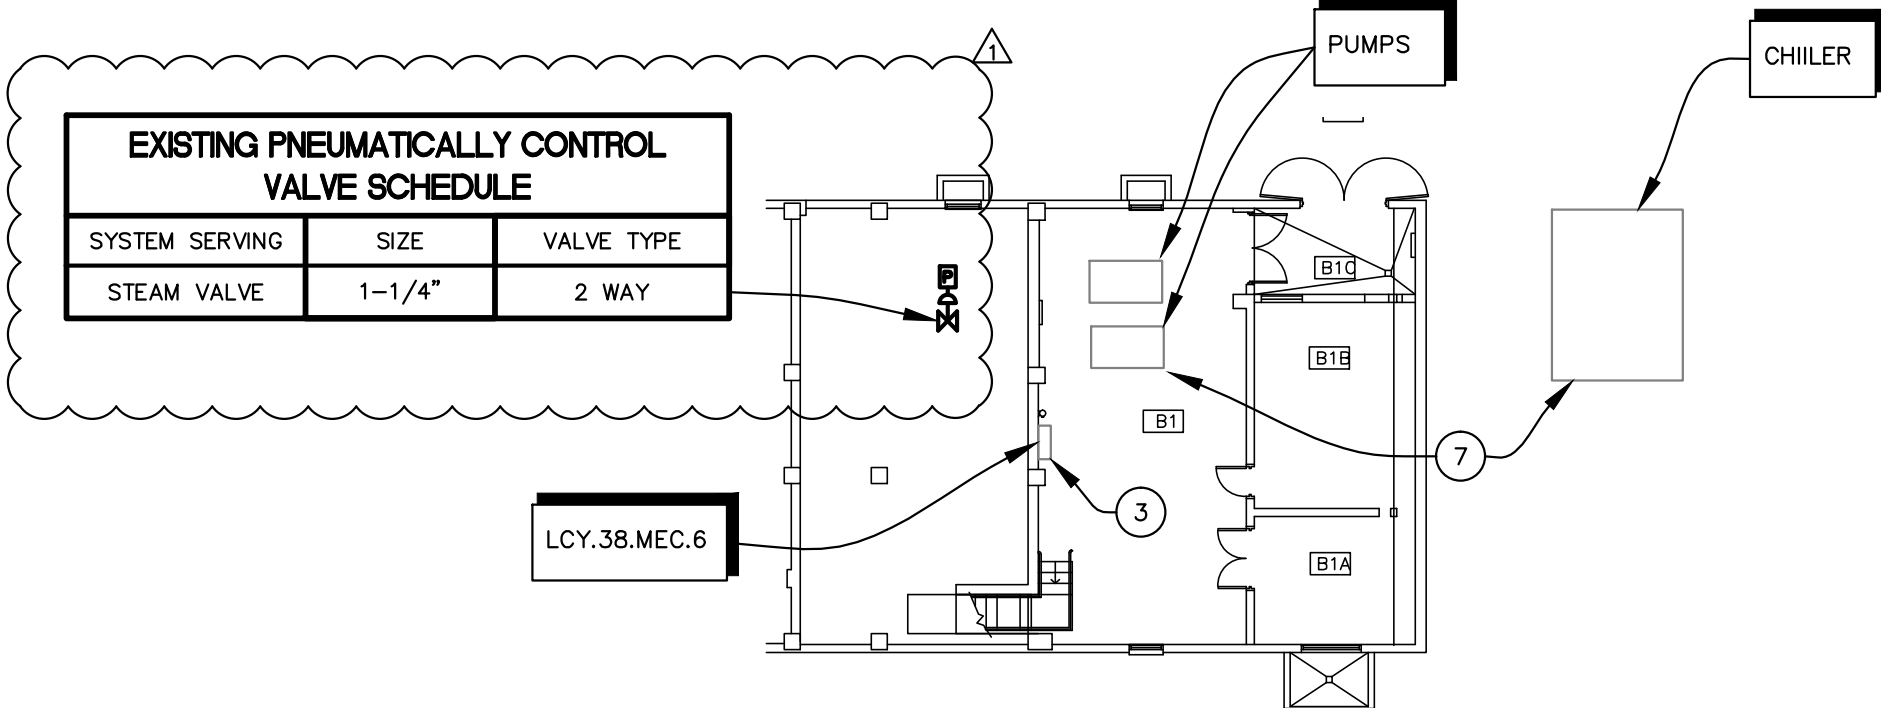


**BUILDING 38
BASEMENT PLAN - MECHANICAL**

SCALE: 1/16\" = 1'-0"

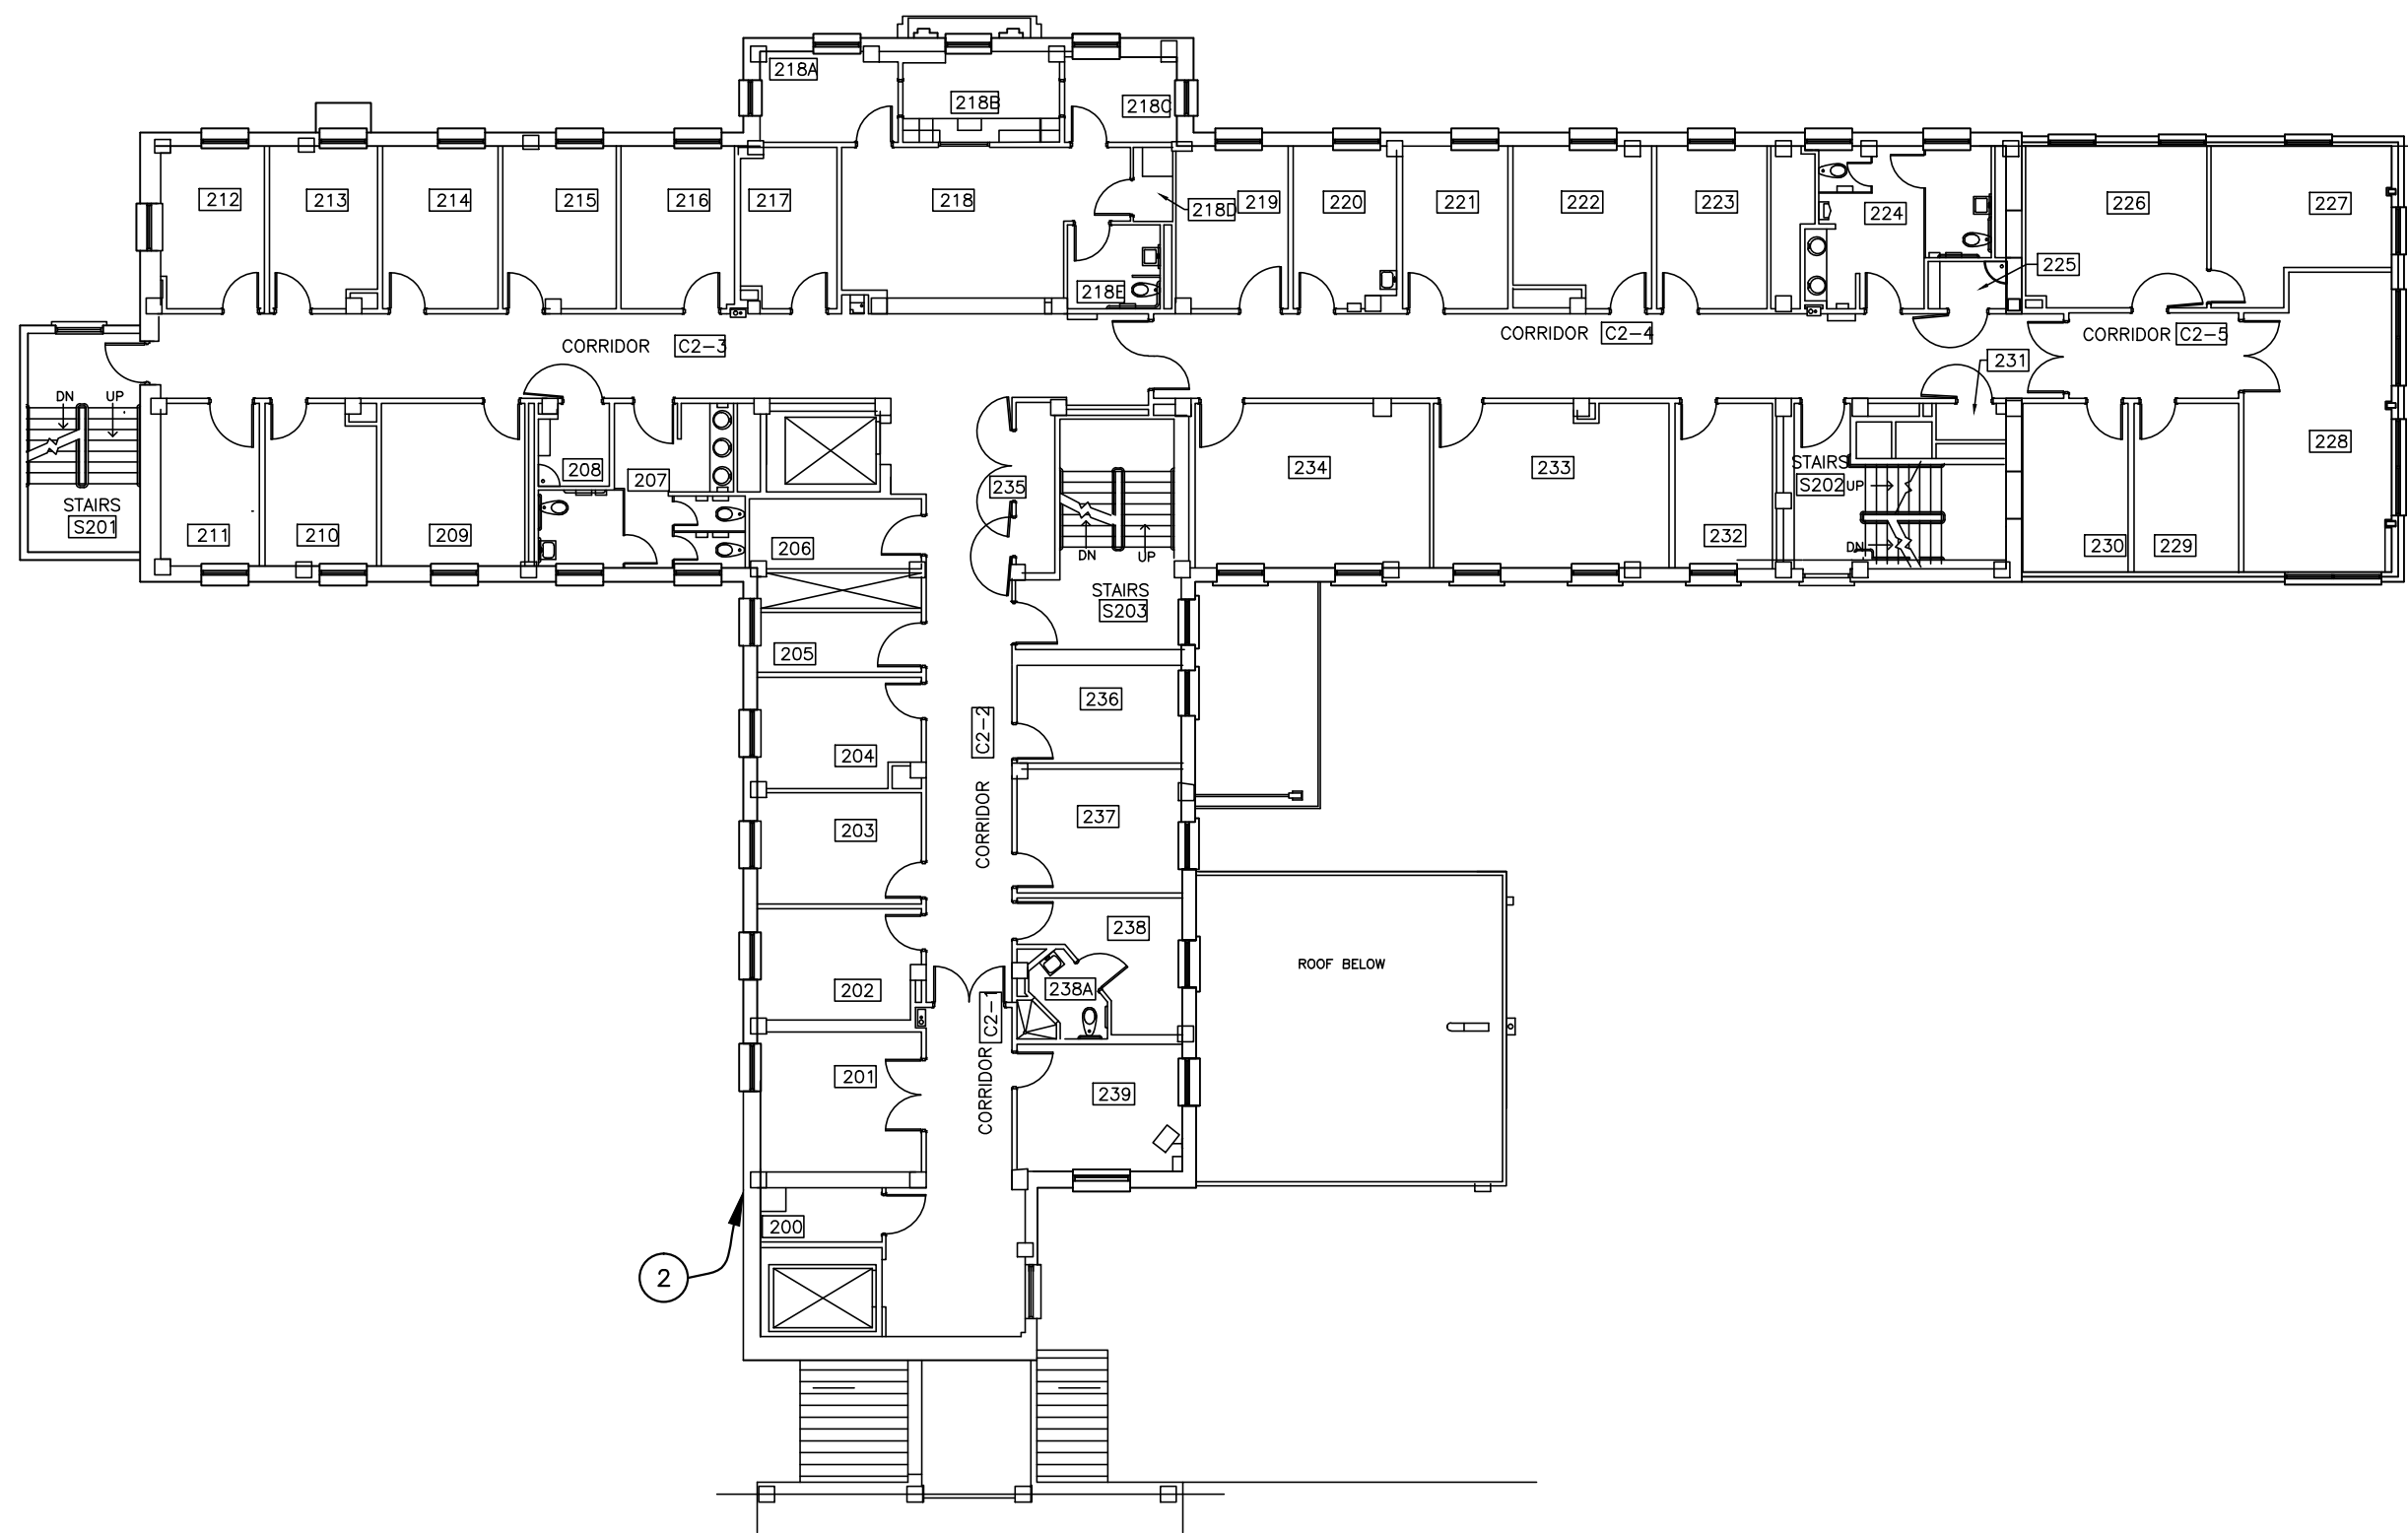


**BUILDING 38
SECOND FLOOR PLAN - MECHANICAL**

SCALE: 1/16\" = 1'-0"

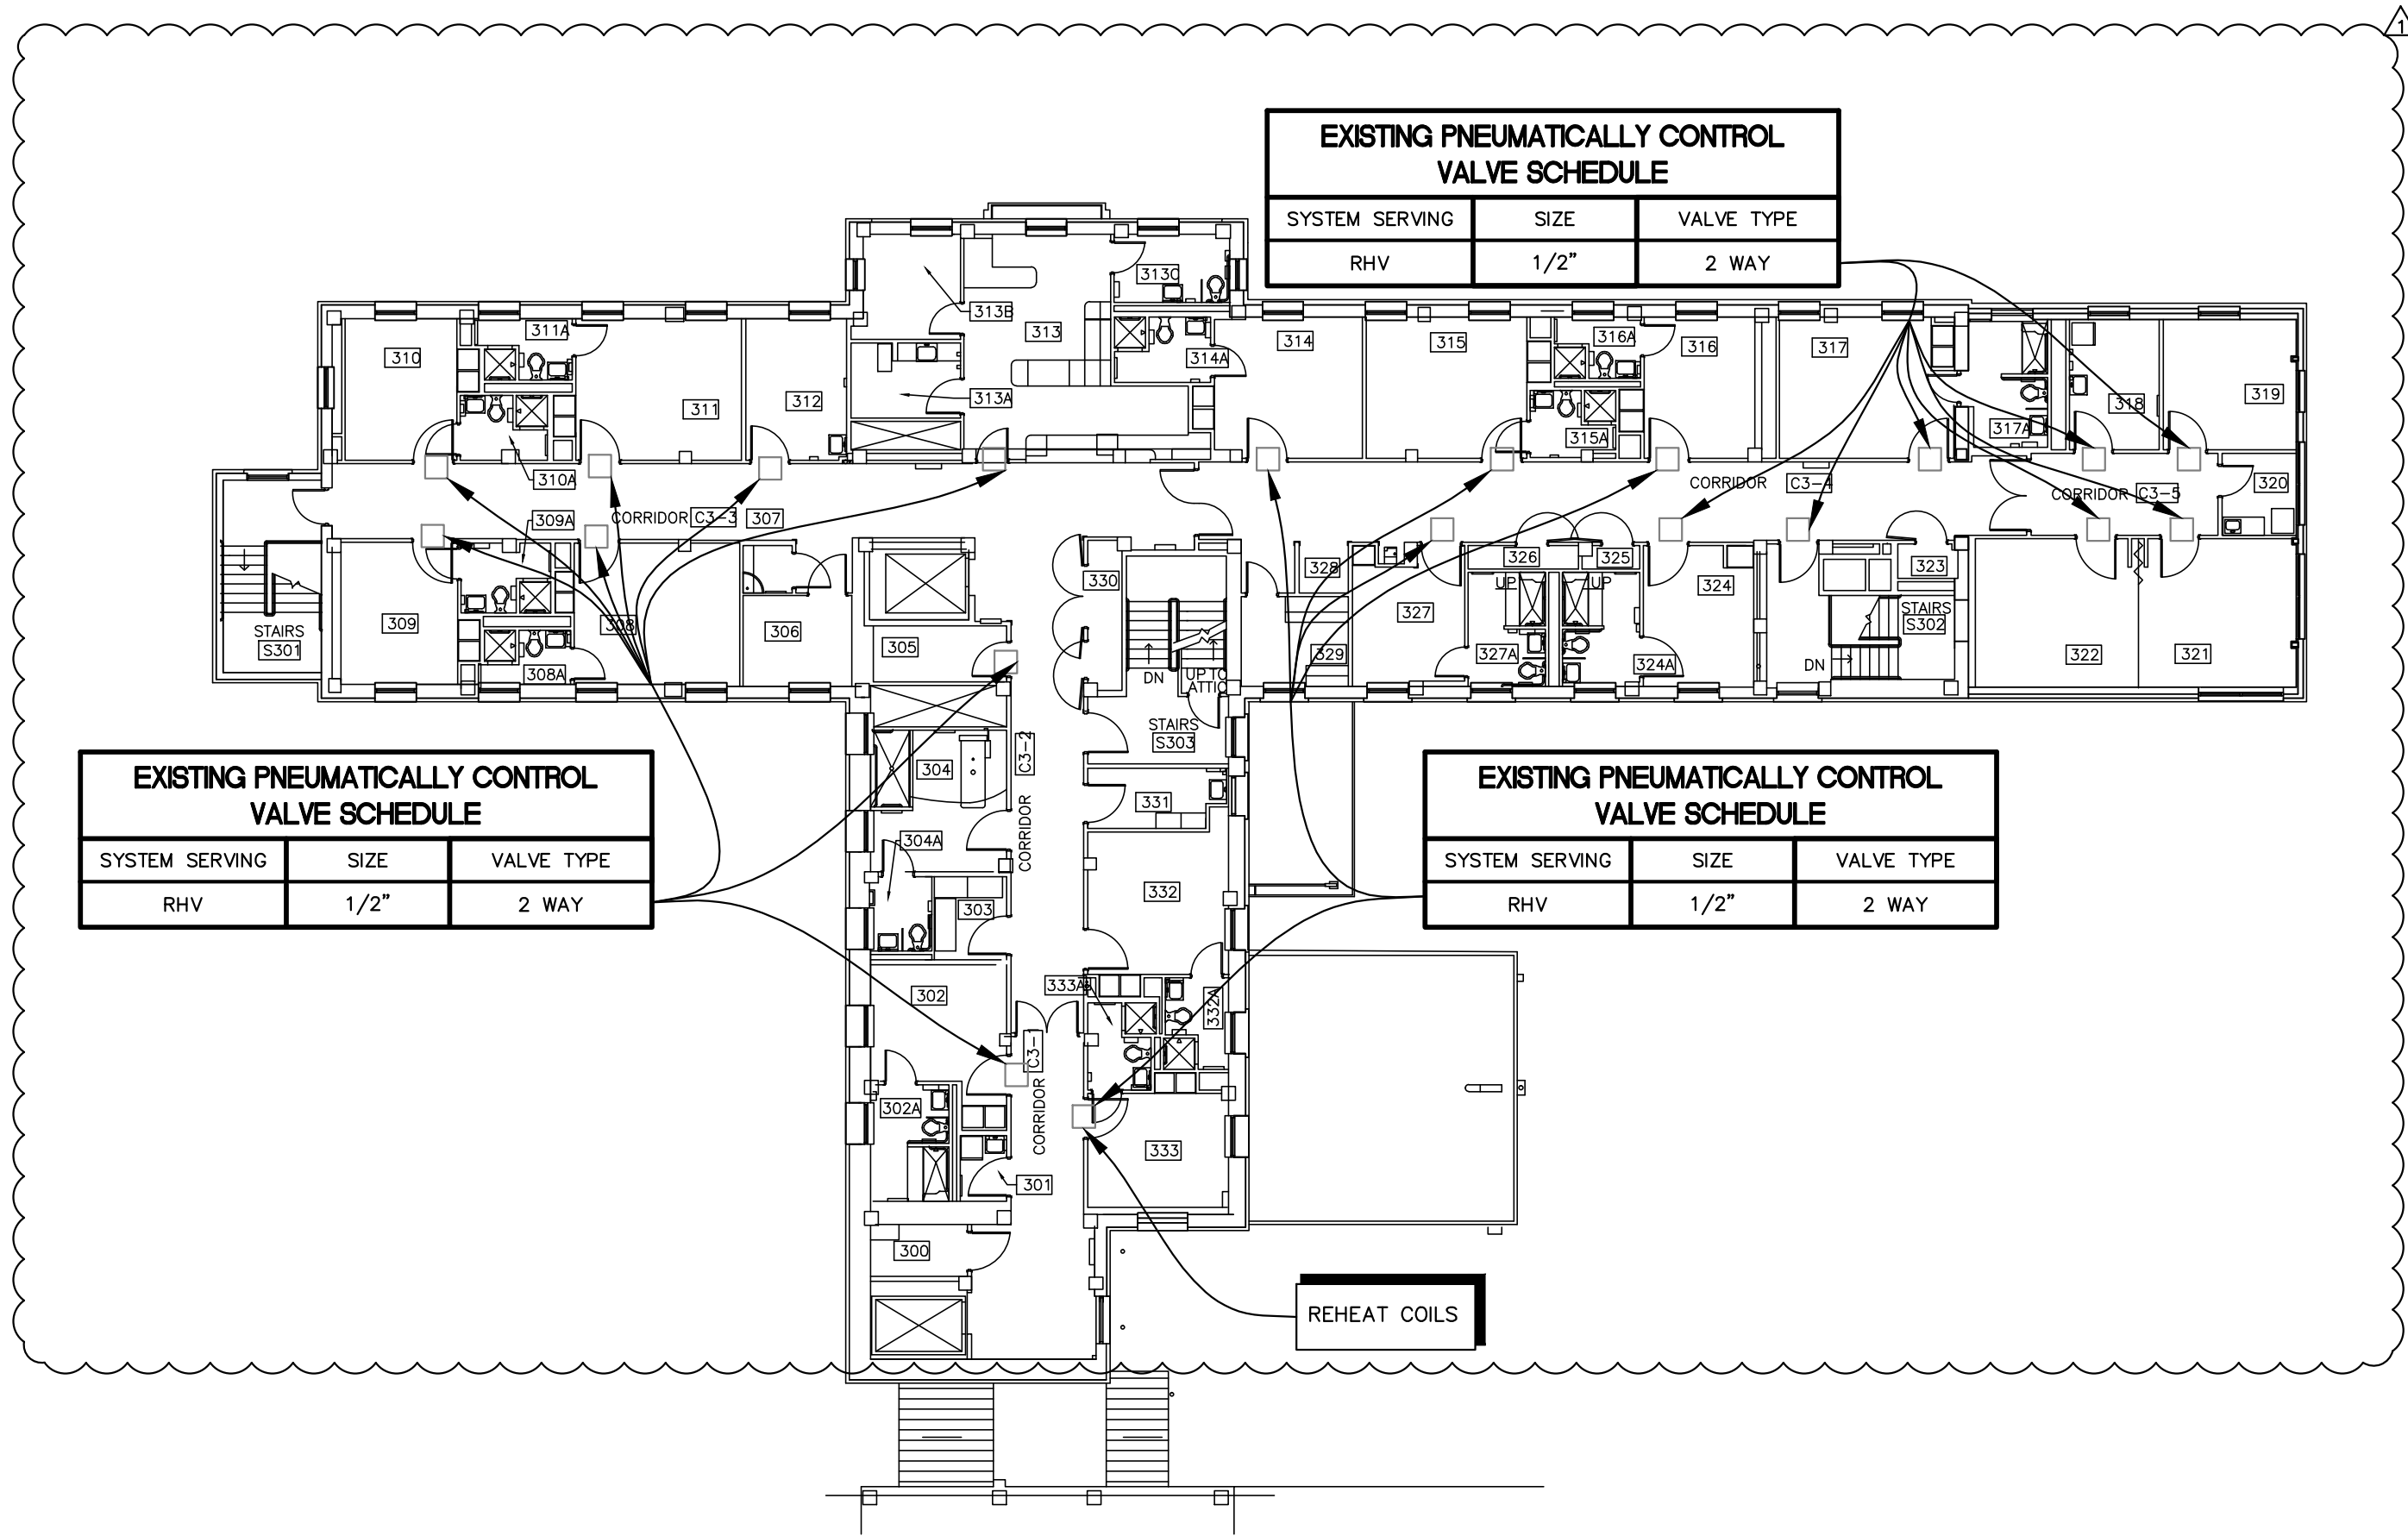

**BUILDING 38
THIRD FLOOR PLAN - MECHANICAL**

SCALE: 1/16\" = 1'-0"

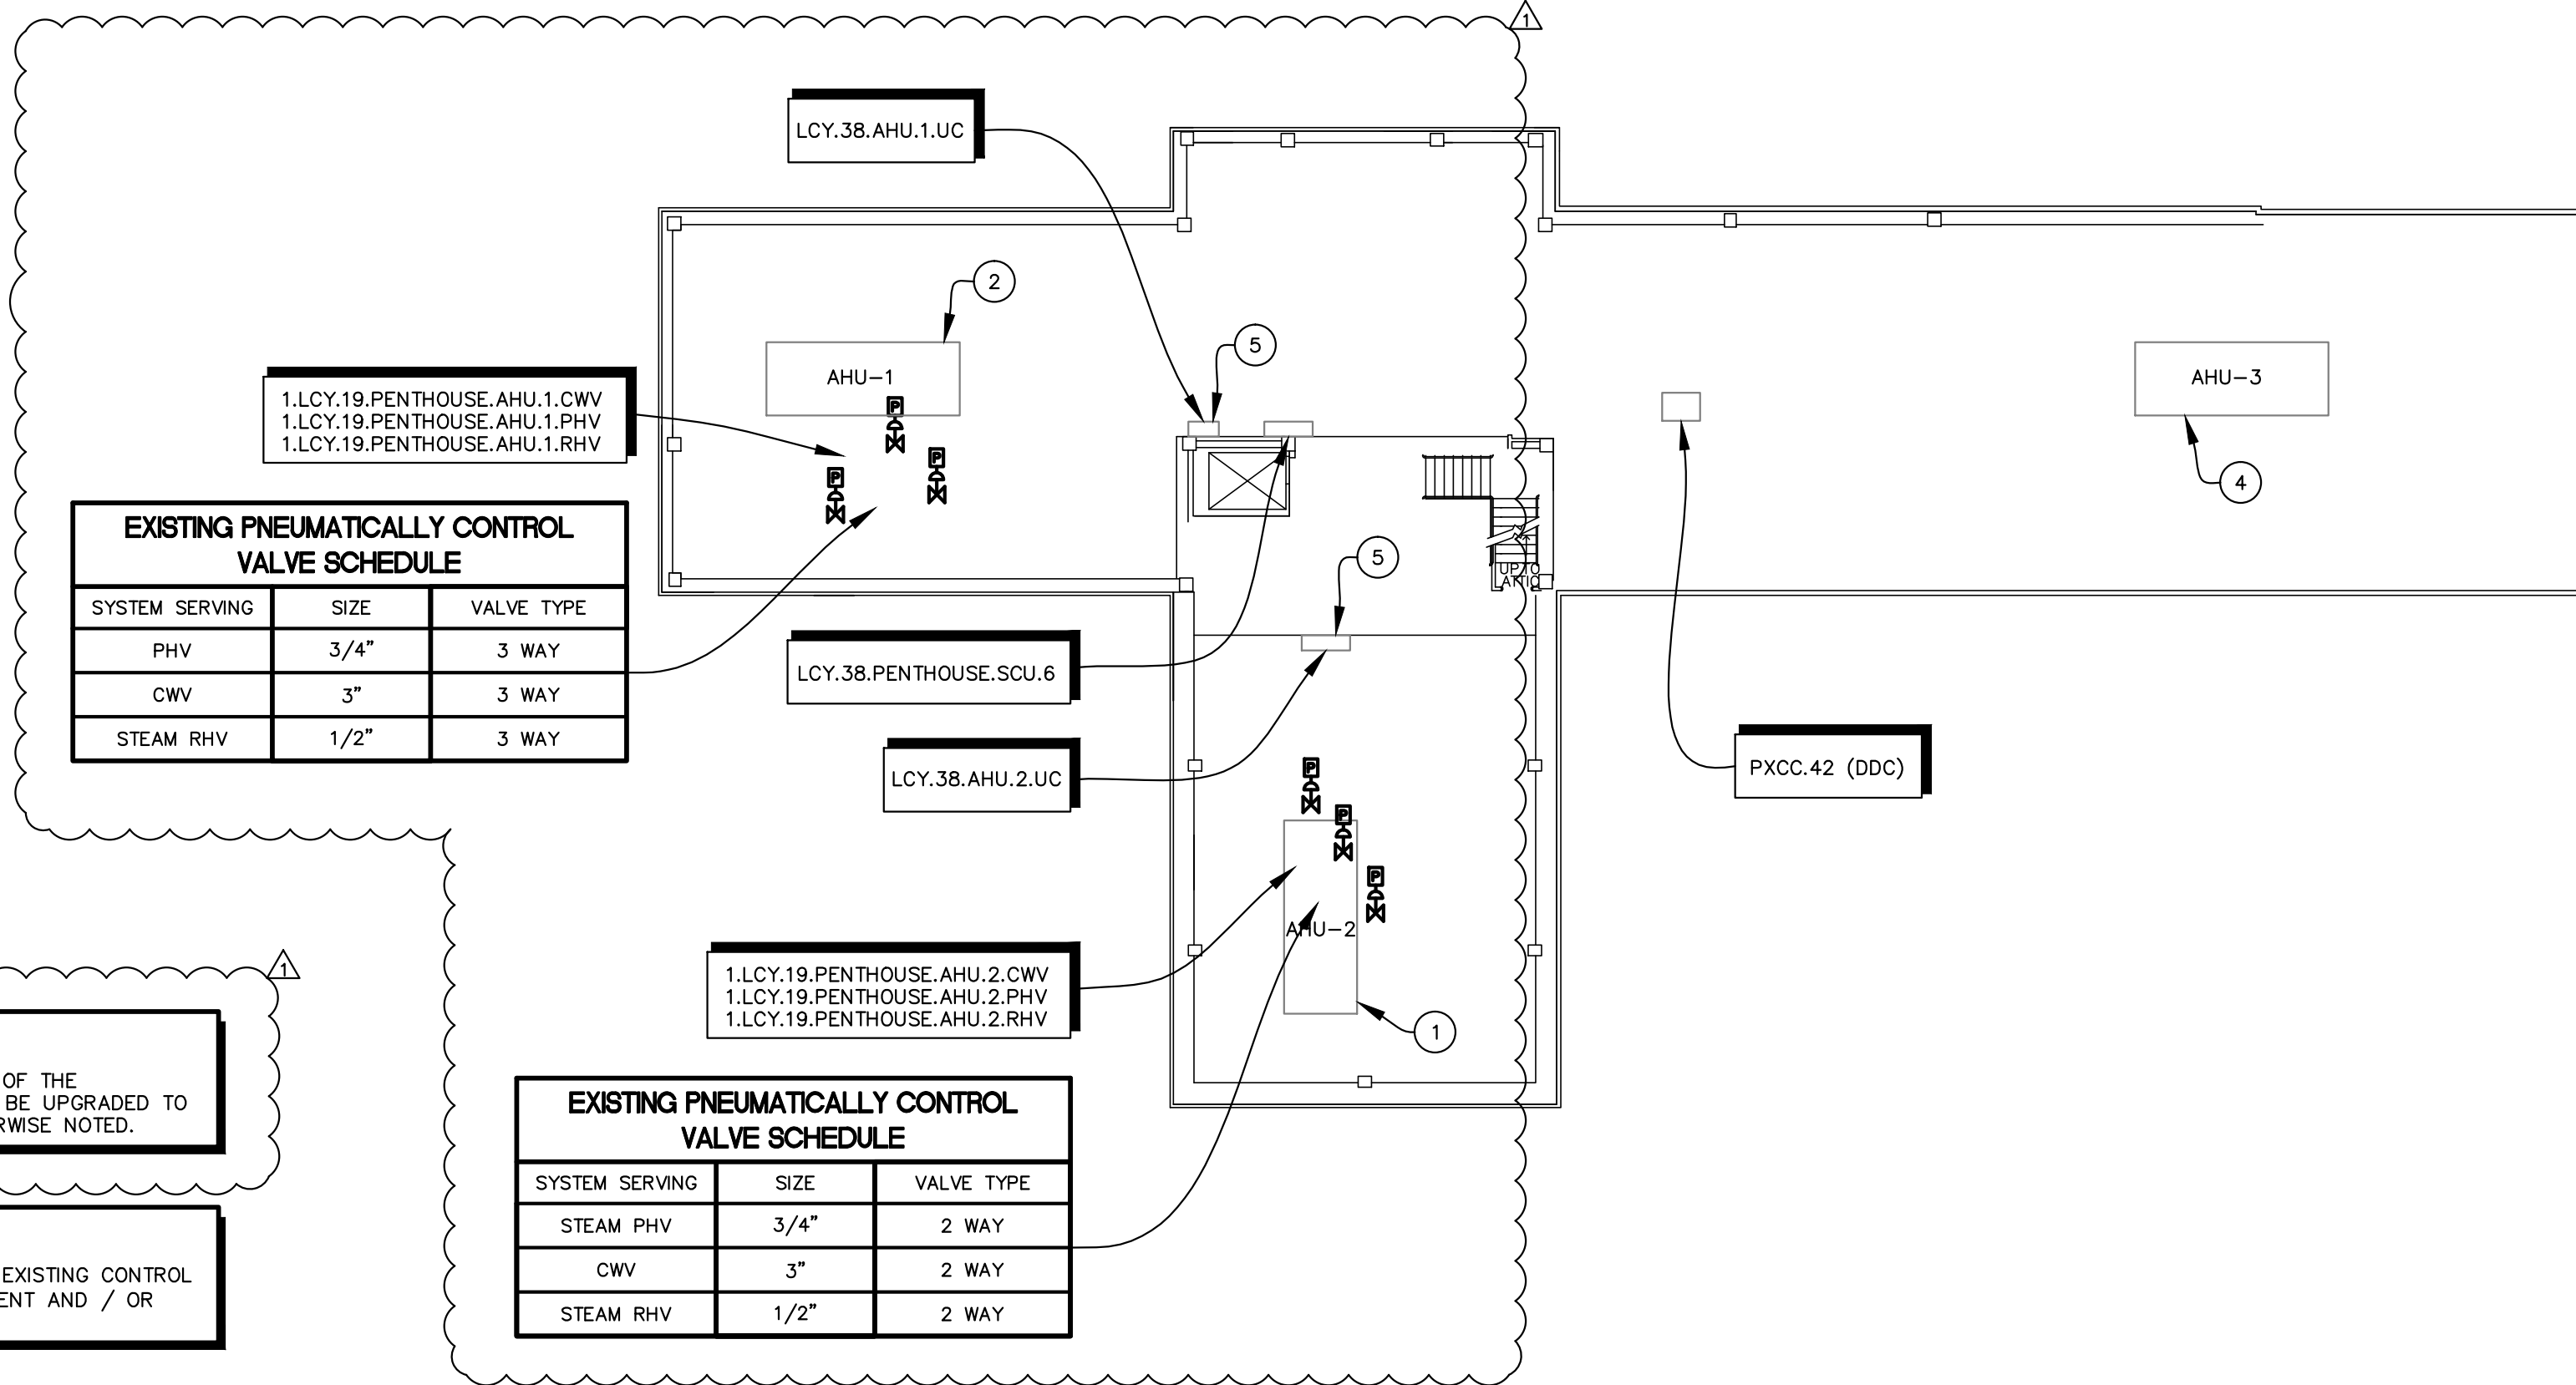

**BUILDING 38
PENTHOUSE FLOOR PLAN - MECHANICAL**

SCALE: 1/16\" = 1'-0"

- MECHANICAL NOTE:
1. REFER TO SHEET MH401 DETAIL 3.
 2. REFER TO SHEET MH401 DETAIL 2.
 3. CONTROLS CHILLER FOR BUILDING 38.
 4. REFER TO SHEET MH401 DETAIL 4.
 5. REFER TO SHEET MH401 DETAIL 7.
 6. REFER TO SHEET MH401 DETAIL 6.
 7. REFER TO SHEET MH401 DETAIL 1.

NOTE:
THE EXISTING VALVES SHOWN ARE APPROXIMATE SIZES ONLY. IT IS THE INTENT OF THE CONSTRUCTION DOCUMENT FOR THE EXISTING PNEUMATIC VALVE ACTUATORS TO BE UPGRADED TO DDC. THE EXISTING CONTROL VALVES ARE TO REMAIN IN SERVICE UNLESS OTHERWISE NOTED.

NOTE:
THE CONTRACTOR IS RESPONSIBLE TO VERIFY, LOCATE, AND ACCOUNT FOR ALL EXISTING CONTROL POINTS, PANELS, AND CONTROLLERS. INSPECT ALL PANELS PRIOR TO REPLACEMENT AND / OR RECONFIGURATION.

BID ITEM SUMMARY:
BASE BID: PROVIDE ALL EQUIPMENT AND WORK INDICATED ON PLANS.
BID ALTERNATE 1: SAME AS BASE BID, EXCEPT DEDUCT THE REPLACEMENT OF FLOOR/FIELD CONTROLLERS AND REUSE AND RECONFIGURE FOR NEW BAGNET. EXISTING PANELS TO BE EXAMINED. NEWER EXISTING PANELS SHALL BE RECONFIGURED TO WORK IN OPEN PROTOCOL BAGNET FORMAT. OLDER UNCONFIGURED / UNCONFIGURABLE PANELS SHALL BE REPLACED WITH NEW.
BID ALTERNATE 2: SAME AS BASE BID, EXCEPT DEDUCT THE CONVERSION OF ALL PNEUMATIC ACTUATED VALVES AND DAMPERS. PNEUMATIC CONTROLLERS TO BE UPDATED AND RECONFIGURED TO WORK IN OPEN PROTOCOL BAGNET FORMAT.

CONSULTANTS:

Mark E. Armiller, P.E.
Florida PE No. 53973

ARCHITECT/ENGINEERS:

**MES
GROUP**

550 North Reo Street
Suite 203, Tampa, FL 33609
813.289.4700
COA # 8304

Drawing Title
**BUILDING 38 FLOOR
PLANS - MECHANICAL**

Approved Project Director

Project Title
UPGRADE EMS

Location
LAKE CITY, FLORIDA

Date
01/03/2014

Checked
MEA

Drawn
DKS

Project Number
573A-12-200

Building Number

Drawing Number
MH102

Dwg. 4 of 30

FINAL BID DOCUMENTS

Office of
Construction
and Facilities
Management

Department of
Veterans Affairs

ADDENDUM 1 REVISION
Revisions: 2-27-14
Date

VA FORM 08-6231