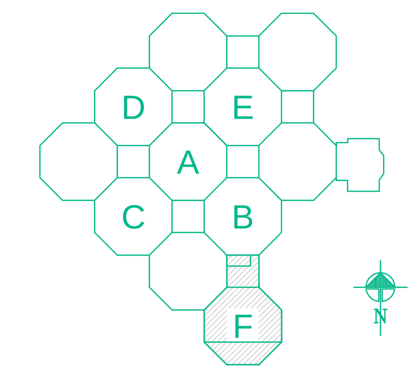

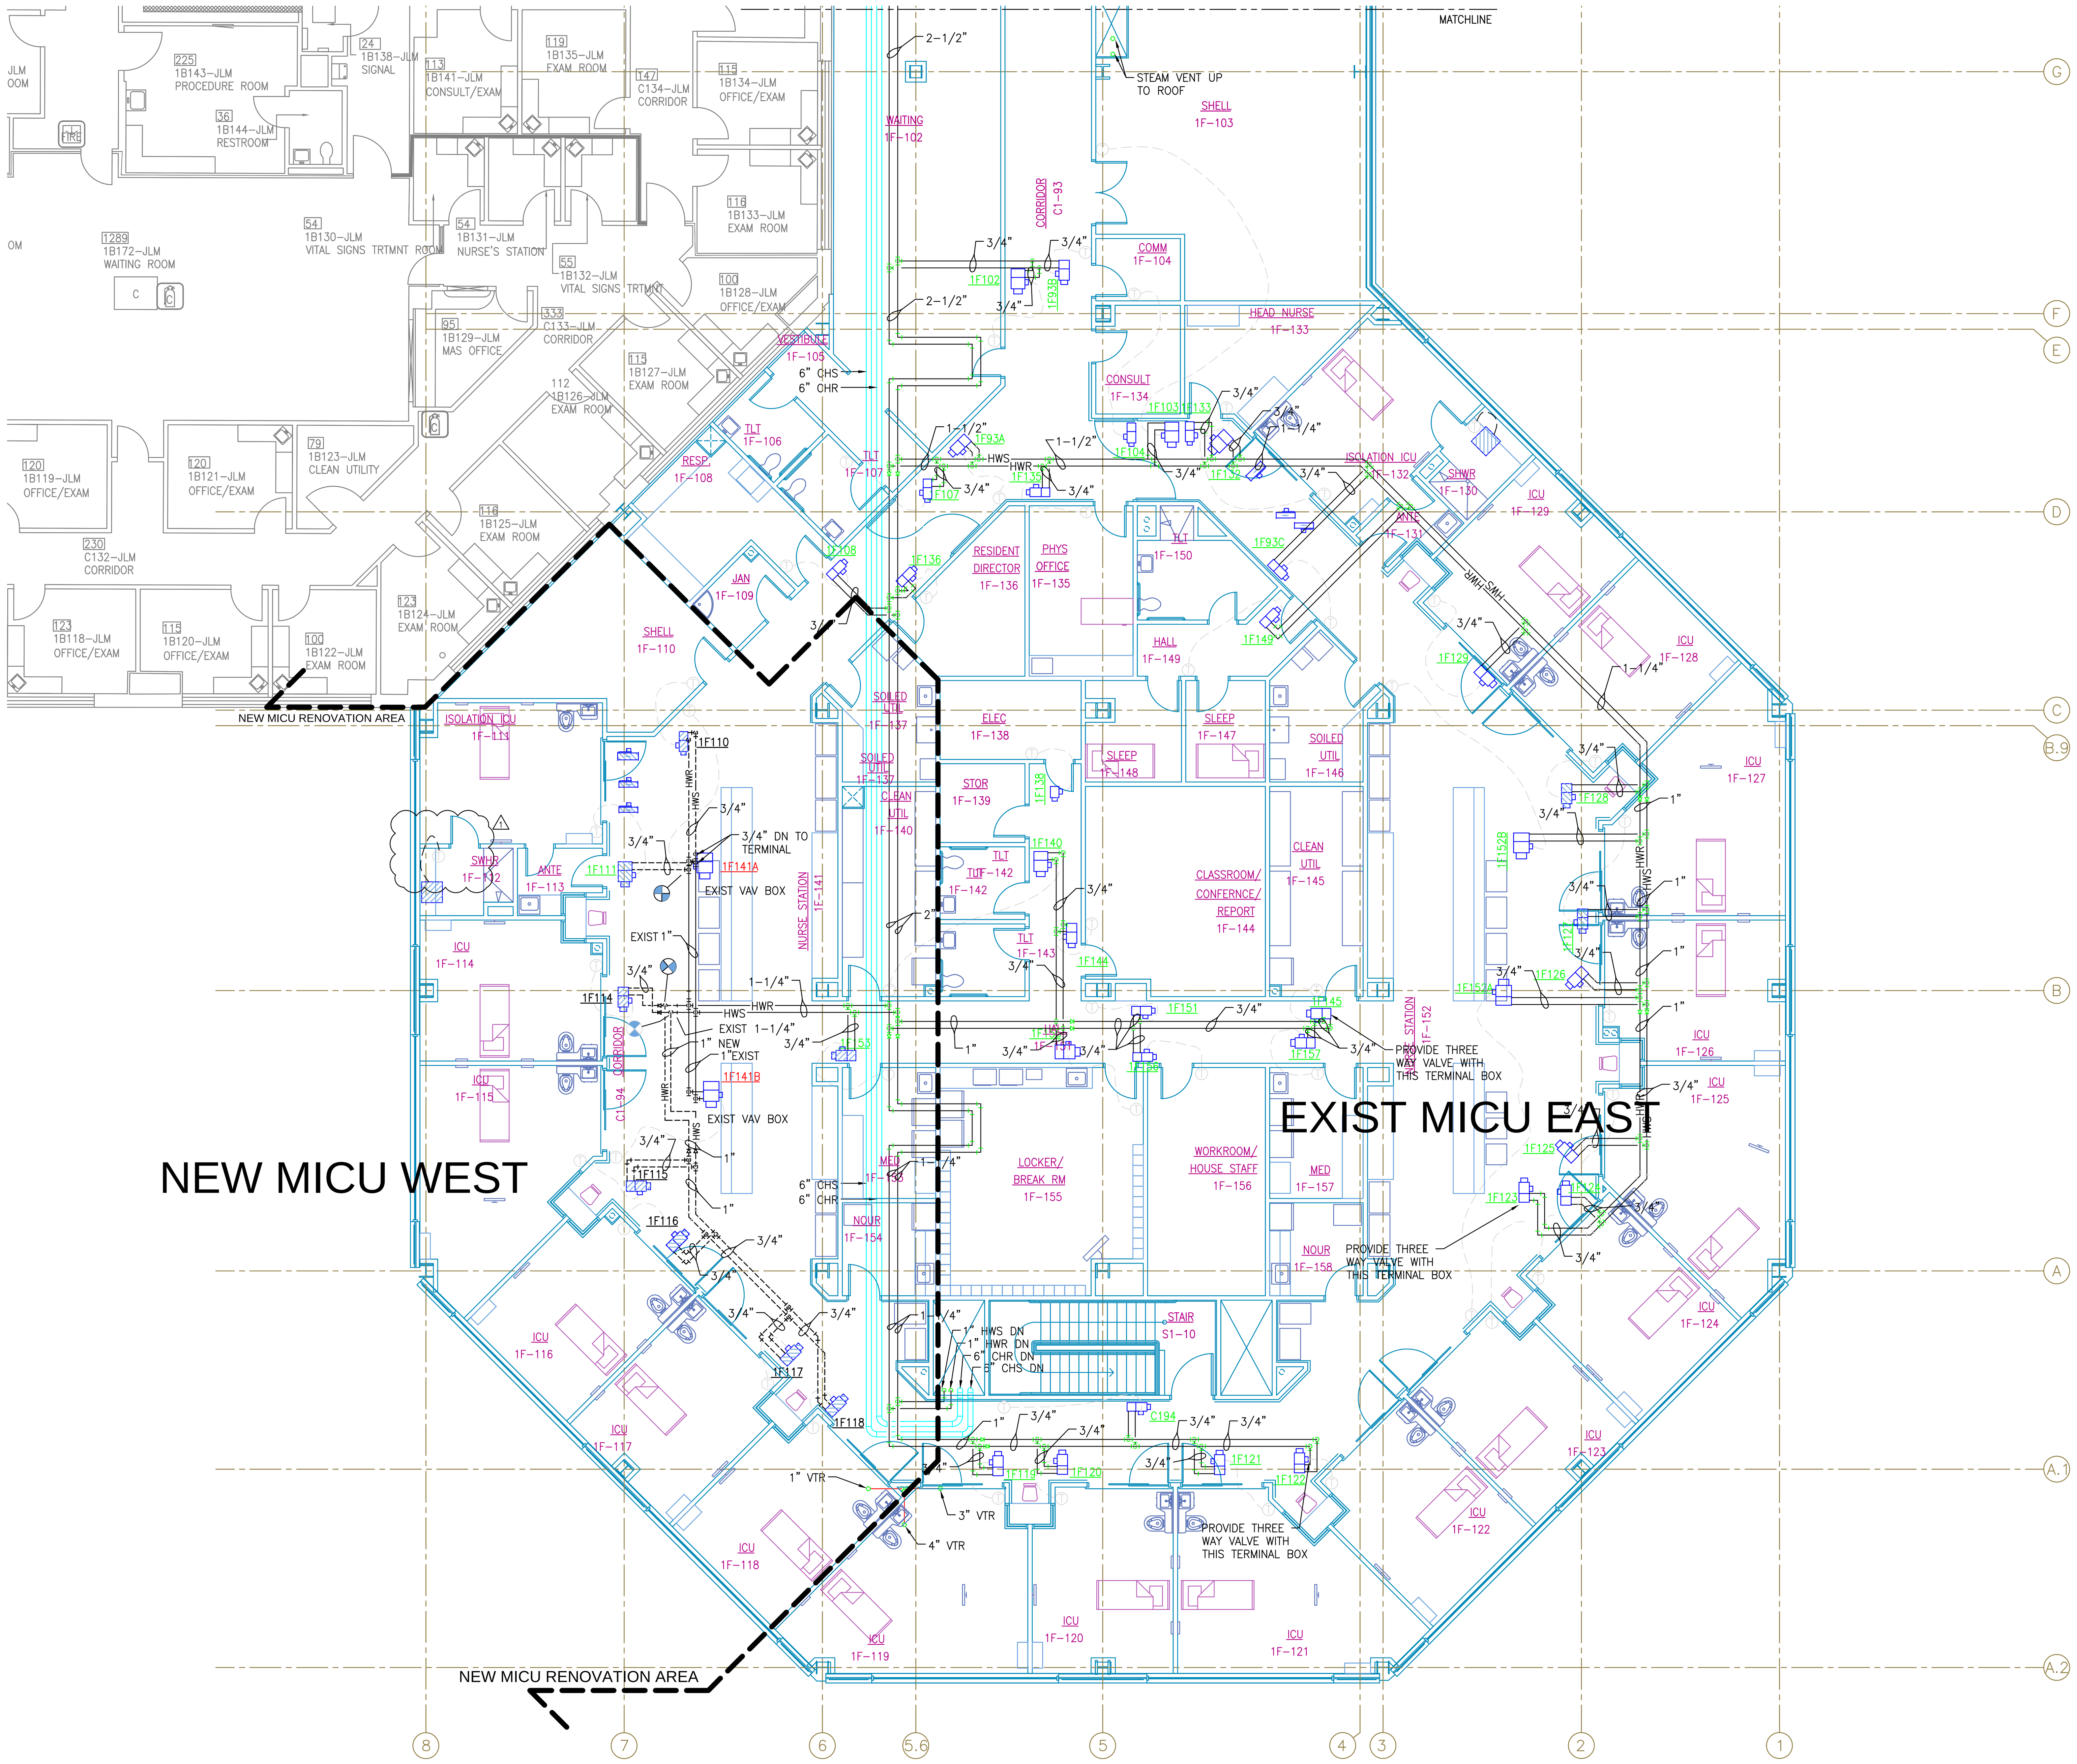

RENOVATION LEGEND

(symbol)	EXISTING VAV BOX TO REMAIN
(symbol)	NEW VAV BOX
—— HWR —— / —— HWS ——	EXIST HOT WATER SUP AND RET
– – HWS – – – / – – HWR – – –	NEW HOT WATER SUPPLY/RETURN

1 FIRST FLOOR PLAN - HVAC PIPING

1/8"=1'-0"

⚠ ADDENDUM - 1 | 08-20-08

Revisions | Date

Approved: Medical Center Director

Approved: Associate Director

Approved: Chief Of Staff

Seals

TAGGART FOSTER-CURRENCE GRAY ARCHITECTS, INC.
4500 Burrow Drive
North Little Rock, AR 72116
Phone: 501-758-7443
Fax: 501-753-7309
www.taggarch.com

Drawing Title	FIRST FLOOR PLAN- HVAC PIPING
Project Title	JLM MEMORIAL VETERAN'S HOSPITAL - EXPAND MICU
Date	NOV 2013
Project No.	XXXXX
Building Number	1-JLM
Checked	JM
Modified	P & D
Location	CAVHS LITTLE ROCK, AR
DRAWING NO.	MH-2R
Dwg	2 Of 12

Office of Facilities

DEPARTMENT OF VETERANS AFFAIRS