SITE PLAN

BUILDING AND STRUCTURE SCHEDULE

1	HOSPITAL PAVILION
1C	SWITCHGEAR BUILDING
5	UNASSIGNED BUILDING
6	ENERGY CENTER BUILDING
7	CANTEEN STORAGE ANNEX
11A	TAYLOR PAVILION
11B	OGDEN PAVILION
15	ELECTRICAL SUBSTATION
18	CHILLER PLANT
20	TRANSFORMER
21	SWITCHGEAR BUILDING
23	OXYGEN TOWER
25	CONDENSING UNIT
26	SWITCHGEAR
27	EMERGENCY GENERATOR
30	ATRIUM CLINICS PAVILION
31	FLAG POLE
32	TEMPORARY METAL BLDG.
40	BED TOWER PAVILION
42	EMERGENCY GENERATOR
43	MEMORIAL STONE – OIF
44	FLAG POLES (3)
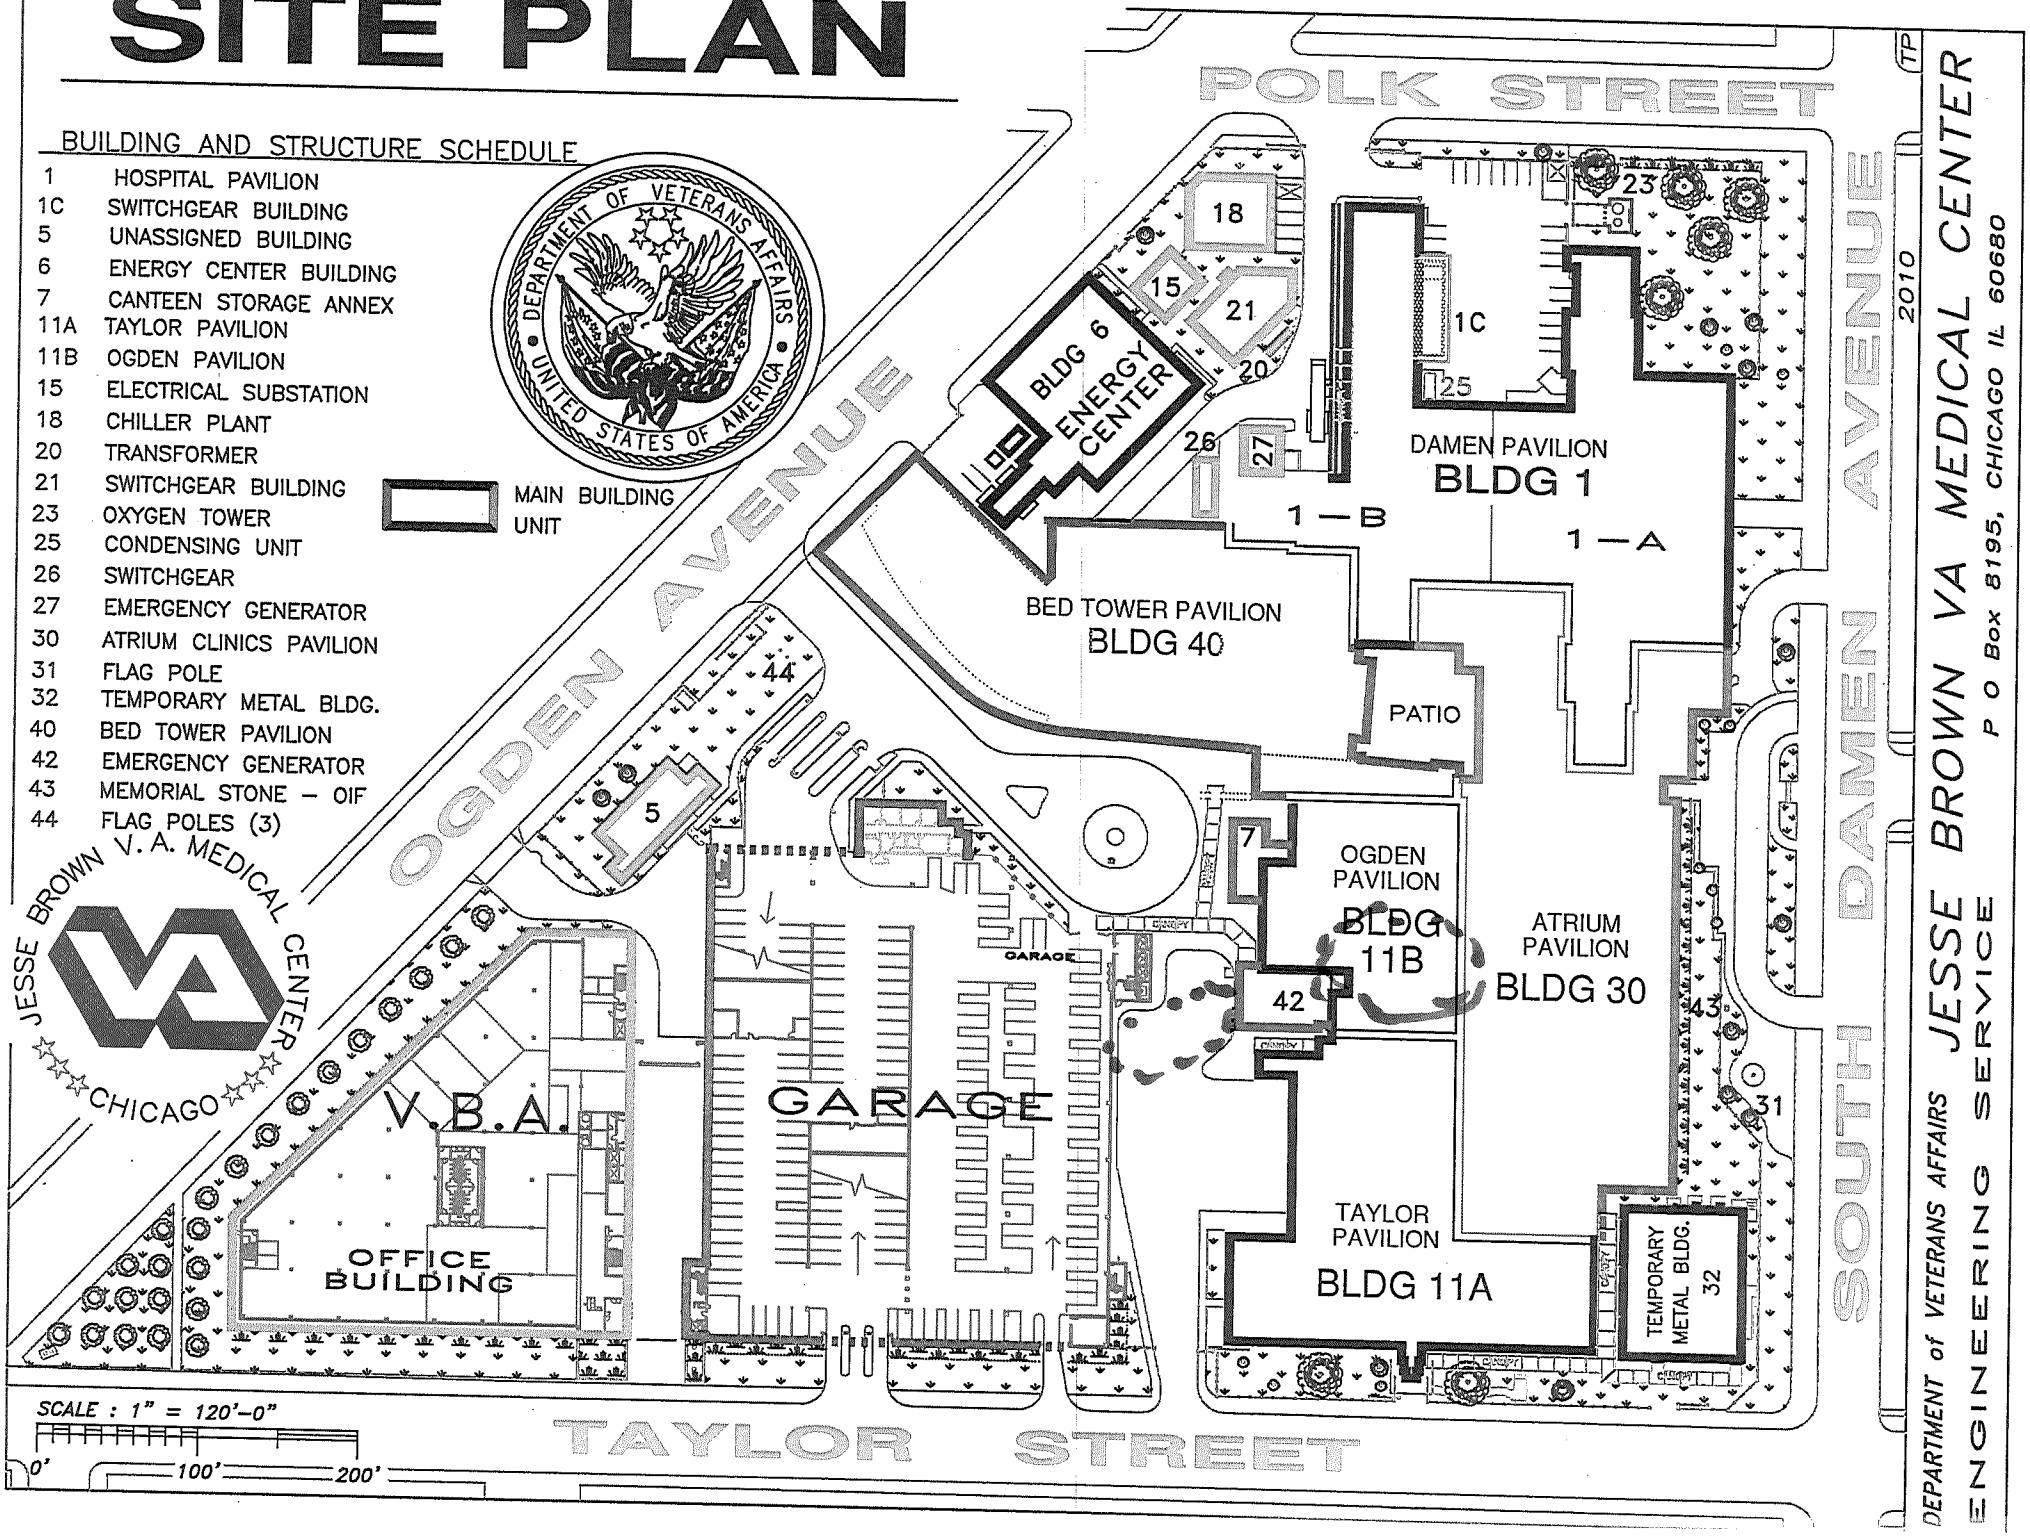
MAIN BUILDING UNIT