


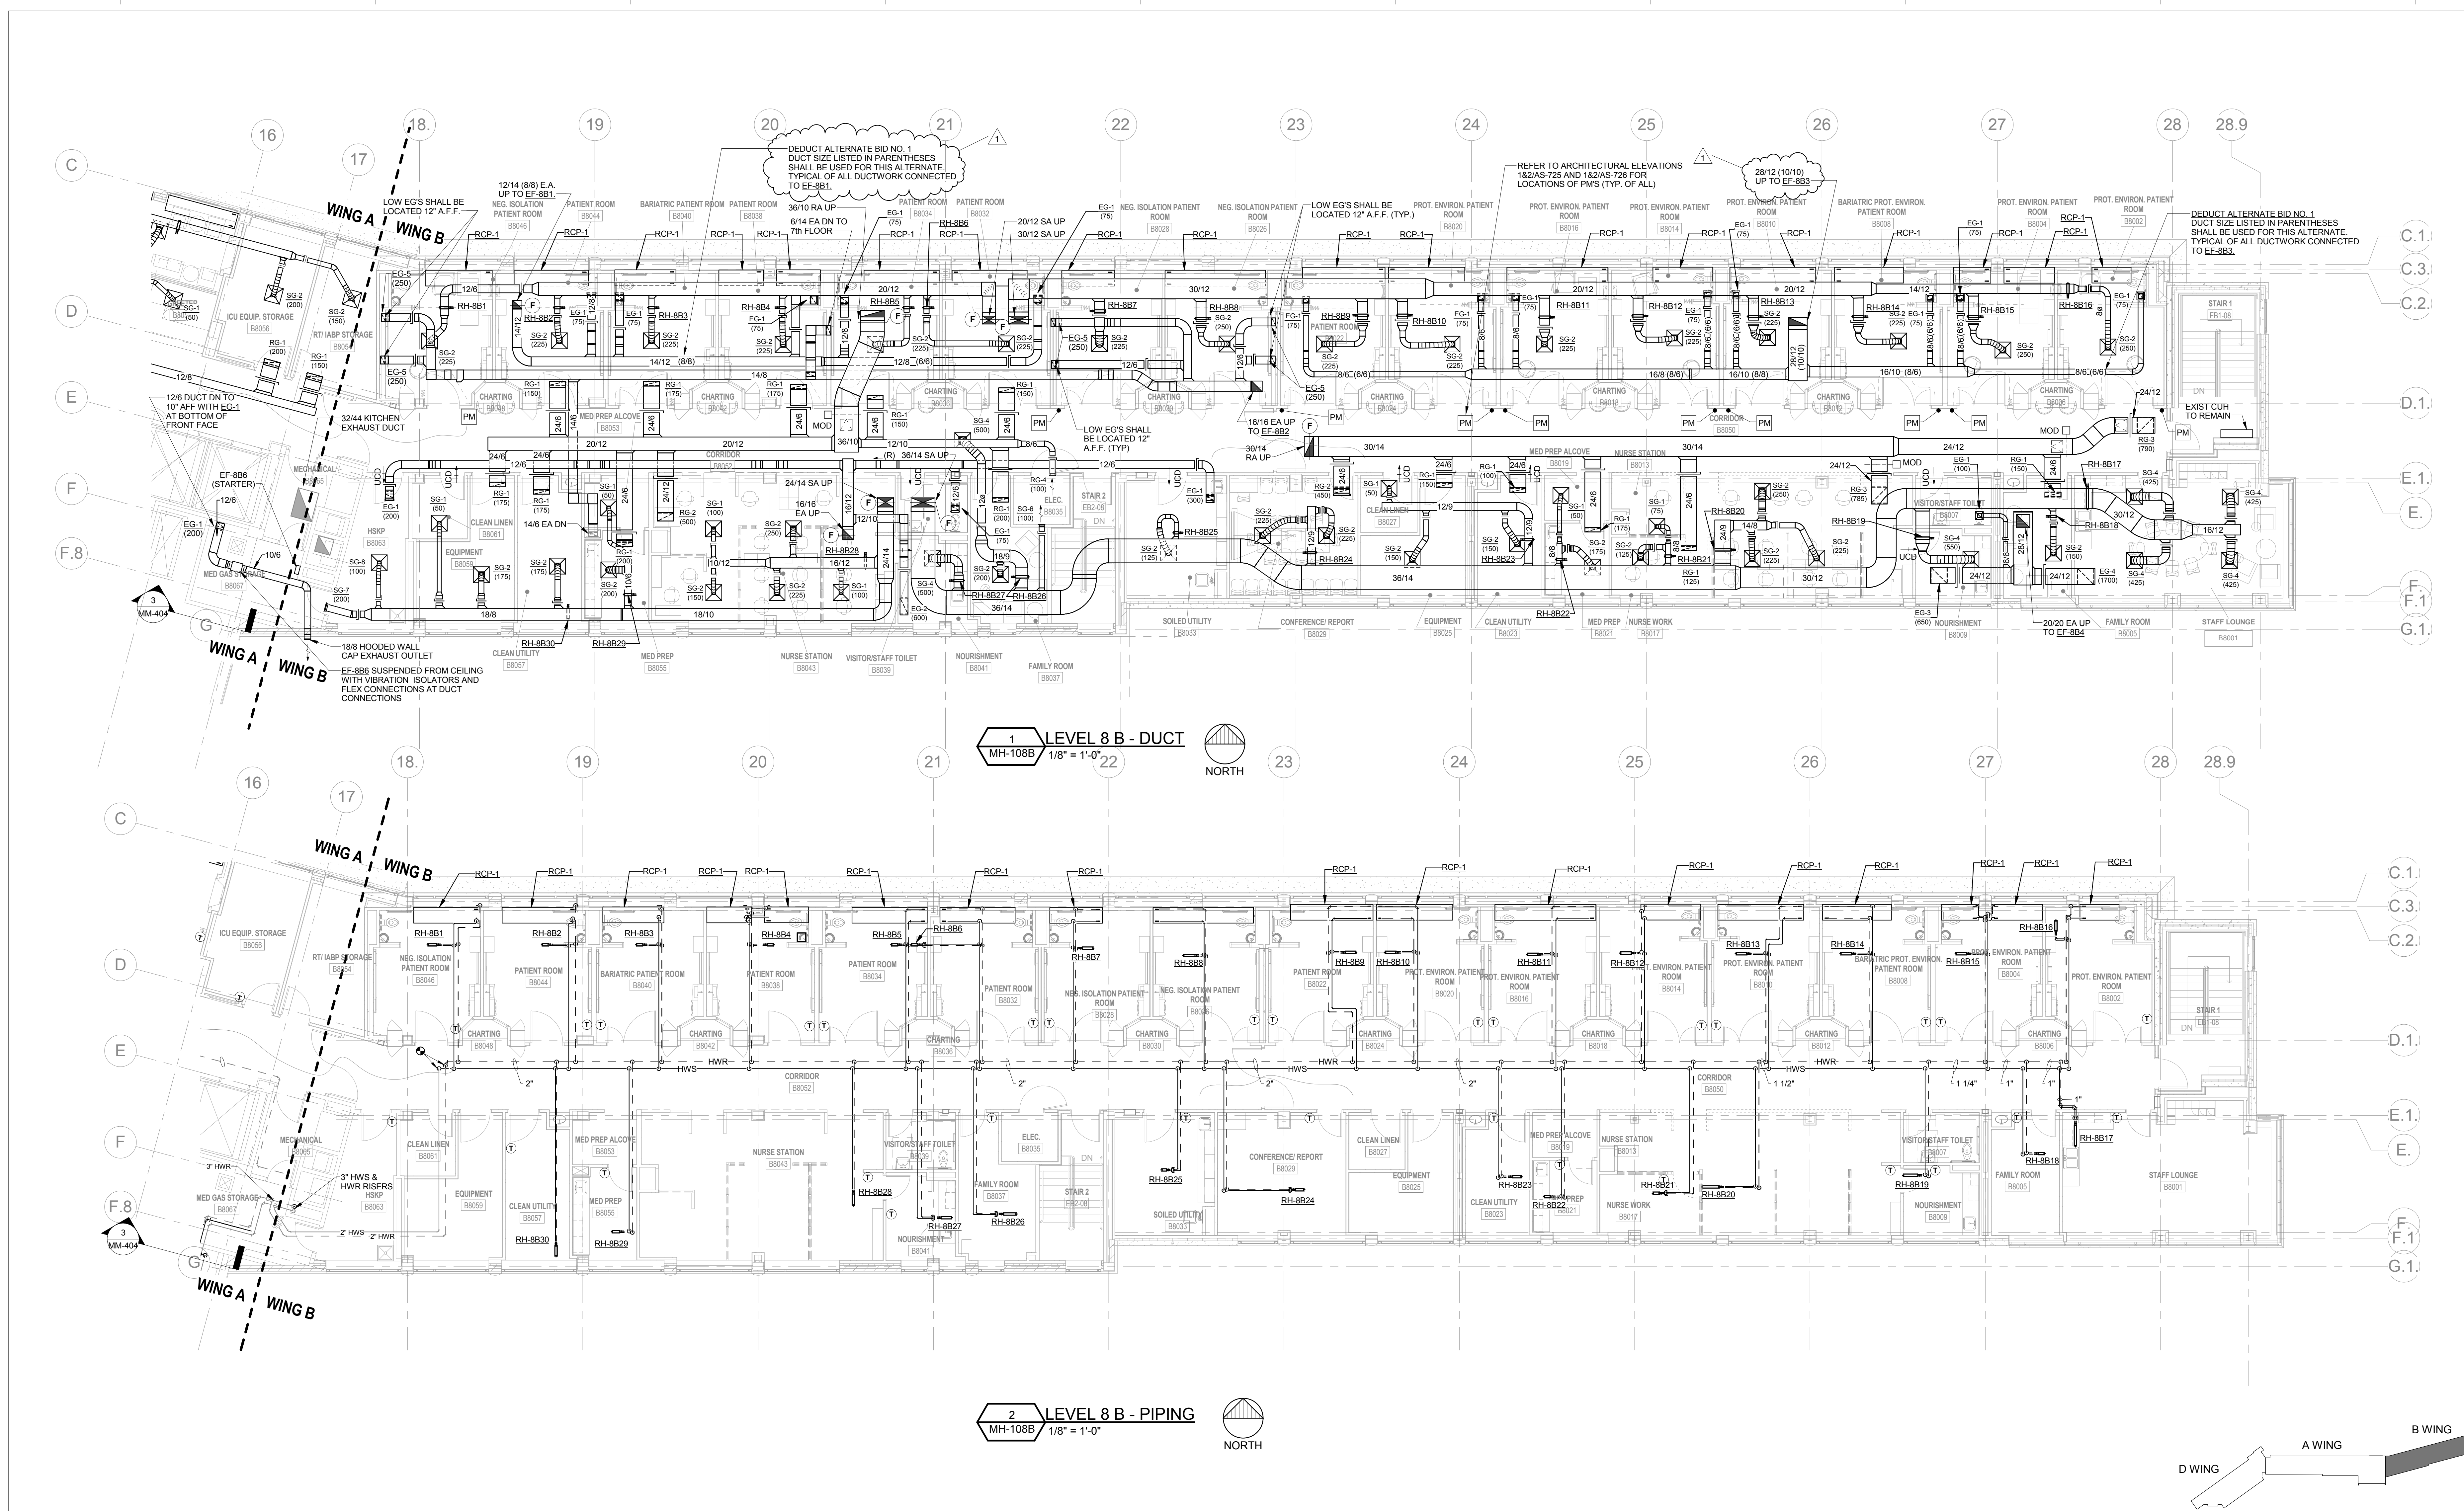

ENGINEERS: GMA Engineers 6402 Clara Road, Madison, WI 53719 Phone: 608.285.1108 / Fax: 608.285.1109		ARCHITECT: Kahler Slater experience design Copyright © 2013 Kahler Slater, Inc. All rights reserved. 111 West Wisconsin Avenue, Milwaukee, WI 53203 Telephone 414.272.2000 / Fax 414.272.2001 44 East Milin Street, Suite 700, Madison, Wisconsin 53703 Telephone 608.283.6300 / Fax 608.283.6317		Drawing Title LEVEL 8 B - HVAC Approved: Project Director		Project Title WM. S. MIDDLETON MEMORIAL VETERAN'S HOSPITAL CONSOLIDATE ICUs, 8A/8B Location MADISON, WI Date DECEMBER 5, 2013 Checked WS Drawn RA		Project Number 607-394 Building Number 1 Drawing Number MH-108B Dwg. 43 of 109		Office of Construction and Facilities Management	
Revisions: Addendum 1 03/10/2014											