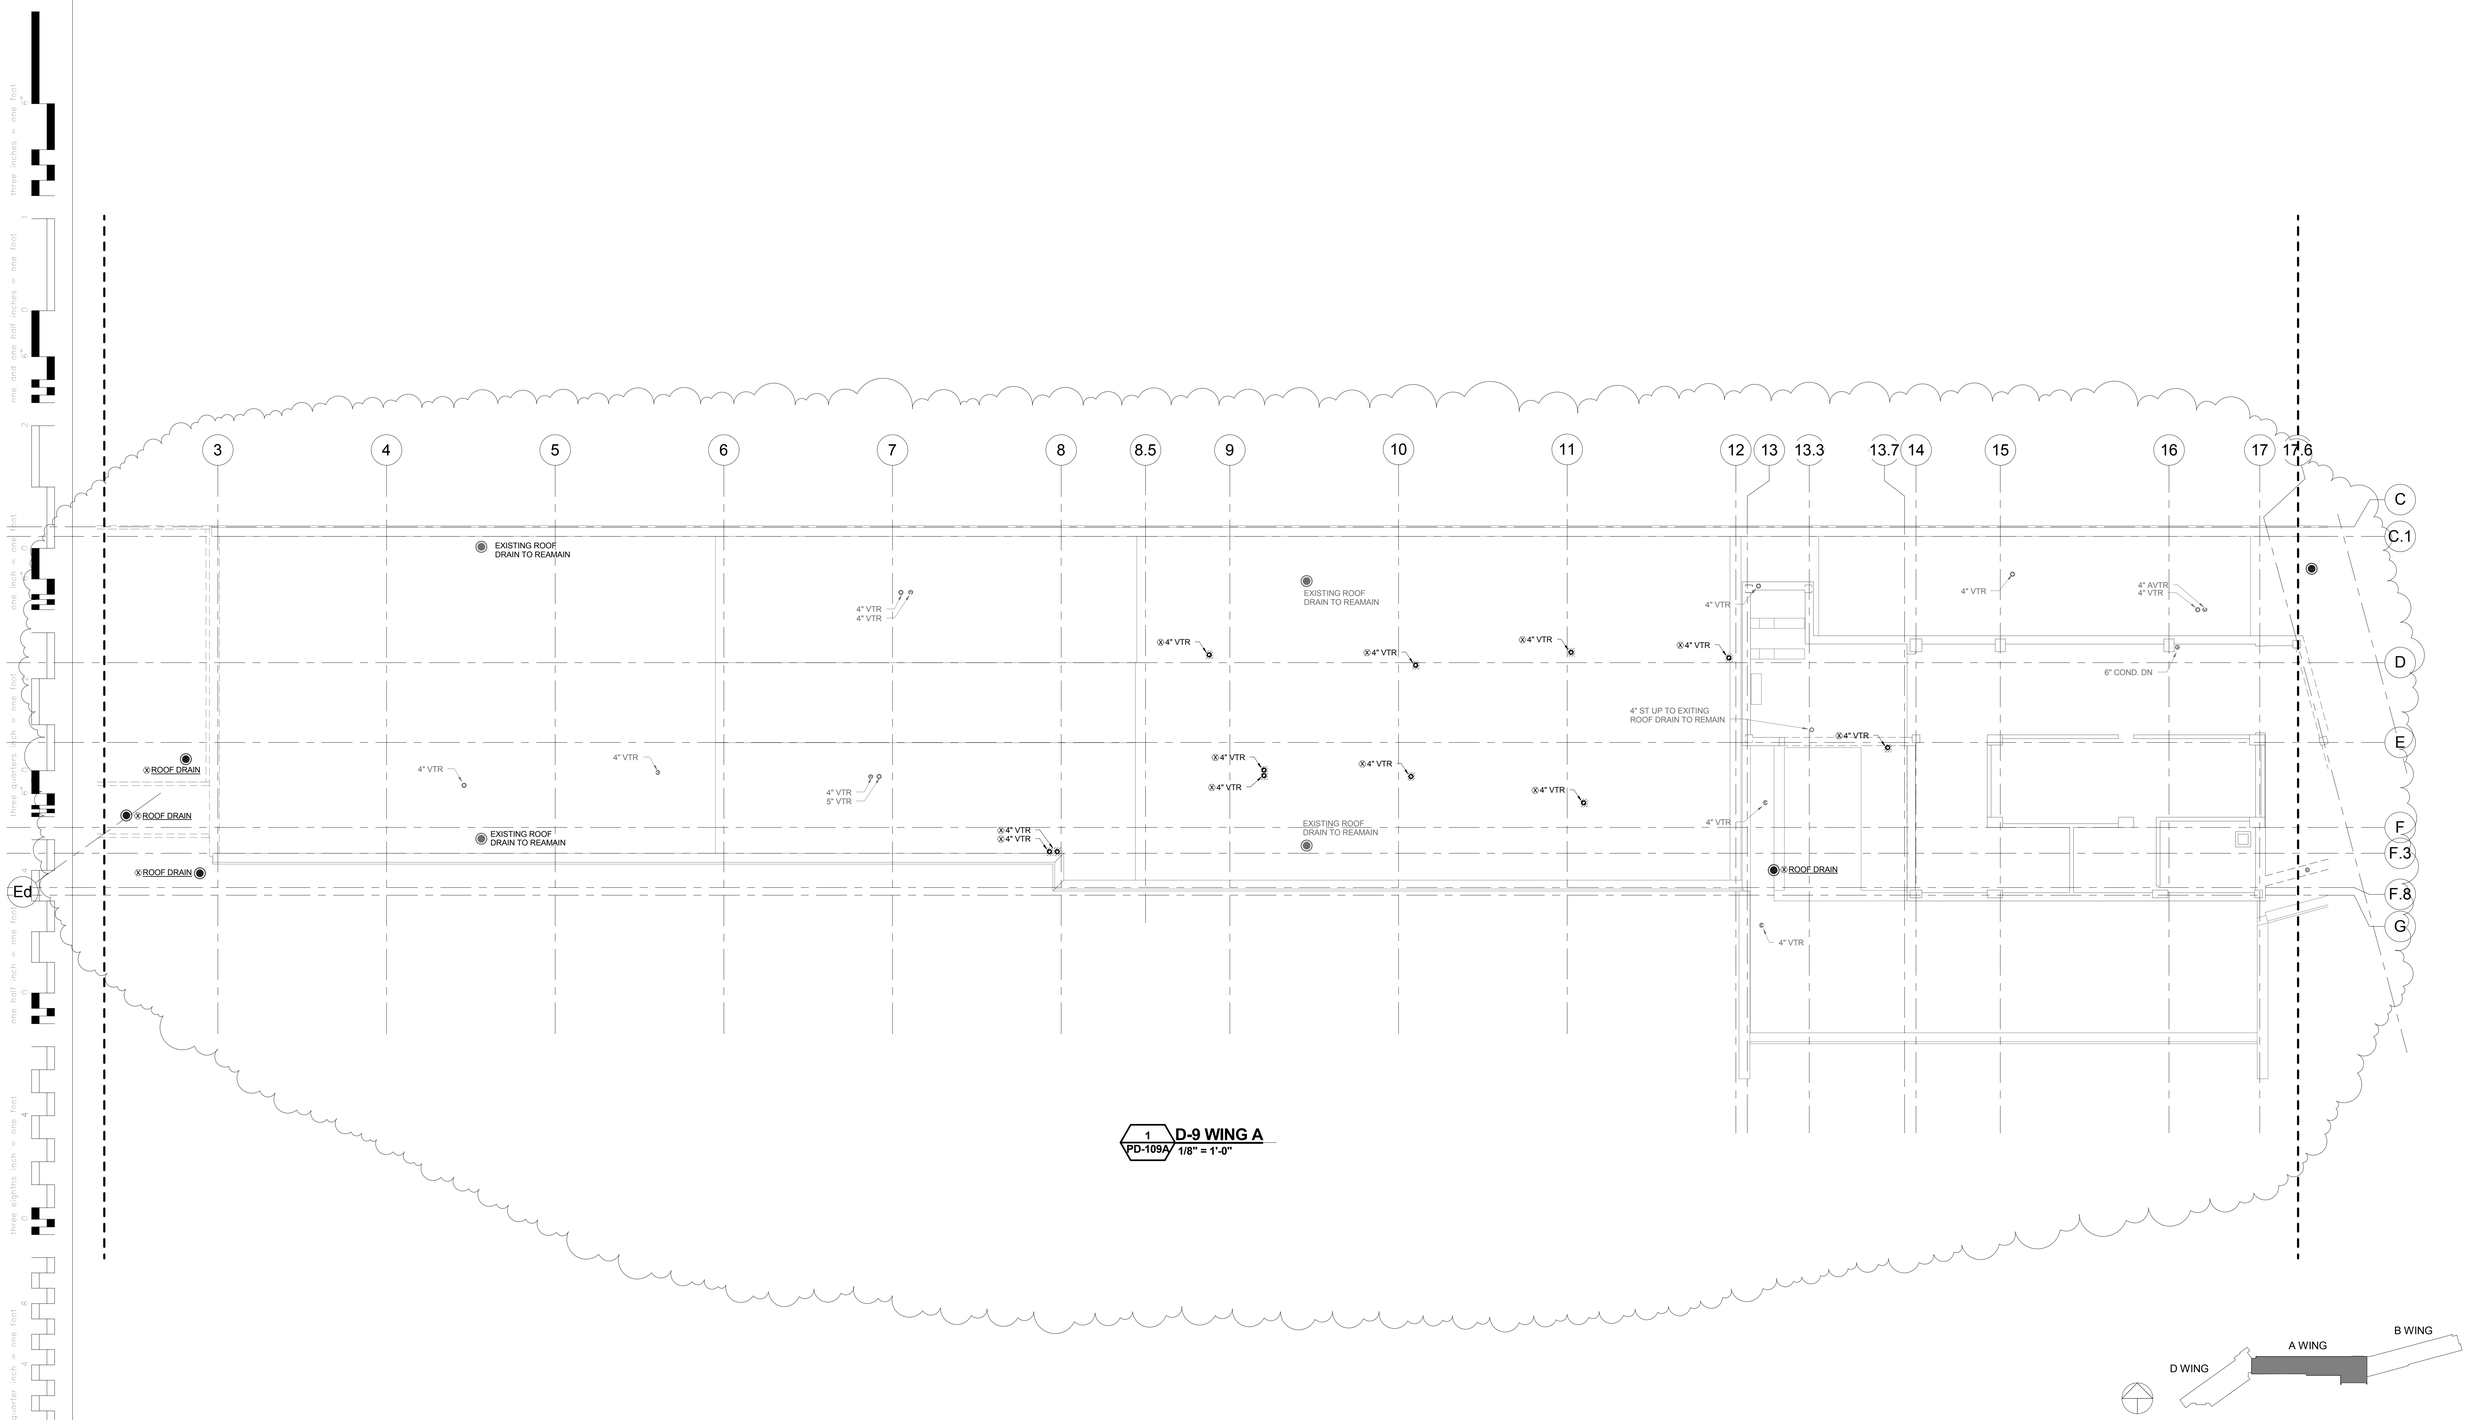

Revisions:	Date
Addendum 1	03-10-14

ENGINEERS:

GMA Engineers
6402 Odana Road, Madison, WI 53719
Phone: 608.288.1108 / Fax: 608.288.1109

RING & DUCHATEAU
10101 Innovation Drive - Suite 200, Milwaukee, WI 53266
Phone: 414.778.1700 / Fax: 414.778.2360 / r-d@ringdu.com

ARCHITECT:

Kahler Slater
experience design

Copyright © 2012 Kahler Slater, Inc. All rights reserved.

111 West Wisconsin Avenue, Milwaukee, Wisconsin 53203
Telephone 414.272.2000 Fax 414.272.2001

44 East Mifflin Street, Suite 700, Madison, Wisconsin 53703
Telephone 608.283.6300 Fax 608.283.6317

Kahler Slater Project No.
211033.00

Drawing Title
Plumbing Demolition Plan Level 9 / Wing A

Approved: Project Director

Project Title
WM. S. MIDDLETON MEMORIAL VETERAN'S HOSPITAL CONSOLIDATE ICUs, 8A/8B

Location
MADISON, WI

Date: December 5, 2013
Checked: WS
Drawn: RA

Project Number
607-394

Building Number
1

Drawing Number
PD-109A
Dwg. 21 of 109

Office of Construction and Facilities Management

VA FORM 08-6231

A00001