


three inches = one foot
 one and one half inches = one foot
 one inch = one foot
 three quarters inch = one foot
 one half inch = one foot
 three eighths inch = one foot
 one quarter inch = one foot
 one eighth inch = one foot

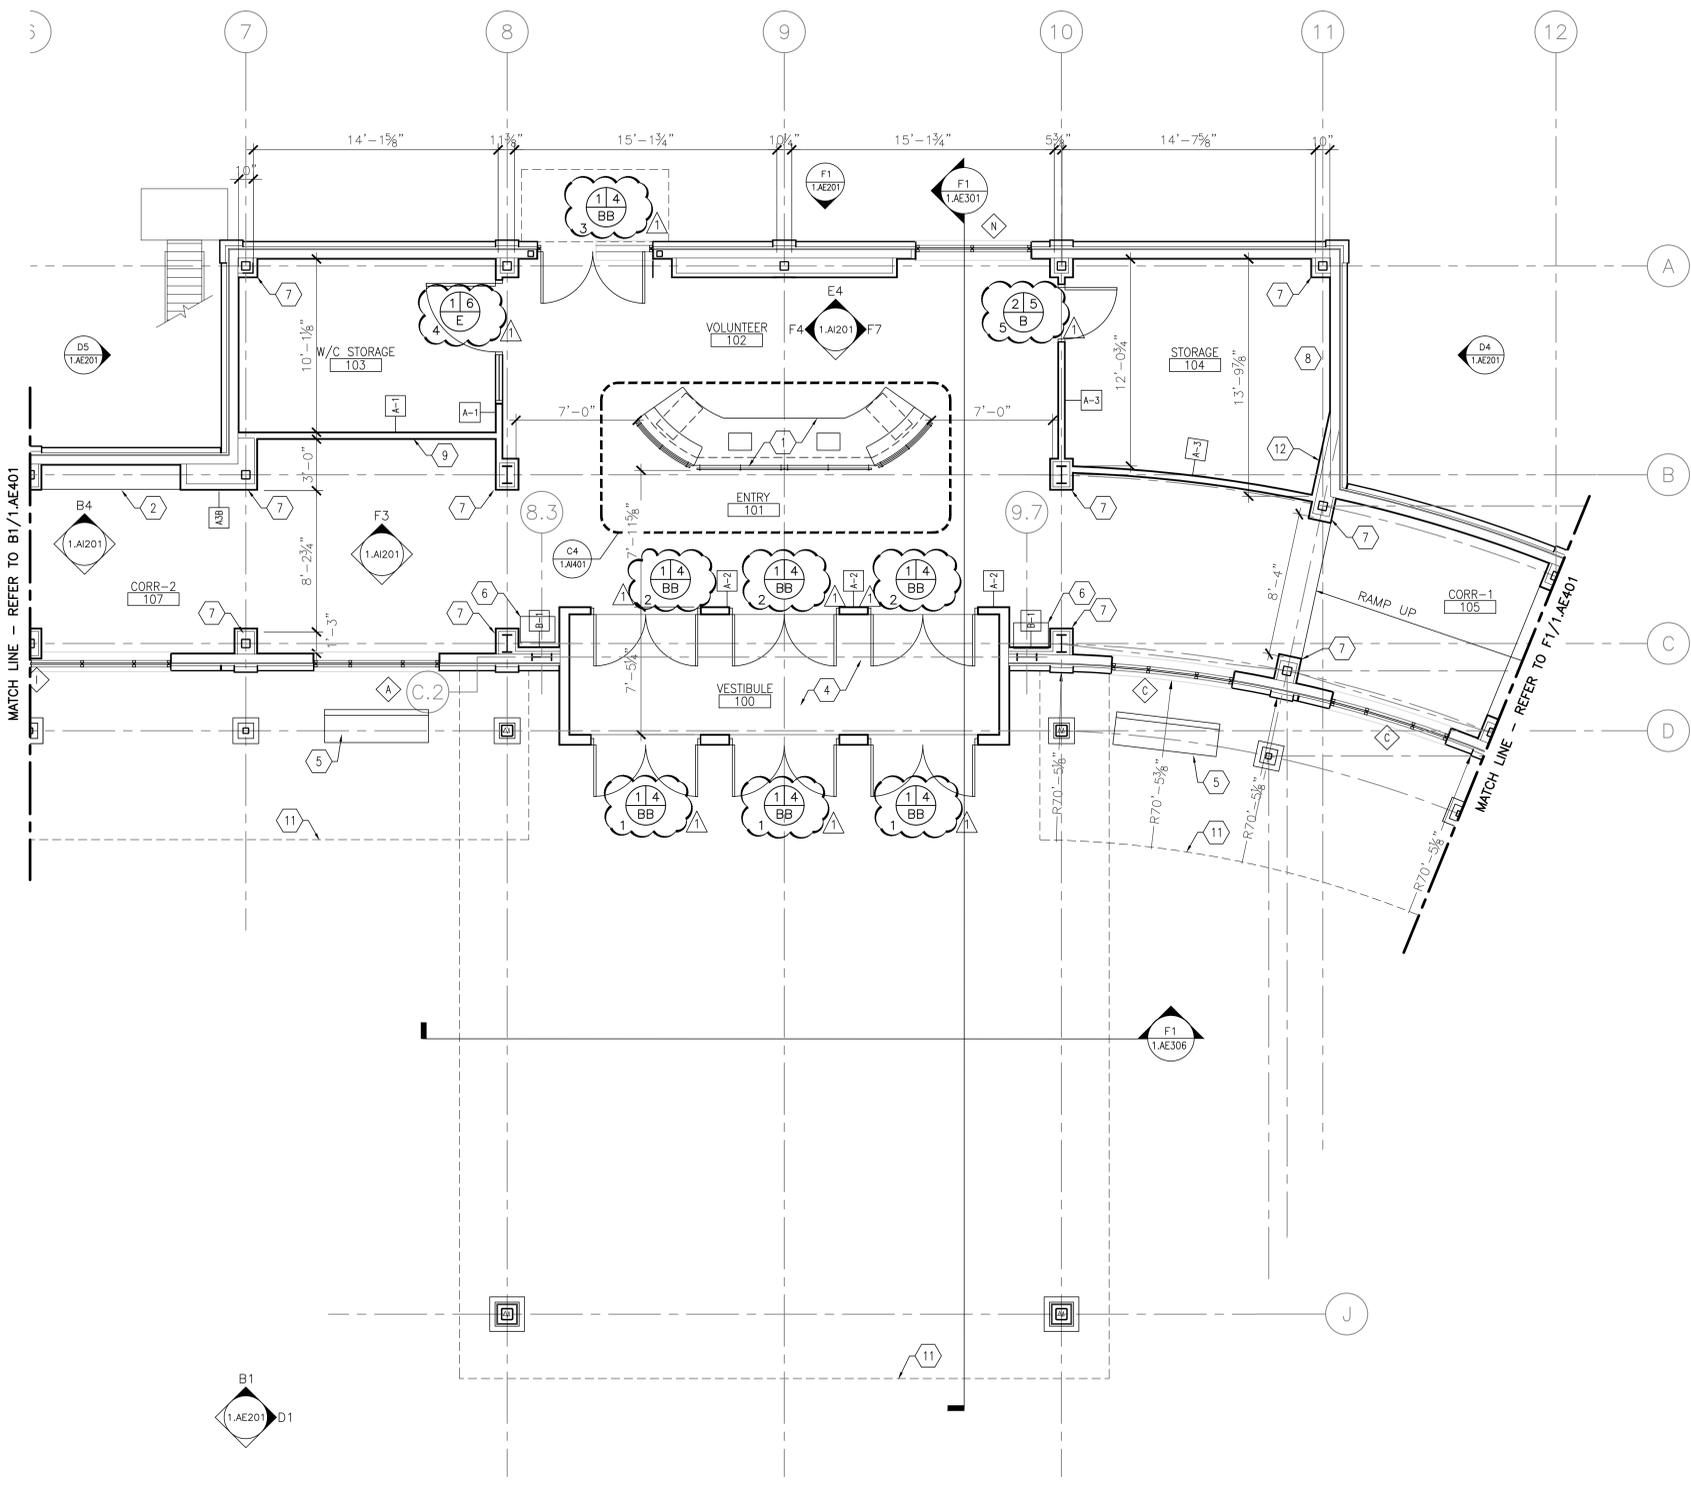

WALL LEGEND

- A-1 3 5/8" MTL STUD WALL STUDS @ 16" O.C. W/ (1) LAYER OF 5/8" GYP BOTH SIDES, 4" ABOVE CEILING
- A-2 3 5/8" MTL STUD WALL STUDS @ 16" O.C. W/ 4" BATT INSULATION, (1) LAYER OF 5/8" GYP BOTH SIDES.
- A-3 1 HOUR FIRERATED - 3 5/8" MTL STUD WALL STUDS @ 16" O.C. W/ SOUND ATTENUATION, (1) LAYER OF TYPE X GYP BOTH SIDES, TO DECK.
- A3B 3 5/8" MTL STUD WALL STUDS @ 16" O.C. W/ 5/8" GYP ONE SIDE.
- B-1 6" MTL STUD WALL STUDS @ 16" O.C. W/ 6" BATT INSULATION, (1) LAYER OF 5/8" GYP BOTH SIDES, 4" ABOVE CEILING
- B-2 6" MTL STUD WALL STUDS @ 16" O.C. W/ (1) LAYER OF 5/8" GYP BOTH SIDES.

NOTES


1. REFER TO 1.AE001 FOR ARCHITECTURAL SYMBOLS AND ABBREVIATIONS.
2. REFER TO MECHANICAL, ELECTRICAL, AND PLUMBING SHEETS FOR SPECIFIC NOTES FOR OTHER THAN GENERAL NOTES.
3. REFER TO 1.AI602 FOR GLAZING SCHEDULE AND DETAILS.
4. REFER TO 1.AI601 FOR DOOR SCHEDULE AND DETAILS.
5. REFER TO CIVIL DRAWINGS FOR NEW SITE WORK.
6. REFER TO AI AND ID SERIES DWGS FOR FINISH DETAILS.
7. ALL ELEVATIONS ARE REFERENCED WITH 100'-0" = 552.00' ON THE CIVIL DWGS.

KEY NOTES

- 1 VOLUNTEER COUNTER CASEWORK; REFER TO C4/1.AI401 FOR DETAILS.
- 2 INTERIOR BENCH, REFER TO ELEVATION A1/1.AI301.
- 3 (NOT USED)
- 4 RECESS SLAB 1/2" TO ACCOMMODATE WALK OFF MAT - SEE DETAIL B6/1.ID501 FOR DETAILS.
- 5 EXTERIOR CONCRETE BENCH; REFER TO CIVIL DWGS. FOR DETAILS.
- 6 EMERGENCY CALL BOX; REFER TO ELECTRICAL DWGS. FOR DETAILS.
- 7 COLUMN SURROUND CONSTRUCTION SIMILAR TO DETAIL F5/1.AE401. EXPAND TO DIMENSIONS SHOWN AS REQUIRED.
- 8 COMPUTER BASED BUILDING AUTOMATION SYSTEM LOCATION.
- 9 DONOR WALL, REFER TO 1.AI301 FOR MORE INFORMATION.
- 10 (NOT USED)
- 11 CANOPY ABOVE.
- 12 FRAME WALL BACK TO EXTERIOR WALL AS INDICATED. CONSTRUCTION SIMILAR TO TYPE A3B WALL.

LEGEND

- NEW DOORS
- EXISTING DOORS TO REMAIN
- NEW WALLS
- EXISTING WALLS TO REMAIN
- WINDOW TAG; REFER TO 1.AI602 FOR DETAILS

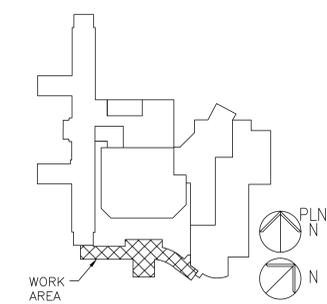

F1 ENLARGED FLOOR PLAN
 1/4"=1'-0"

Revision	01-10-14	CONSULTANTS:	ARCHITECT/ENGINEERS:		Drawing Title: ENLARGED FLOOR PLANS	Project Title: NEW FRONT ENTRANCE BUILDING 1	Project Number: 595-11-125	Office of Construction and Facilities Management
Revision 1	03/18/14				Approved Project Director	Location: LEBANON VAMC 7700 SOUTH LINCOLN AVE, LEBANON PA 17042-7529	Building Number: 1	
Revisions:	Date		200 Envoy Circle #201, Louisville KY 40299 - PH: 502.339.8511 - www.paradigmusa.com		Date: 06-28-2013	Checked: BYG	Drawn: JDM	