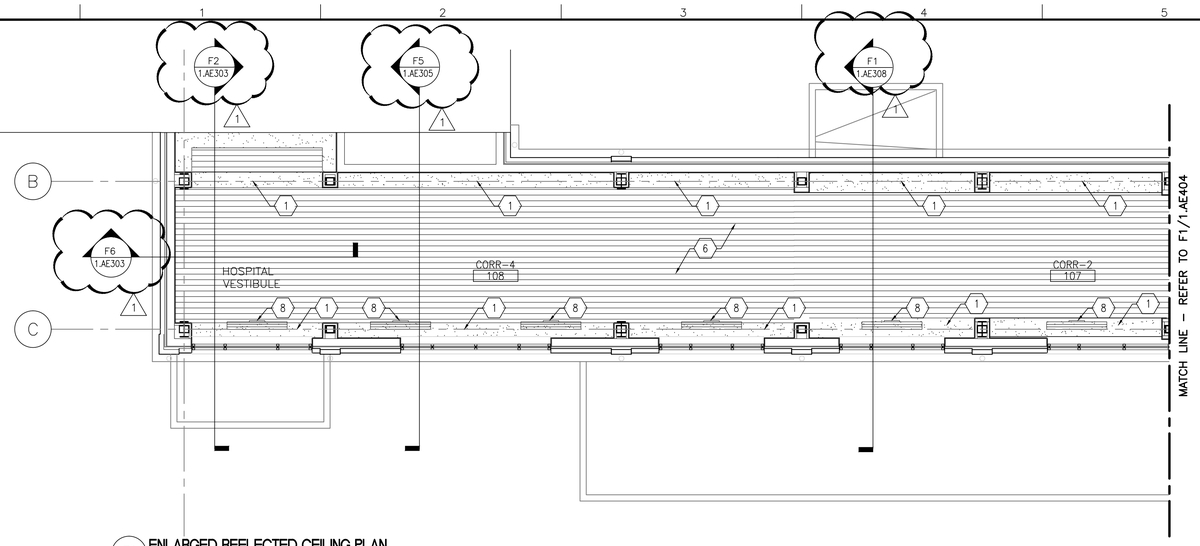

B1 ENLARGED REFLECTED CEILING PLAN
1/4"=1'-0"

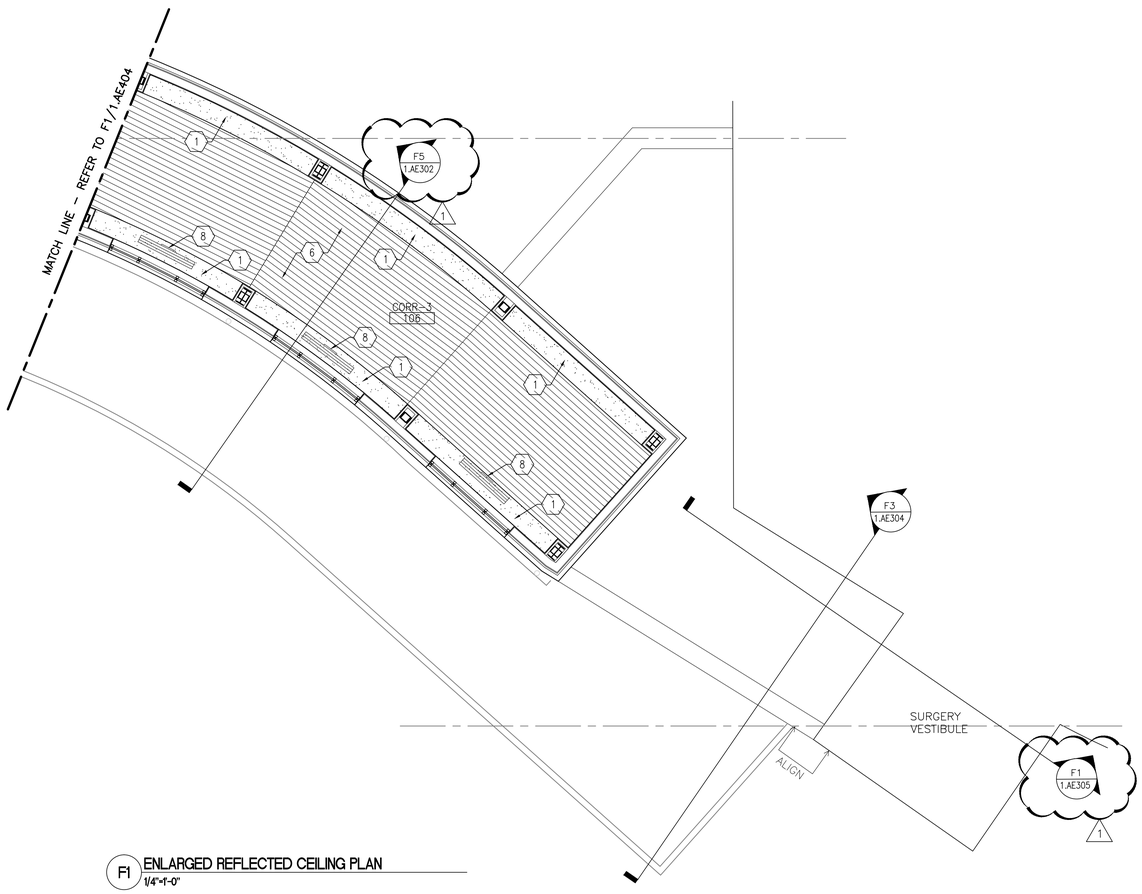

F1 ENLARGED REFLECTED CEILING PLAN
1/4"=1'-0"

NOTES

1. ACOUSTICAL LAY–IN CEILING TILE TO BE ARMSTRONG 584 CIRRUS ANGLED TEGULAR (#584), REFER TO FINISH SCHEDULE 1.ID601.
2. CONTRACTOR TO COORDINATE WITH OTHER TRADES.

KEY NOTES

1. GYPSUM BOARD SOFFIT.
2. (NOT USED)
3. 2' x 2' ACT CEILING @ 9'–0" A.F.F.
4. GYP. SOFFIT OVER DESK @ 8'–0" A.F.F; REFER TO F1/1.AE103 FOR DETAILS.
5. TAPERED WOOD CEILING PANEL SYSTEM; REFER TO B1/1.AI503 AND B3/1.AI503 FOR DETAILS.
6. METAL CEILING PANEL SYSTEM; REFER TO A6/1.AE103 FOR DETAILS.
7. SUSPENDED GYPSUM BOARD CEILING.
8. HVAC DIFFUSER; REFER TO MECHANICAL PLANS FOR DETAILS.

LEGEND

- SUSPENDED GYPSUM BOARD CEILING
- METAL CEILING PANEL SYSTEM
- TAPERED WOOD CEILING PANEL SYSTEM
- 2X2 ACOUSTICAL LAY–IN CEILING TILE
- 2'x4' FLUORESCENT LIGHT FIXTURE, REFER TO ELECTRICAL DRAWINGS.
- 2'x2' FLUORESCENT LIGHT FIXTURE, REFER TO ELECTRICAL DRAWINGS.
- RECESSED LIGHT FIXTURE, REFER TO ELECTRICAL DRAWINGS.
- 1'x4' FLUORESCENT LIGHT FIXTURE, REFER TO ELECTRICAL DRAWINGS.
- RETURN AIR DEVICE, REFER TO MECHANICAL DRAWINGS.
- SUPPY AIR DEVICE, REFER TO MECHANICAL DRAWINGS.

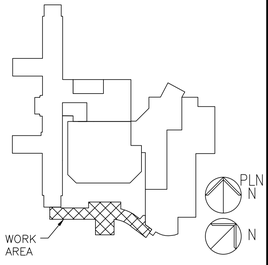

KEYPLAN – NOT TO SCALE

FULLY SPRINKLERED
BID DOCUMENTS 08-23-2013

Revision	01-10-14
REVISION 1	03/18/14
Revisions:	Date

CONSULTANTS:

ARCHITECT/ENGINEERS:

PARADIGM
ENGINEERS AND CONSTRUCTORS
200 Envoy Circle #201, Louisville KY 40299 – PH: 502.339.8511 – www.paradigmusa.com

COMMONWEALTH OF PENNSYLVANIA
REGISTERED PROFESSIONAL
BLAINE VAN GANSBEKE
ENGINEER
No. PE079536

Drawing Title: ENLARGED CLERESTORY REFLECTED CEILING PLANS

Approved: Project Director

Project Title: NEW FRONT ENTRANCE BUILDING 1

Location: LEBANON VAMC
1700 SOUTH LINCOLN AVE, LEBANON PA 17042-7529

Date: 06-28-2013 | Checked: BVG | Drawn: JDM

Project Number: 595-11-125

Building Number: 1

Drawing Number: 1.AE405

Office of Construction and Facilities Management

Department of Veterans Affairs

VA FORM 08–6231