



5960 Fairview Road
Suite 500
Charlotte, NC 28210

704
887.3500
887.3507 fax

Consultants

MECHANICAL/ELECTRICAL/PLUMBING/FIRE PROTECTION:

AME Consulting Engineers, PC
421 Penman Street, Suite 200
Charlotte, NC 28203
NC License: C-2848
704.295.4263 PHONE
704.295.7543 FAX

STRUCTURAL:

ZAPATA, Inc.
6302 Fairview Rd., Ste. 600
Charlotte, NC 28210
704.378.4923 PHONE
704.358.8342 FAX

CIVIL:
COLEJENEST & STONE, P.A.
230 South Tryon Street, Suite 1400
Charlotte, North Carolina 28202
704.378.1555 PHONE
704.378.7851 FAX

Project

**VAMC Salisbury
Building 42 Additions &
Renovation - Phase III**

City, State
Salisbury, NC

VA Project Number
659-335

Issued For

Construction

Item	Date	Description
△	3-17-14	Amendment #A00007

Drawn By **JGU**
Checked By **MJM**

Seal / Signature




Sheet Title

**Plumbing - Partial
Second Floor Medical
Gas Plan - Area C**

Date **December 21, 2012**


Sheet Number

P421C

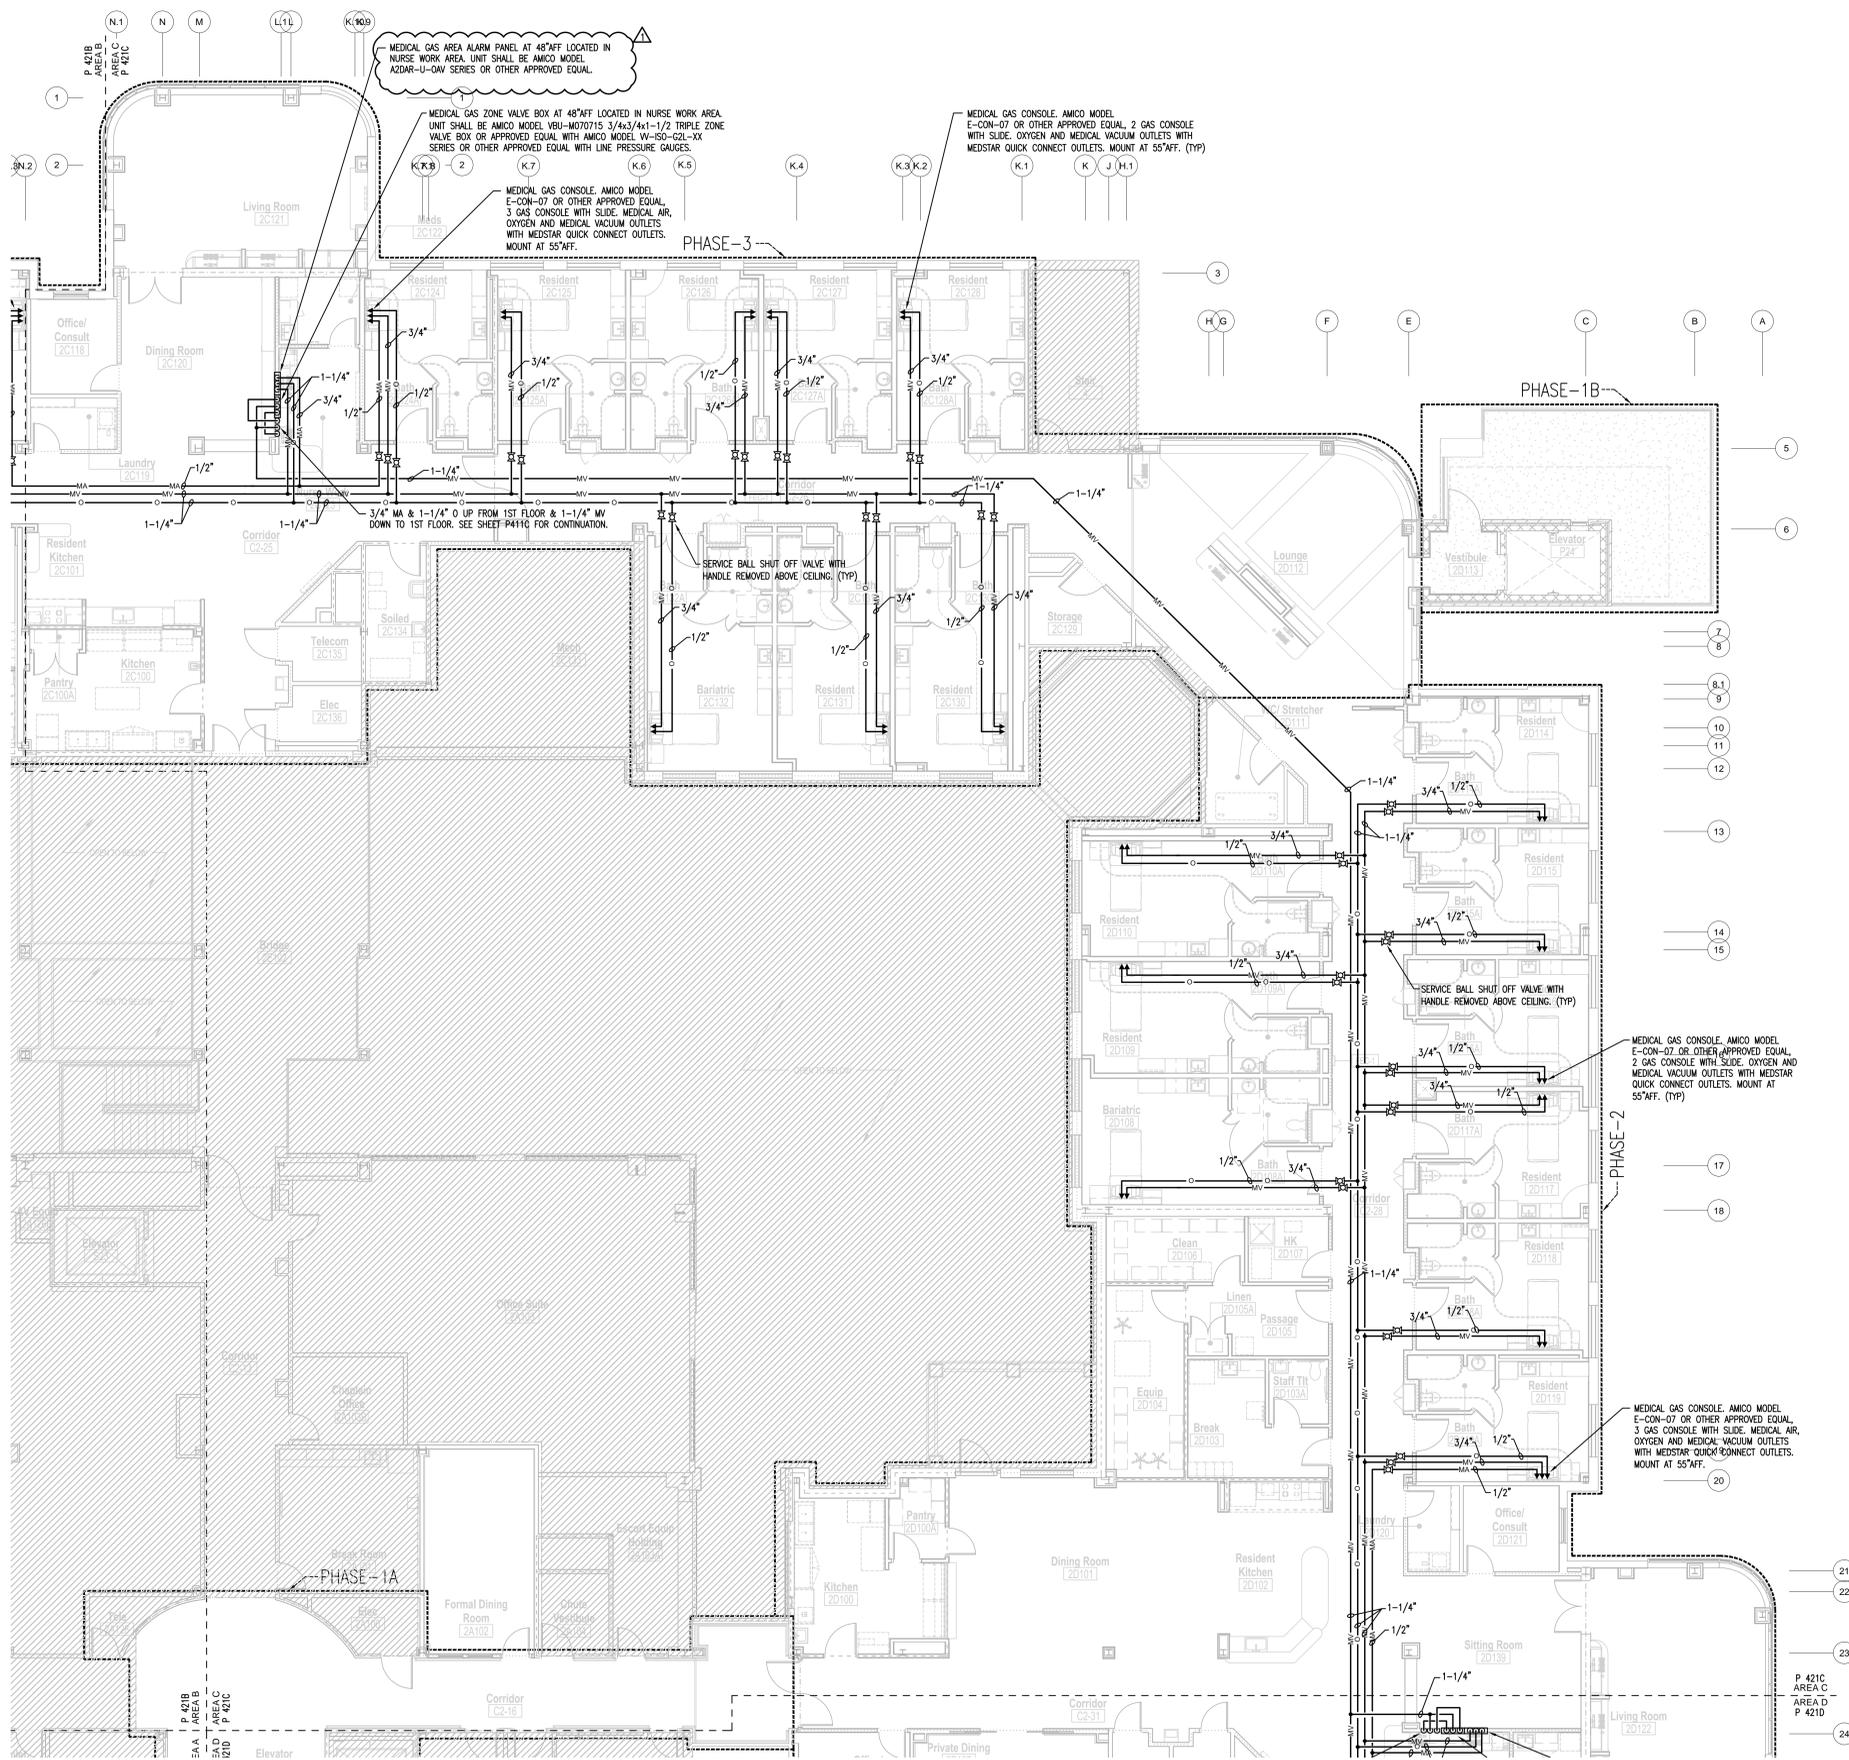

Life Safety Legend

Non-Rated Smoke Tight
1 Hour Fire Rated Barrier
1 Hour Smoke Barrier
2 Hour Fire Rated Barrier
2 Hour Smoke Barrier
3 Hour Fire Rated Barrier
3 Hour Smoke Barrier

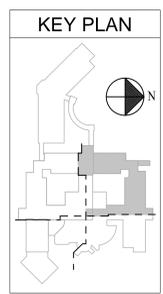

PLUMBING - PARTIAL SECOND FLOOR MEDICAL GAS PLAN - AREA C
SCALE: 1/8" = 1'-0"

This document is the property of RPA Design and RPA Design retains all rights therein. It may only be used in a manner consistent with RPA Design's terms and conditions. It may not be used for any other purpose without the express written agreement of, and compensation to, RPA Design.

3/17/2014 1:06:41 PM X:\2011 Projects\11065 VA Salisbury - Phase III\Design\Plumbing\11065 P421c SECOND MED GAS NEW.dwg