



5960 Fairview Road  
Suite 500  
Charlotte, NC 28210

704  
887.3500  
887.3507 fax

Consultants

MECHANICAL/ELECTRICAL/PLUMBING/FIRE PROTECTION:

**AME Consulting Engineers, PC**

421 Pennman Street, Suite 200  
Charlotte, NC 28203  
NC License: C-2848  
704.295.4263 PHONE  
704.295.7543 FAX

STRUCTURAL:

**ZAPATA, Inc.**

6302 Fairview Rd., Ste. 600  
Charlotte, NC 28210  
704.378.4923 PHONE  
704.358.8342 FAX

CIVIL:

**COLEJENEST & STONE, P.A.**

200 South Tryon Street, Suite 1400  
Charlotte, North Carolina 28202  
704.378.1555 PHONE  
704.378.7851 FAX

Project

**VAMC Salisbury  
Building 42 Additions &  
Renovation - Phase III**

City, State  
**Salisbury, NC**

VA Project Number  
**659-335**

Issued For

**Construction**

Item	Date	Description
1	3-17-14	Amendment #A00007

Drawn By **JGU**  
Checked By **MJM**

Seal / Signature




Sheet Title

**Plumbing - Partial  
Second Floor Medical  
Gas Plan - Area D**

Date December 21, 2012

Sheet Number

**P421D**

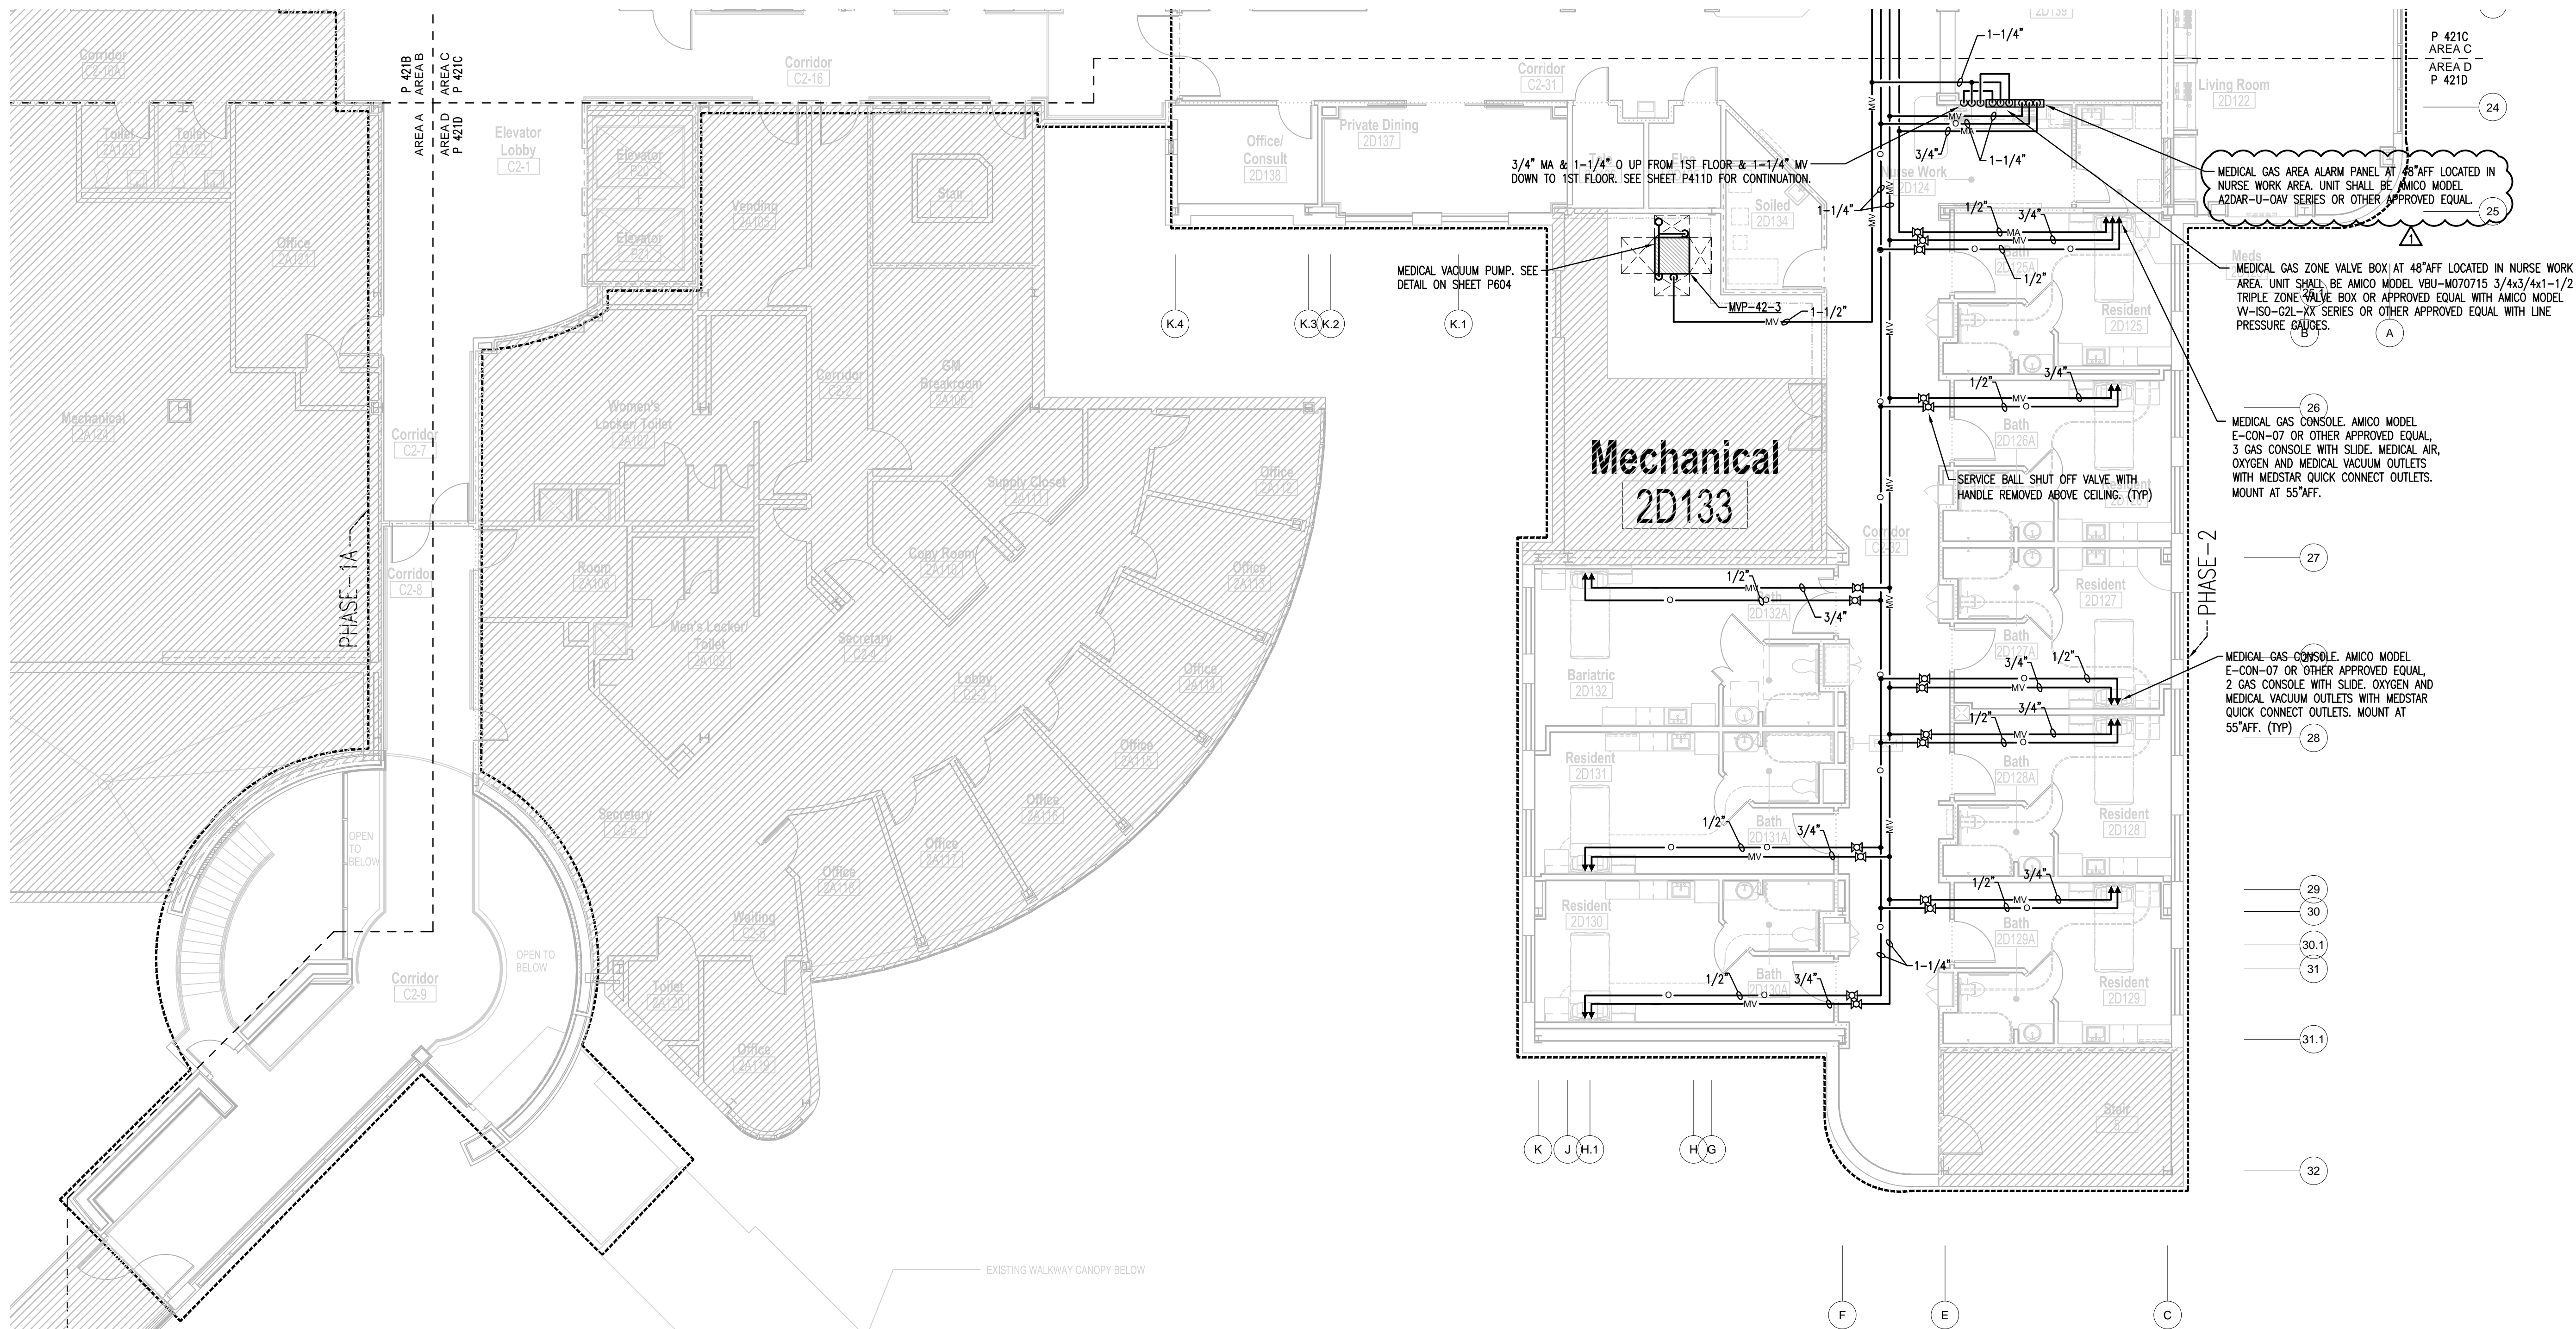

**PLUMBING - PARTIAL SECOND FLOOR MEDICAL GAS PLAN - AREA D**

SCALE: 1/8" = 1'-0"

**Life Safety Legend**

Non-Rated Smoke Tight	-----
1 Hour Fire Rated Barrier	=====
1 Hour Smoke Barrier	-----
2 Hour Fire Rated Barrier	=====
2 Hour Smoke Barrier	-----
3 Hour Fire Rated Barrier	=====
3 Hour Smoke Barrier	-----

**KEY PLAN**

