


- NEW WORK NOTE:**
1. INSTALL NEW TENNIS COURT SURFACE. COLORS TO BE BLUE COURT AND GREEN SURROUND.
 2. CONTRACTOR TO HIRE NY CERTIFIED ARBORIST TO TRIM 2 LARGE (16") BRANCHES AND 1 SMALLER BRANCH (10"). HEIGHT IS APPROXIMATELY 35' ABOVE GRADE.

- BASKETBALL NOTES:**
1. LINES ARE 2" WIDE. COLOR TO BE A LIGHTER SHADE OF COURT COLOR.
I.E. LIGHT BLUE ON DARK BLUE TENNIS COURT AND LIGHT GREEN ON DARK GREEN COURT SURROUND.
 2. BASKETBALL POLE TO BE INSTALLED OUTSIDE TENNIS COURT FENCE. SEE DETAIL (3) (L201)

INSTALL NEW 6'-0" WIDE MINIMUM CONCRETE PATHWAY FROM ROAD TO BLEACHERS. SEE DETAIL (6) (L201)

NEW 10'X10'X12" THICK CONCRETE PAD FOR NEW BLEACHERS. TOP OF CONCRETE TO BE 2" ABOVE GRADE.

NEW BLEACHERS

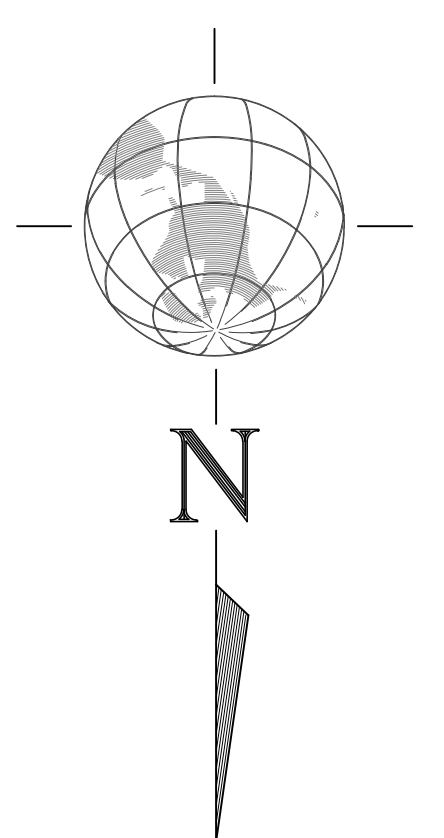

0' 4' 8' 20' 40'
2'
SCALE: 1/8" = 1'-0"

ADDENDUM 1	3/25/14
Revisions	Date

Engineer:

EVERETT ENGINEERS

1740 MASSACHUSETTS AVE., SUITE D
BOXBOROUGH, MA 01710
PHONE: 978-268-3711
FAX: 978-268-3712

ALL WORK TO BE IN ACCORDANCE WITH N.F.P.A., NATIONAL STATE AND CITY CODES & O.S.H.A.	
Approved: Logistics Manager.	Date
Approved: Infection Control Mgr.	Date
Approved: Chief Security	Date

Approved: A.F.G.E.	Date
Approved: Interior Designer	Date
Approved: Info. Sys.	Date
Approved: Women's Health Rep	Date

Approved: Fire Chief	Date
Approved: Safety Officer	Date
Approved: Industrial Hygienist	Date
Approved: Space Owner	Date

Approved: Energy Engineer	Date
Approved: M&R Foreman	Date
	Date
	Date

Drawing Title NEW WORK PLAN	
Approved: Eng. Project Supervisor	Date
Approved: Medical Center Director	Date

Project Title RENOVATE TENNIS AND BASKETBALL COURTS	
Building No. N/A	Checked RAE
Location BATH, NEW YORK	Drawn JPS

Date 3/25/14
Project No. 528A6-13-636
DRAWING NO. L101
Dwg. 4 Of 11

