



1 ELEVATION - SIDE FENCE WITH OPEN MIDDLE
L201 SCALE: NOT TO SCALE

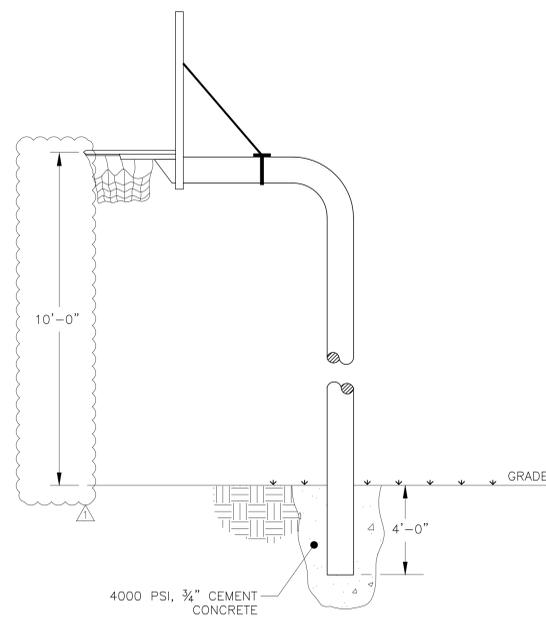

3 ELEVATION - BASKETBALL POLE
L201 SCALE: NOT TO SCALE

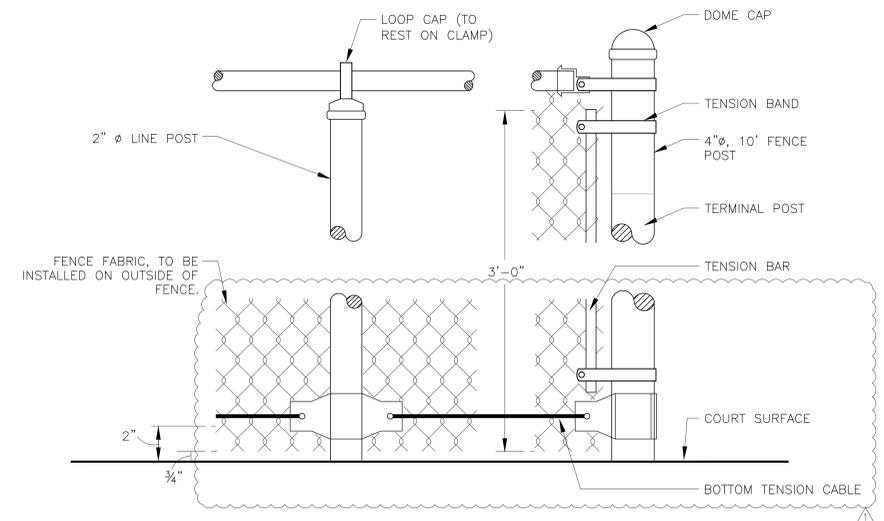

2 ELEVATION - ENLARGED FENCE DETAIL
L201 SCALE: NOT TO SCALE



ADDENDUM 1	3/25/14
Revisions	Date

Engineer:

EVERETT ENGINEERS

1740 MASSACHUSETTS AVE., SUITE D
 BOXBOROUGH, MA 01710
 PHONE: 978-268-3711
 FAX: 978-268-3712

ALL WORK TO BE IN ACCORDANCE WITH N.F.P.A., NATIONAL STATE AND CITY CODES & O.S.H.A.	
Approved: Logistics Manager.	Date
Approved: Infection Control Mgr.	Date
Approved: Chief Security	Date

Approved: A.F.G.E.	Date
Approved: Interior Designer	Date
Approved: Info. Sys.	Date
Approved: Women's Health Rep	Date

Approved: Fire Chief	Date
Approved: Safety Officer	Date
Approved: Industrial Hygienist	Date
Approved: Space Owner	Date

Approved: Energy Engineer	Date
Approved: M&R Foreman	Date
	Date
	Date

Drawing Title ELEVATIONS	
Approved: Eng. Project Supervisor	Date
Approved: Medical Center Director	Date

Project Title RENOVATE TENNIS AND BASKETBALL COURTS	
Building No. N/A	Checked RAE
Drawn JPS	Date
Location BATH, NEW YORK	

Date 3/25/14
Project No. 528A6-13-636
DRAWING NO. L201
Dwg. 6 Of 11

