

R.F.I.

(REQUEST FOR INFORMATION)

Project #:	664-14-105	RFI #:	
Project Name:	Occupational Therapy/Physical Therapy Renovation	Date Requested:	3/27/14
Solicitation No.:	VA262-14-B-0366	Reference:	
Drawing:	AE-102, AE-401	Specification Section:	

DESCRIPTION OF PROBLEM OR INFORMATION REQUESTED

Please be as specific as possible.

The finish schedule on Sheet AE-401 calls for Office room 1447 to receive vinyl sheet flooring (VSF). However, Room 1447 doesn't show on the remodel floor plan Sheet AE-102. Is this room part of the contract scope of work?

OWNER RESPONSE

Delete reference to and requirements for Room 1447 on Room Finish Schedule on Drawing Sheet AE-401.


OWNER TRACKING No.:

AMEND No.:


VA Project Engineer/Manager: *Michael Merino, RA*

Date: March 27, 2014

REVISED SHEET AE-303

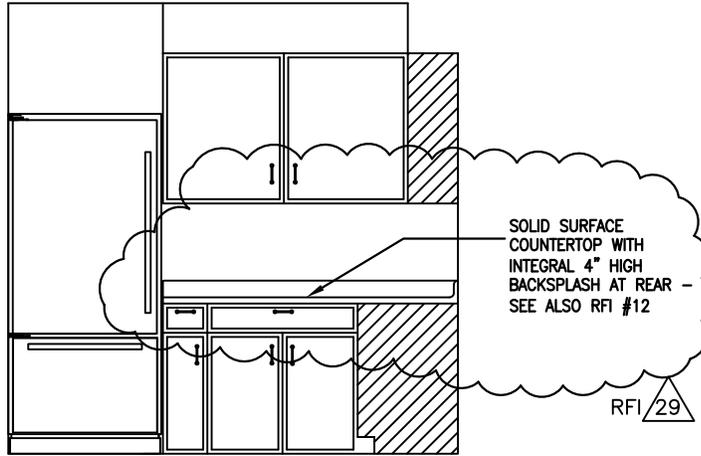

ⓑ 1469 S

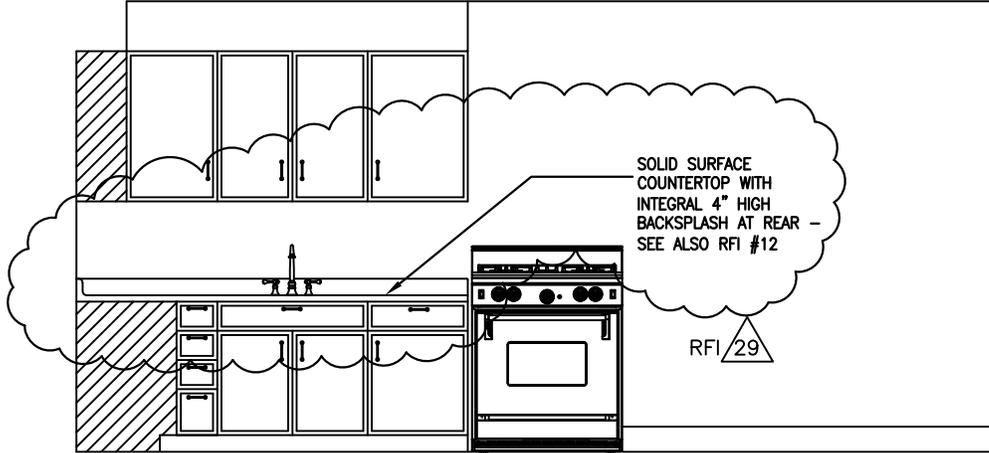

Ⓐ 1469 W

REVISED INTERIOR ELEVATIONS

1/4" = 1'-0"

RFI #29