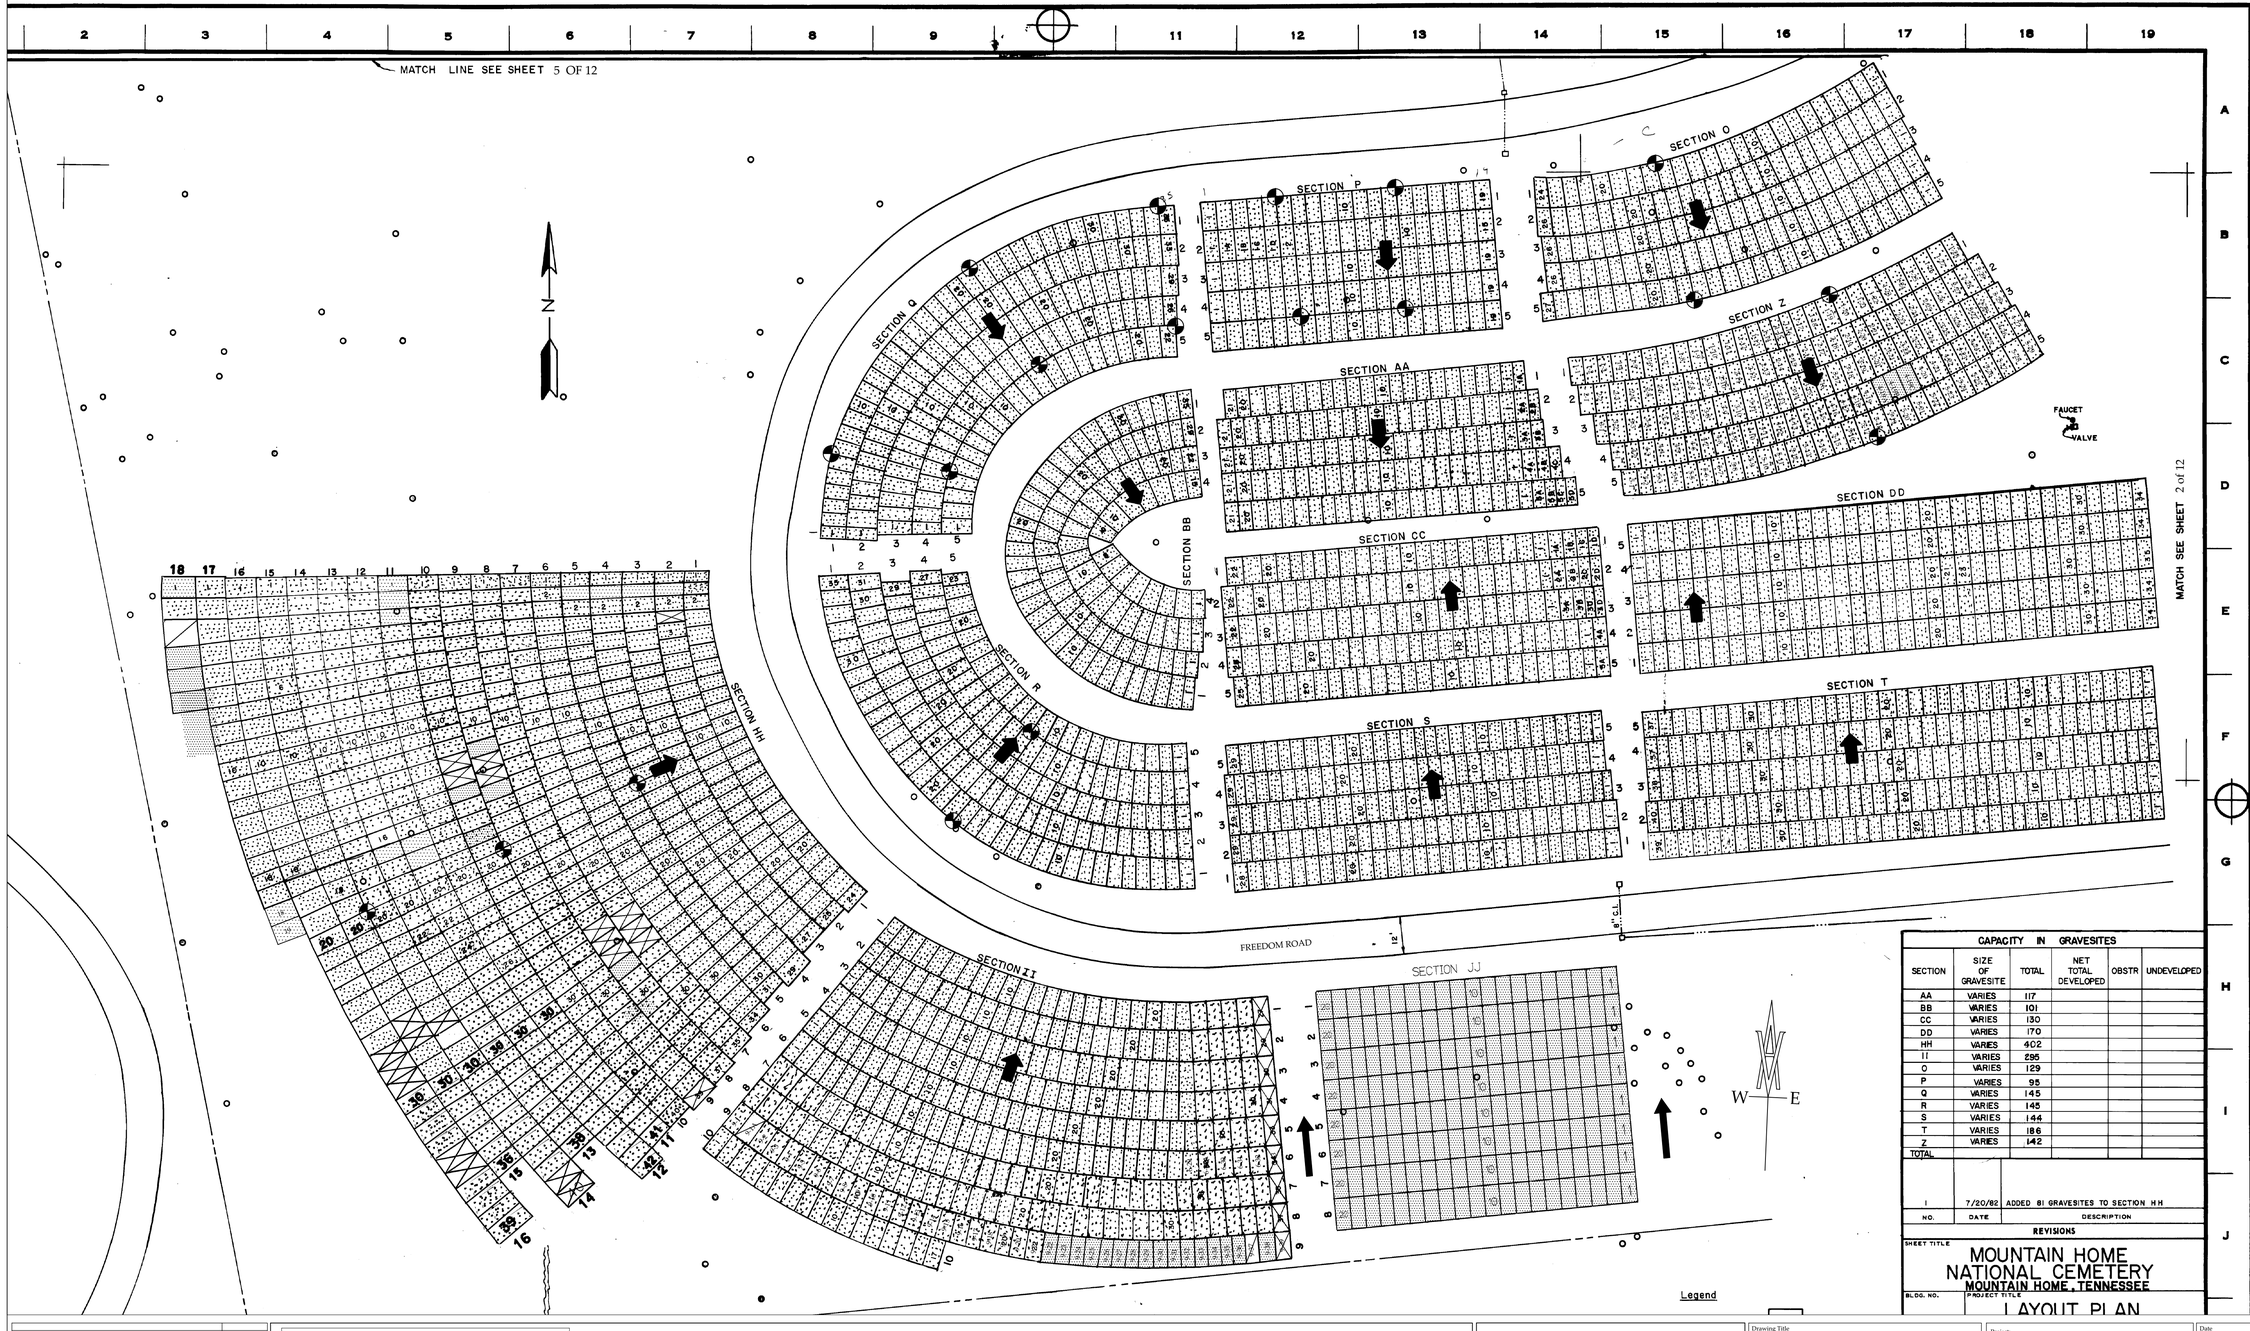

CAPACITY IN GRAVESITES					
SECTION	SIZE OF GRAVESITE	TOTAL	RES	AVAIL	OBST.
		SEE GBSAT			

Semi-Annual Update and BOSS Comparison	2/14/13
Semi-Annual Update and Corrections	6/12/12
Semi-Annual Update	12/13/11
Semi-Annual Update	6/13/11
Semi-Annual Update	11/3/10
Semi-Annual Update	5/10/10
Semi-Annual Update	10/1/09
Revisions	Date

Scale NTS

LEGEND
- AVAILABLE GRAVESITE
- SET ASIDE/RESERVED
- OBSTRUCTED GRAVESITE
- OCCUPIED GRAVESITE
- GRAVES FACE
- GRAVESITE CONTROL MONUMENT

CAPACITY IN GRAVESITES				
SECTION	SIZE OF GRAVESITE	TOTAL	NET TOTAL DEVELOPED	OBSTR	UNDEVELOPED
AA	VARIES	117			
BB	VARIES	101			
CC	VARIES	130			
DD	VARIES	170			
HH	VARIES	402			
II	VARIES	295			
O	VARIES	129			
P	VARIES	95			
Q	VARIES	145			
R	VARIES	145			
S	VARIES	144			
T	VARIES	186			
Z	VARIES	142			
TOTAL					

NO.	DATE	DESCRIPTION
1	7/20/82	ADDED 81 GRAVESITES TO SECTION HH

REVISIONS

SHEET TITLE: MOUNTAIN HOME NATIONAL CEMETERY
MOUNTAIN HOME, TENNESSEE
BLDG. NO. / PROJECT TITLE
LAYOUT PLAN

National Cemetery Administration
Memorial Service Network II
Decatur, Georgia 30033

Drawing Title	Sections HH, II,T,S,R,Q,P,O,DD, BB,AA and Z Layout Drawing
Approved: Area Director	
Approved: Cemetery Director	
Project:	Mountain Home National Cemetery
Location:	Mountain Home, TN
Building Number	
Checked	
Drawn	DCJ
Path:	\\Cematla101\share\MSN II Drawings\Mountain Home\Updated Layout
Date	09/18/09
Project No.	
Drawing Title:	Old Sections
Dwg.	Of

VA FORM 08-6231, FEB. 1983