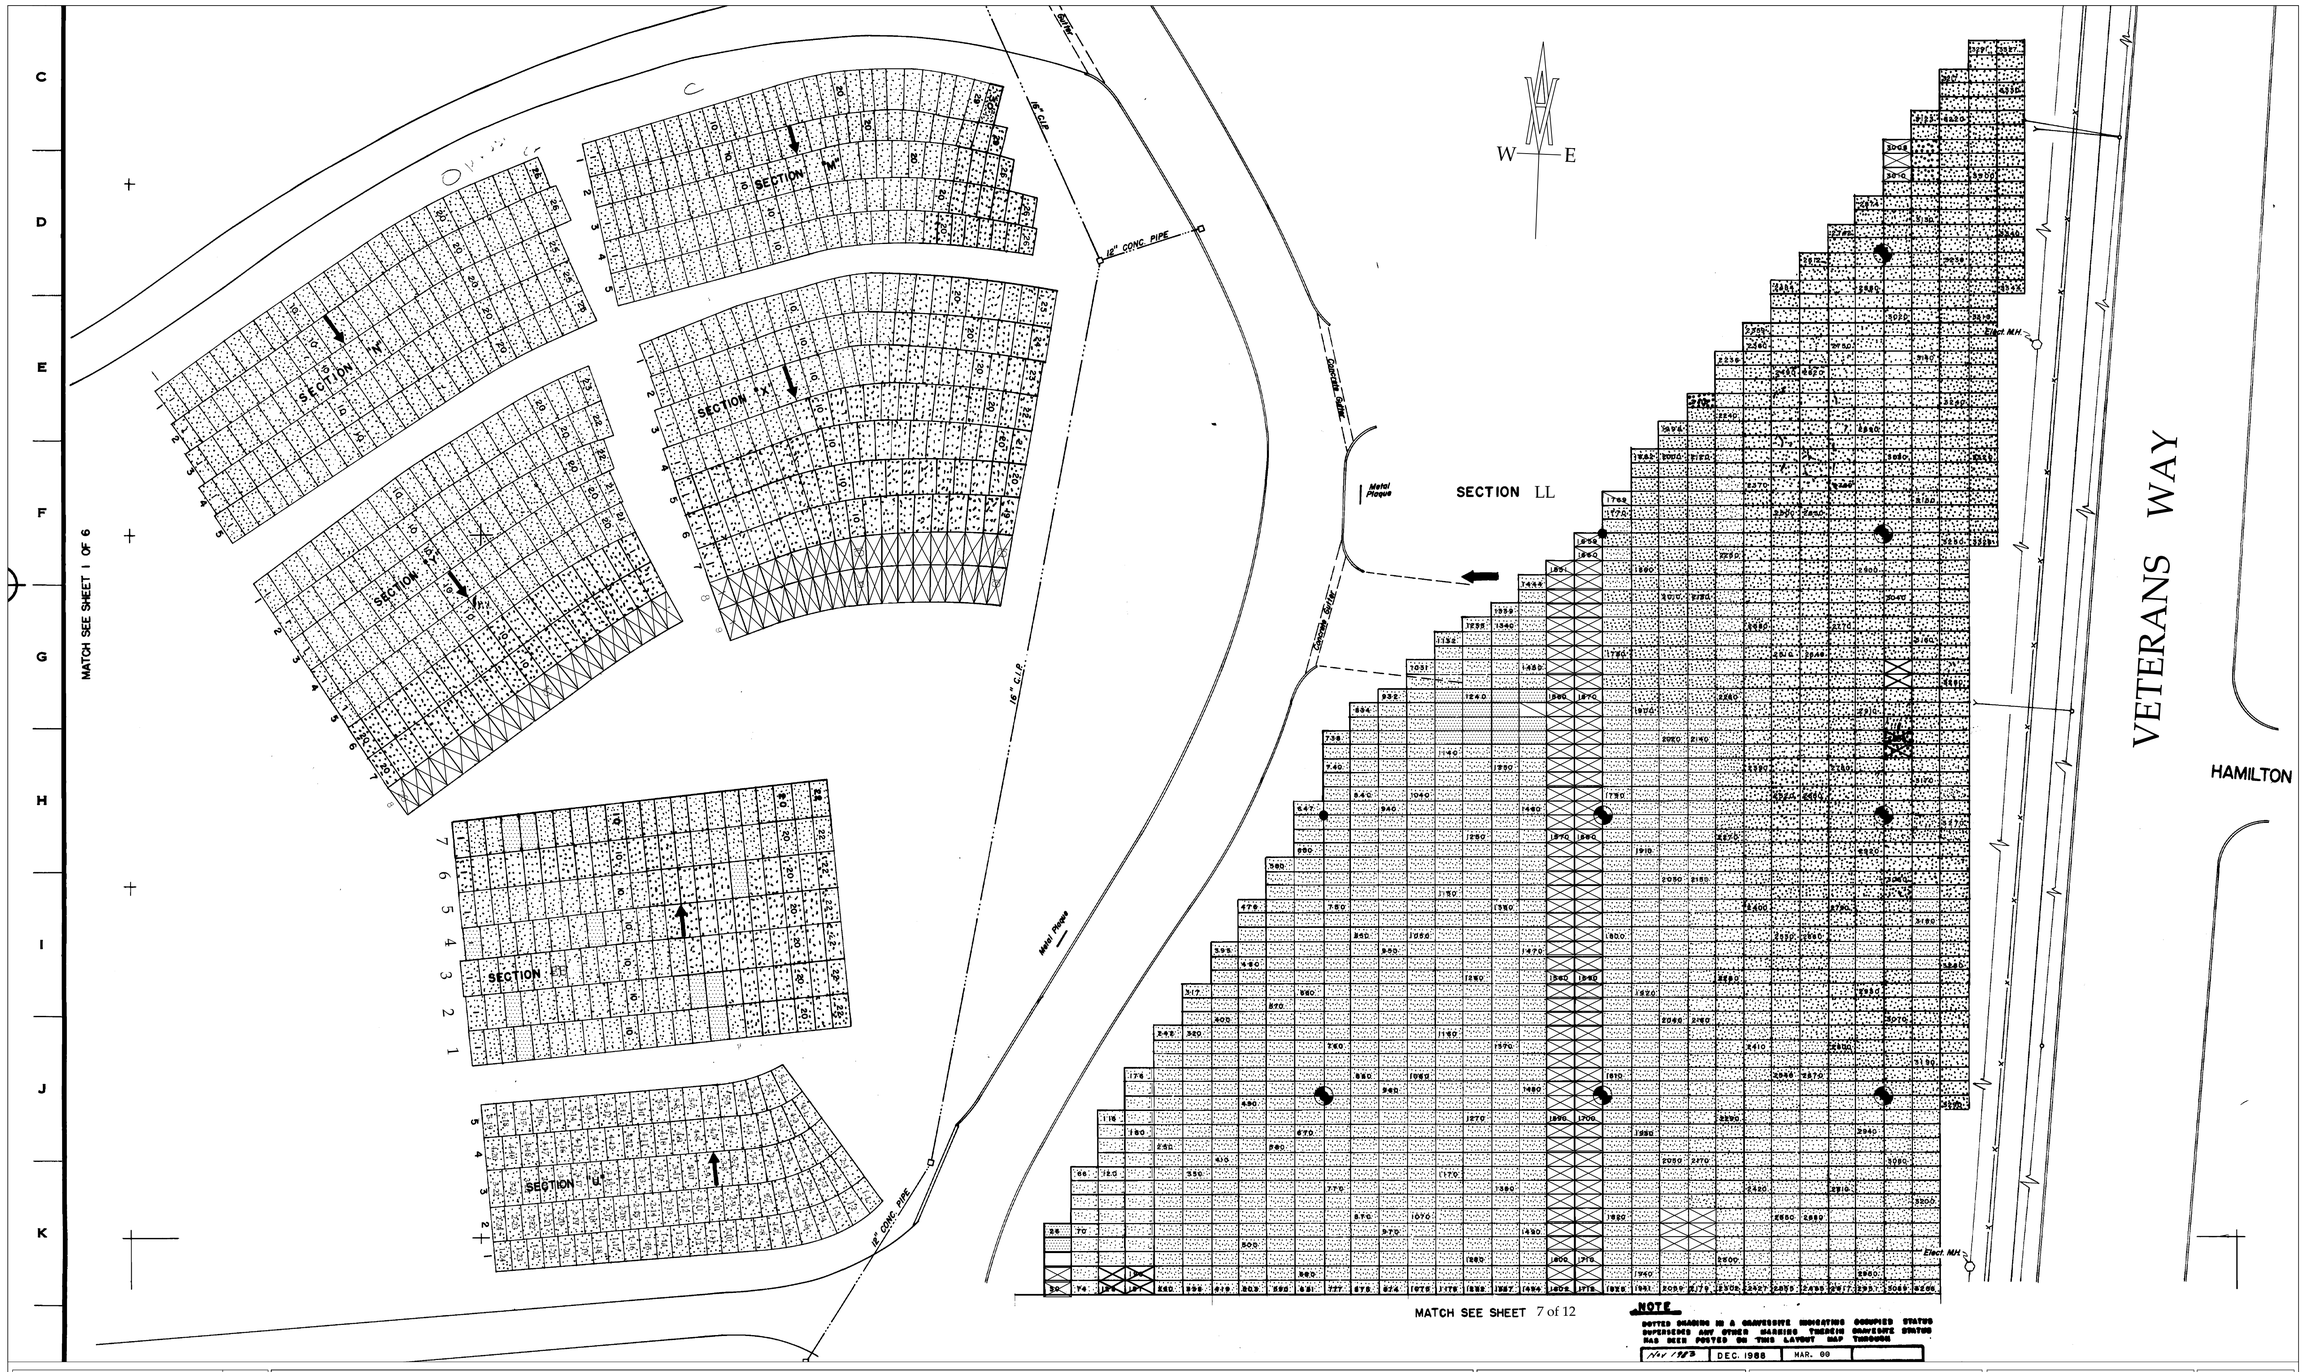

Revisions	Date
Semi-Annual Update and BOSS Comparison	2/14/13
Semi-Annual Update and Corrections	6/12/12
Semi-Annual Update	12/14/11
Semi-Annual Update	6/13/11
Semi-Annual Update	11/3/10
Semi-Annual Update	5/10/10
Semi-Annual Update	10/1/09

CAPACITY IN GRAVESITES

SECTION	SIZE OF GRAVESITE	TOTAL	RES	AVAIL	OBST.	REMARKS
		SEE GBSAT				

Scale NTS

LEGEND
- AVAILABLE GRAVESITE
- SET ASIDE/RESERVED
- OBSTRUCTED GRAVESITE
- OCCUPIED GRAVESITE
- GRAVES FACE
- GRAVESITE CONTROL MONUMENT

National Cemetery Administration
Memorial Service Network II
Decatur, Georgia 30033

Drawing Title: Sections M,N,X,Y,EE,U, and LL(2) Layout Drawing

Project: Mountain Home National Cemetery
Location: Mountain Home, TN

Date: 09/18/09
Project No.:

Approved: Area Director
Approved: Cemetery Director
Building Number
Checked
Drawn: DCJ

Drawing Title: Old Sections
Path: \\Cematla101\share\MSN II Drawings\Mountain Home\Updated Layout
Dwg. Of

VA FORM 08-6231, FEB. 1983