


SECTION MM

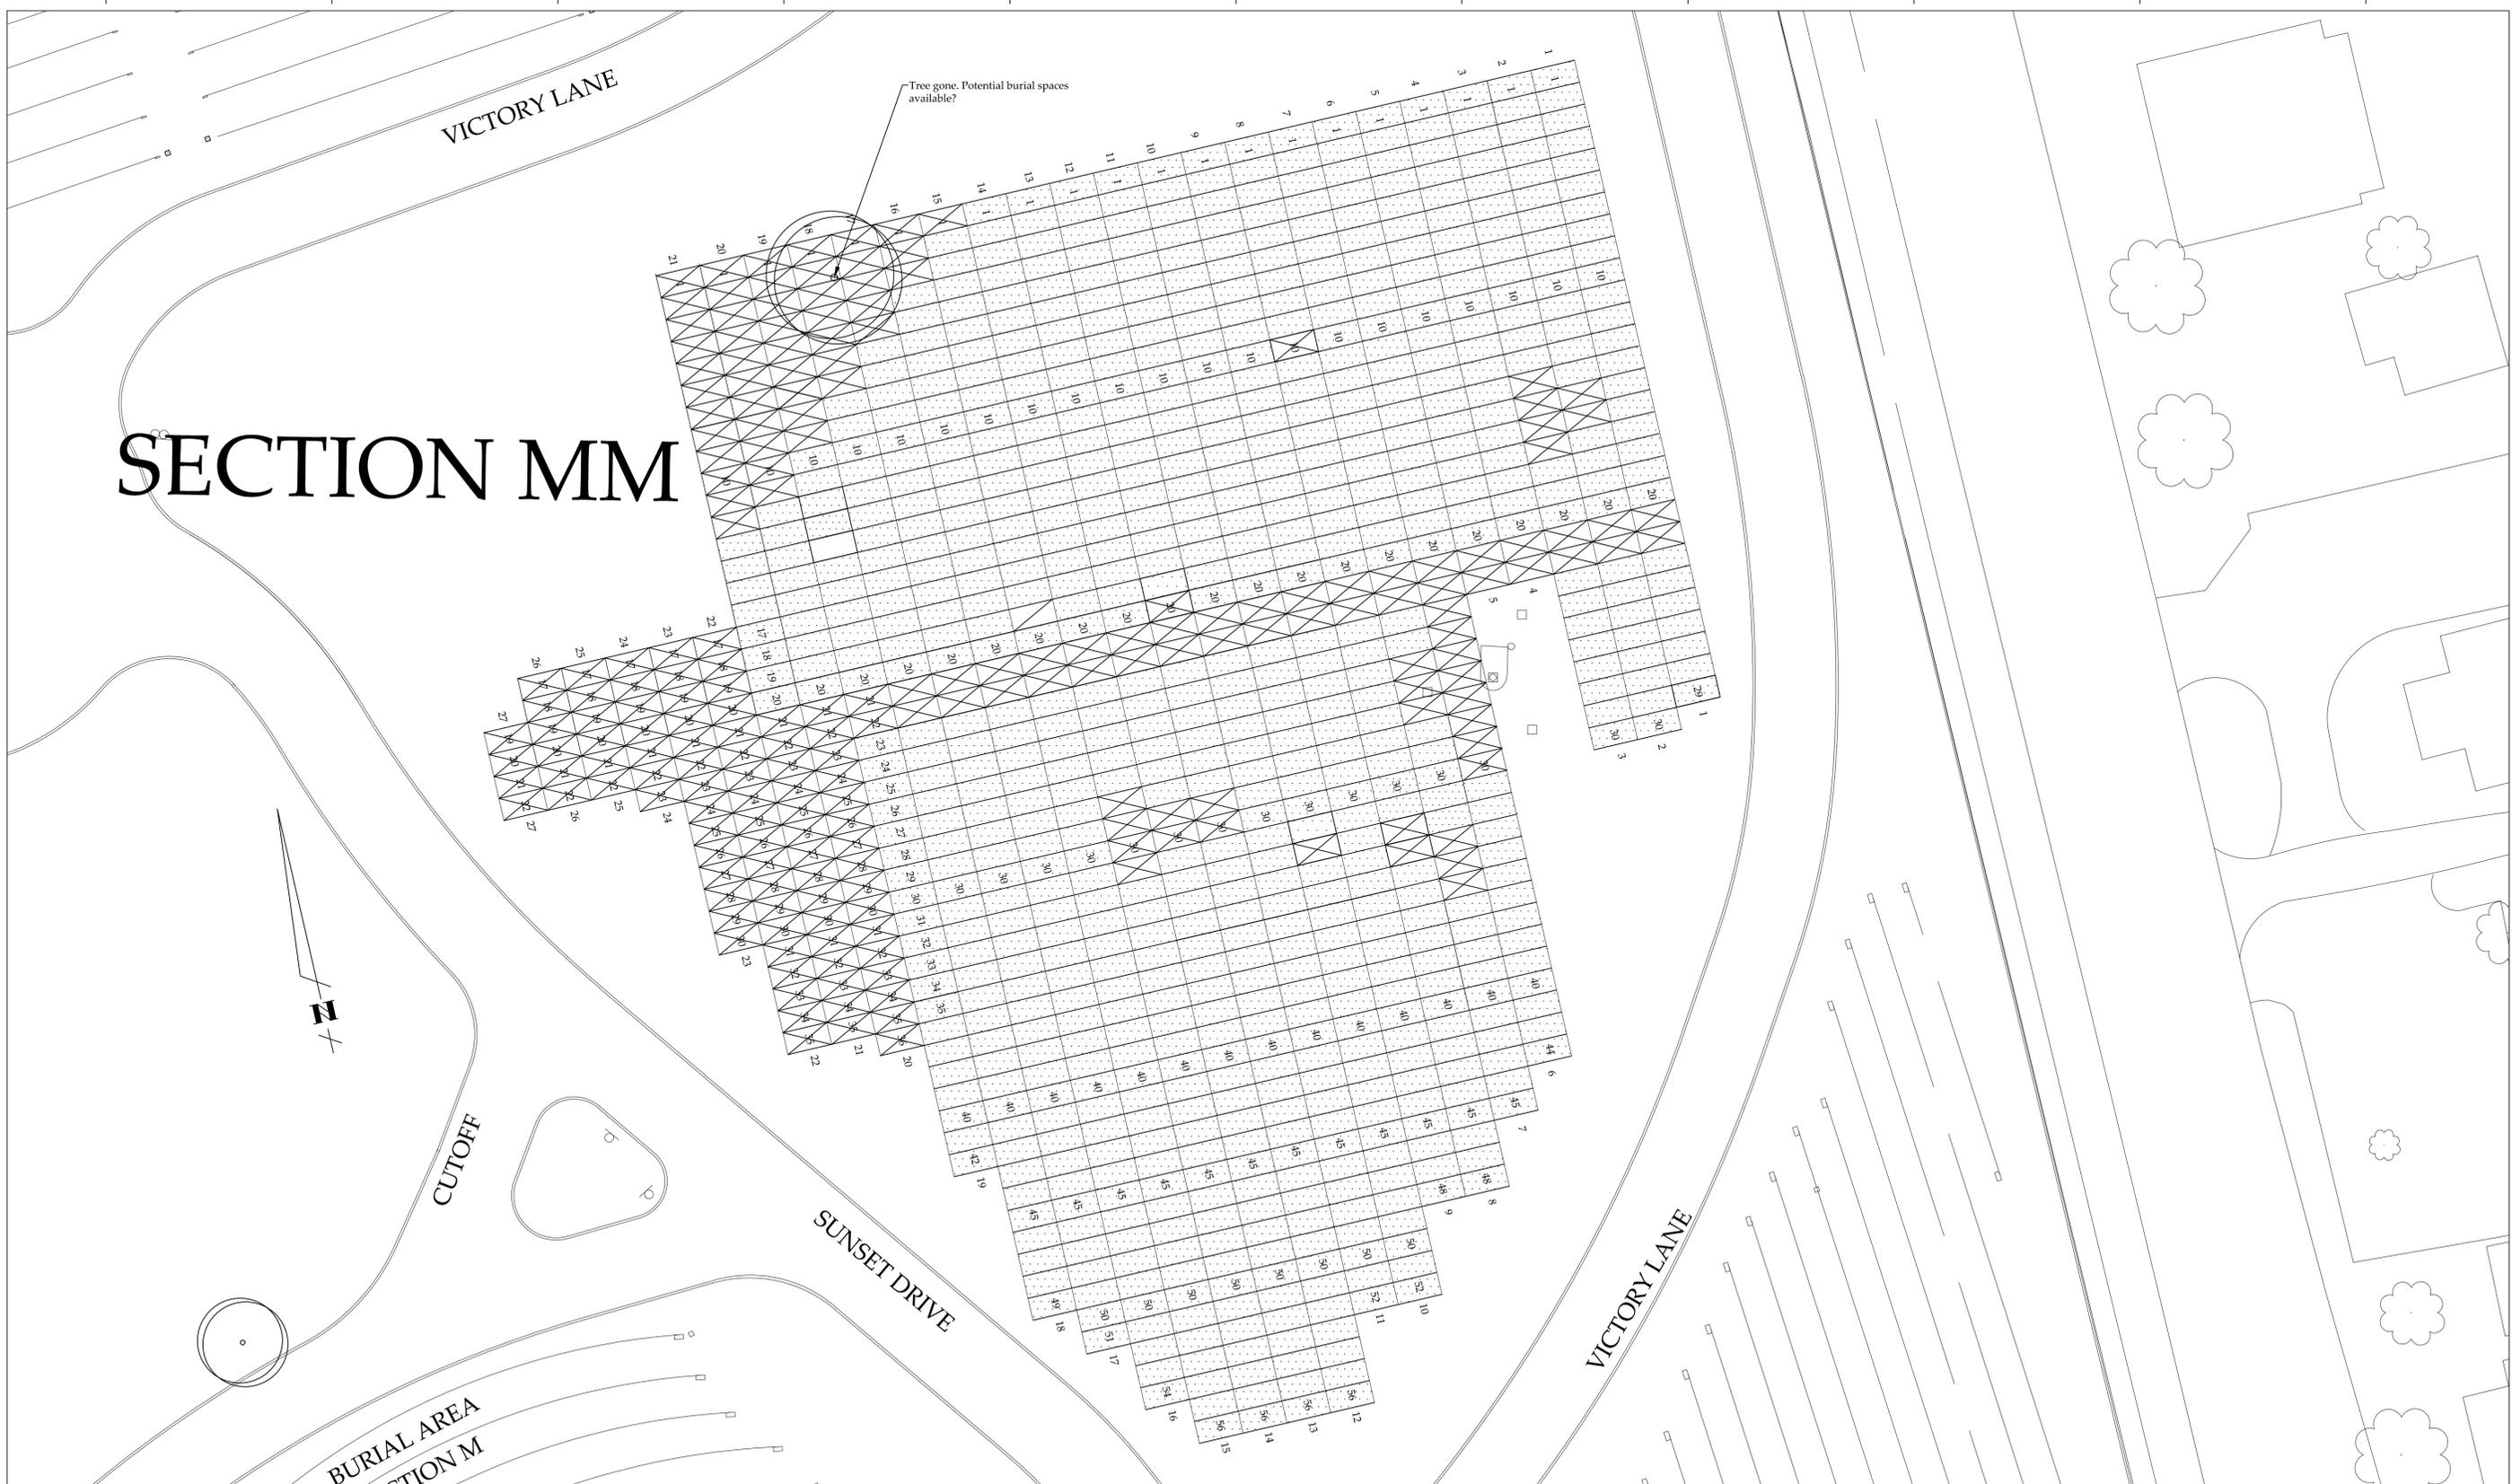

Semi-Annual Update and BOSS Comparison	2/14/13
Semi-Annual Update	6/12/12
Semi-Annual Update	12/14/11
Semi-Annual Update	6/13/11
Semi-Annual Update	11/3/10
Semi-Annual Update	5/10/10
Semi-Annual Update	10/1/09
Revisions	Date

CAPACITY IN GRAVESITES						
SECTION	SIZE OF GRAVESITE	TOTAL	RES	AVAIL	OBST.	REMARKS
MM						SEE GBSAT

Scale : NTS

LEGEND	
	AVAILABLE GRAVESITE
	SET ASIDE/RESERVED
	OBSTRUCTED GRAVESITE
	OCCUPIED GRAVESITE
	GRAVES FACE
	GRAVESITE CONTROL MONUMENT



National Cemetery Administration
Memorial Service Network II
Decatur, Georgia 30033

Drawing Title	
Section MM Layout Drawing	
Approved: Area Director	
Approved: Cemetery Director	

Project	Mountain Home National Cemetery		Date	02/22/12
Location	Mountain Home, TN		Project No.	
Building Number	Checked	Drawn	DCJ	
Path	\\Cemata101\share\MSN II Drawings\Mountain Home\Updated Layout		Drawing Title	823LA600 Sections MM, RR and SS
			Dwg.	01