


one and one half inches = one foot
three quarters inch = one foot
one inch = one foot
three eighths inch = one foot
one half inch = one foot
three eighths inch = one foot
one quarter inch = one foot
one eighth inch = one foot
one eighth inch = one foot

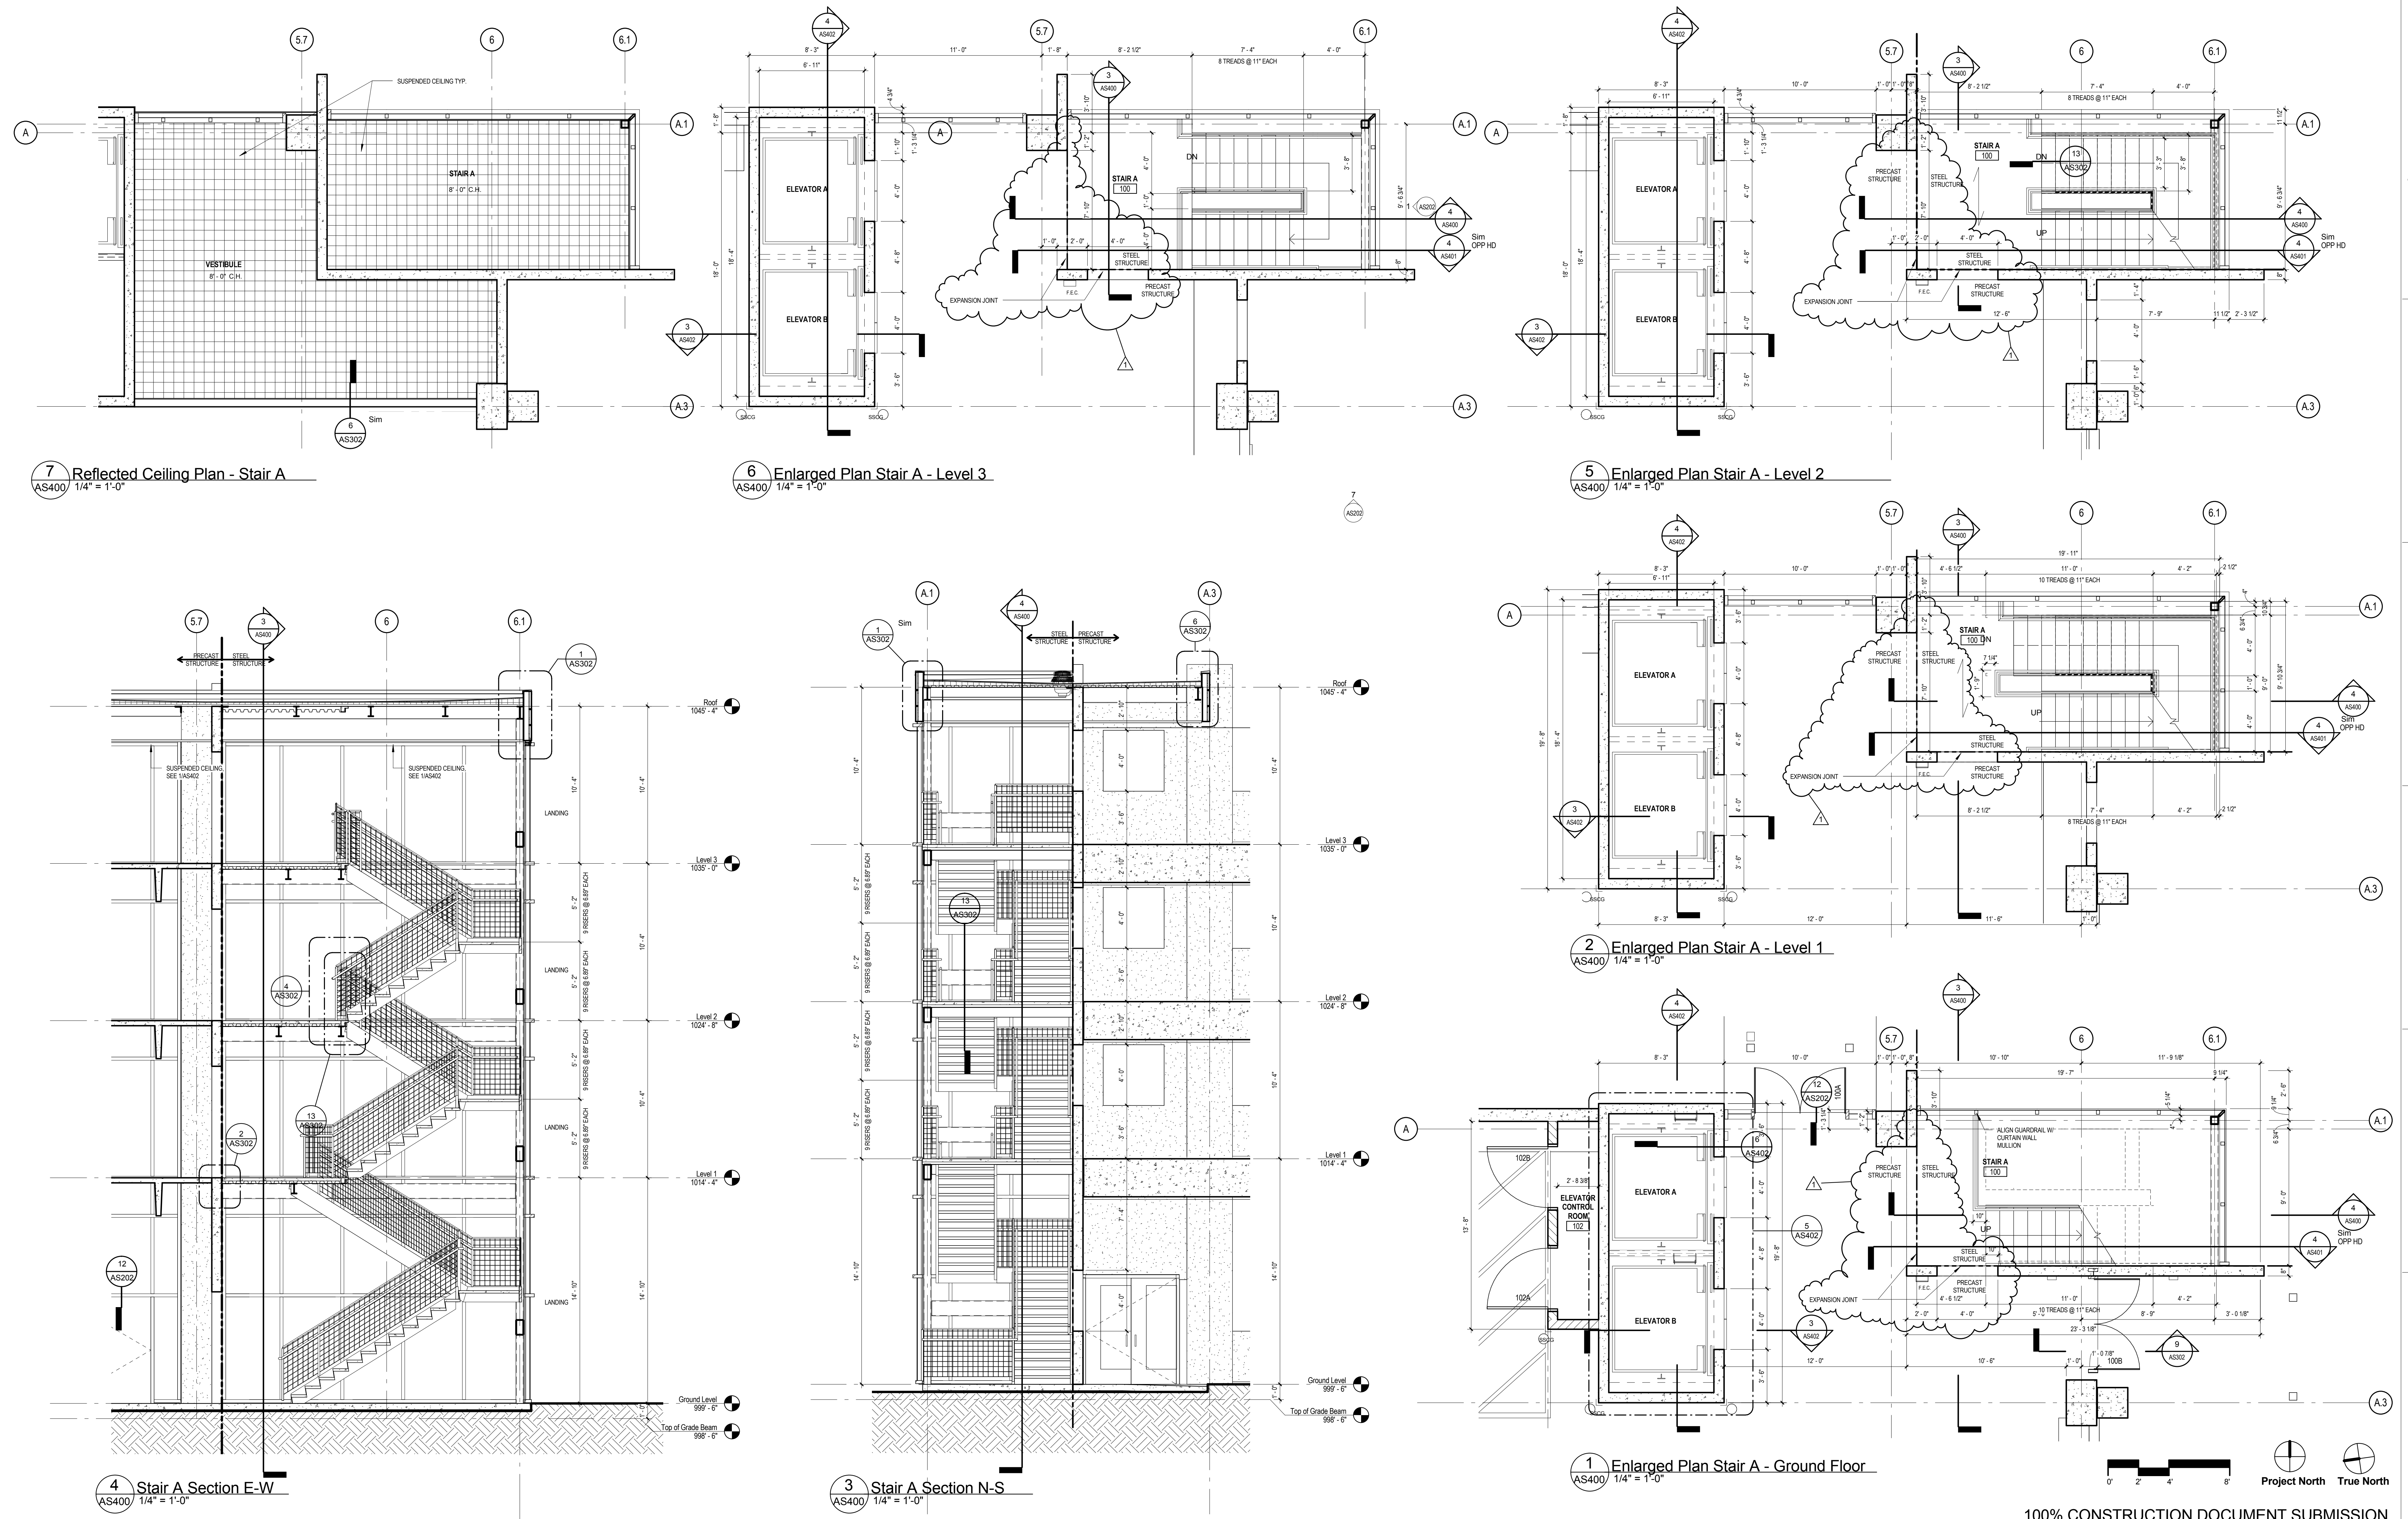

CONSULTANTS:		ARCHITECT/ENGINEERS:		Drawing Title		Project Title		VA Project Number		Office of Construction and Facilities Management	
		IKM architecture planning interior design IKM Incorporated One PPG Place Pittsburgh, PA 15222 412-281-1337 www.ikmnc.com		Stair A Plans and Sections		VA Clarksburg Parking Garage		540-320 IKM Project Number 10-163		Department of Veterans Affairs	
EXHIBIT F - CLARIFICATION		Revisions:		Approved: Project Director		Location		Building Number		AS400	
03-31-2014		Date				VAMC Clarksburg West Virginia				Dwg. of	
						Date		Checked		Drawn	
						13 February 2012					

100% CONSTRUCTION DOCUMENT SUBMISSION

Project North True North